


PLAN	SURVEYED	DATE
	NOTED	BY
PROFILE	NOTED	DATE
	NOTED	BY

PROFILE	SURVEYED	DATE
	NOTED	BY
PLAN	SURVEYED	DATE
	NOTED	BY

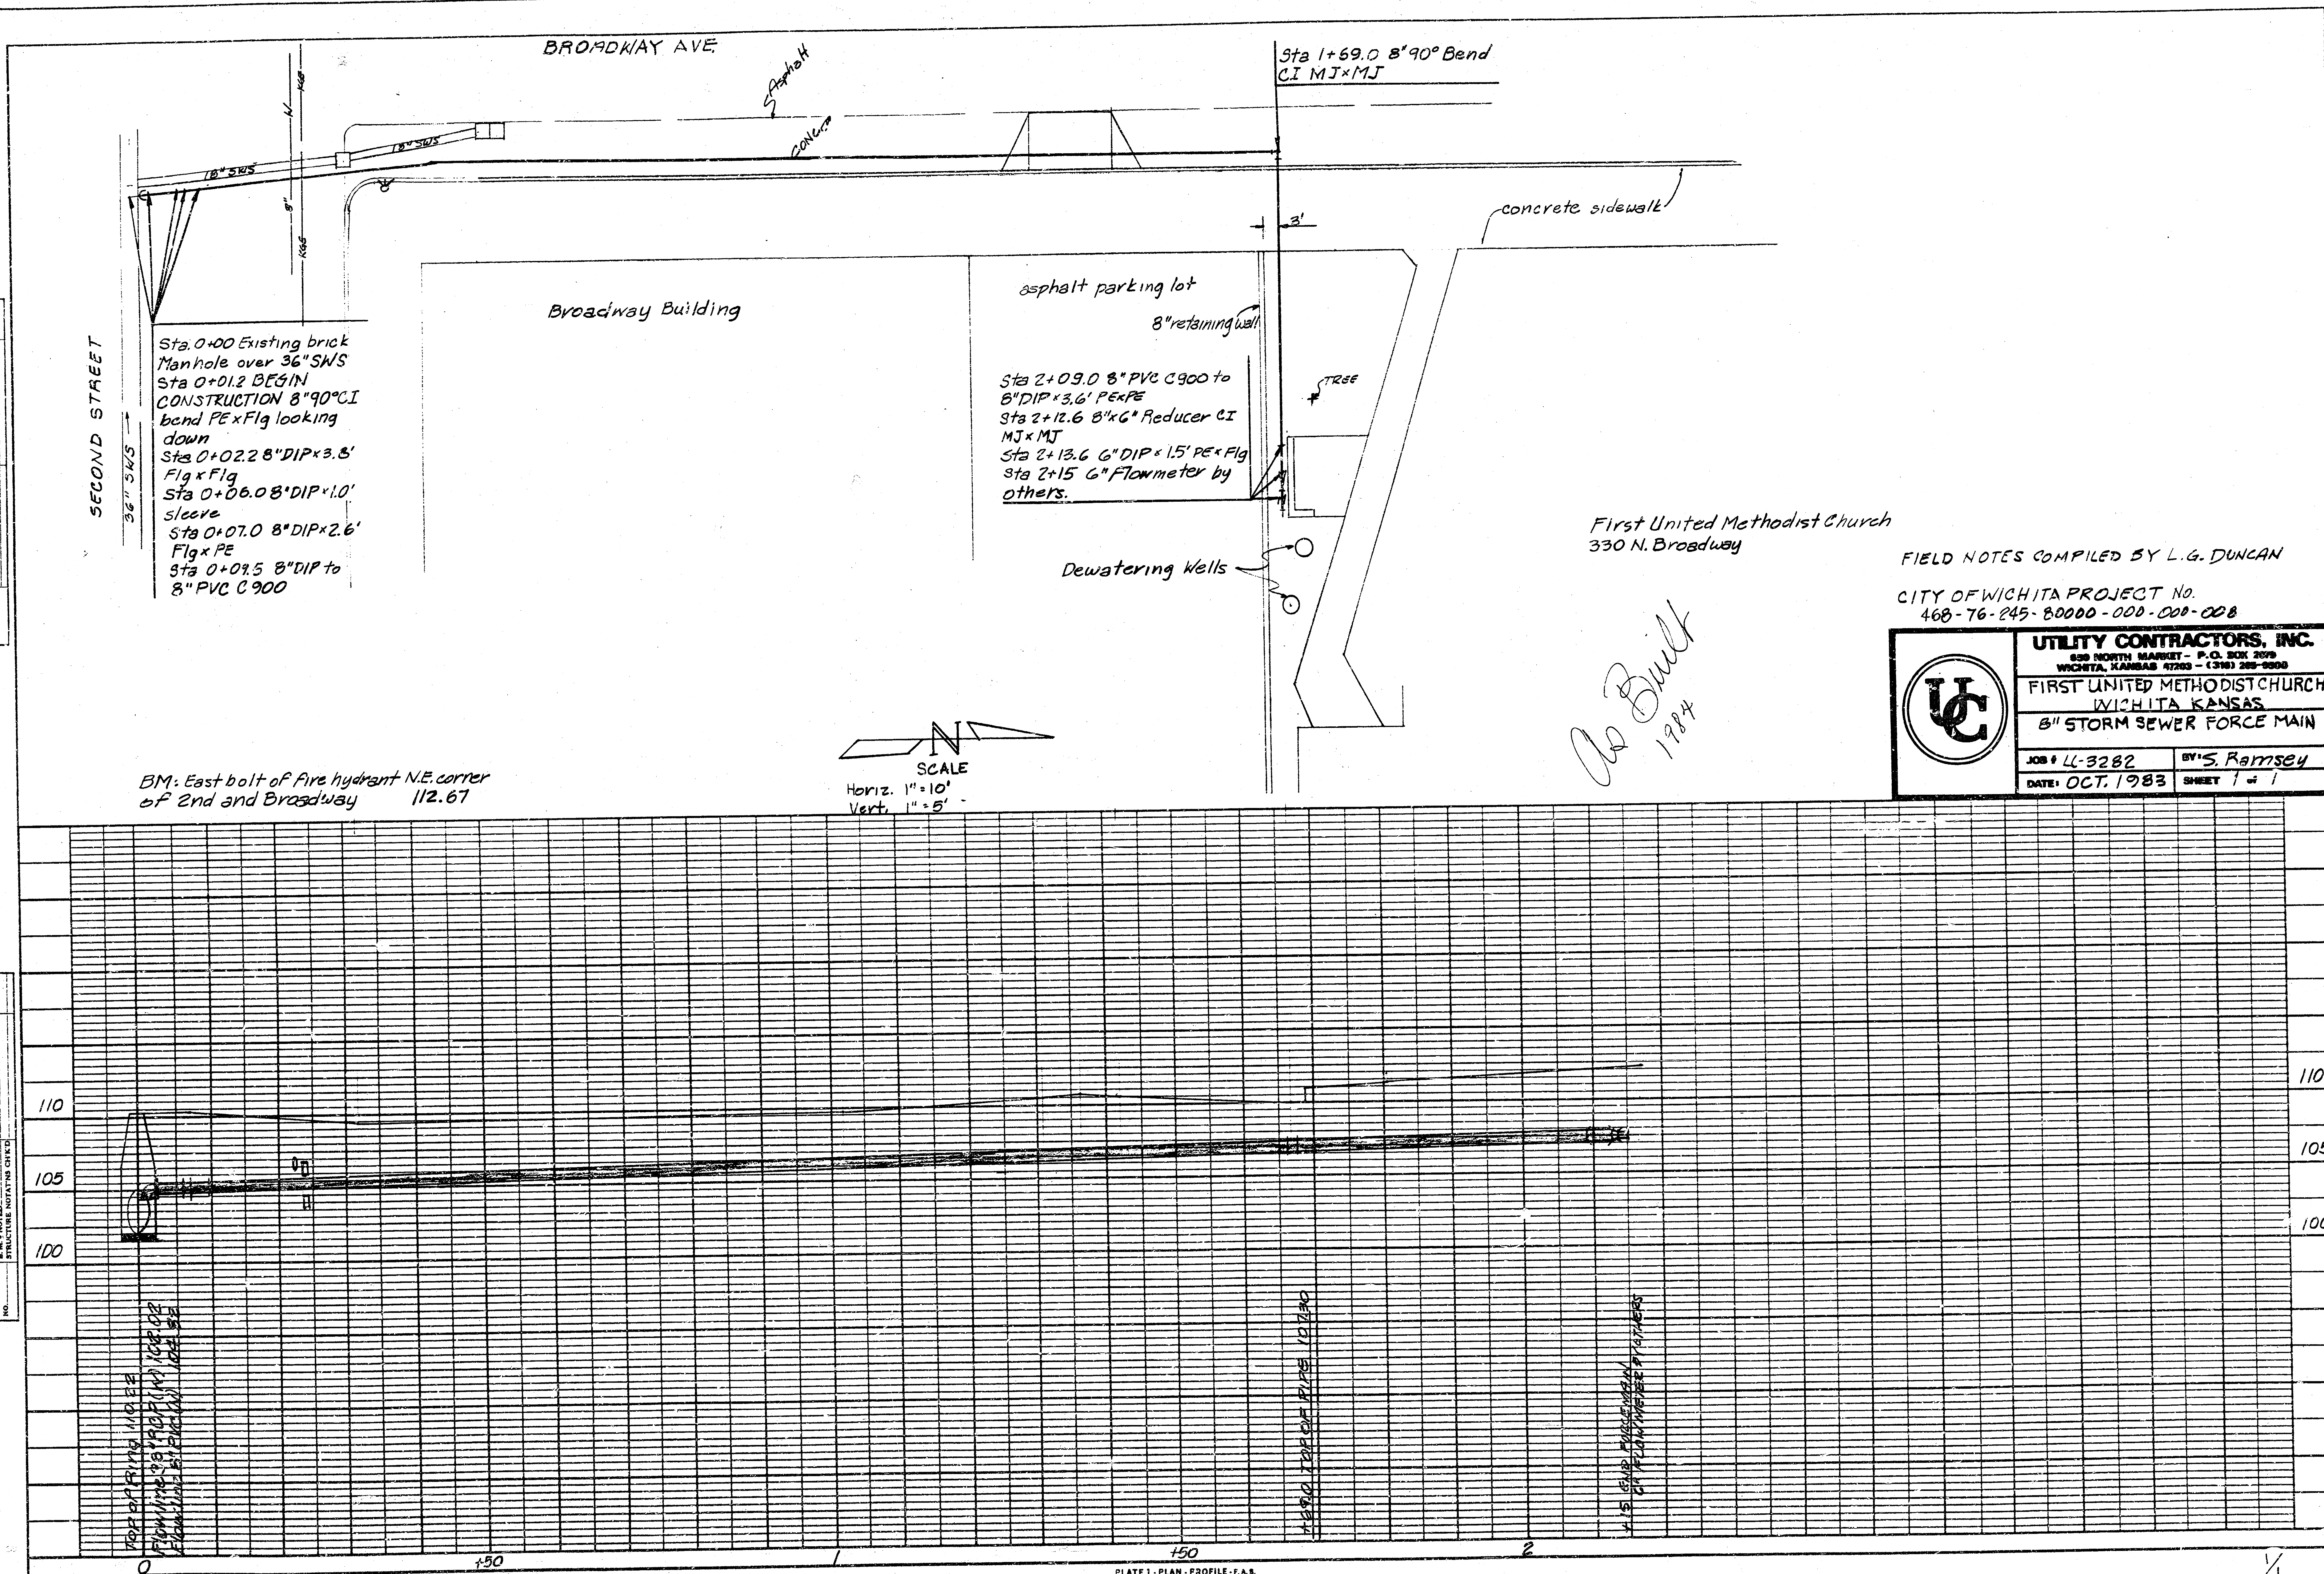

FIELD NOTES COMPILED BY L.G. DUNCAN

CITY OF WICHITA PROJECT NO.
468-76-245-80000-000-000-008

	UTILITY CONTRACTORS, INC.	
	830 NORTH MARKET - P.O. BOX 2018 WICHITA, KANSAS 67202 - (316) 262-0200	
	FIRST UNITED METHODIST CHURCH WICHITA, KANSAS	
	8" STORM SEWER FORCE MAIN	
JOB # 44-3282	BY S. Ramsey	
DATE: OCT. 1983	SHEET 1 of 1	

FILMED FROM THE BEST