



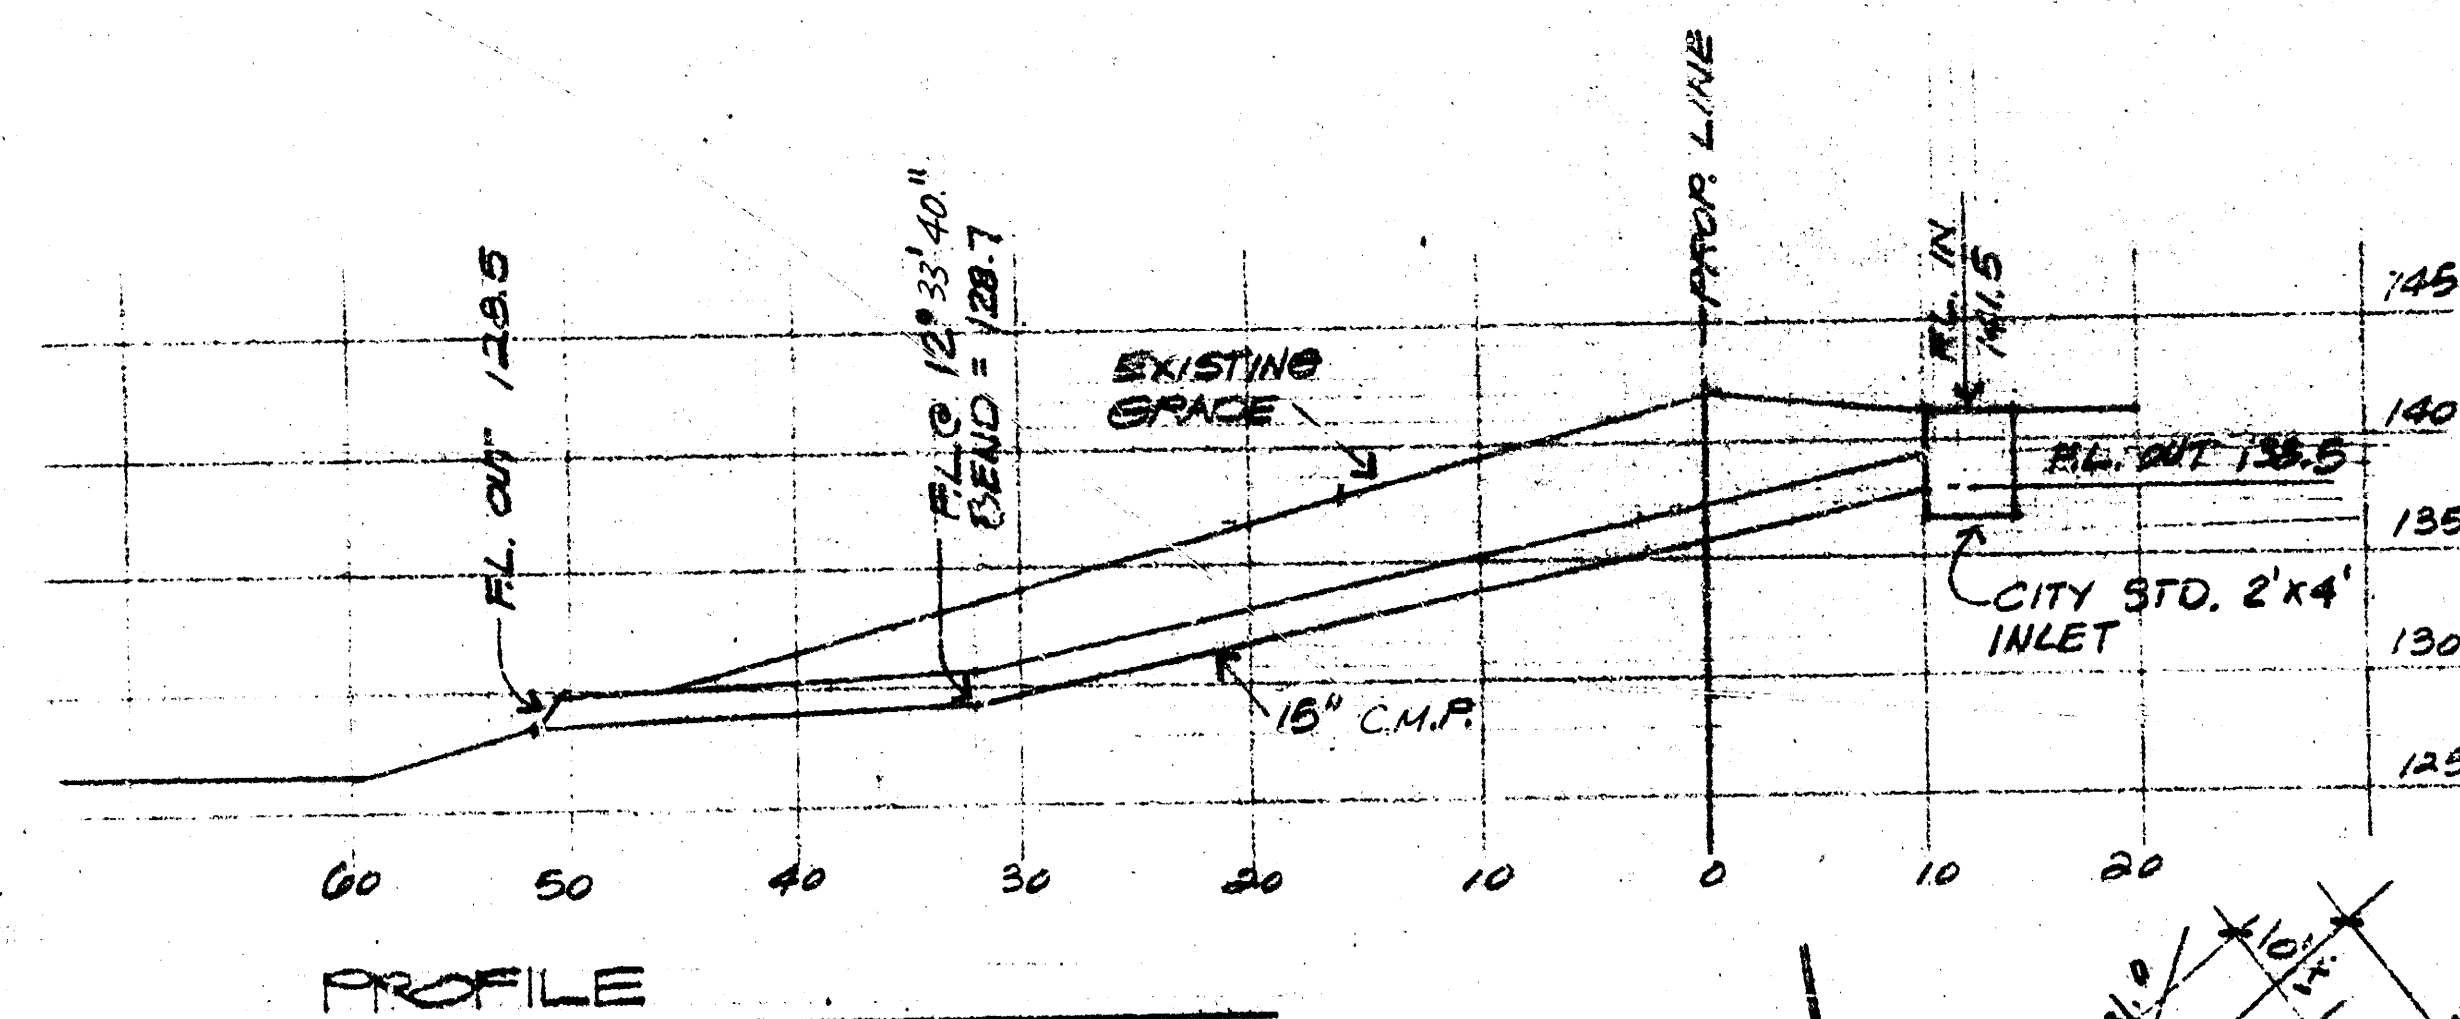

APPROVED AS NOTED
By CITY ENGINEER OF WICHITA
Sanitary Sewers
Storm Sewers *Y. J. J.* 2/19/83
Driveway Approaches

NOTE TO CONTRACTOR
This project will be under the supervision of the City Engineer of Wichita and conforming to the City of Wichita Standard Specifications for Streets and Highways and the City of Wichita Standard Specifications for Sanitary Sewers and Storm Sewers.

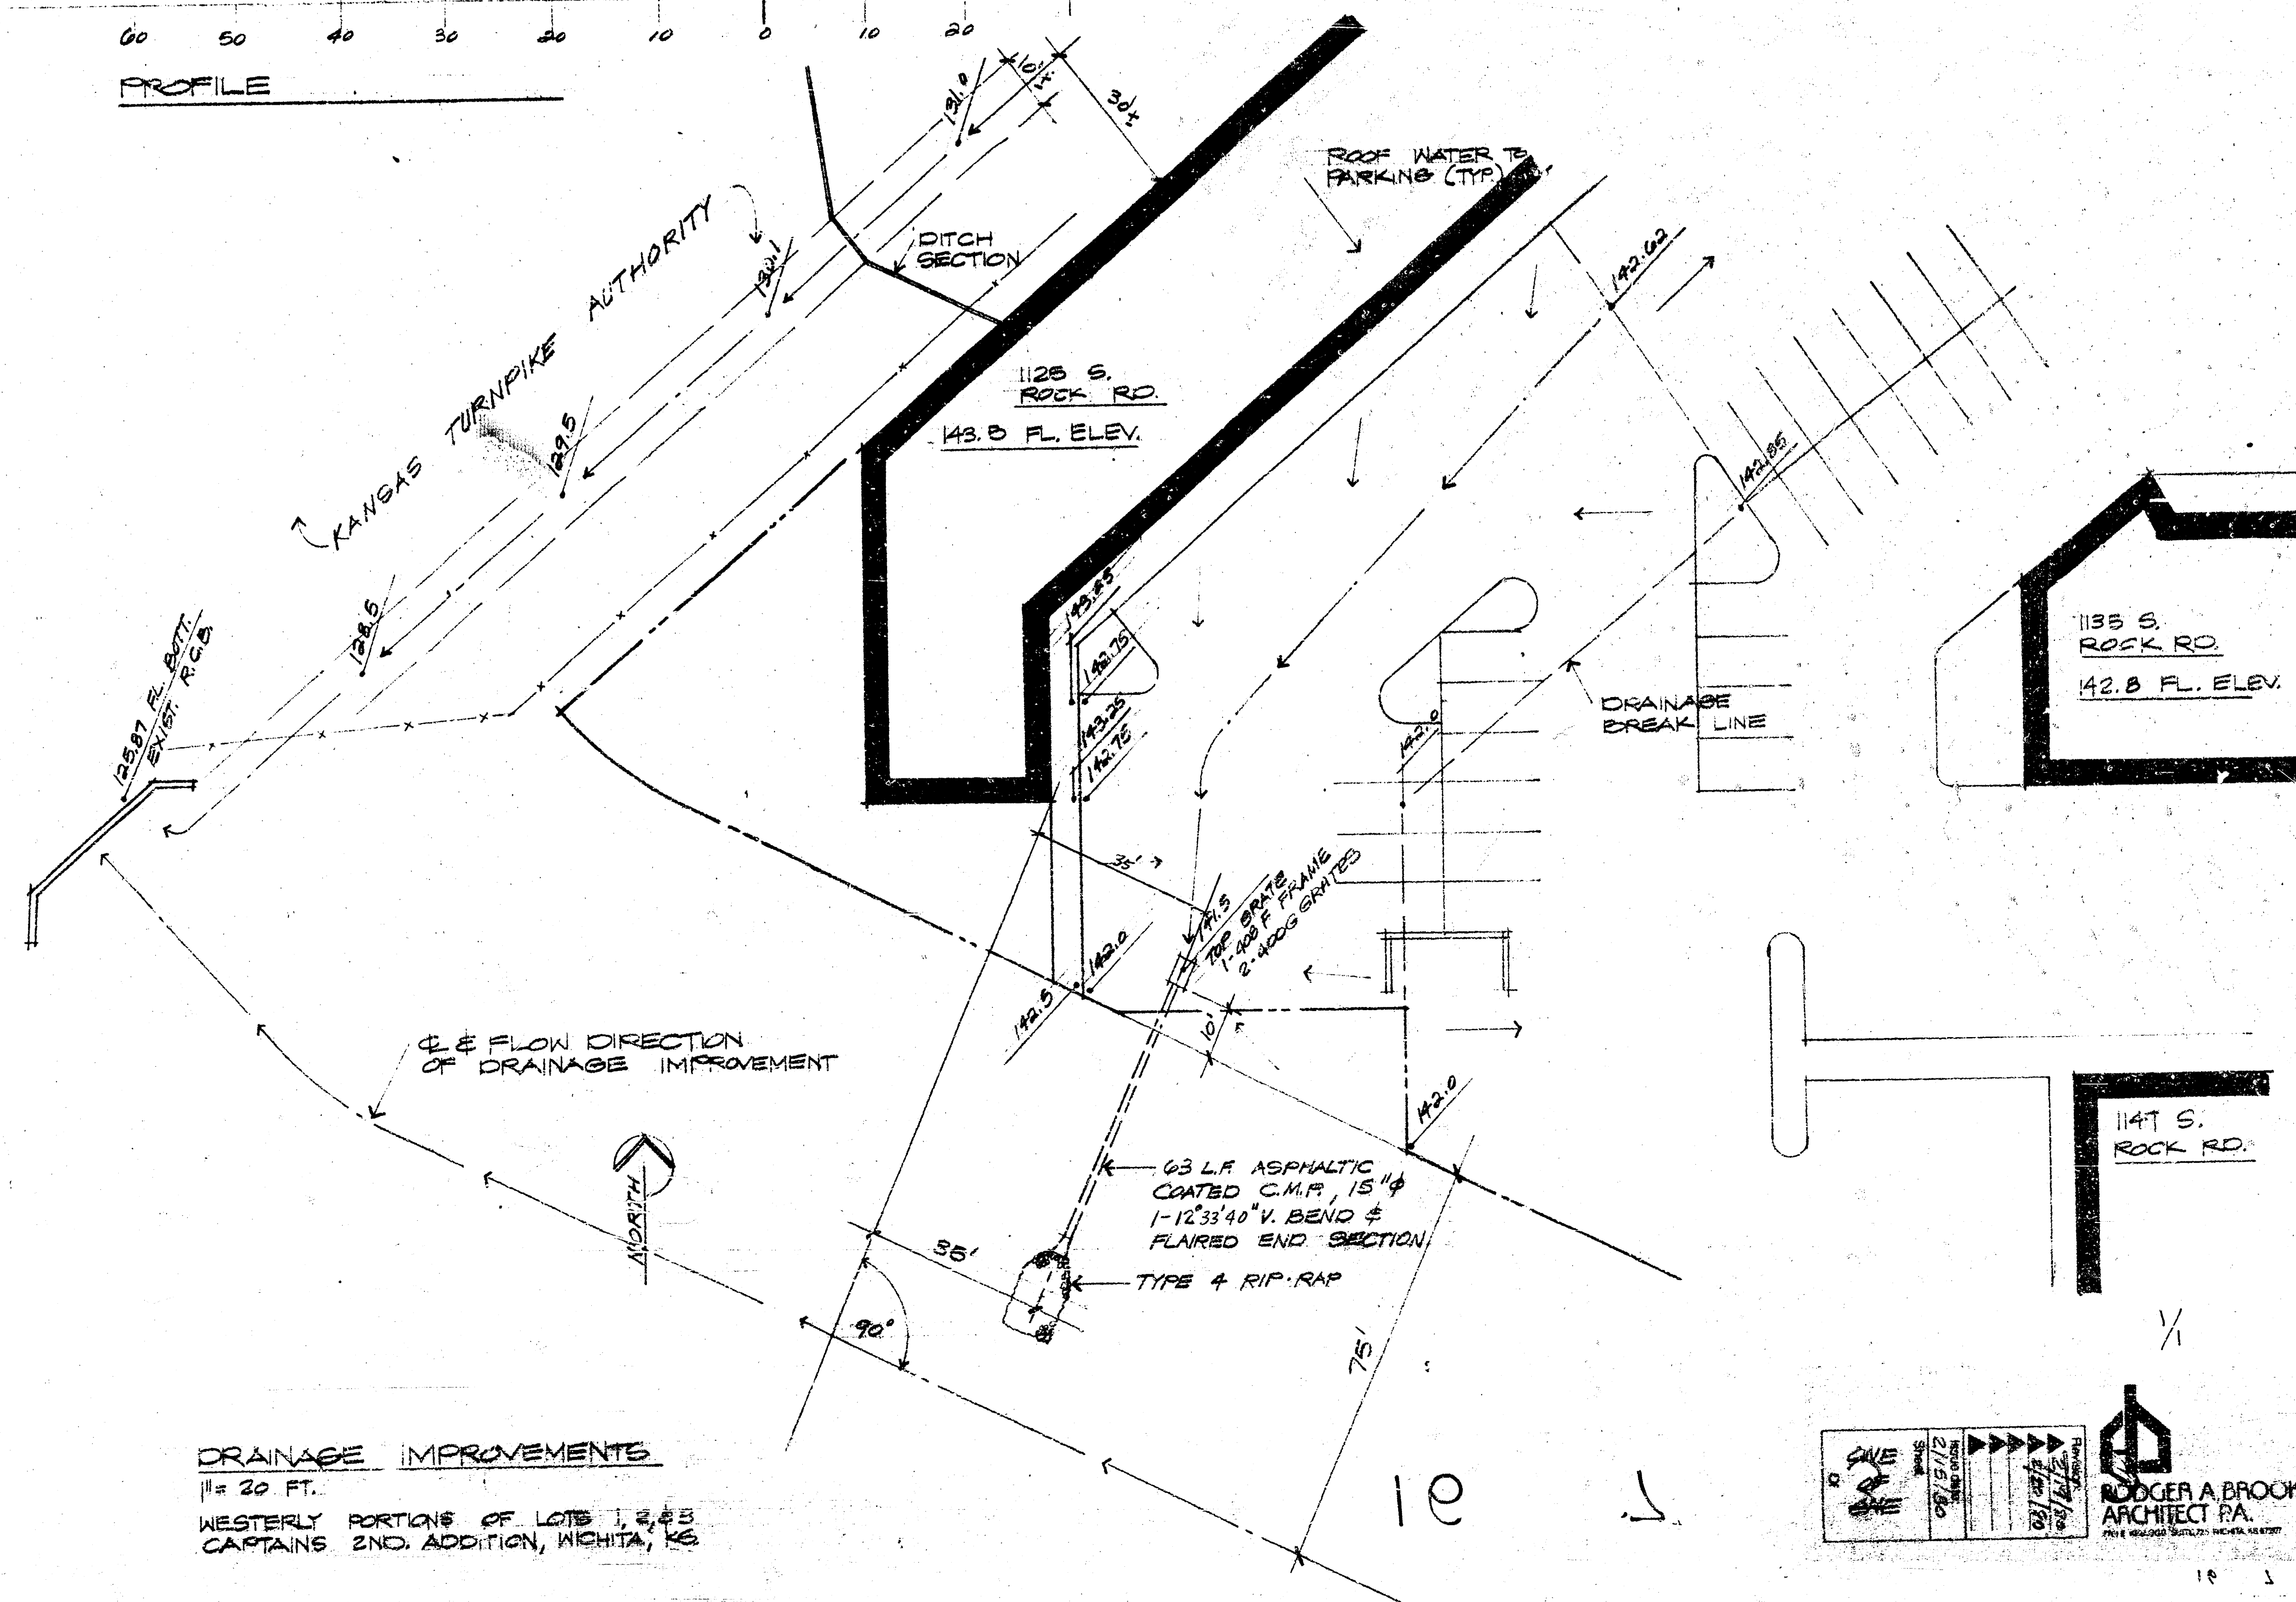

DRAINAGE IMPROVEMENTS
1" = 20 FT.
WESTERLY PORTIONS OF LOTS 1, 2, & 3
CAPTAINS 2ND ADDITION, WICHITA, KS

RODGER A. BROOKS
ARCHITECT P.A.
