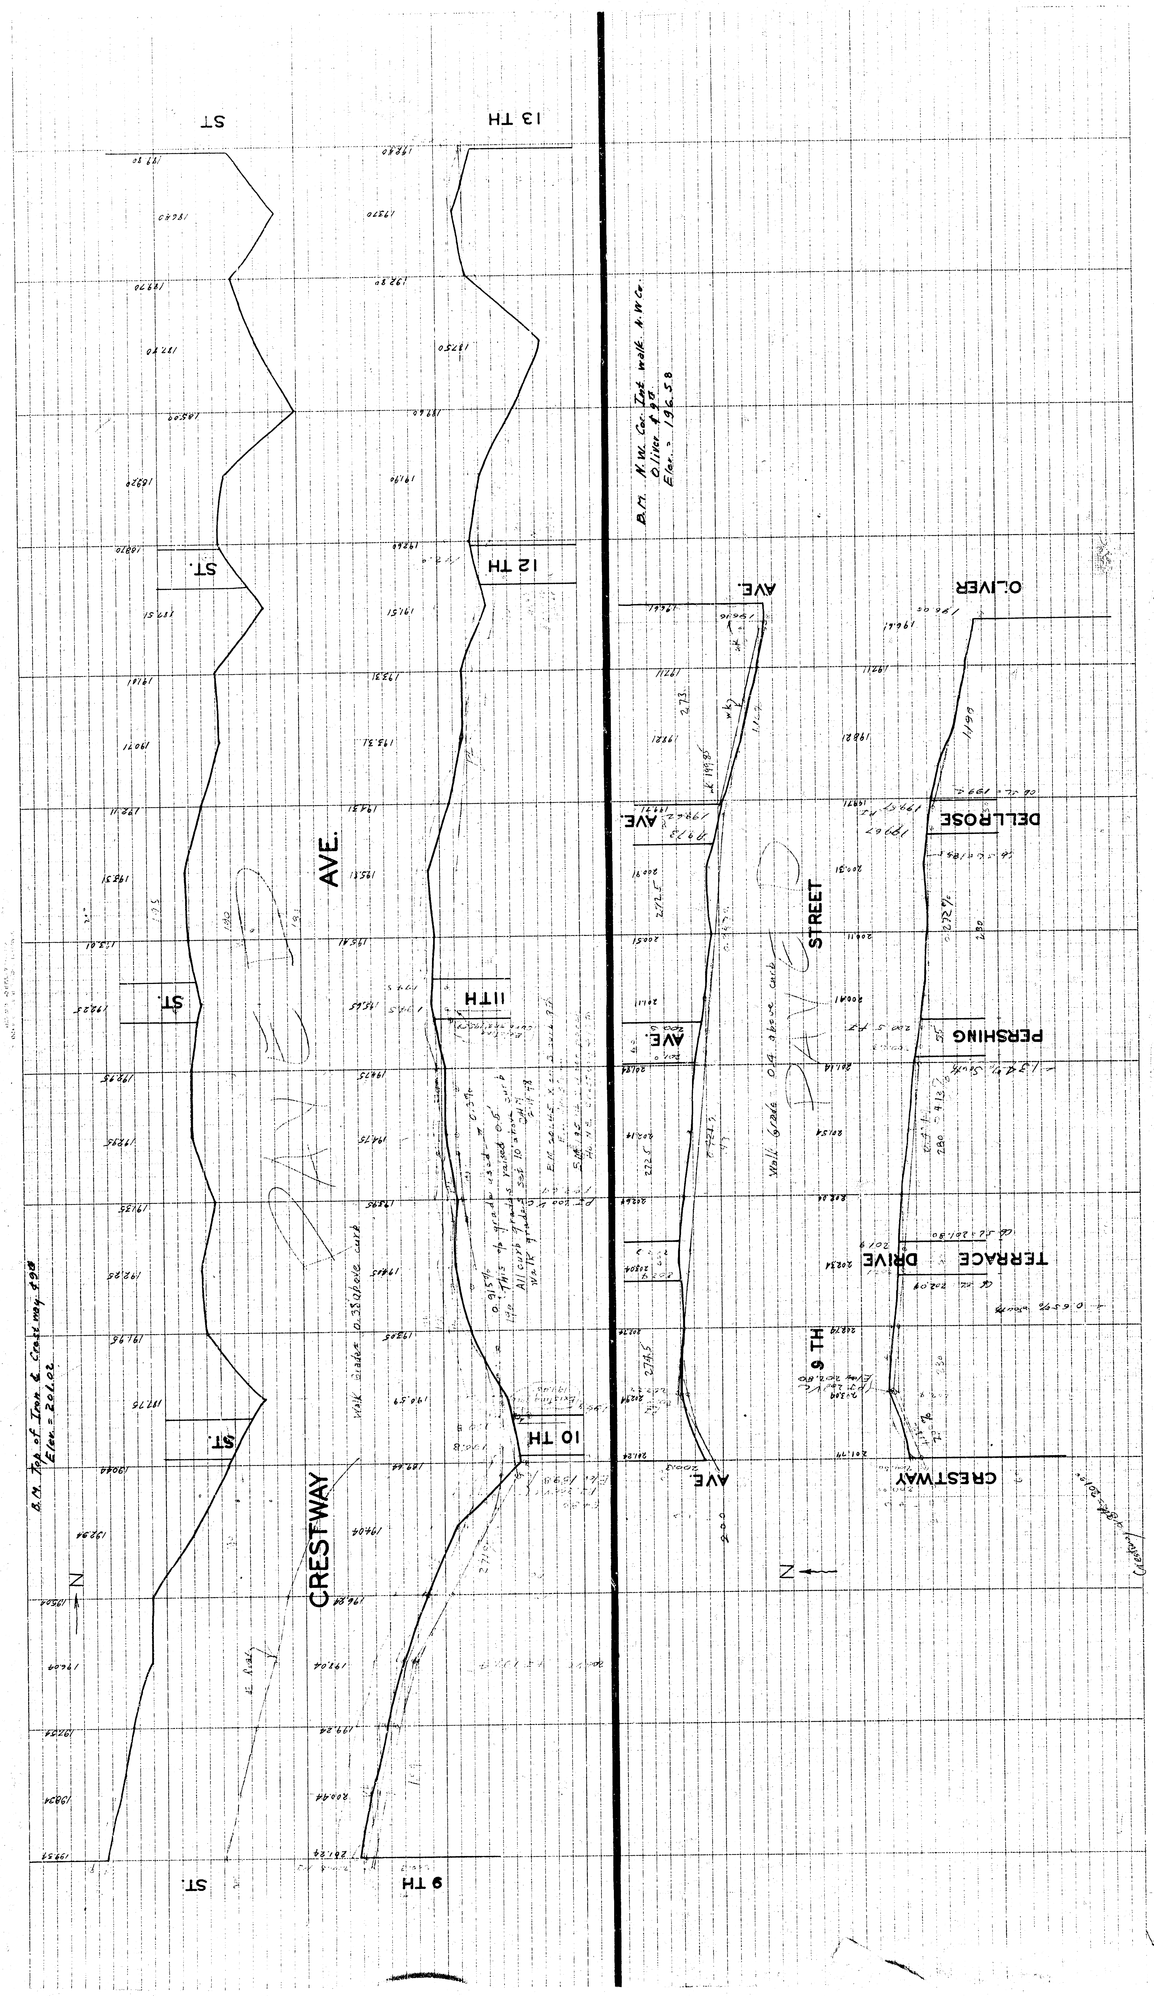
B.M. Top of Trun. & Crosswy. 199
Elev. = 201.02
CRESTWAY
AVE.
ST.
9 TH
10 TH
11TH
12 TH
13 TH
N
B.M. N.W. Cor. Int. walk. N.W. Cor.
Oliver & 9th
Elev. = 196.58
CRESTWAY
AVE.
HT 6
STREET
PERSHING
DELLROSE
TERRACE
DRIVE
OLIVER
N

24-J