S-E1

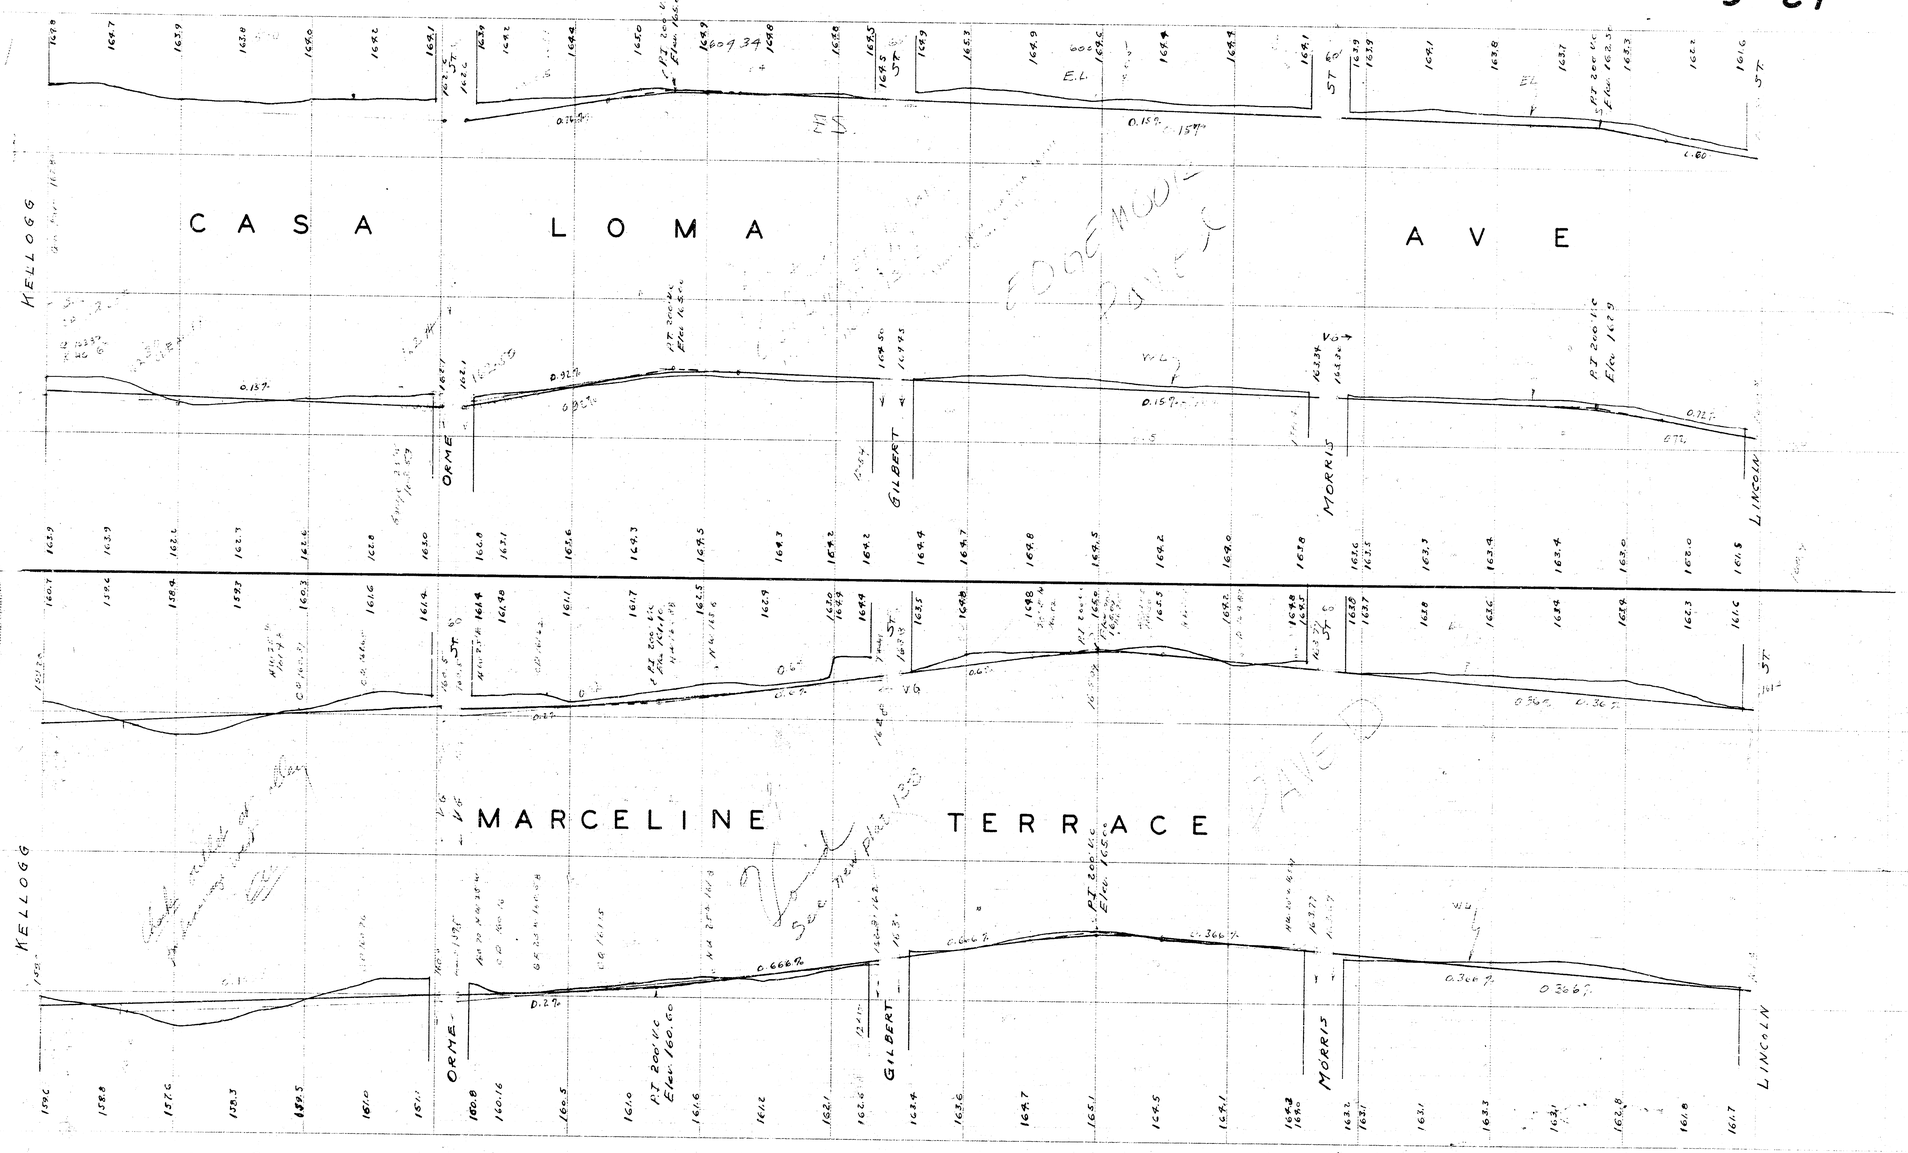
CASA LOMA AVE
MARCELINE TERRACE
KELLOGG
ORME
GILBERT
MORRIS
LINCOLN
EDGEMOOR PLACE
PAVED
See new plat 138

13-S