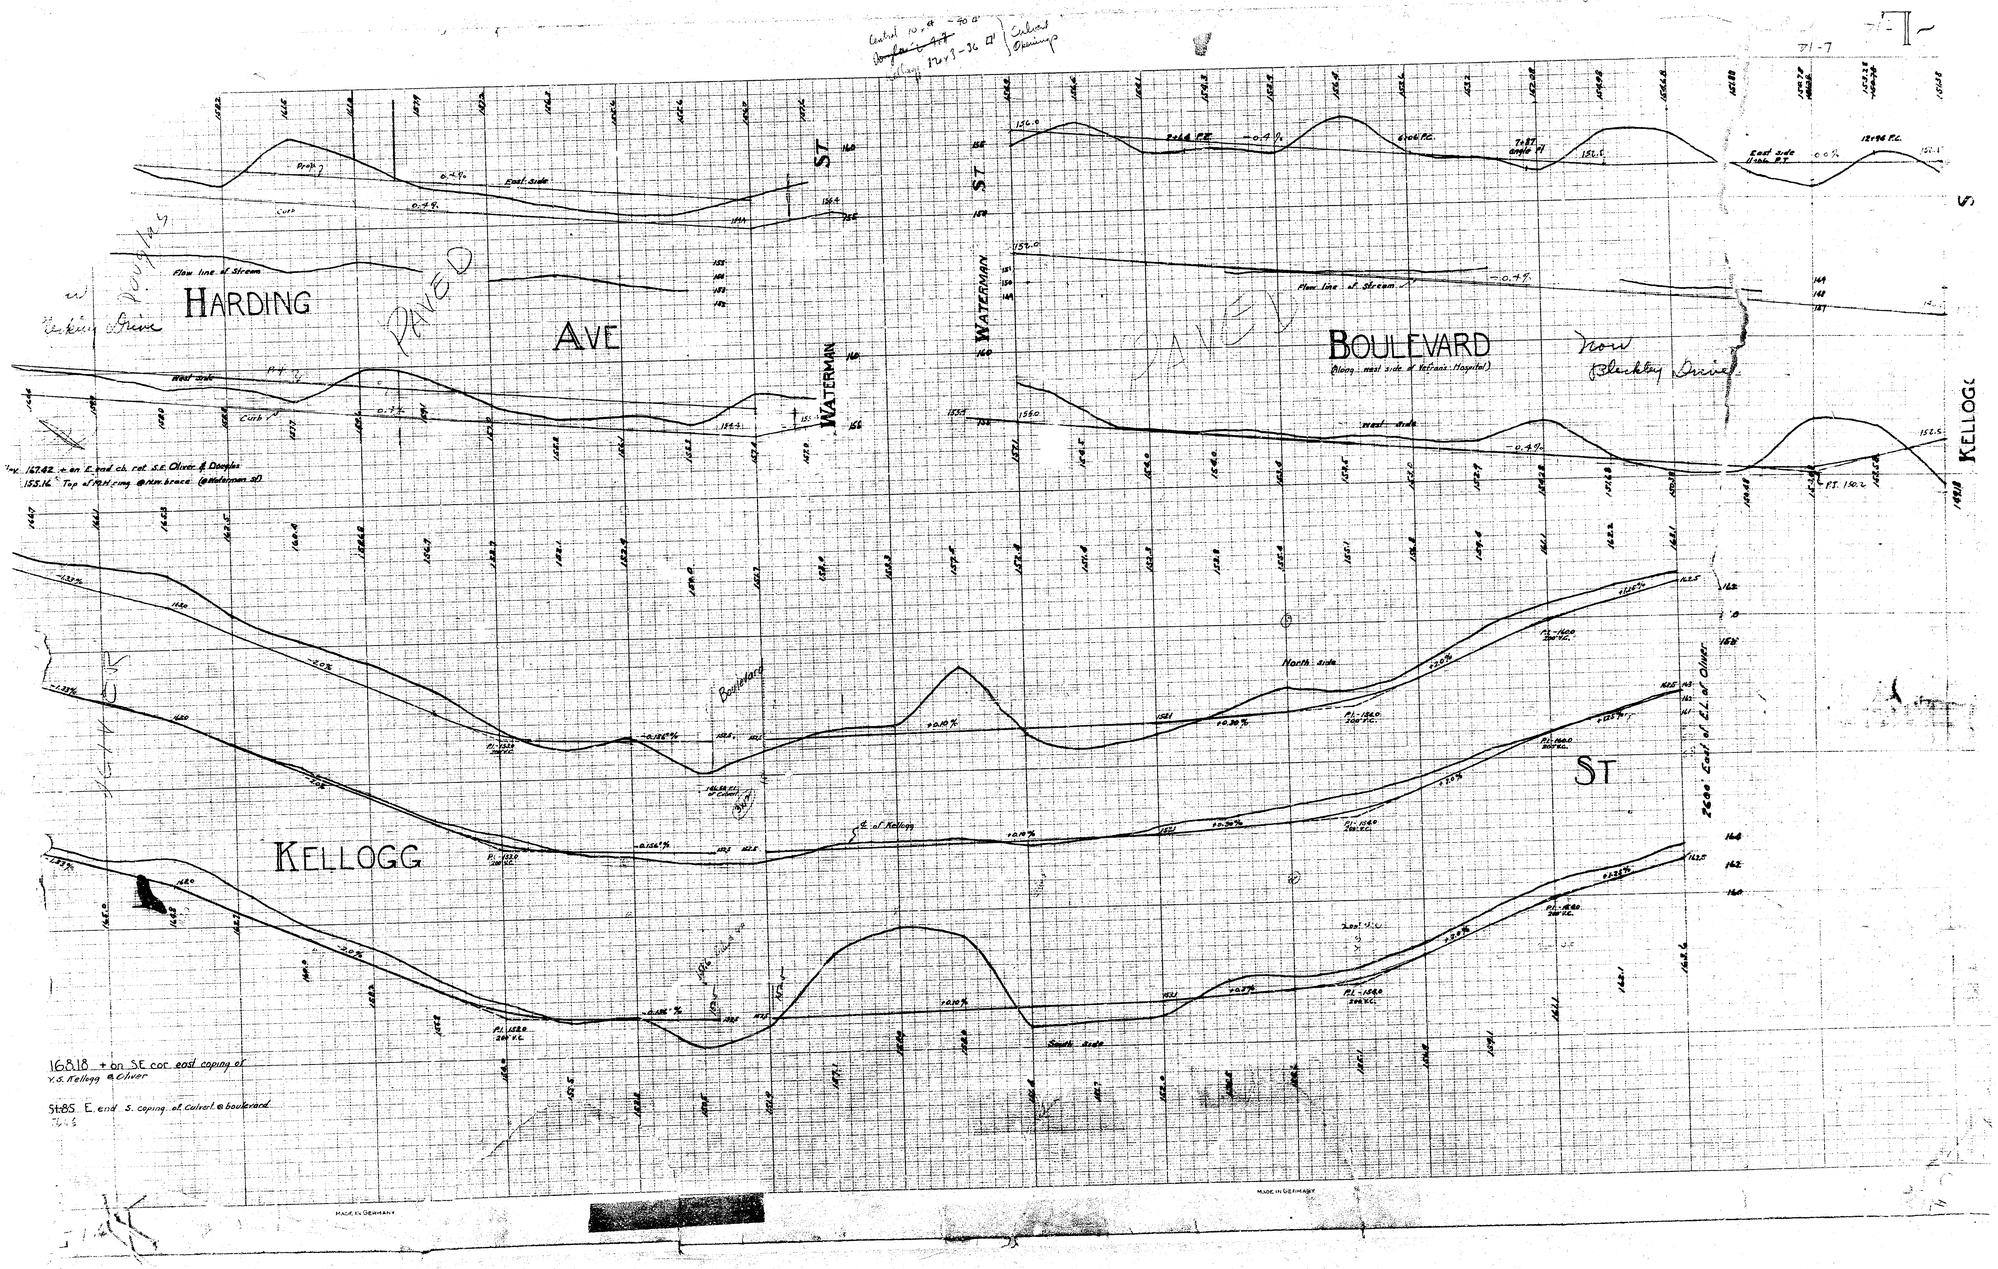
HARDING
AVE
PAVED
WATERMAN ST
BOULEVARD
KELLOGG
ST
Flow line of Stream
East side
West side
North side
South side
Boulevard
℄ of Kellogg
Culvert
16818 + on SE cor. east coping of Y.S. Kellogg & Oliver
St.85 E. end S. coping of Culvert & boulevard