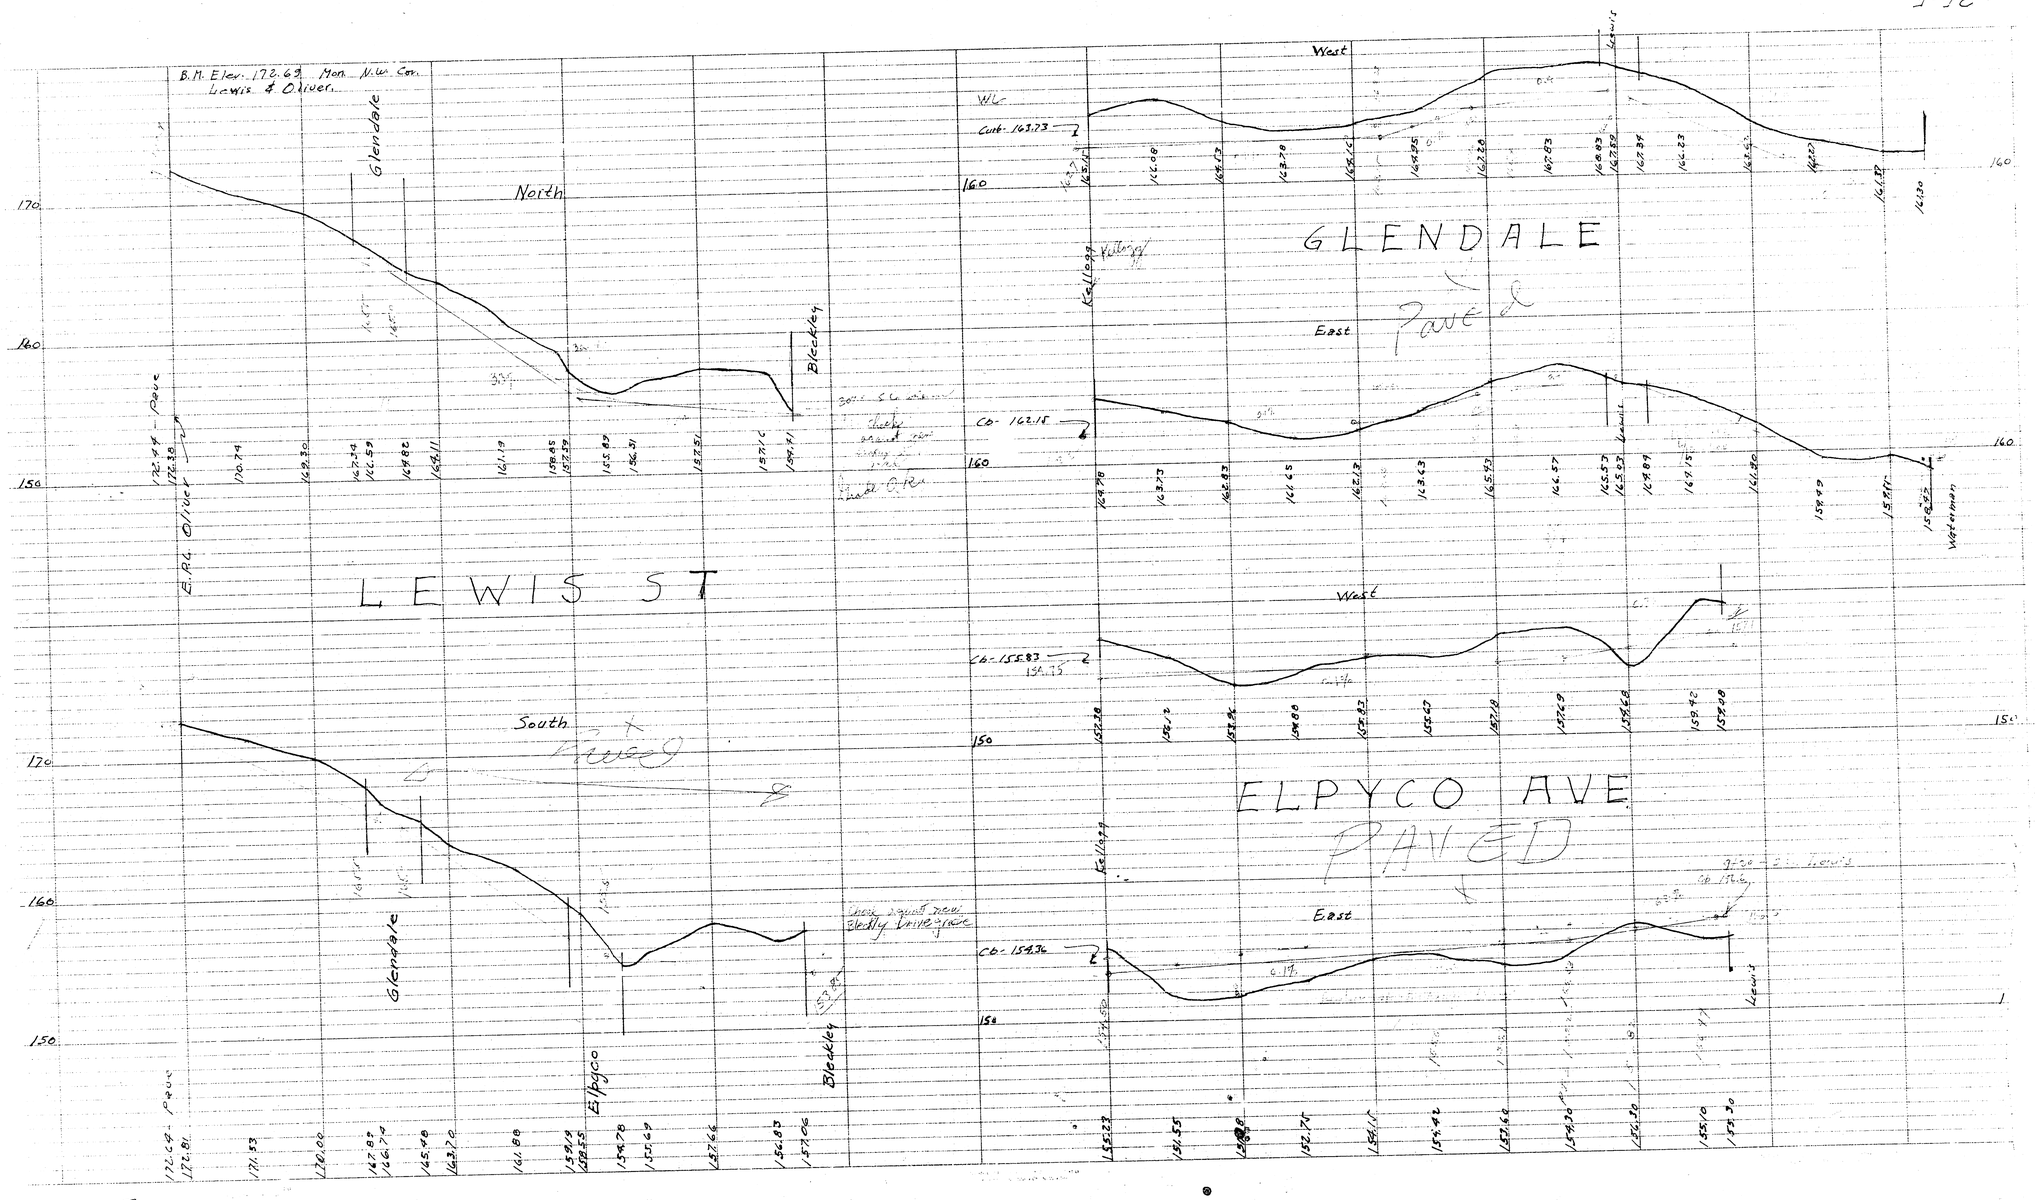
B.M. Elev. 172.69 Mon. N.W. Cor. Lewis & Oliver
LEWIS ST
North
South
Glendale
Blackley
Elpyco
E. Rd. Oliver
GLENDALE
West
East
Paved
WL
Curb 163.73
Kellogg
CL 162.18
ELPYCO AVE
PAVED
CL 155.83
CL 154.36
Lewis
Waterman
170
160
150