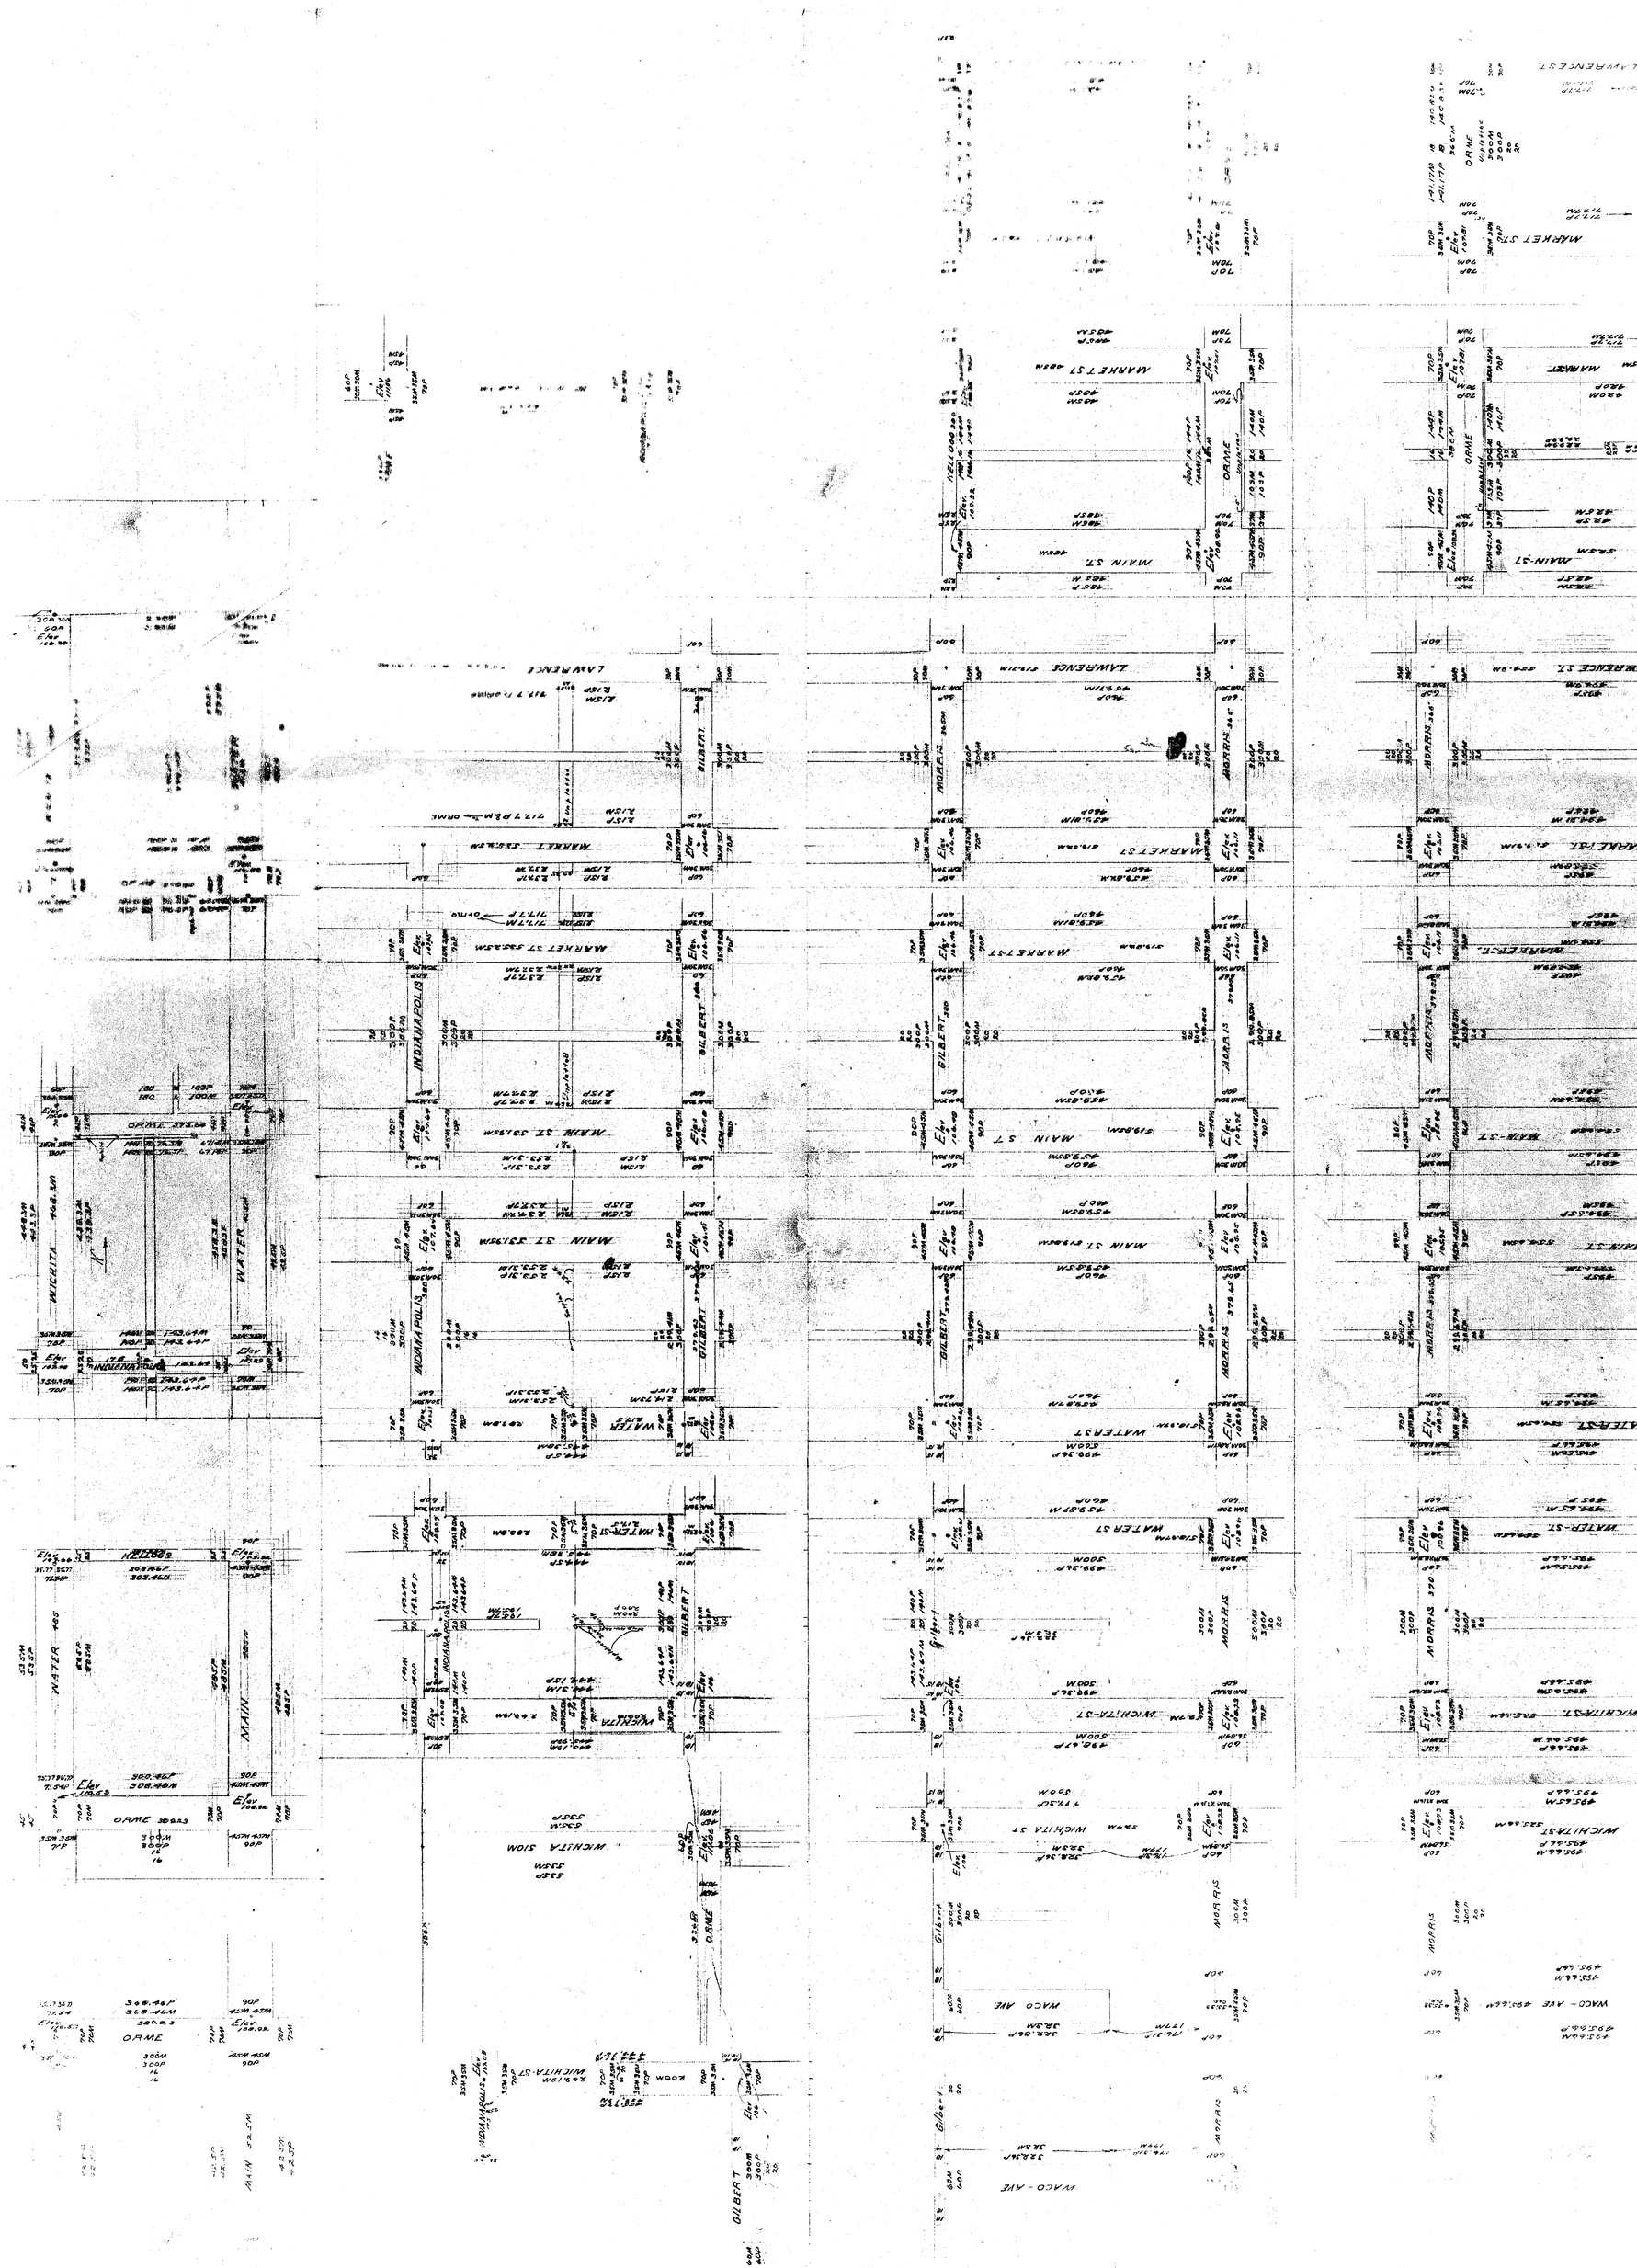
LAWRENCE ST
MARKET ST
ORME
MAIN ST
INDIANAPOLIS
GILBERT
MORRIS
WATER ST
WICHITA ST
WACO AVE
WATER
MAIN

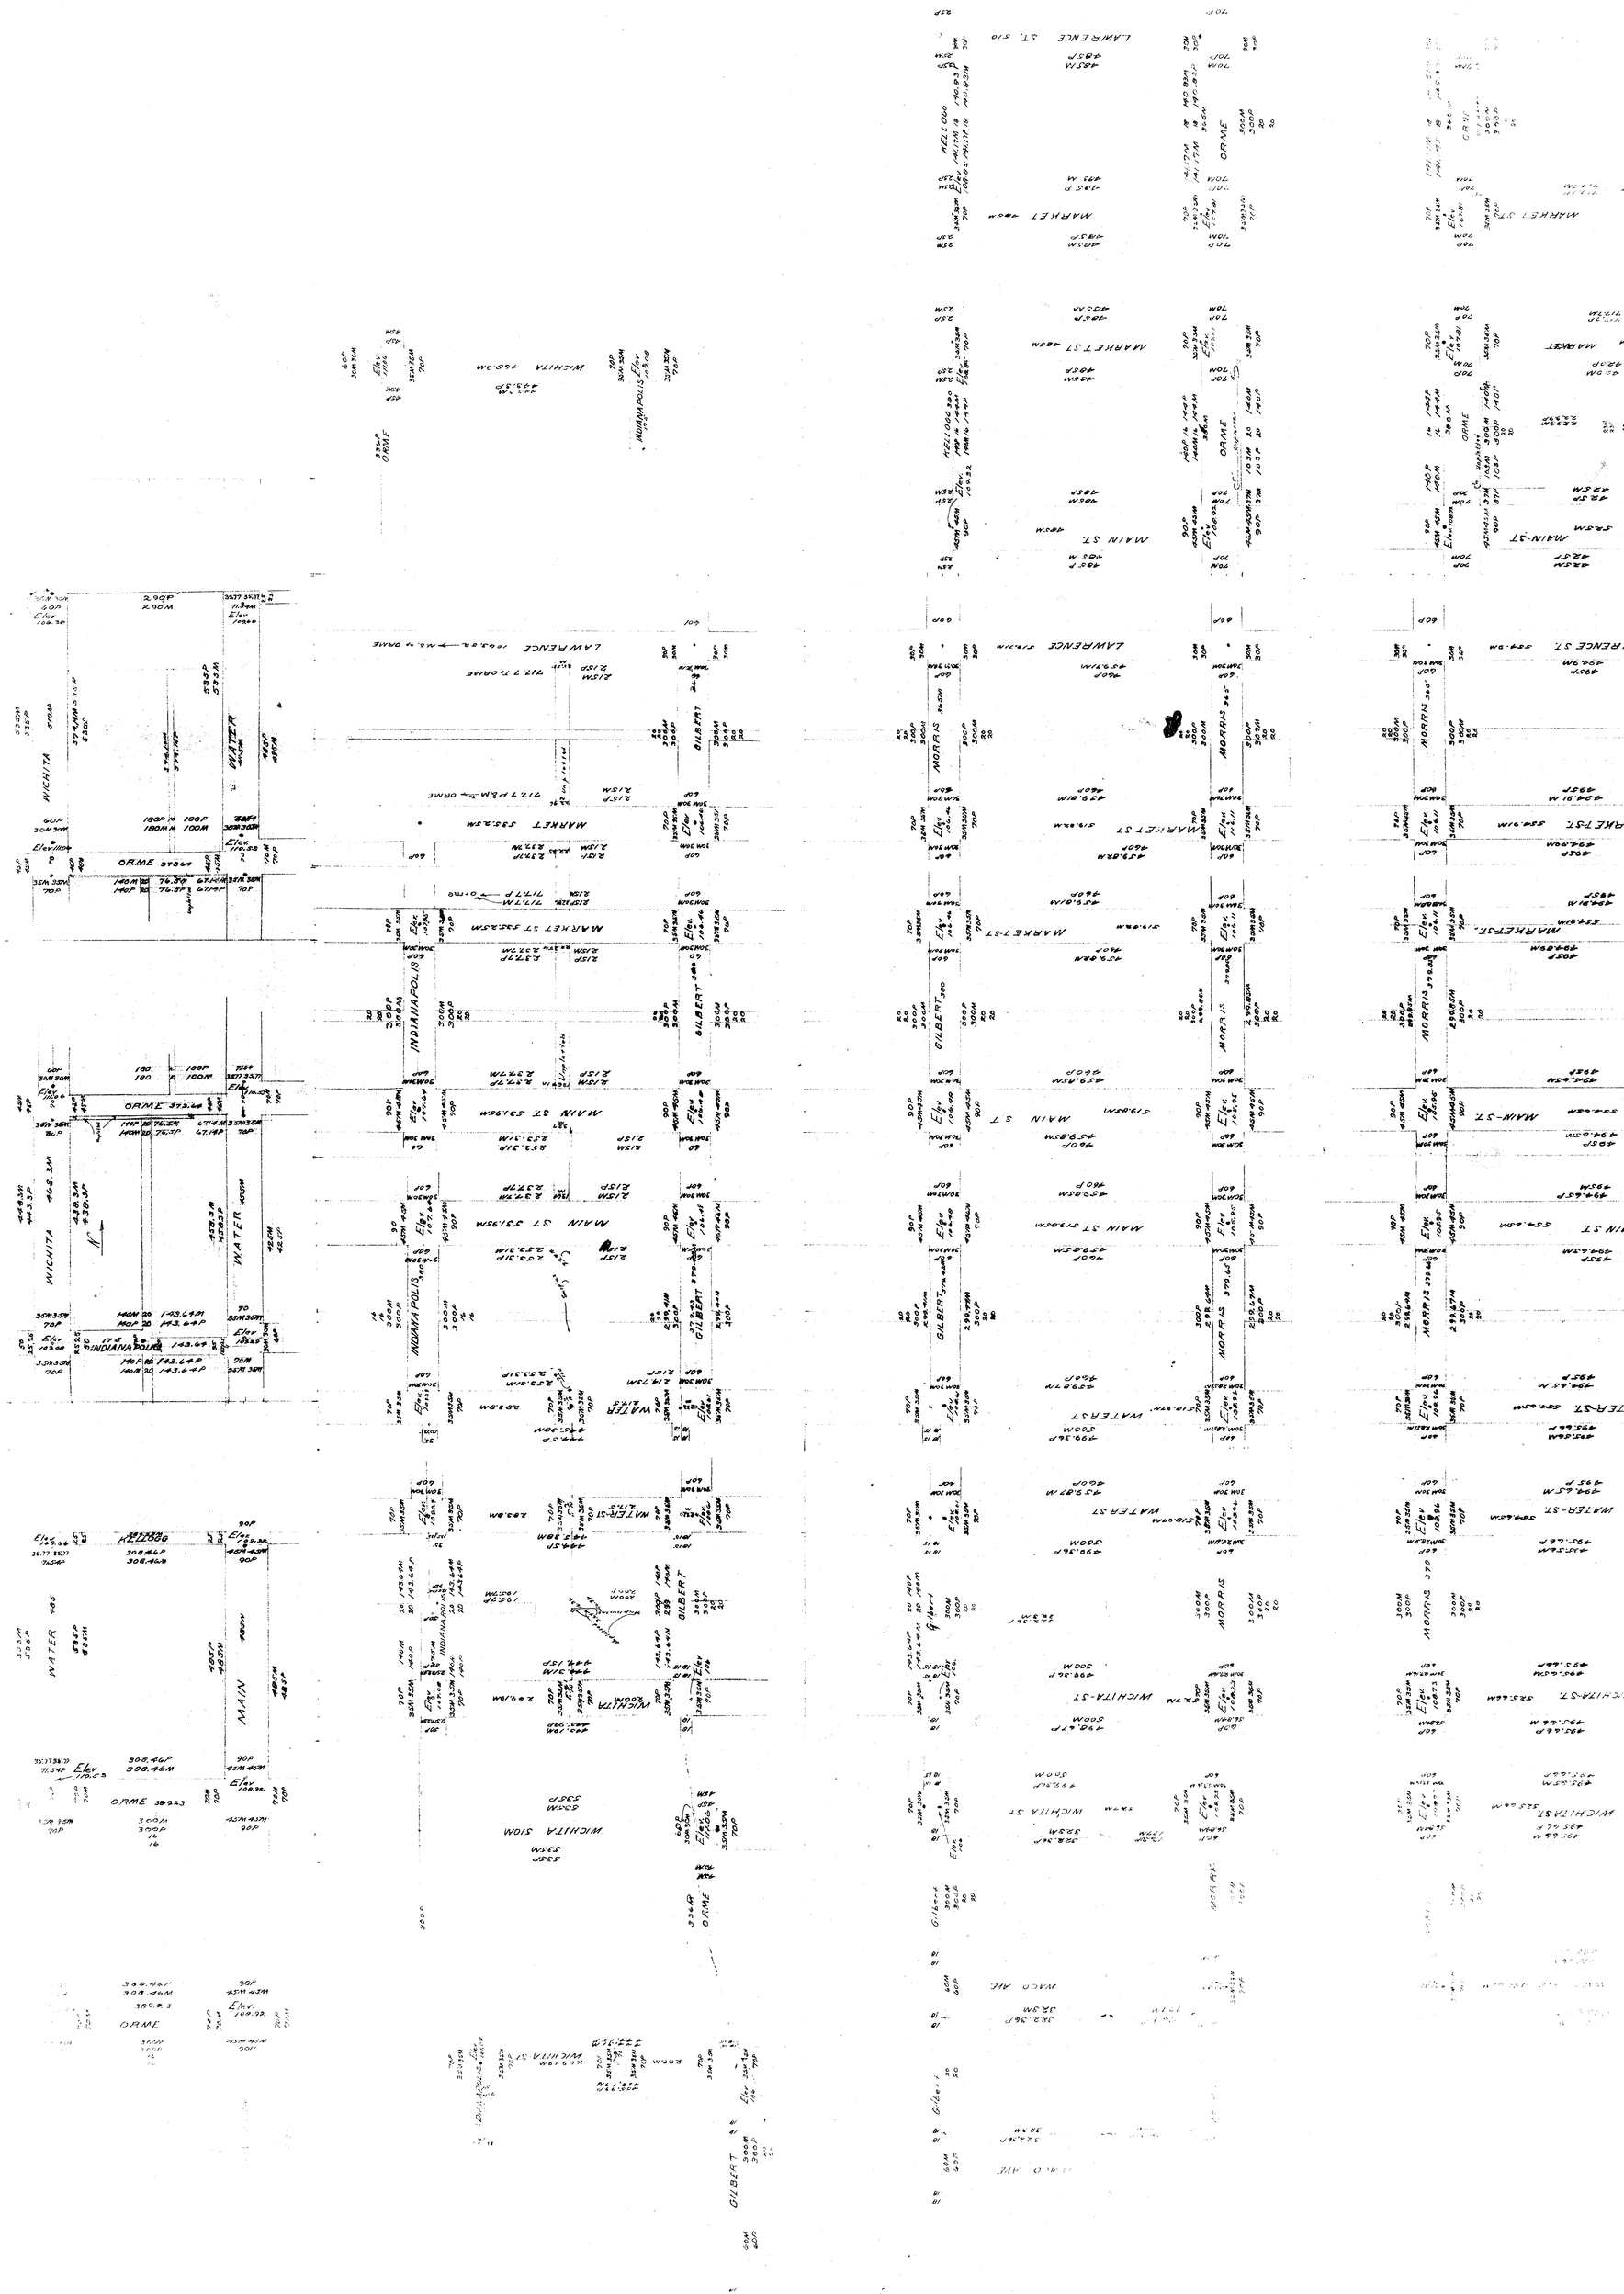
WICHITA
WATER
ORME
INDIANAPOLIS
MAIN
KELLOGG
MARKET
LAWRENCE
GILBERT
MORRIS
MAIN ST
MARKET ST
WATER ST
WICHITA ST

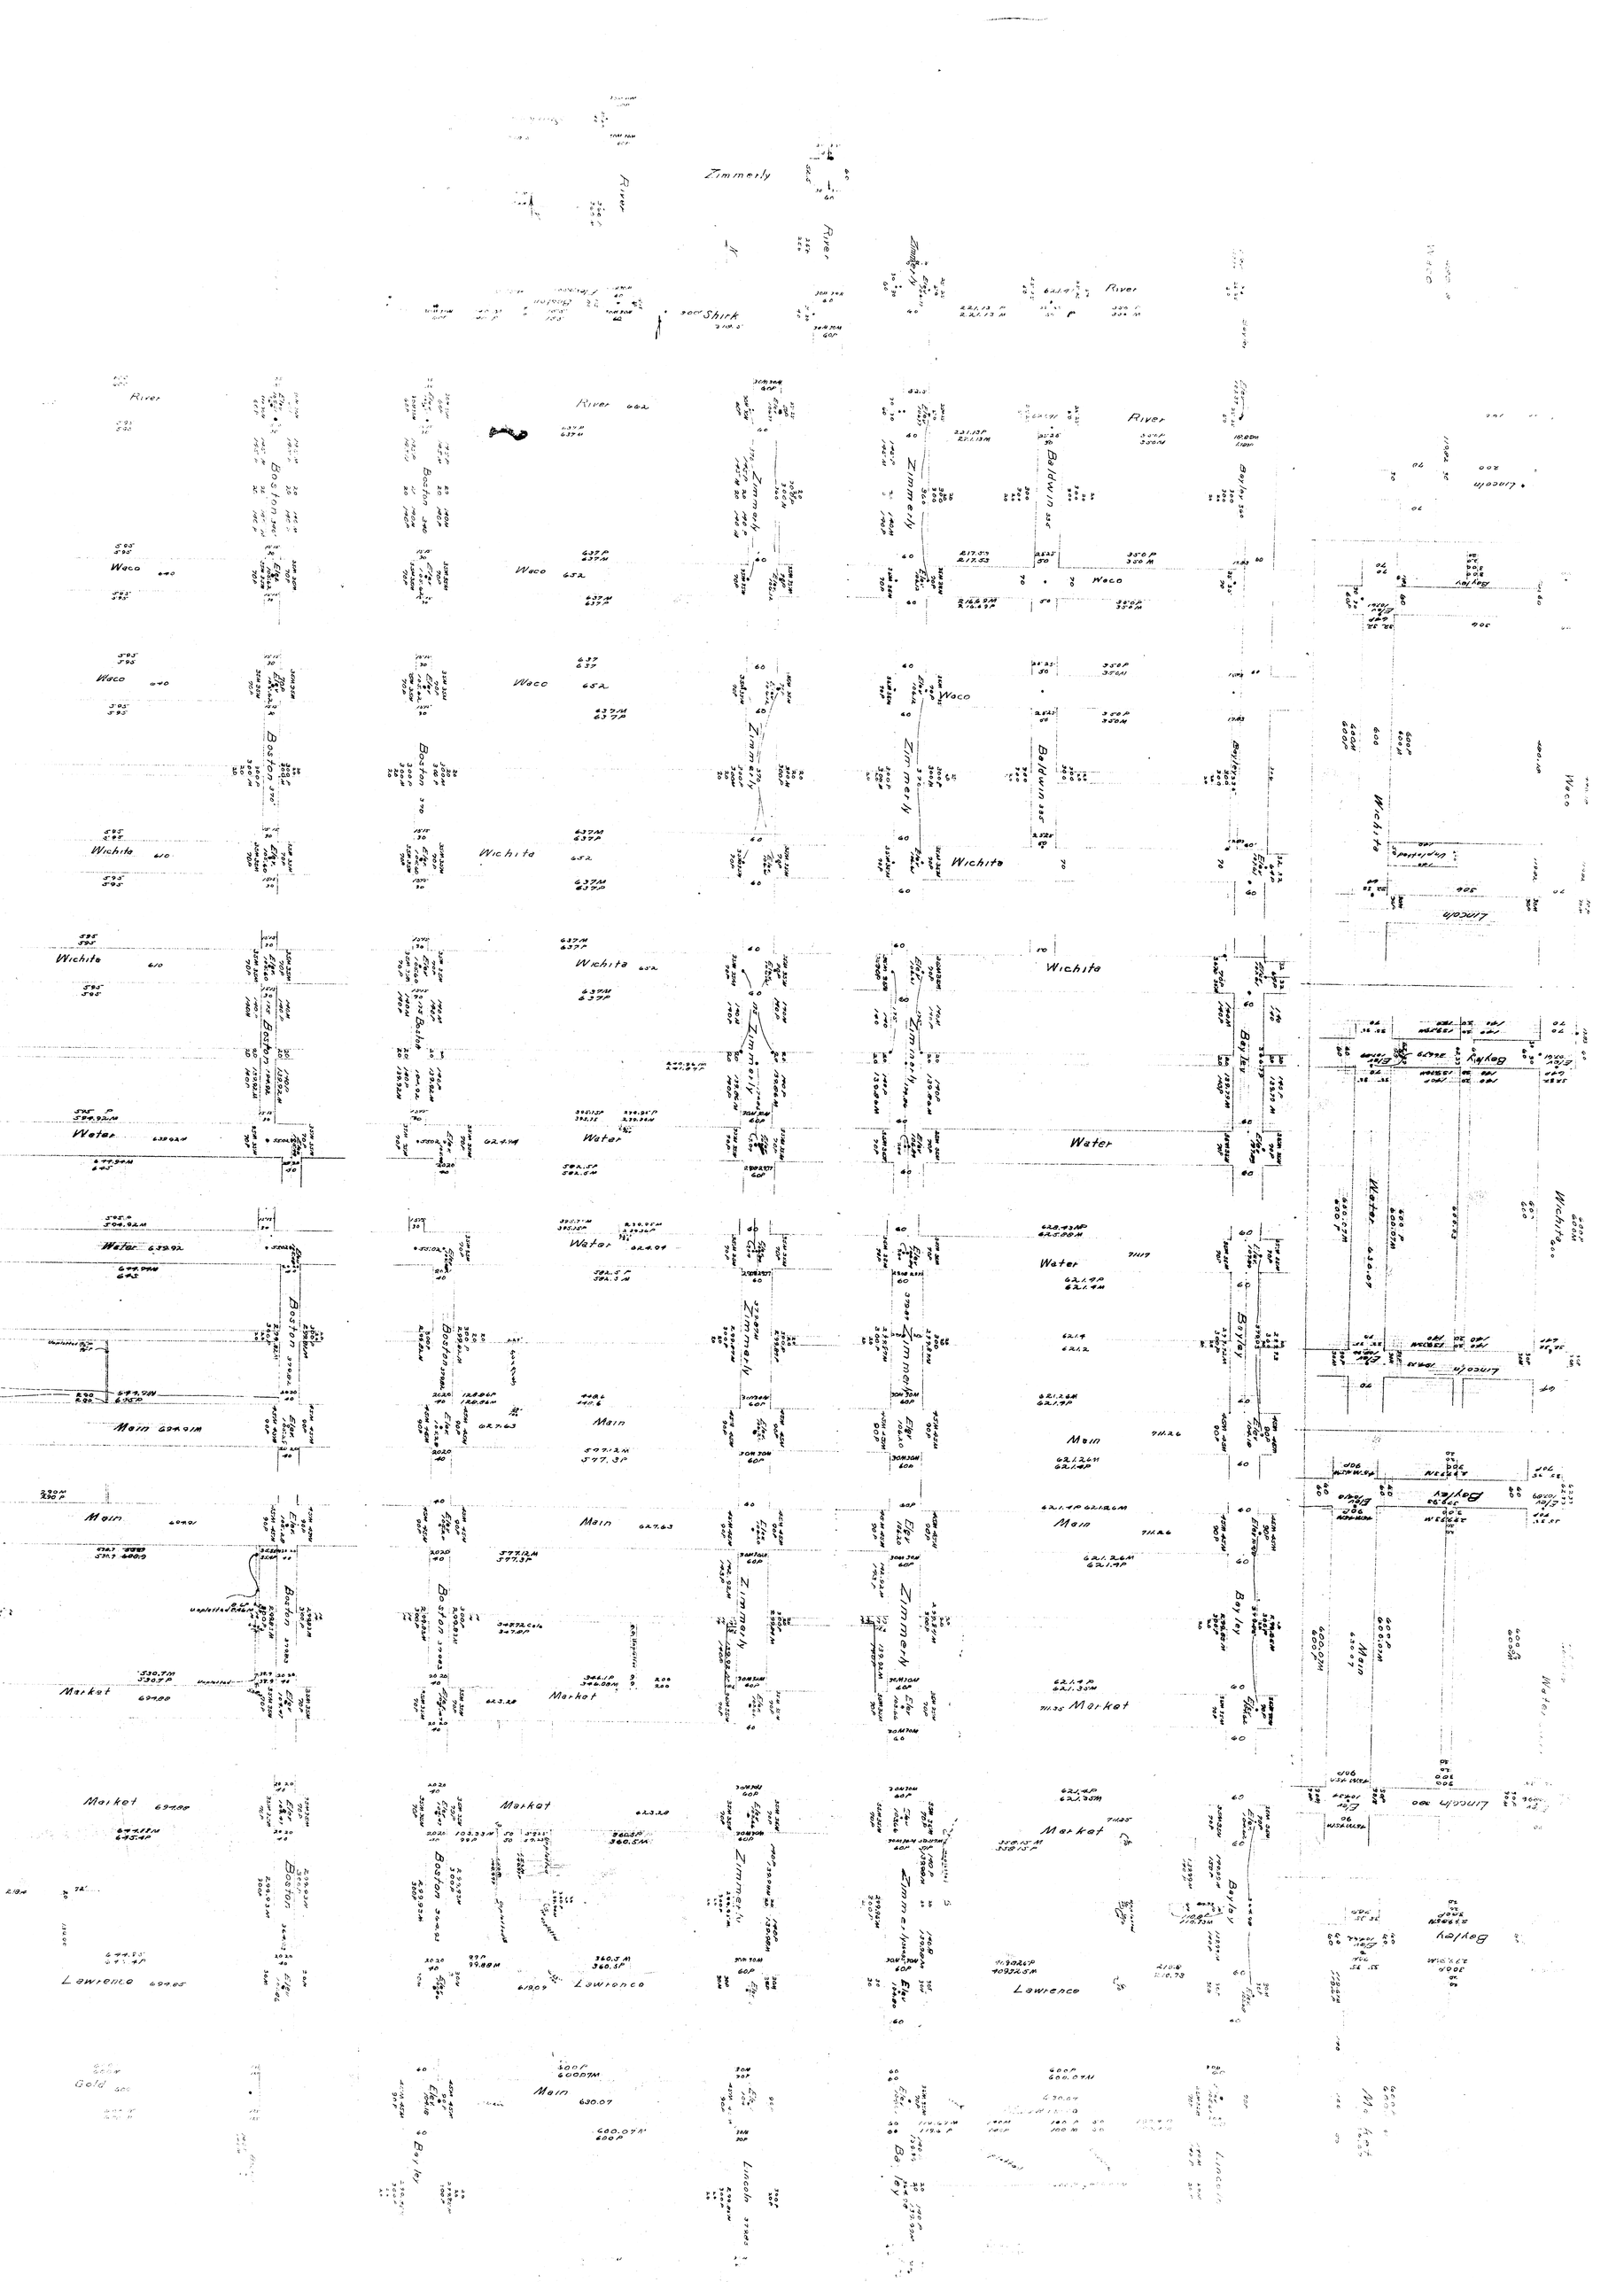
Zimmerly
River
Shirk
Baldwin
Bayley
Lincoln
Waco
Wichita
Boston
Elk
Water
Main
Market
Lawrence
Gold
Rykog

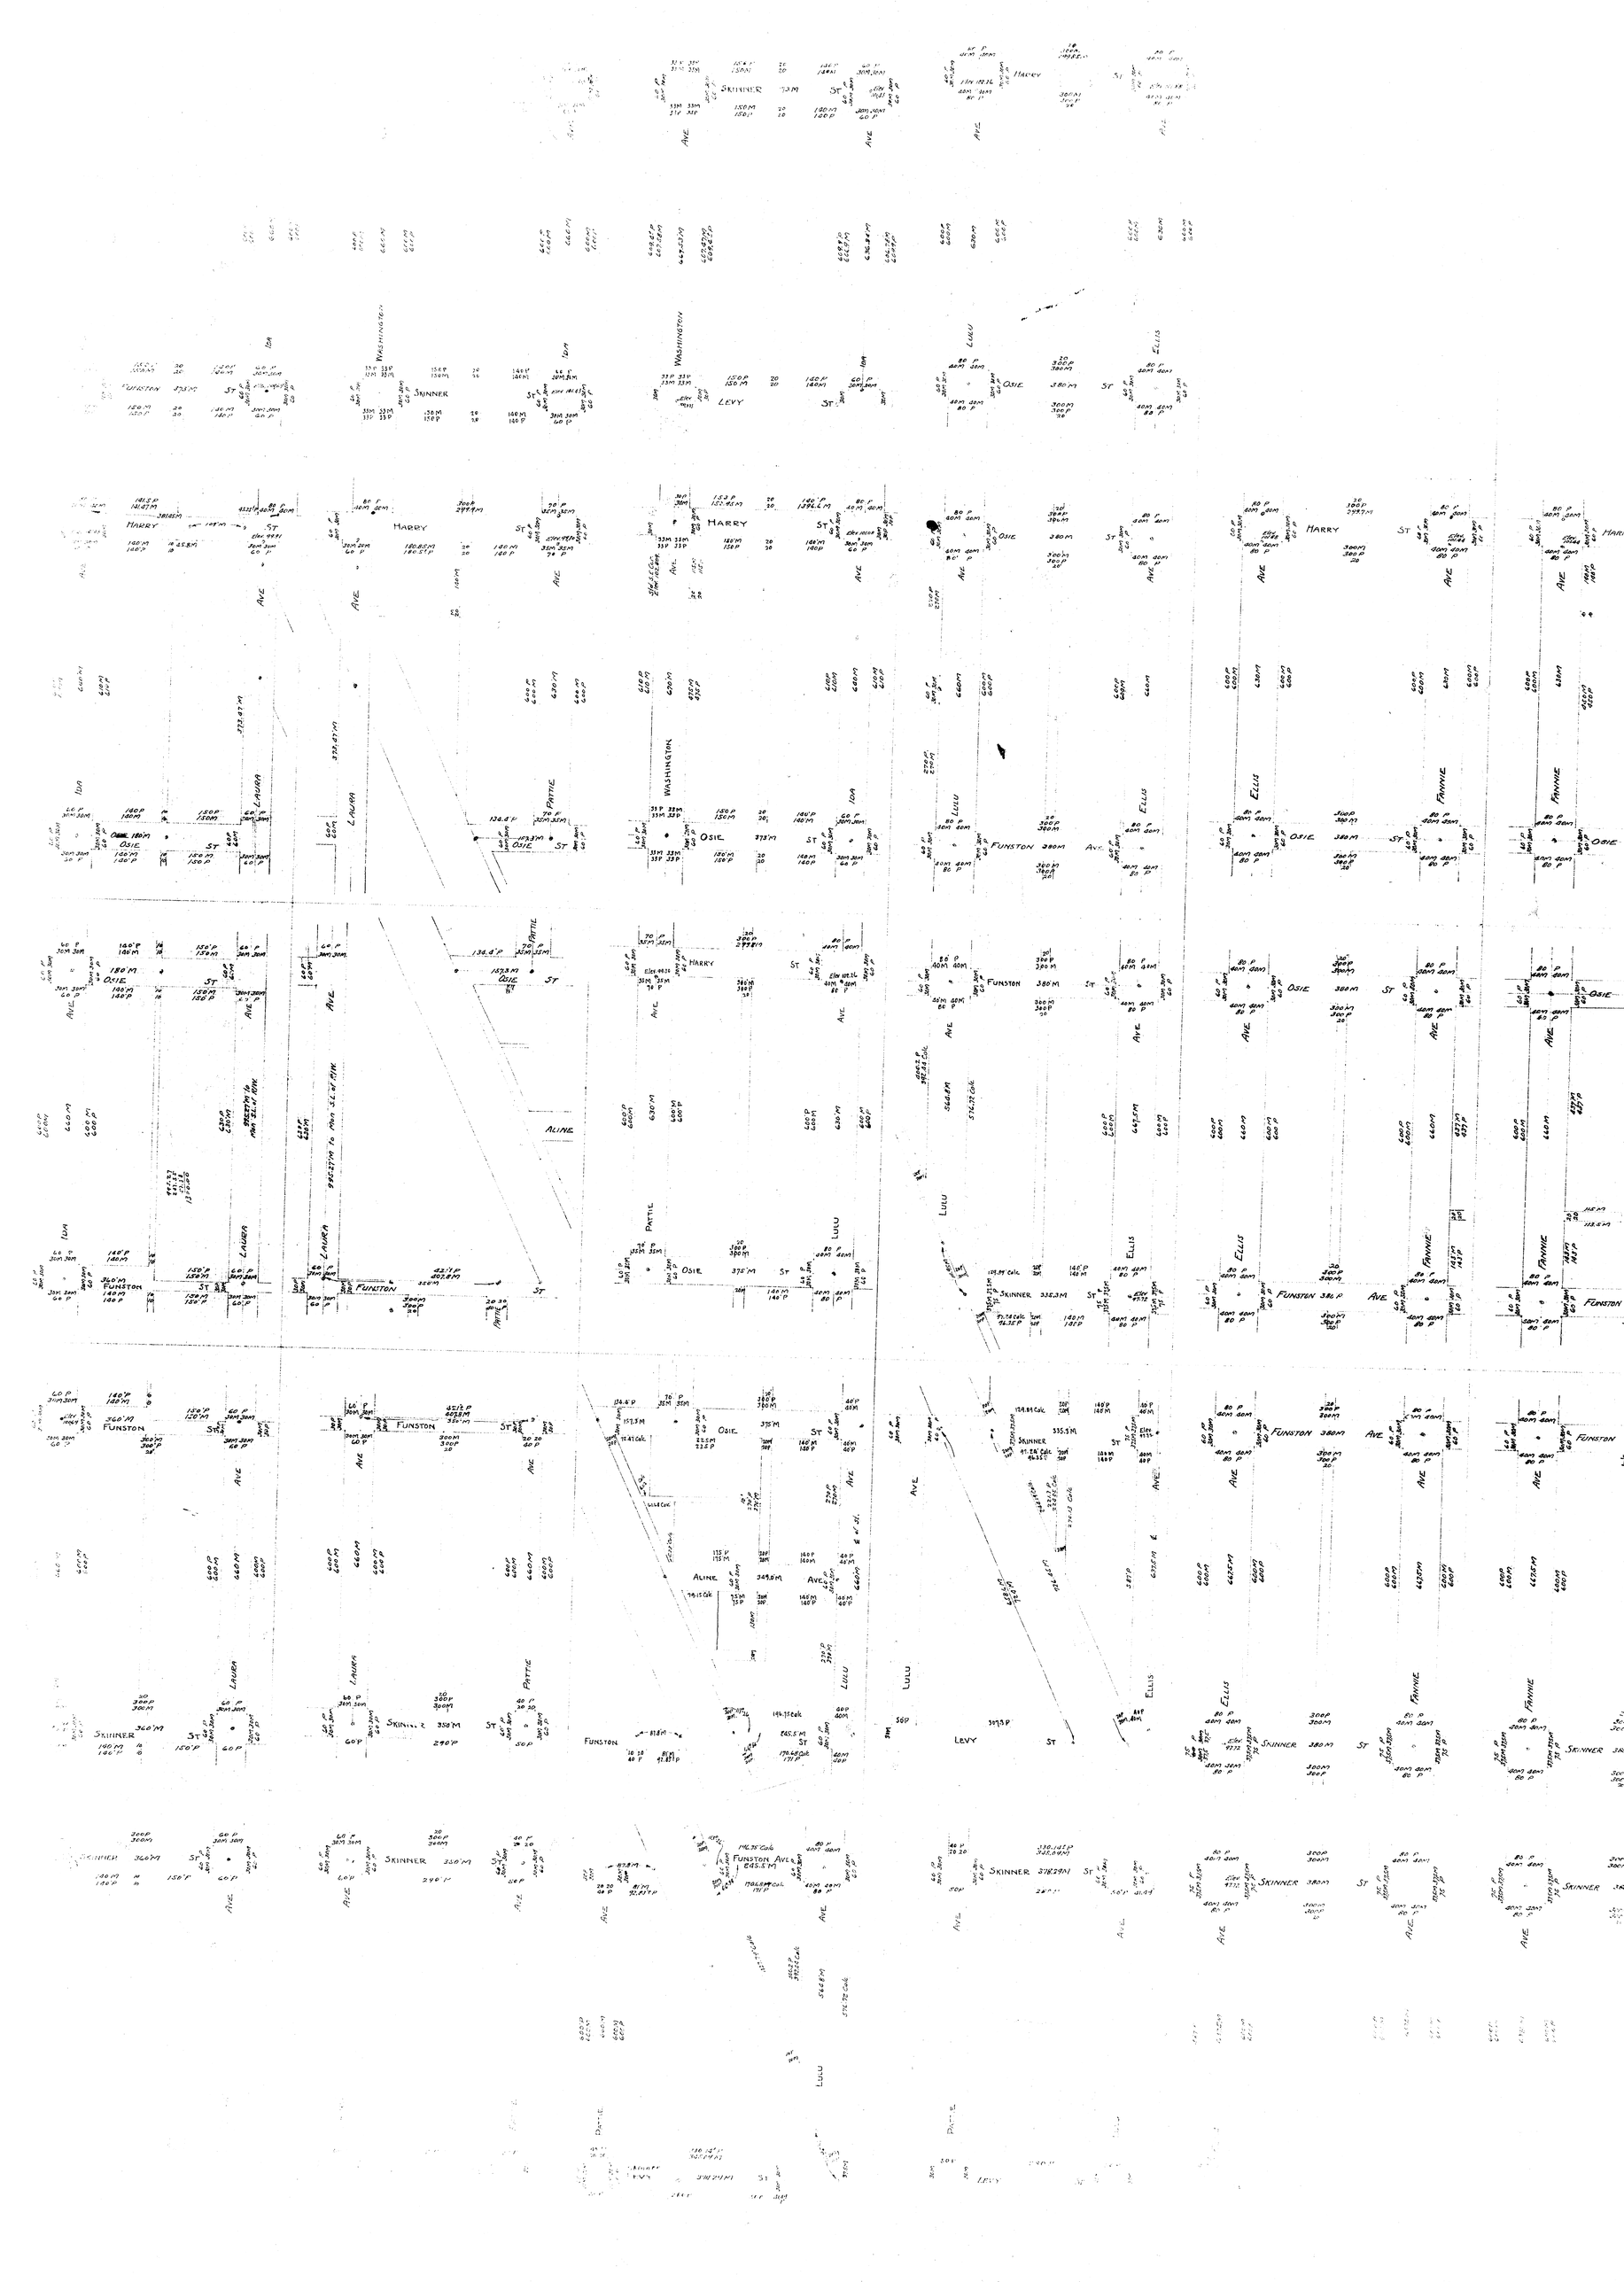
SKINNER
HARRY
WASHINGTON
LEVY
LULU
OSIE
ELLIS
FANNIE
FUNSTON
LAURA
PATTIE
ALINE
AVE
ST

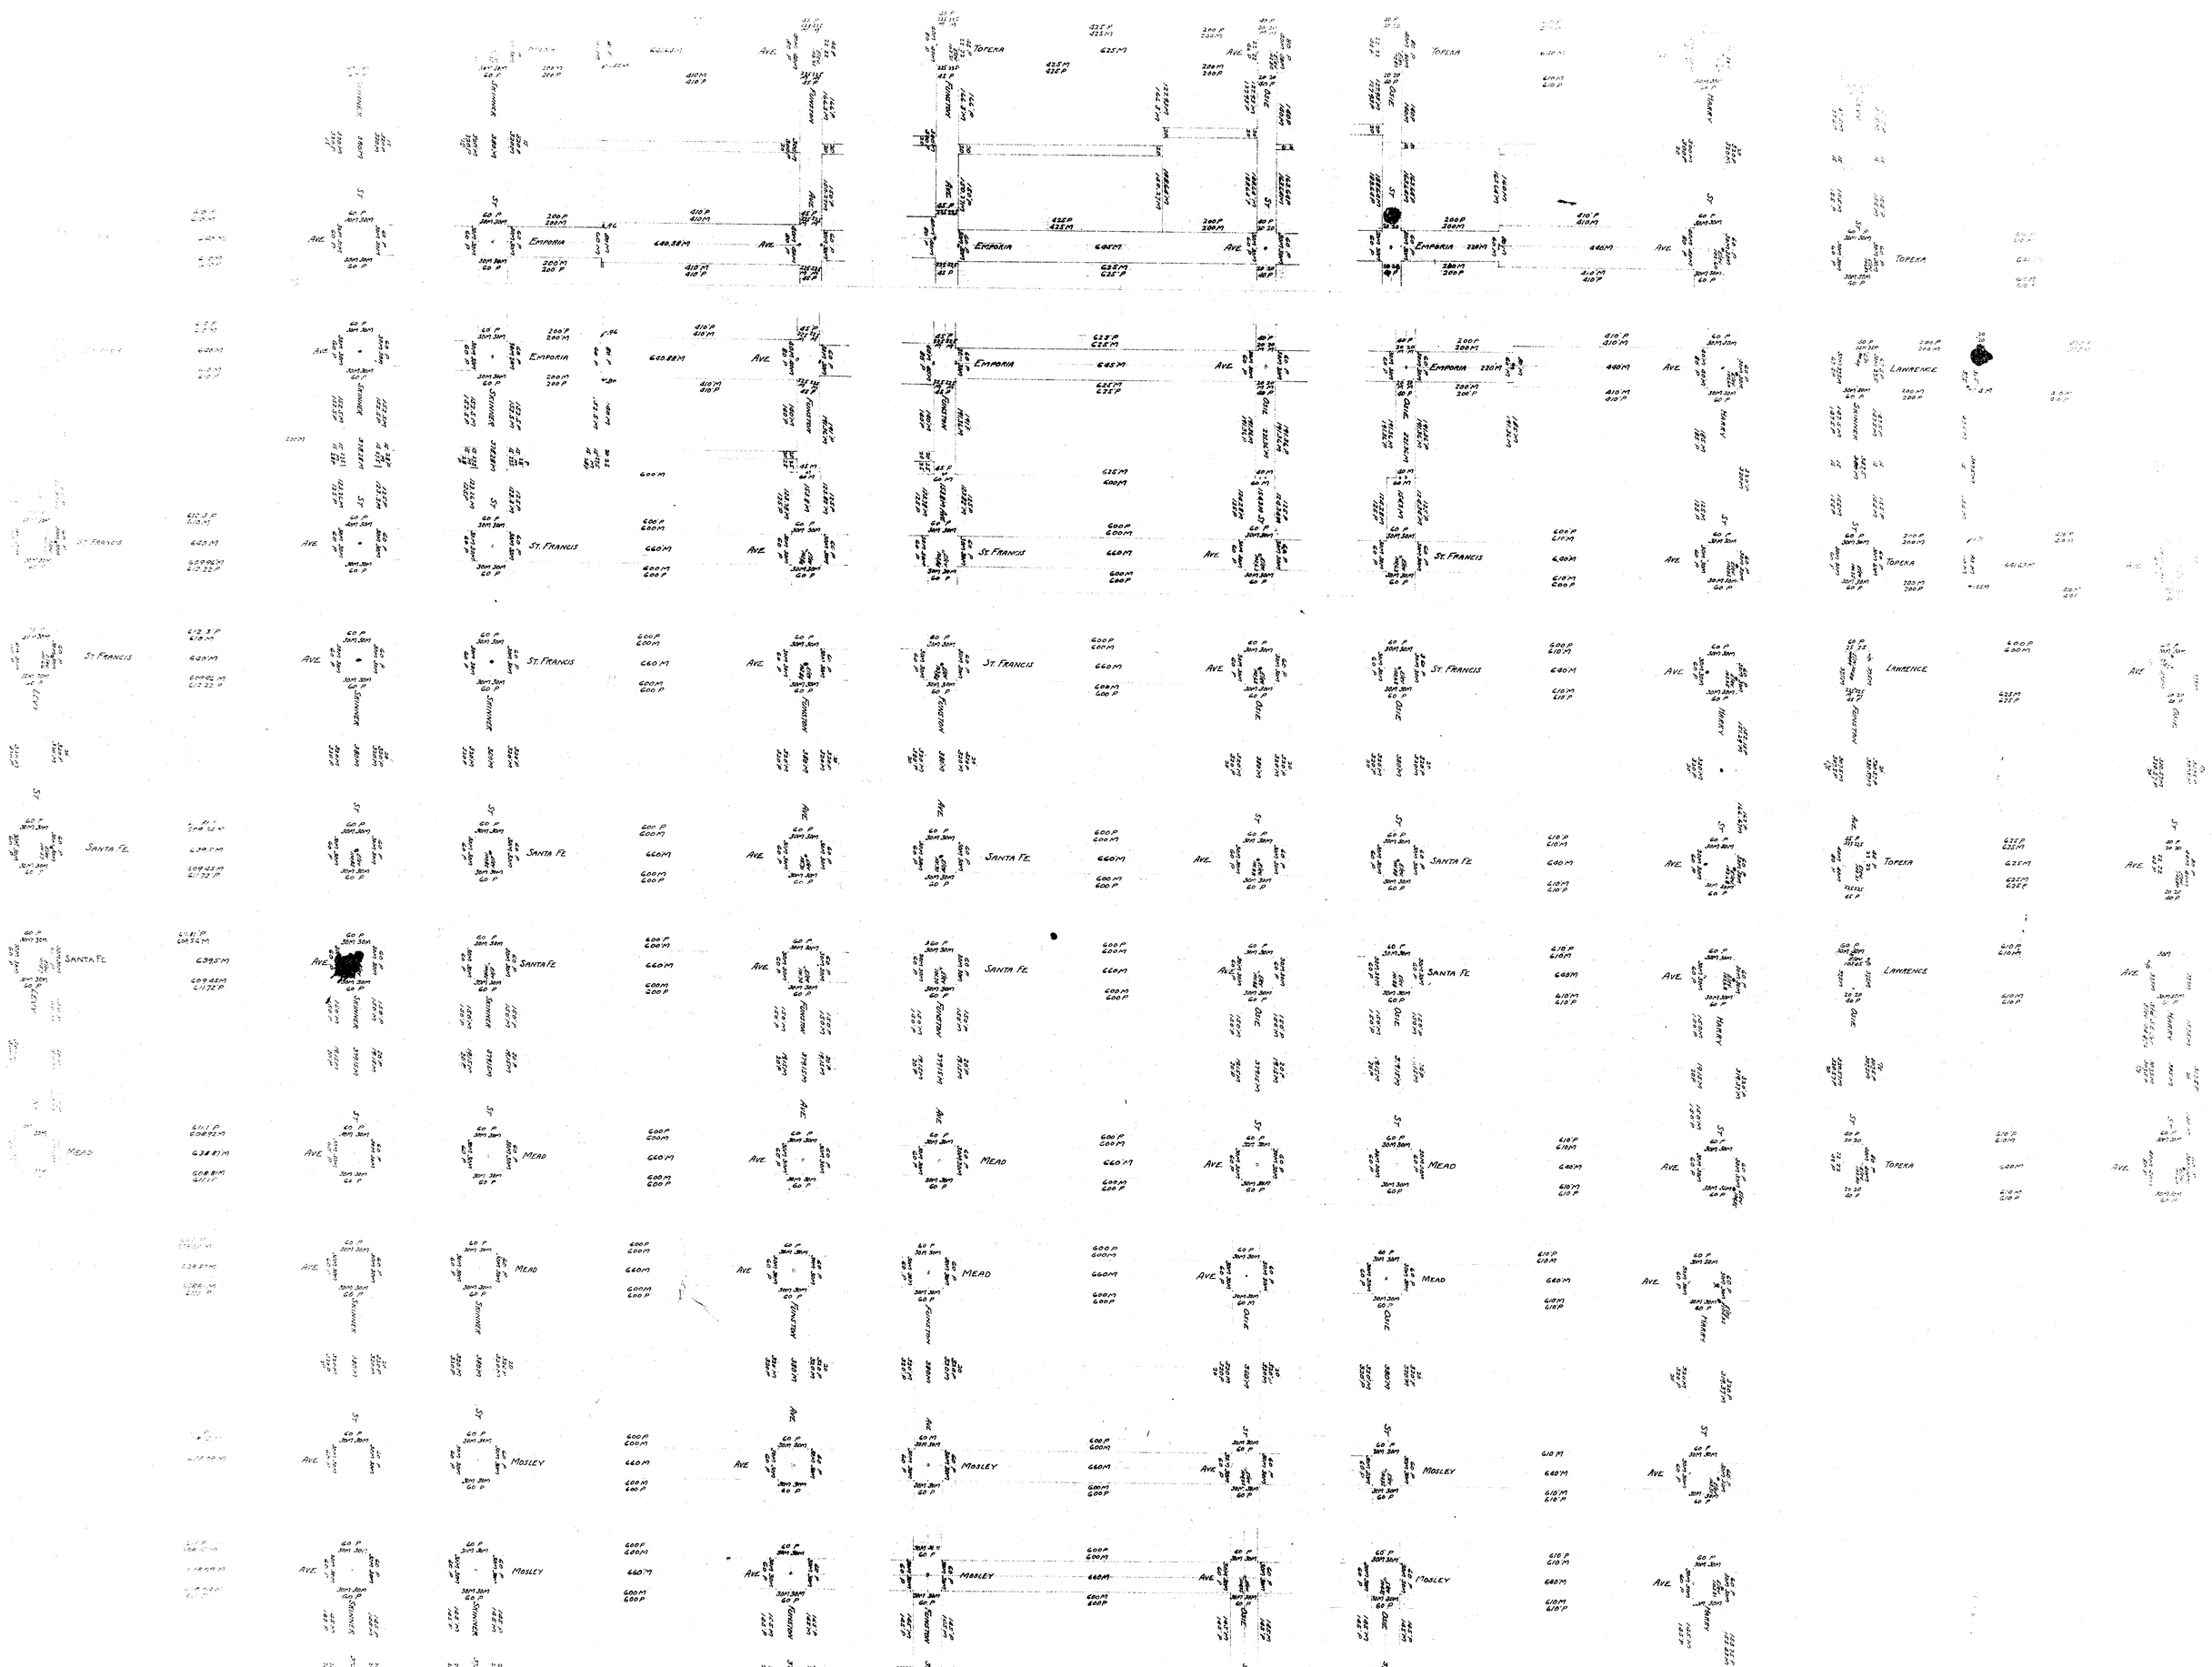
Topeka
Emporia
St. Francis
Santa Fe
Mead
Mosley
Lawrence
Ave
St
Spinner
Funston
Harry

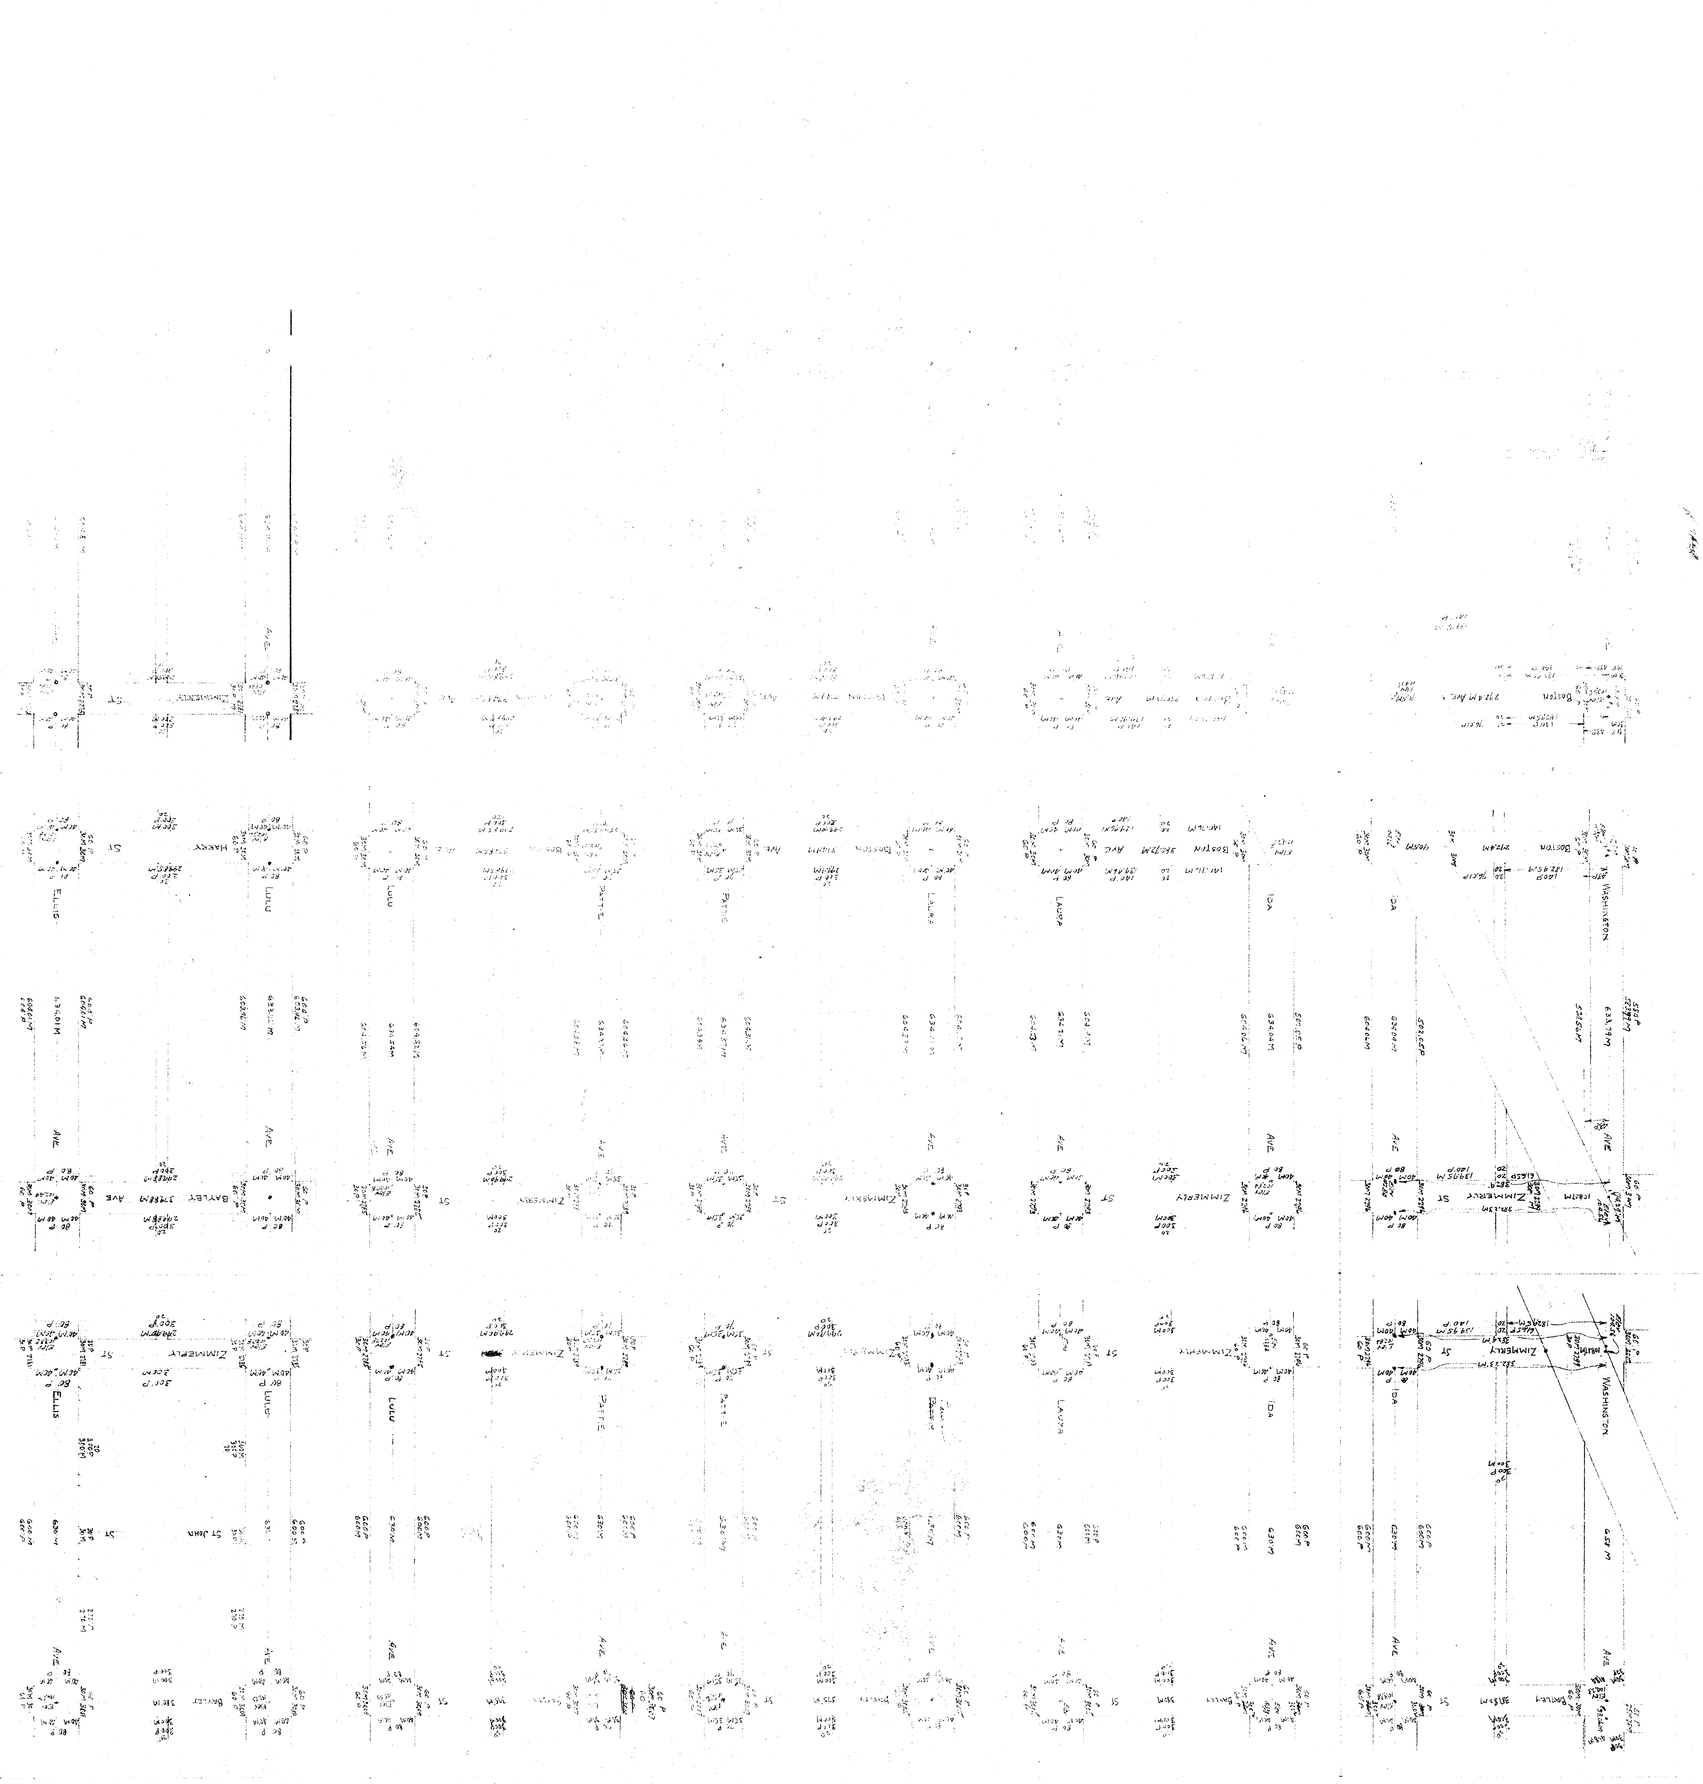
WASHINGTON
IDA
ZIMMERLY
LAUPP
BOSTON
PATTEE
LUCU
ELLIS
GAYLEY
ST JOHN
AVE
ST

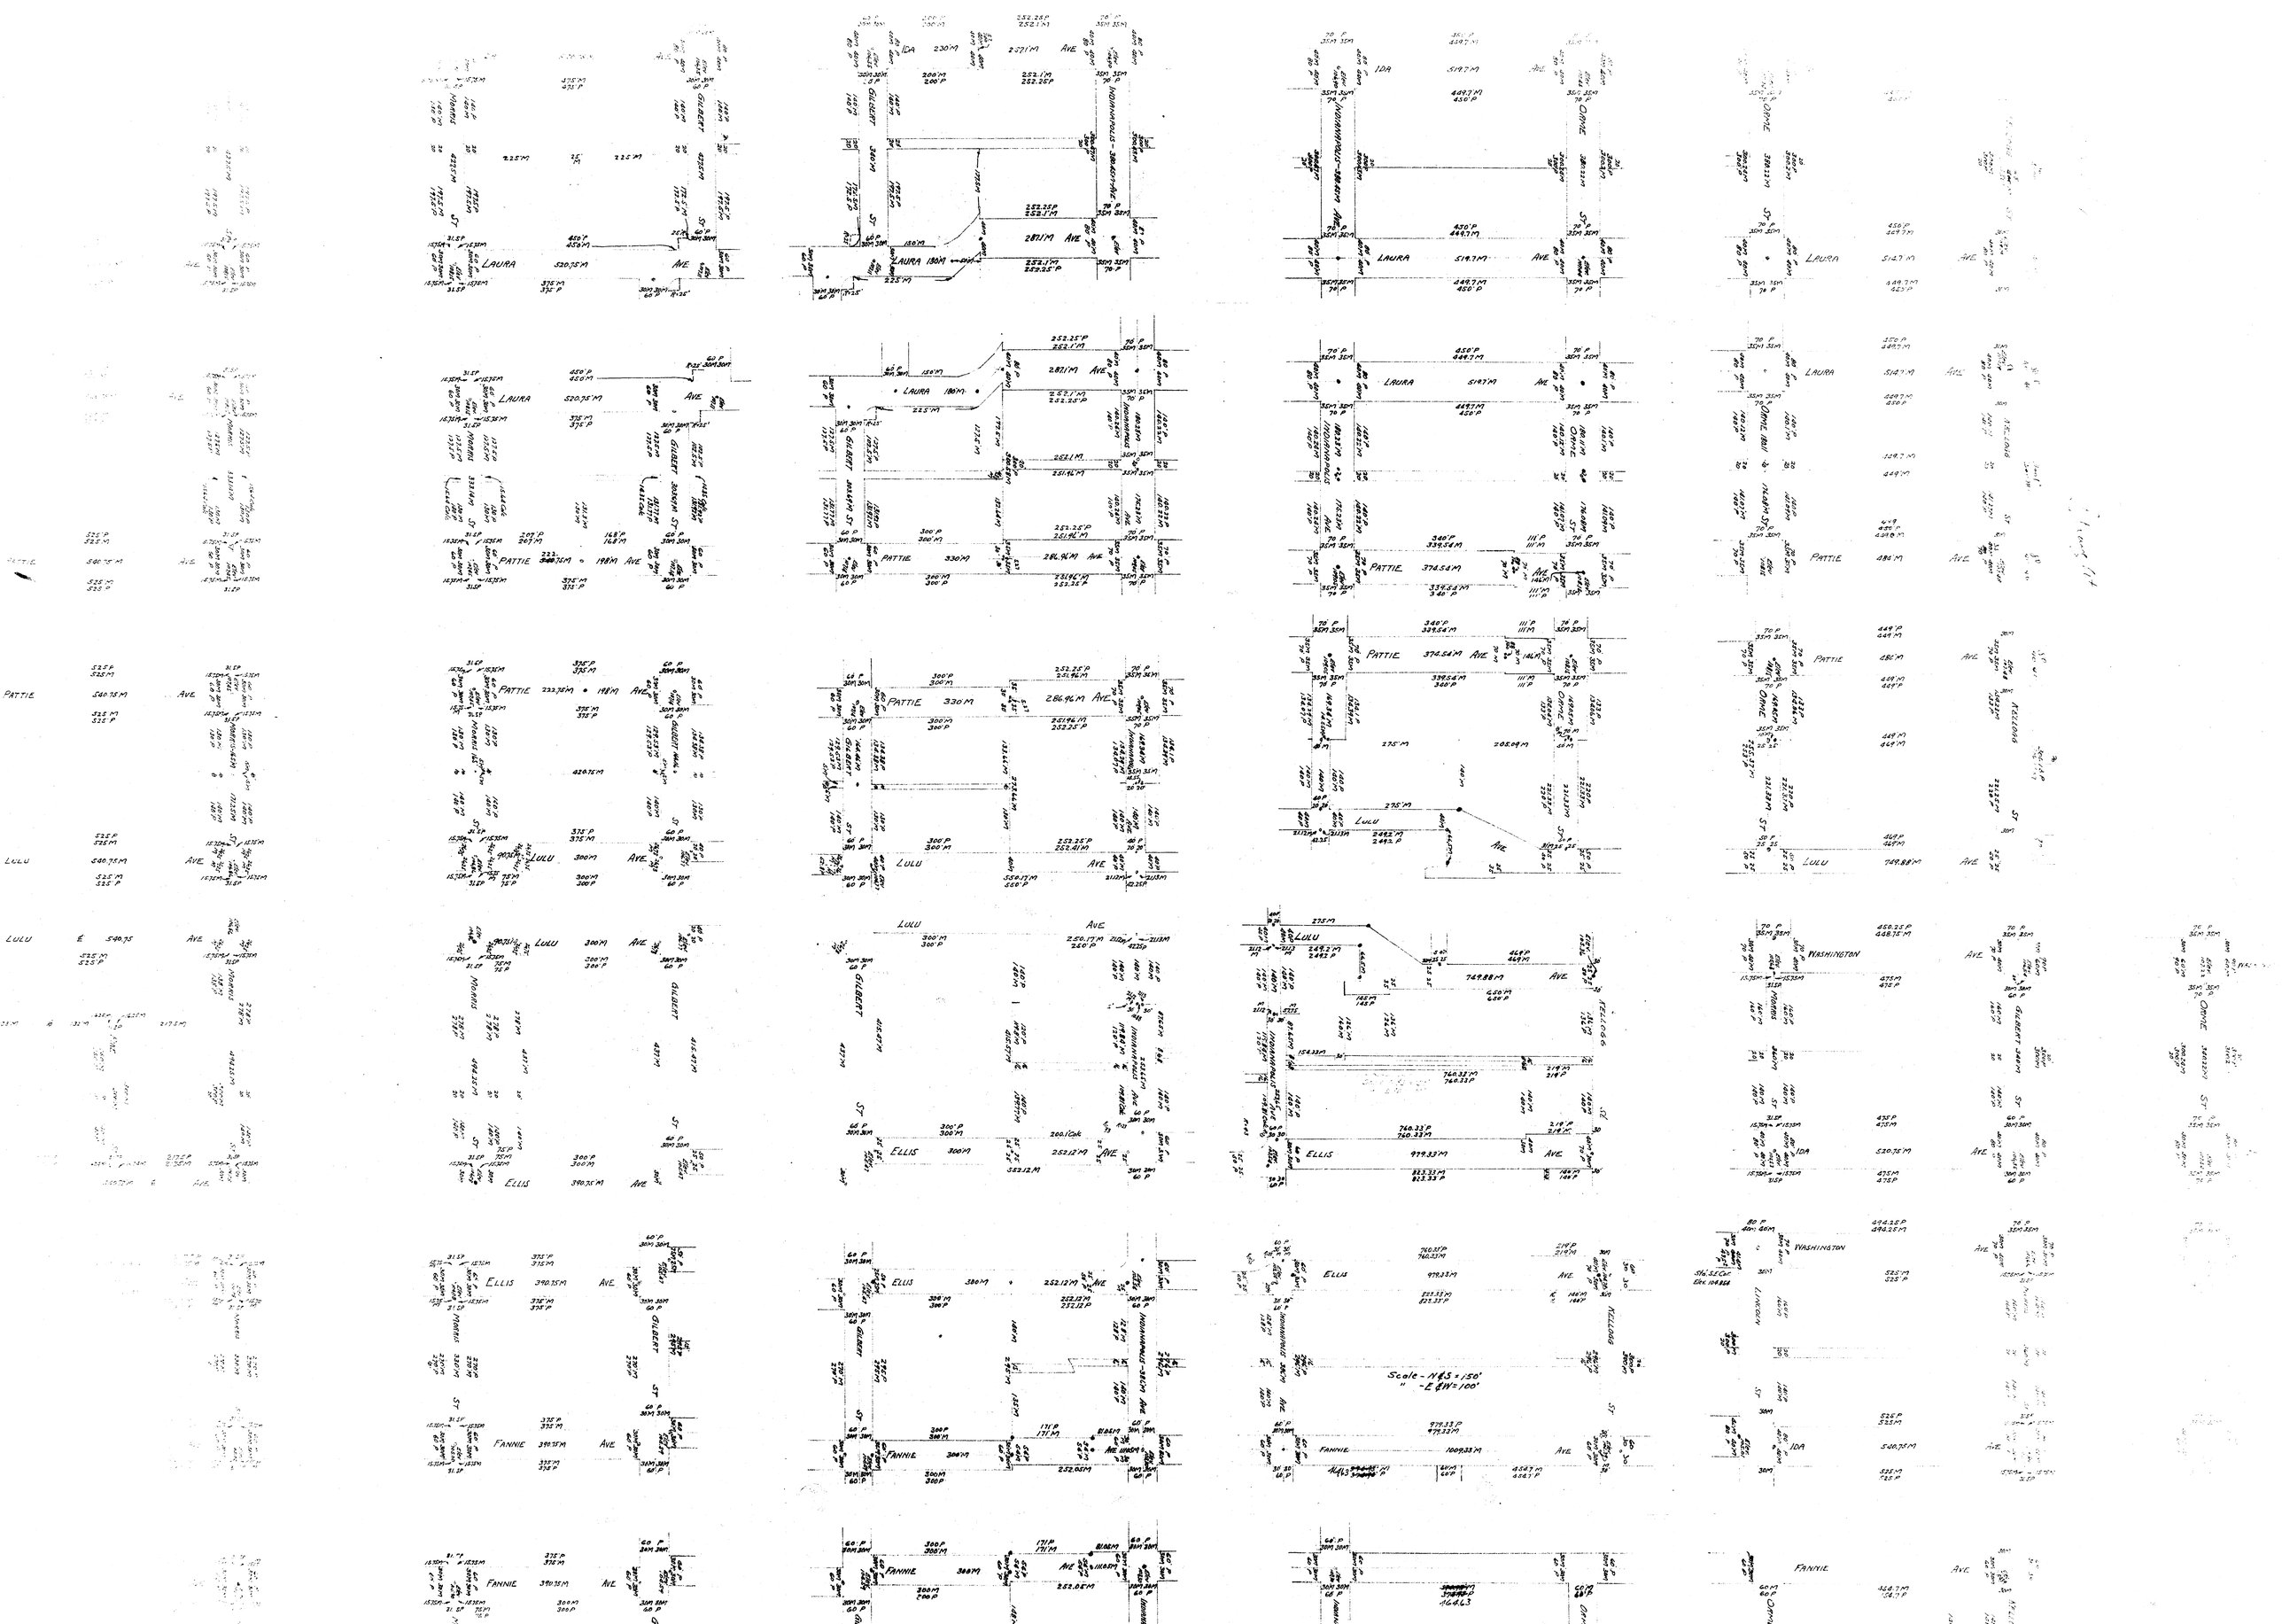
IDA
LAURA
PATTIE
LULU
ELLIS
FANNIE
WASHINGTON
GILBERT ST
Scale - N & S = 150'
" - E & W = 100'

Straight

Straight

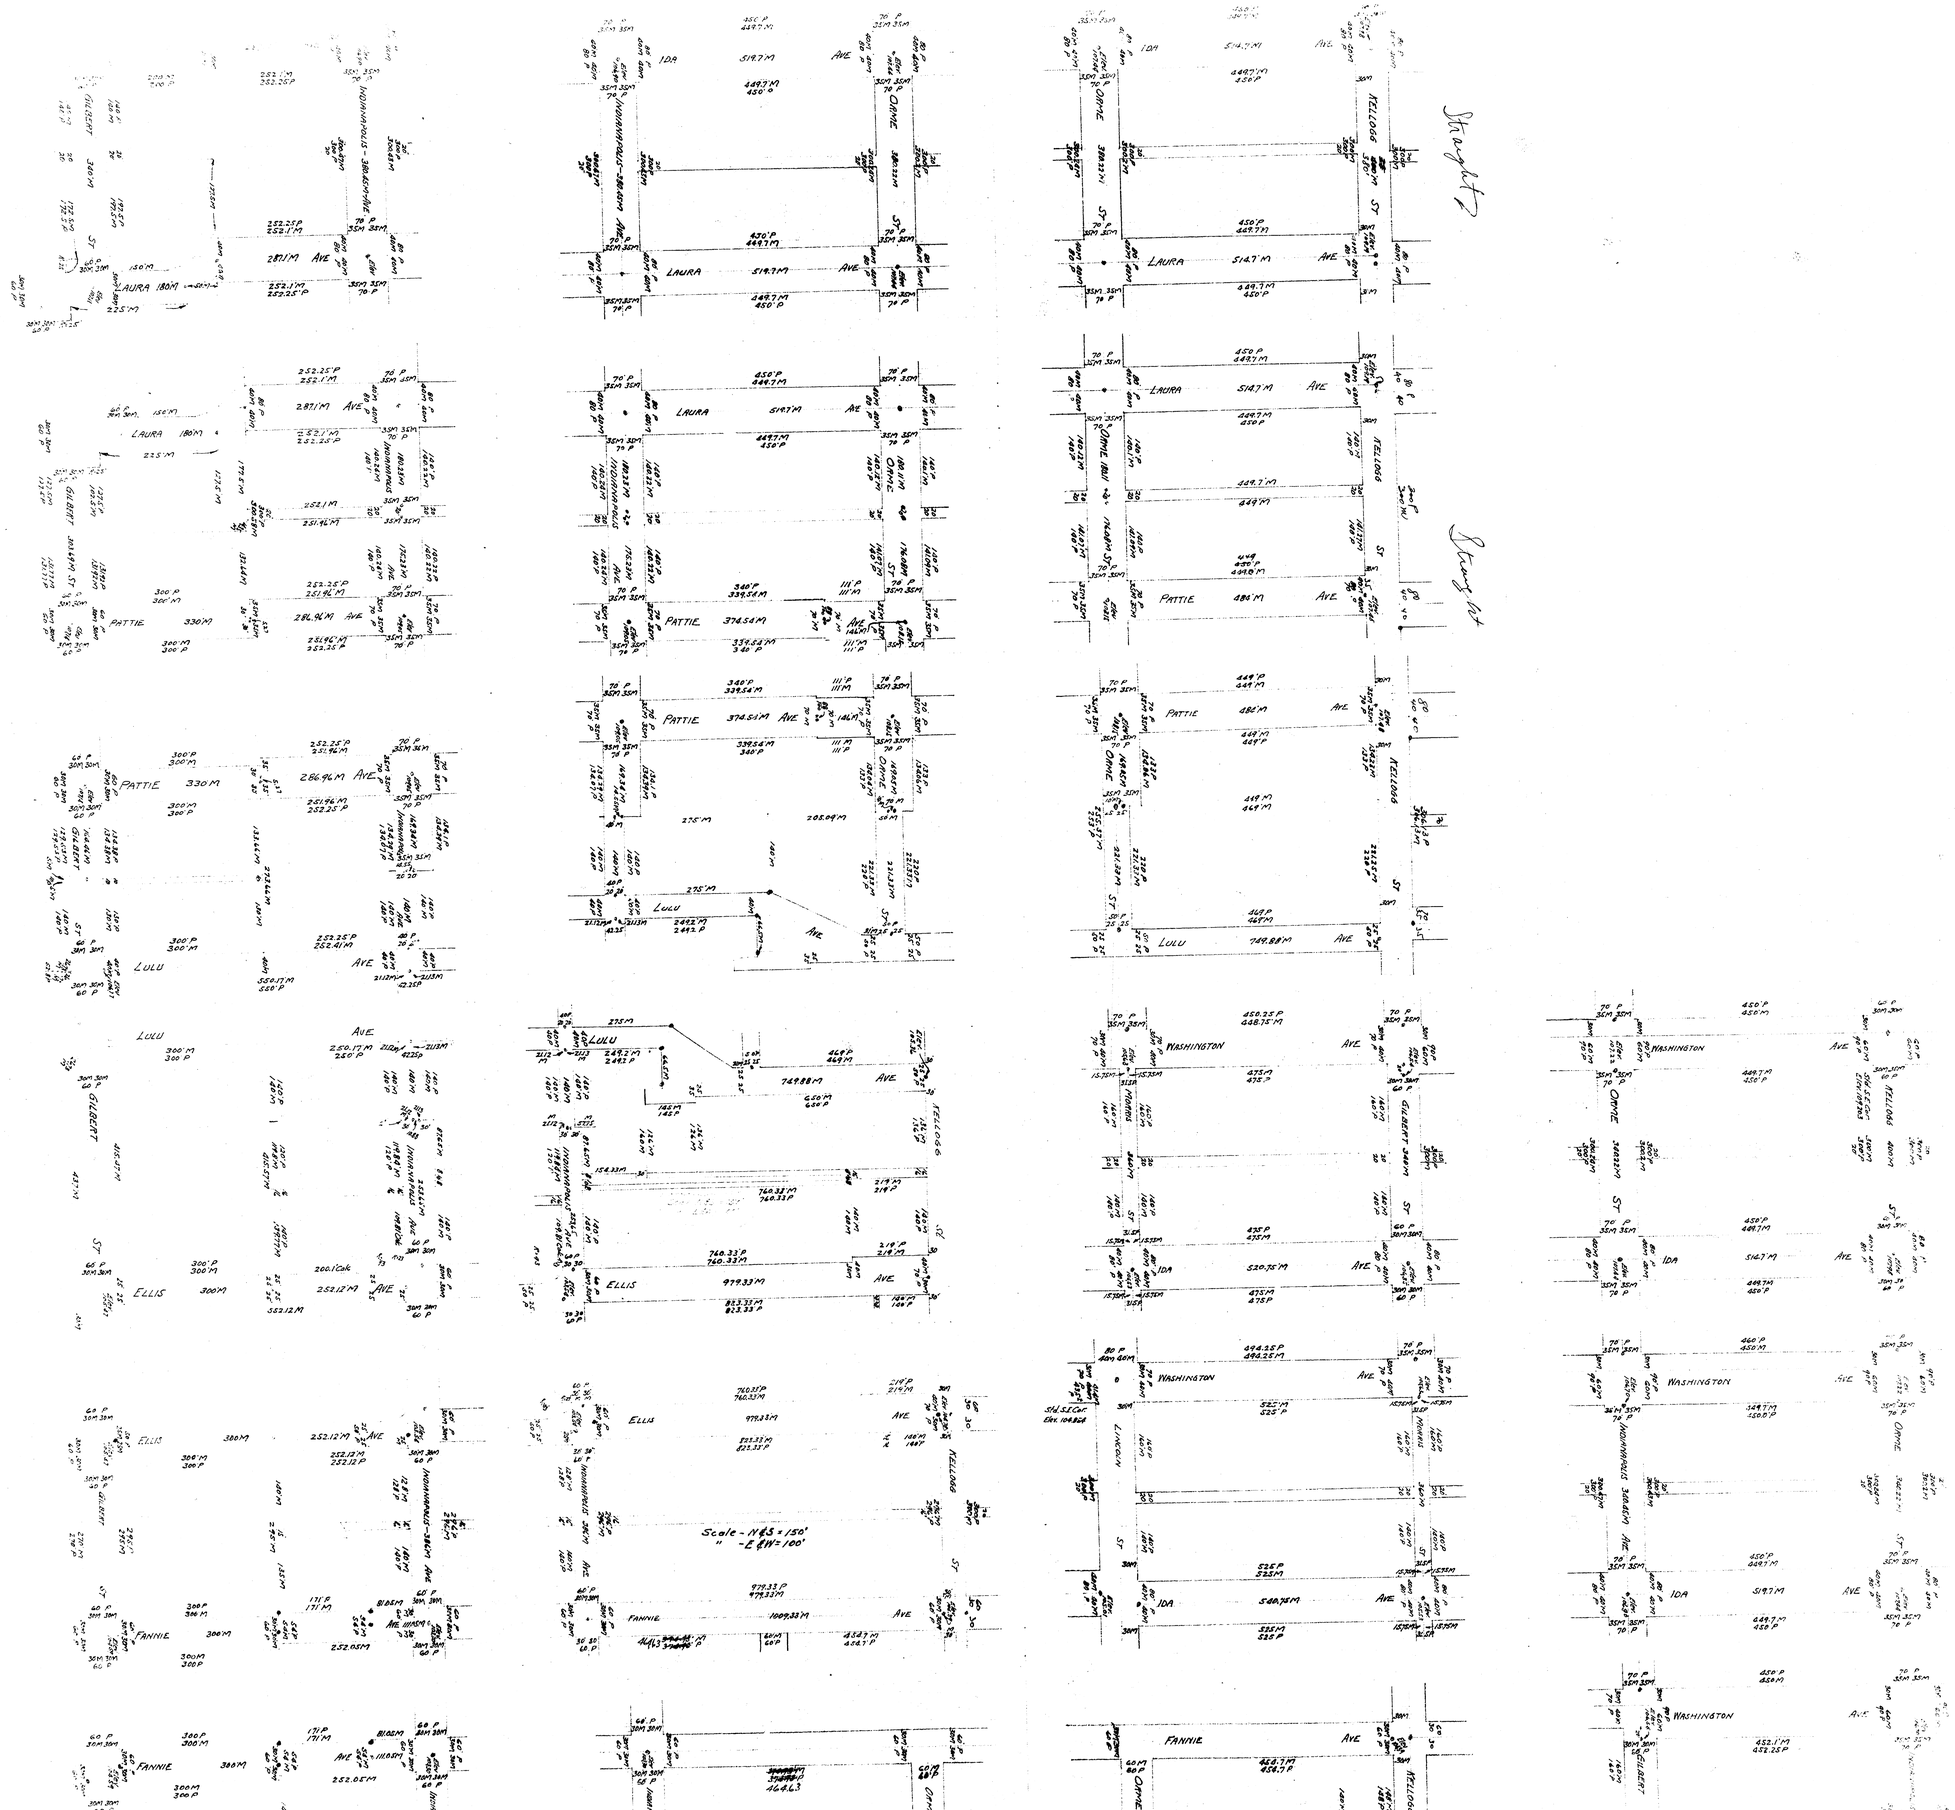

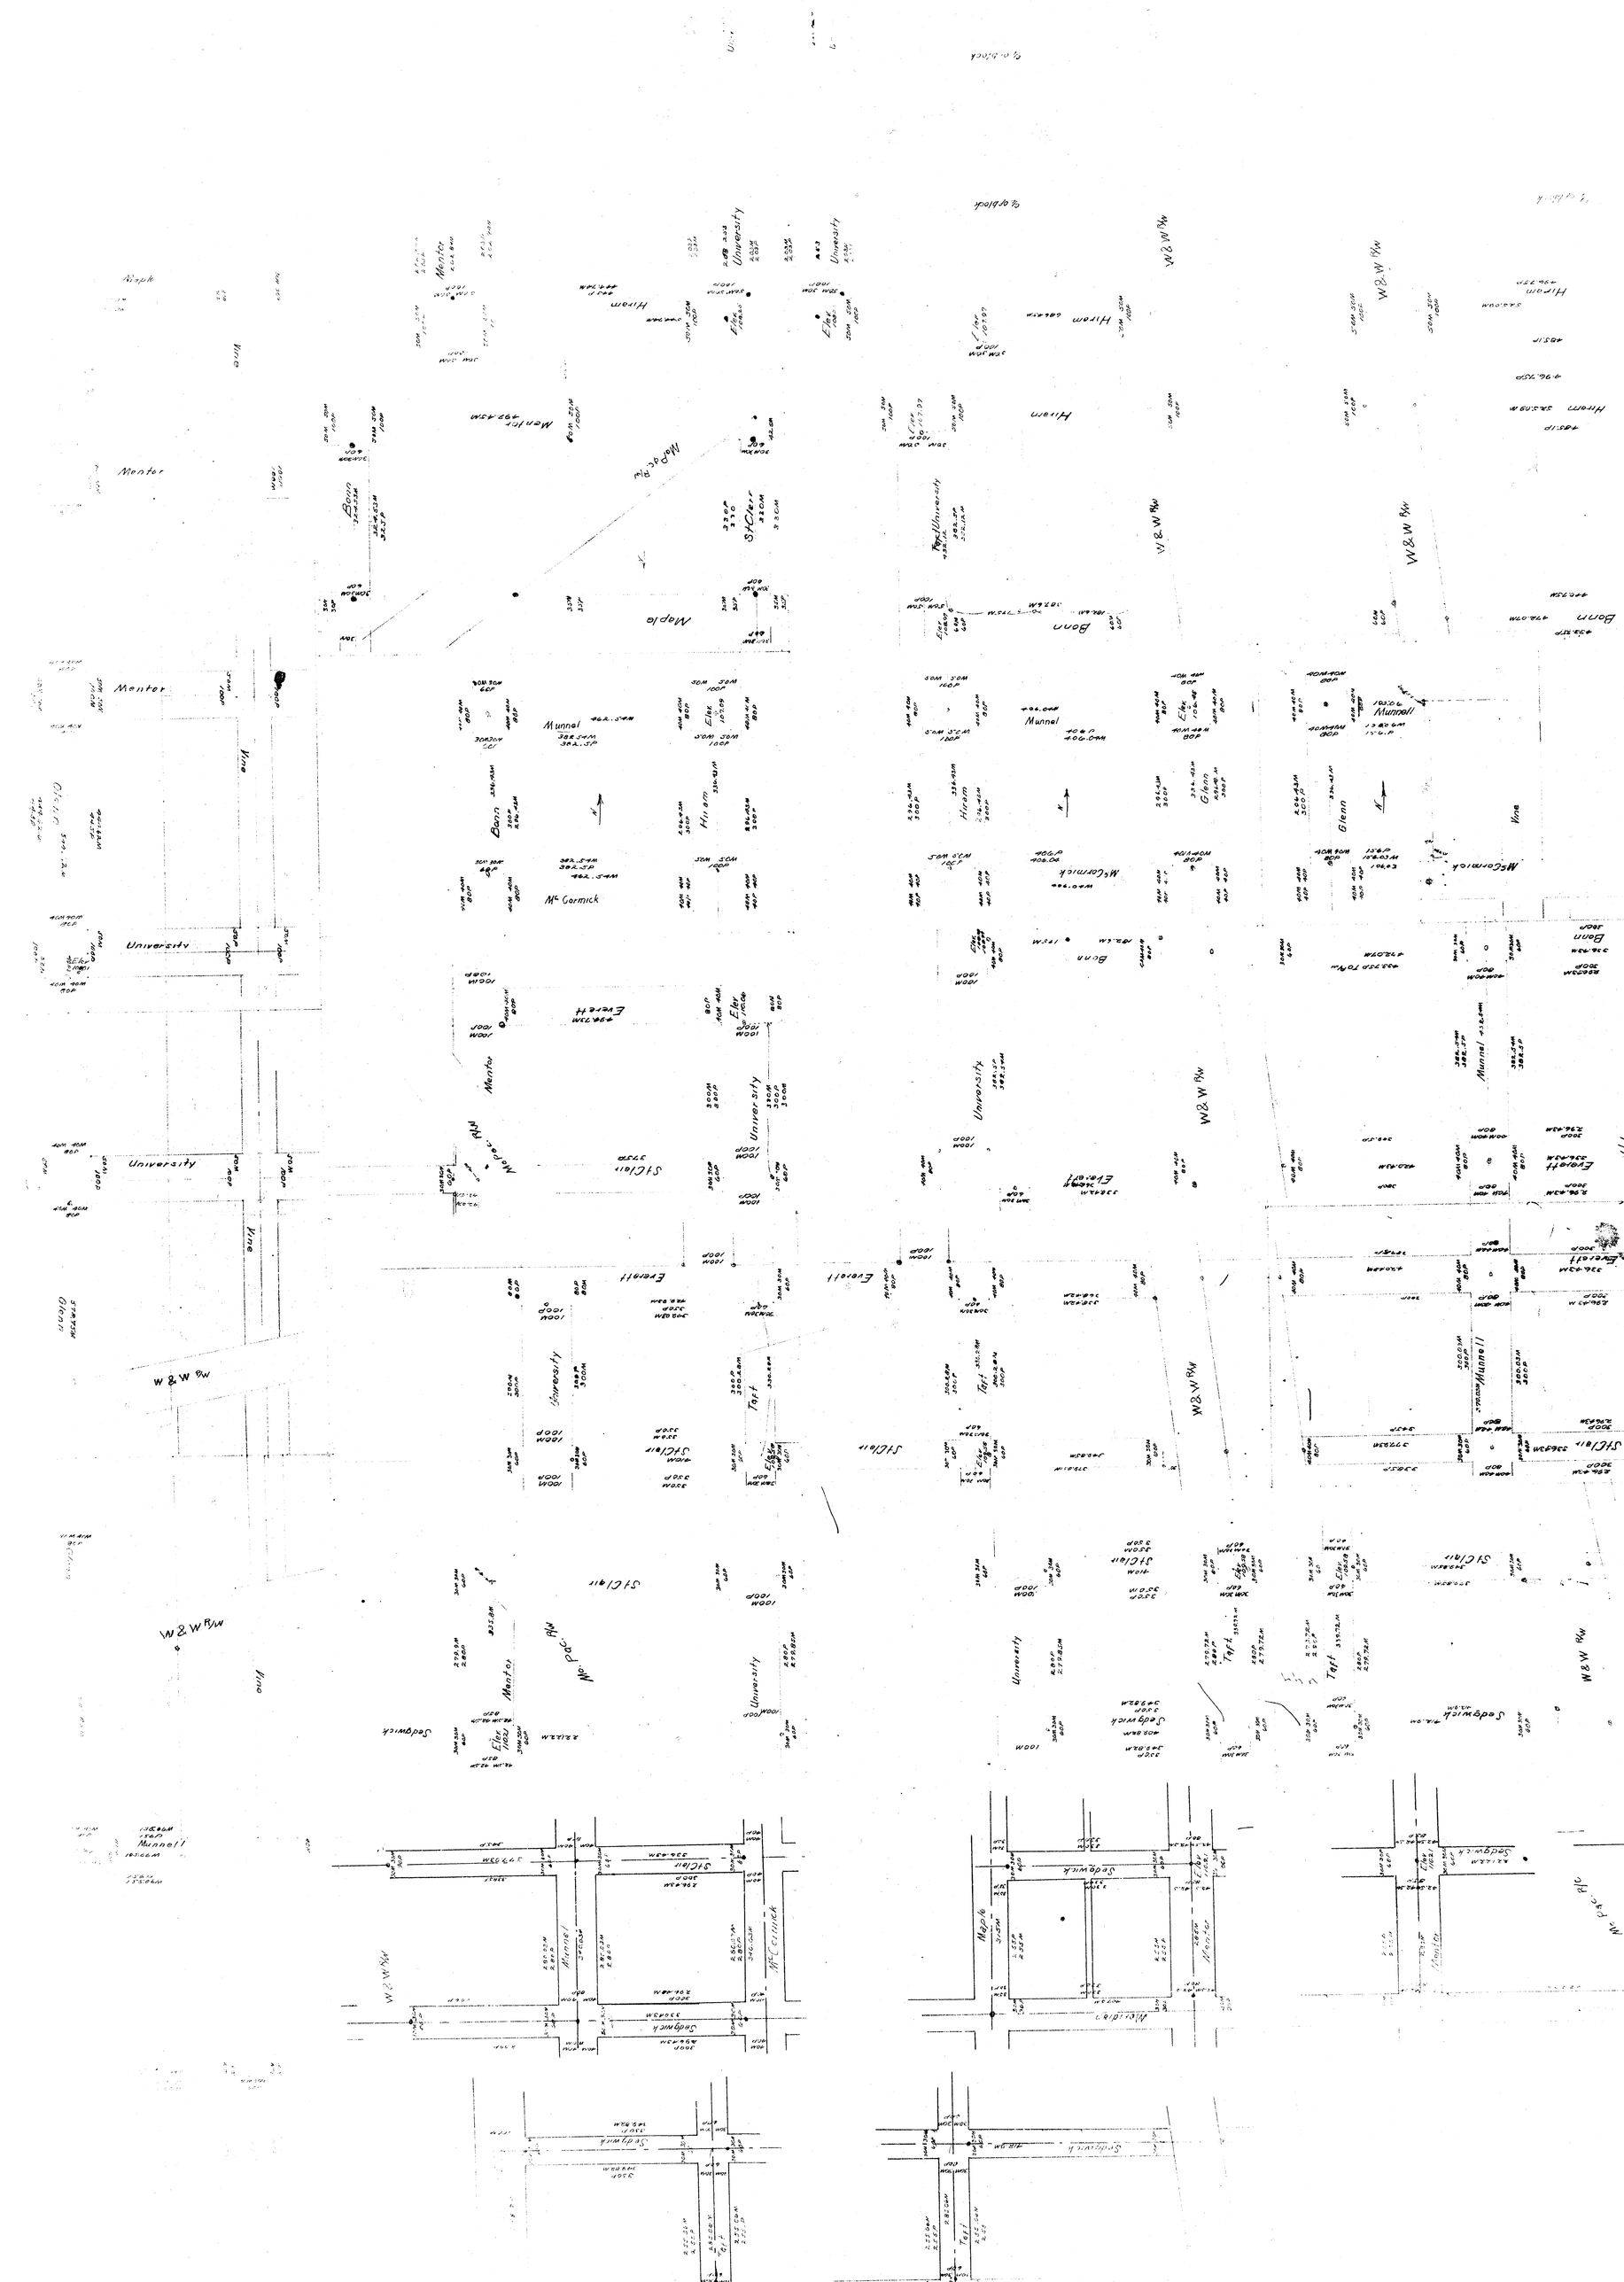
Mentor
Maple
Hiram
Bonn
Elm
Glenn
Munnell
McCormick
Sidgwick
University
Everett
St Clair
Taft
Vine
W & W RW
N. Pac. RW
McPac. RW

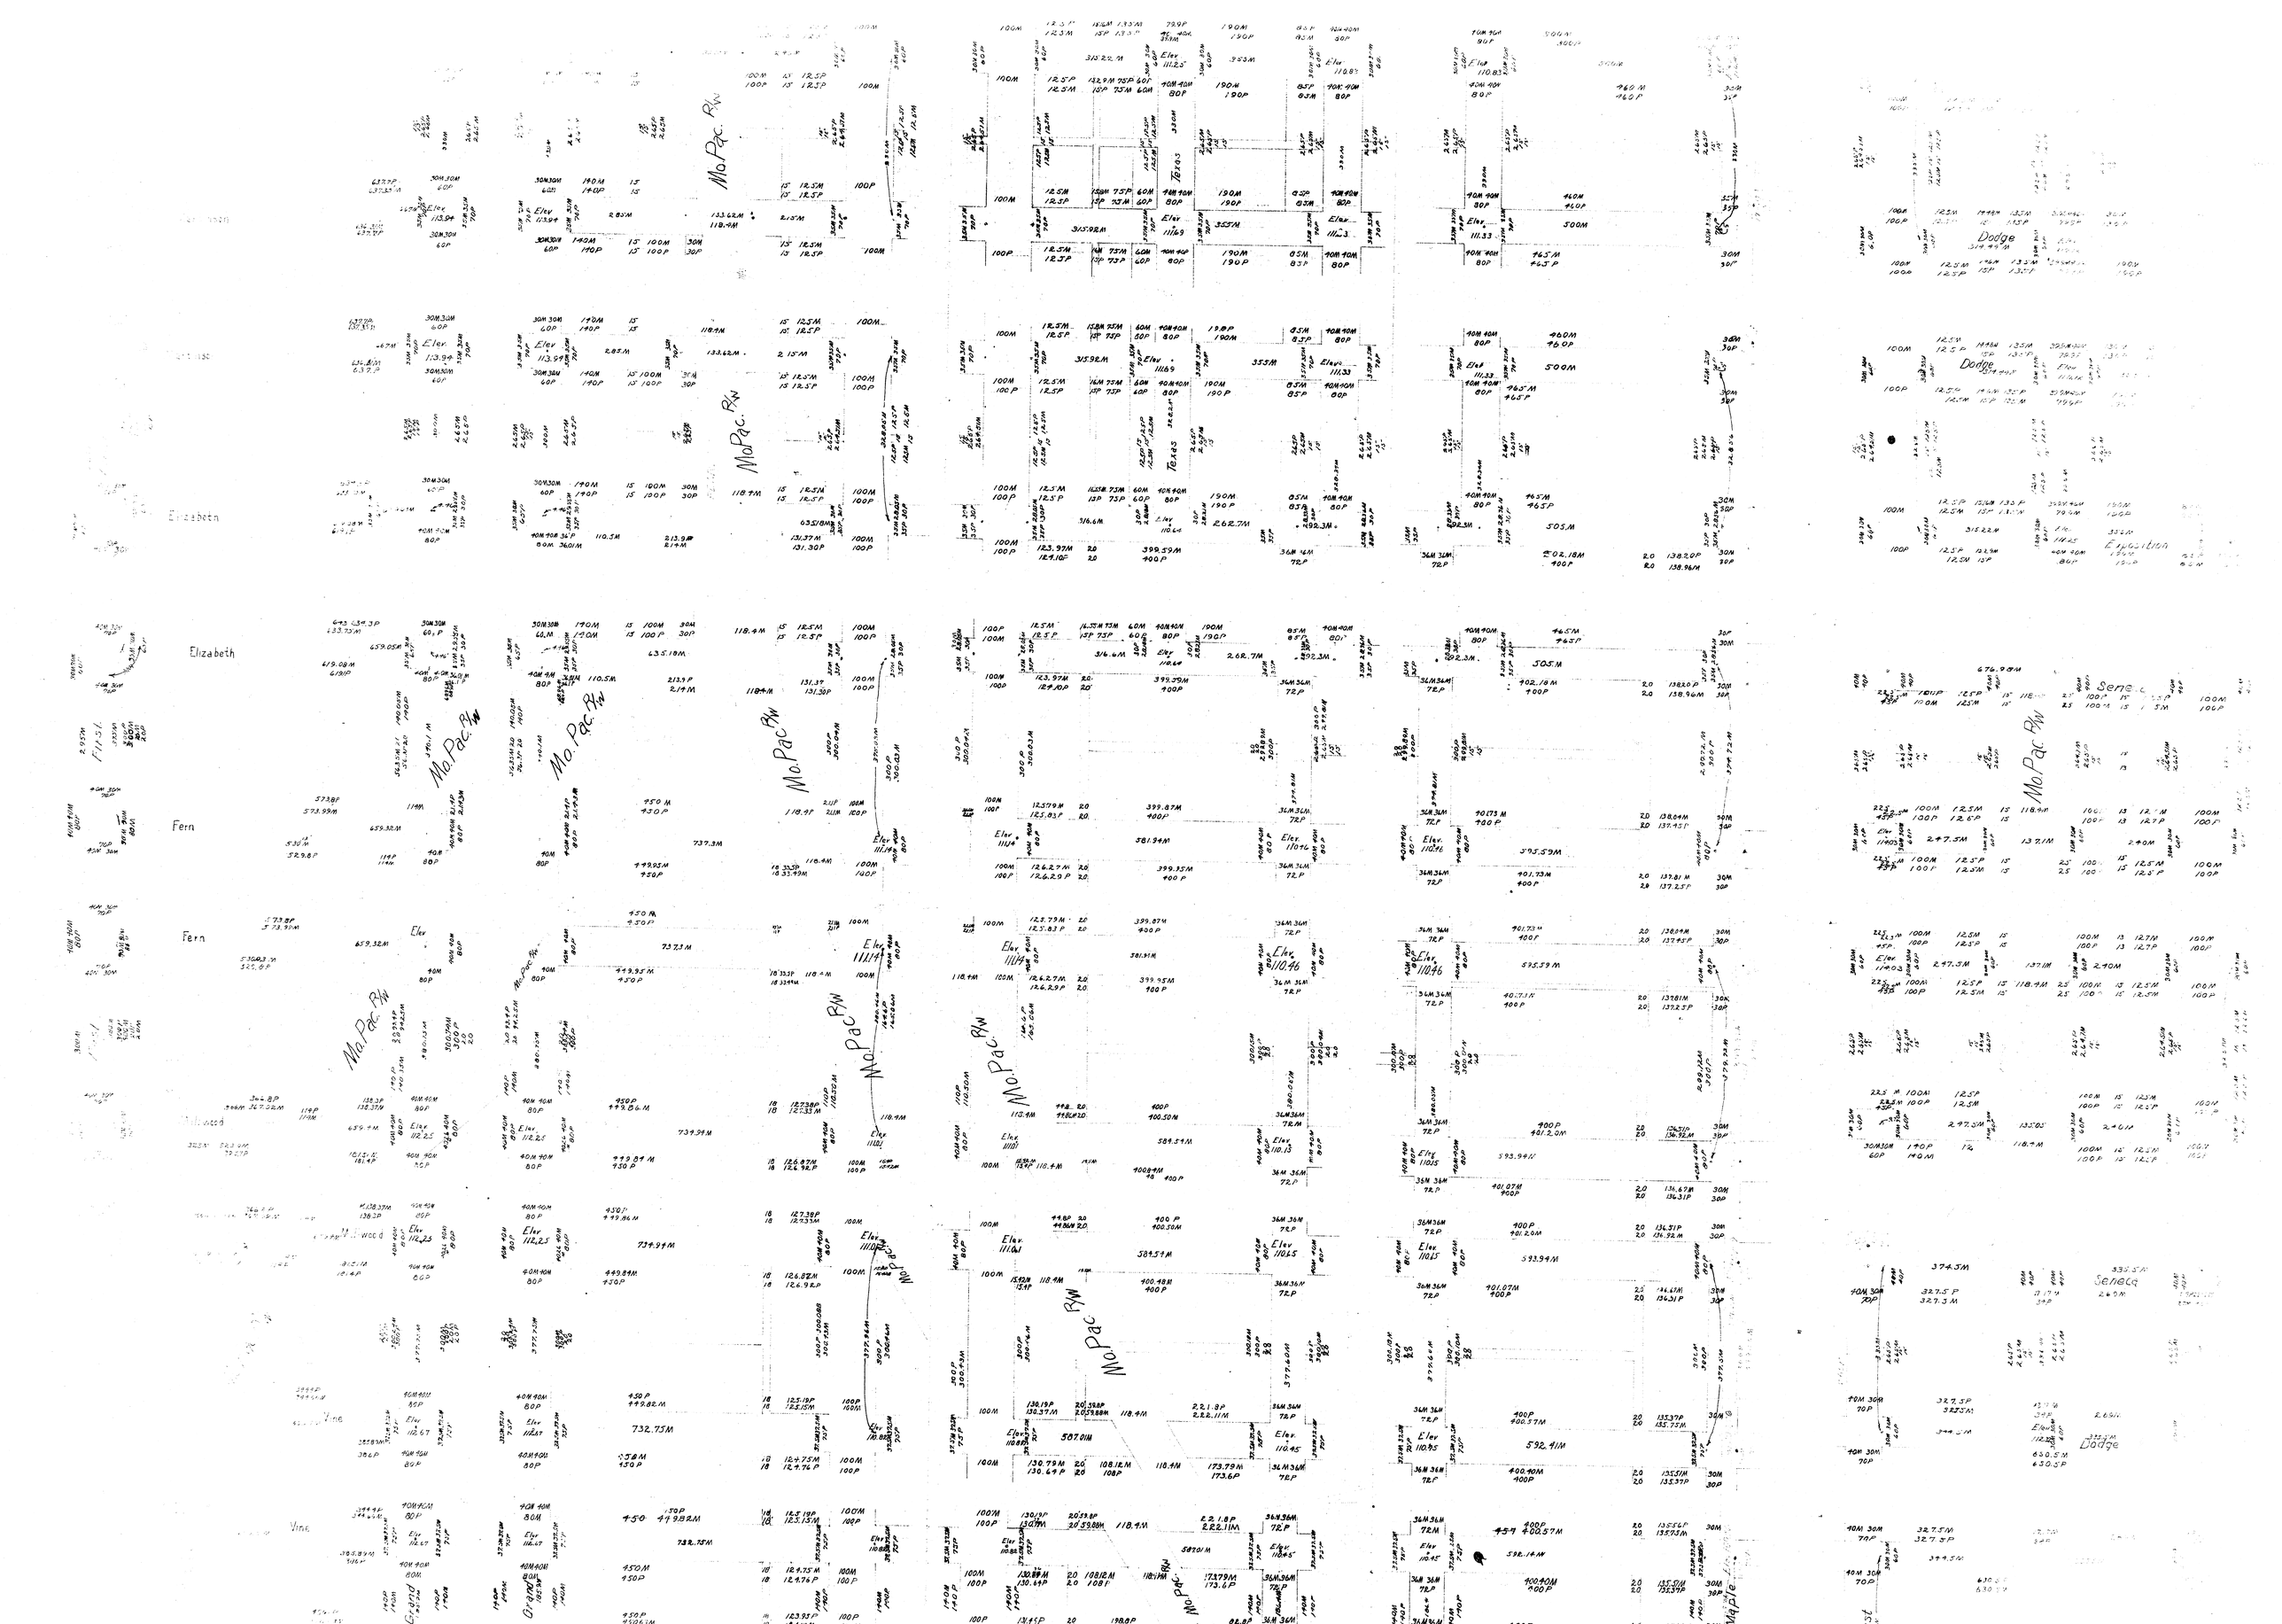
Elizabeth
Fern
Mo. Pac. R/W
Dodge
Exposition
Sene
Seneca
Vine
Grand
Maple

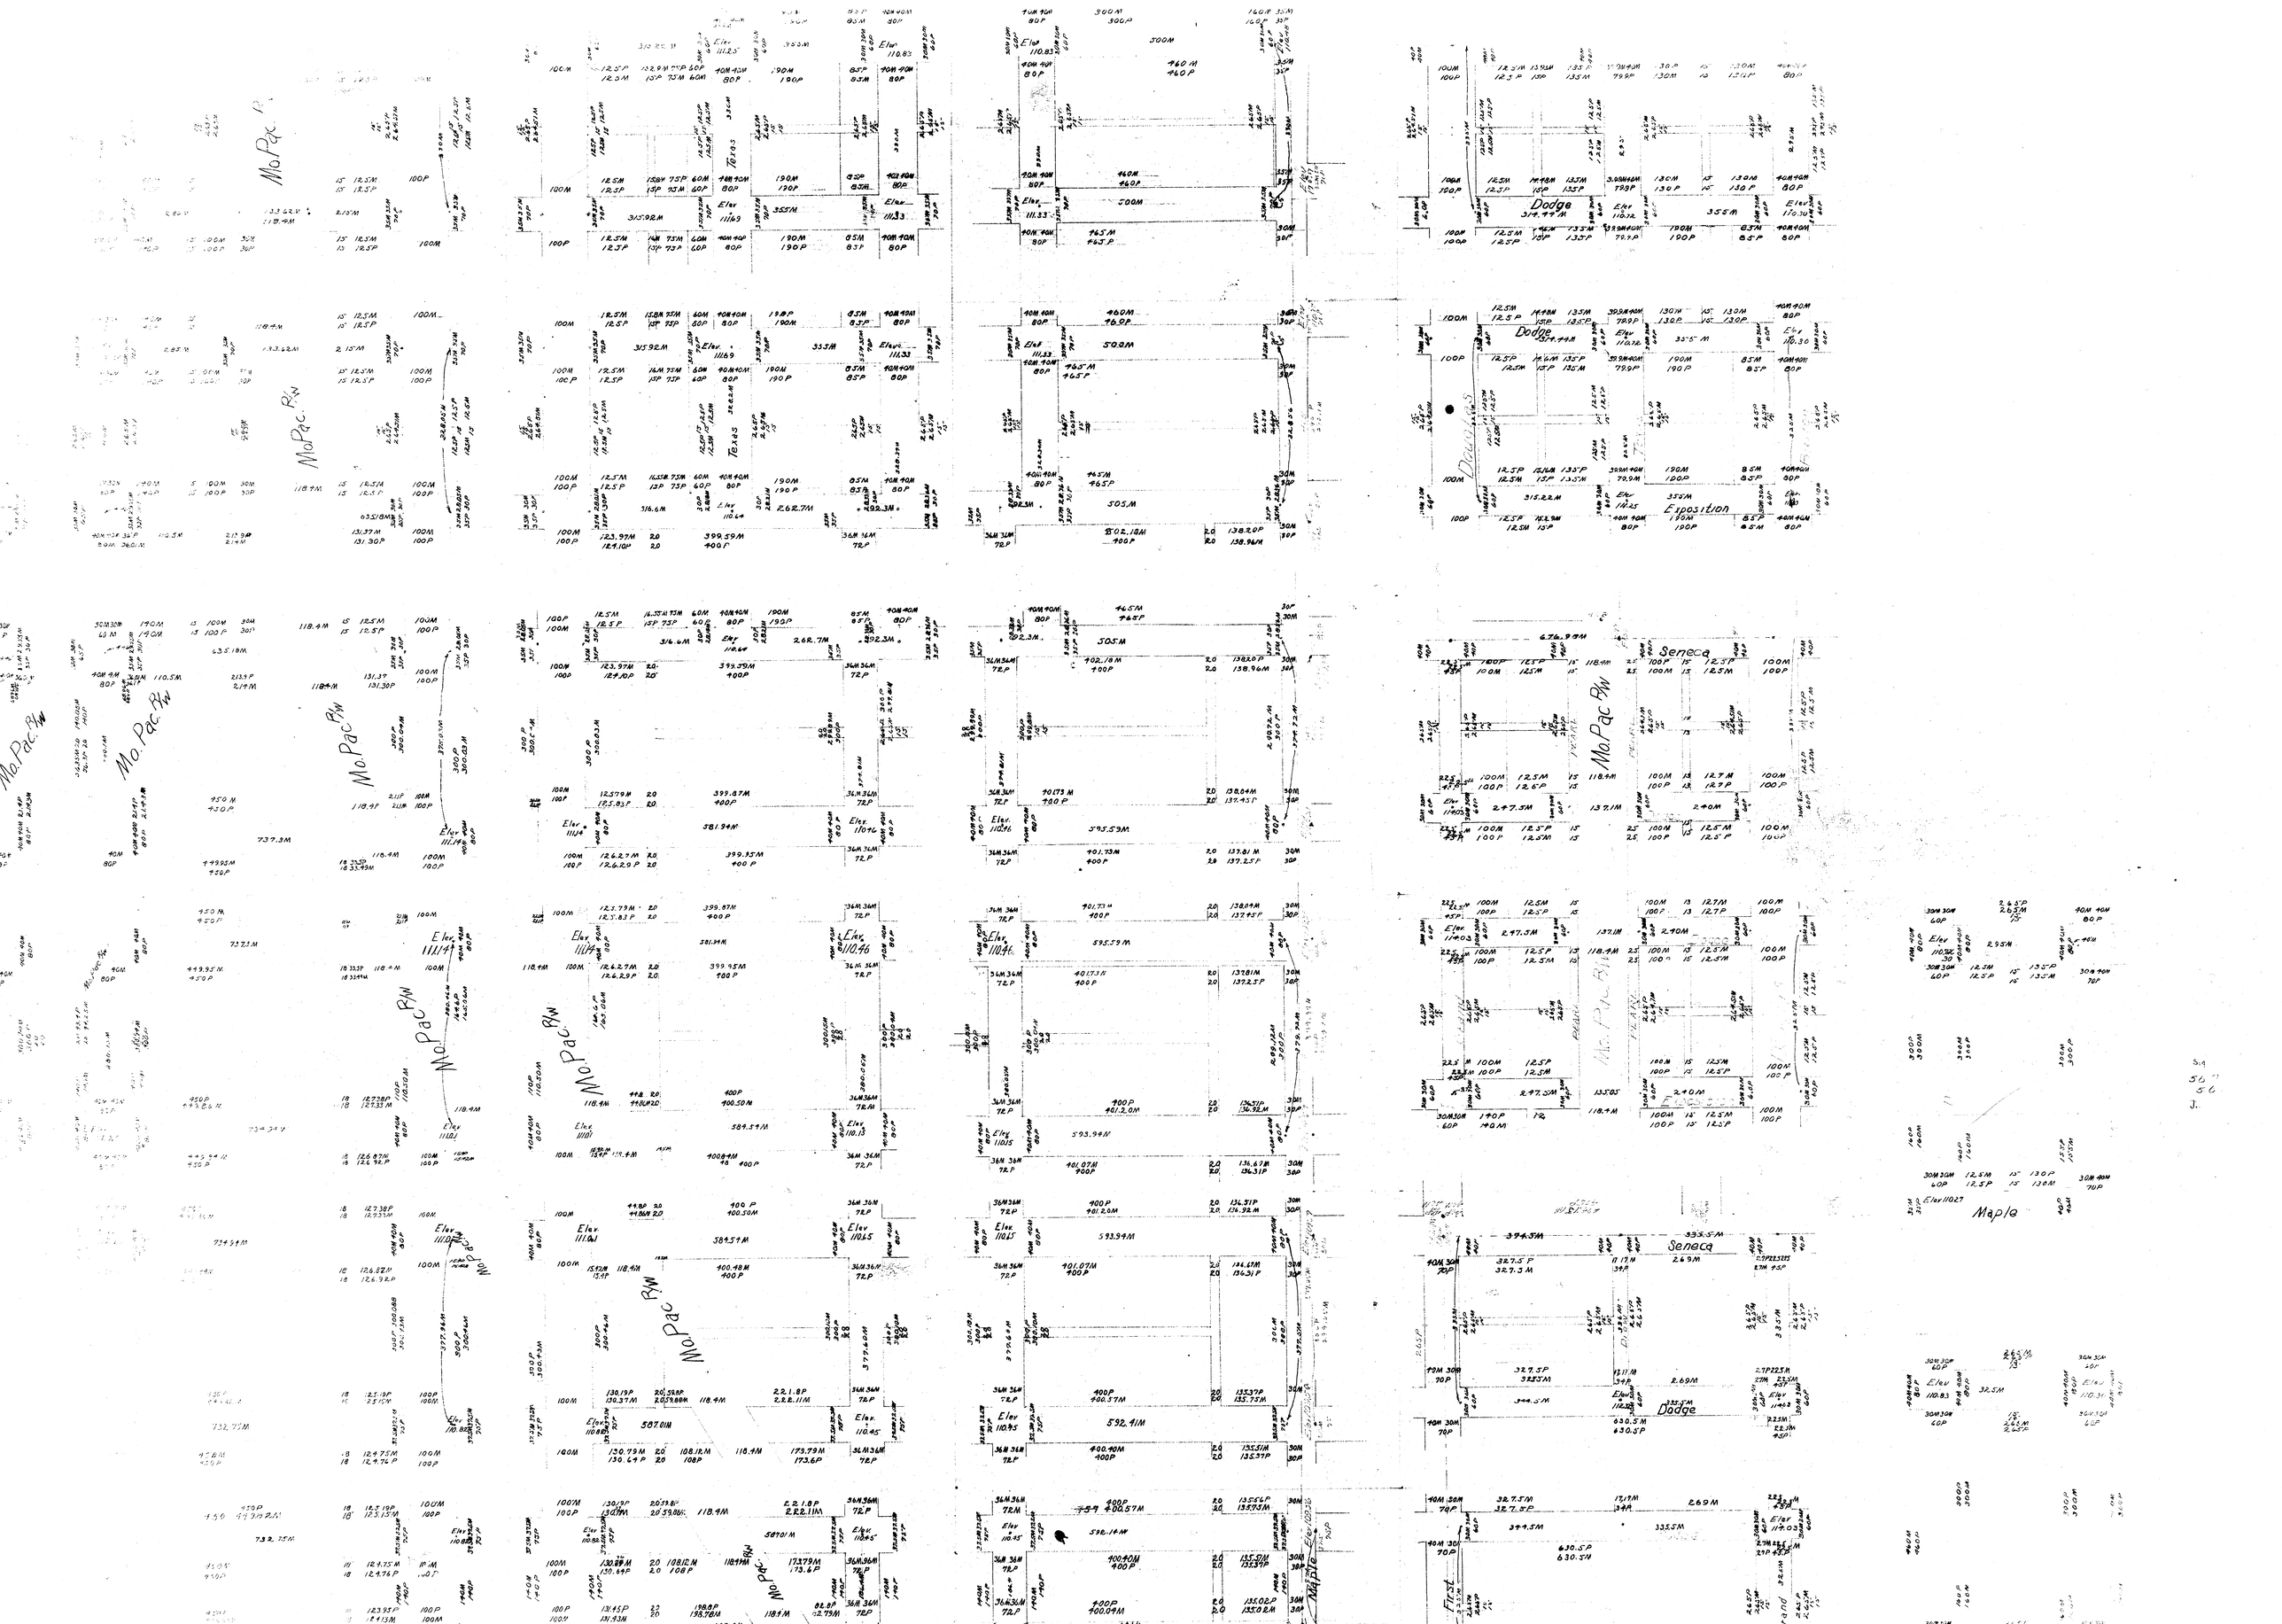
Dodge
Texas
Douglas
Exposition
Seneca
Mo. Pac. R/W
Maple
First