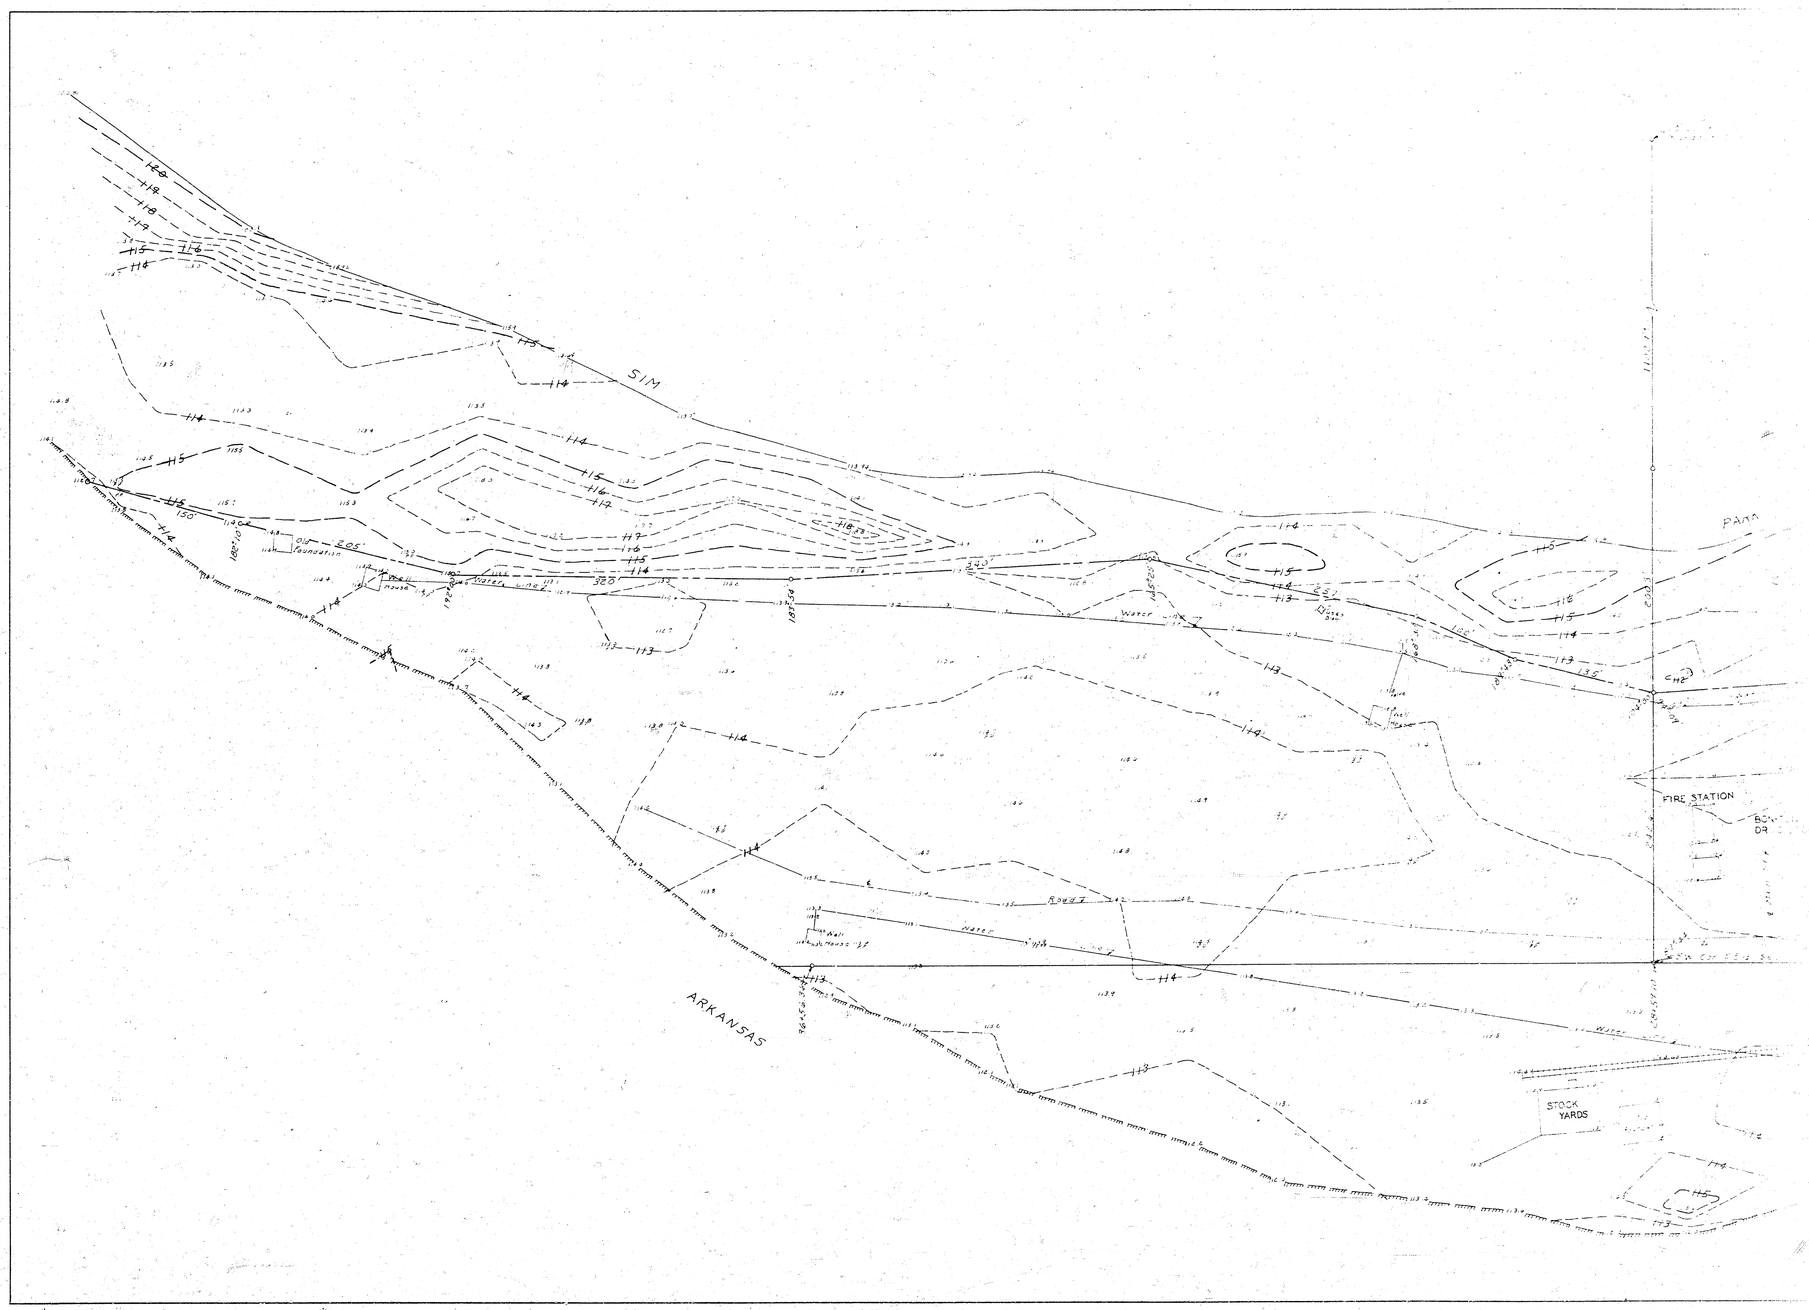

Cowtown
Topo
Survey

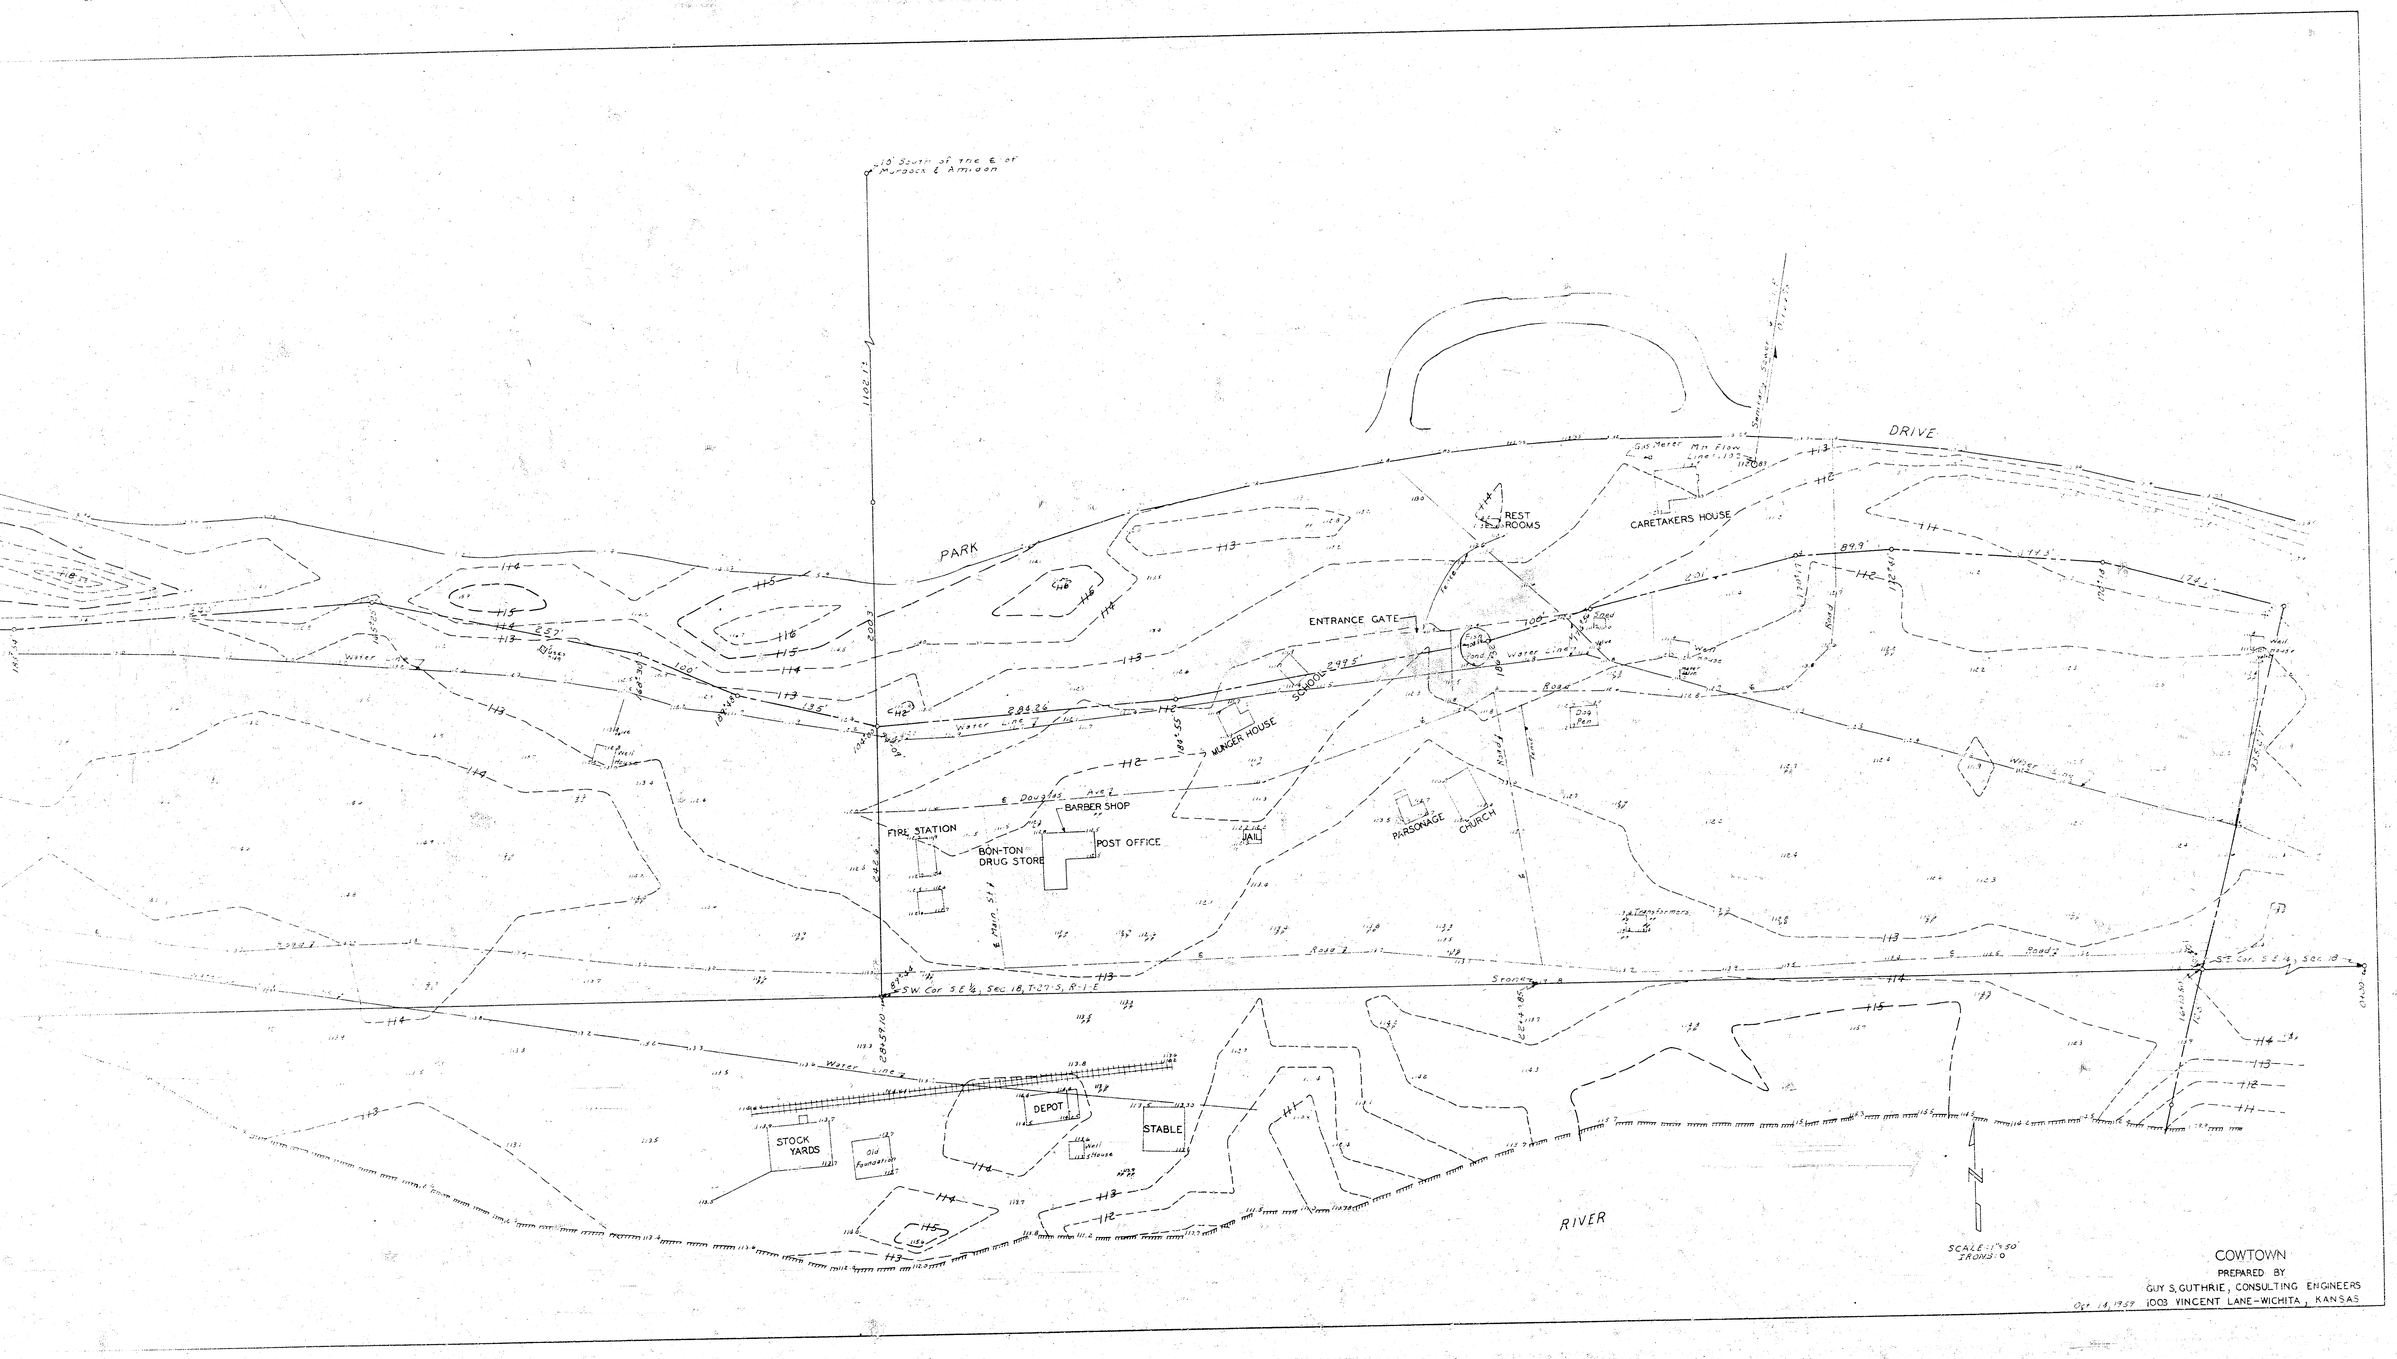
DRIVE
PARK
REST ROOMS
CARETAKERS HOUSE
ENTRANCE GATE
SCHOOL
MUNGER HOUSE
BARBER SHOP
POST OFFICE
BON-TON DRUG STORE
FIRE STATION
JAIL
PARSONAGE
CHURCH
DEPOT
STABLE
STOCK YARDS
RIVER
SCALE: 1" = 50'
COWTOWN
PREPARED BY
GUY S. GUTHRIE, CONSULTING ENGINEERS
1003 VINCENT LANE-WICHITA, KANSAS