
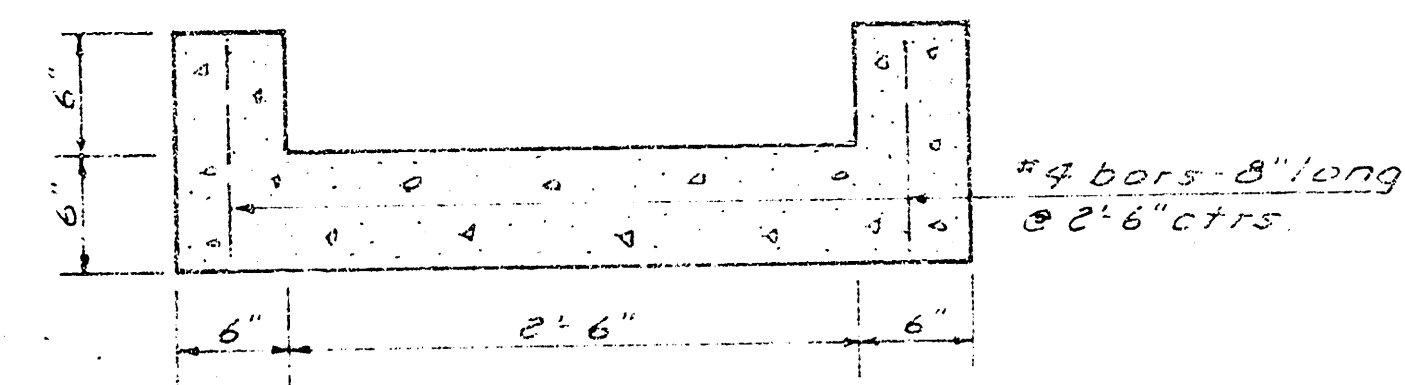
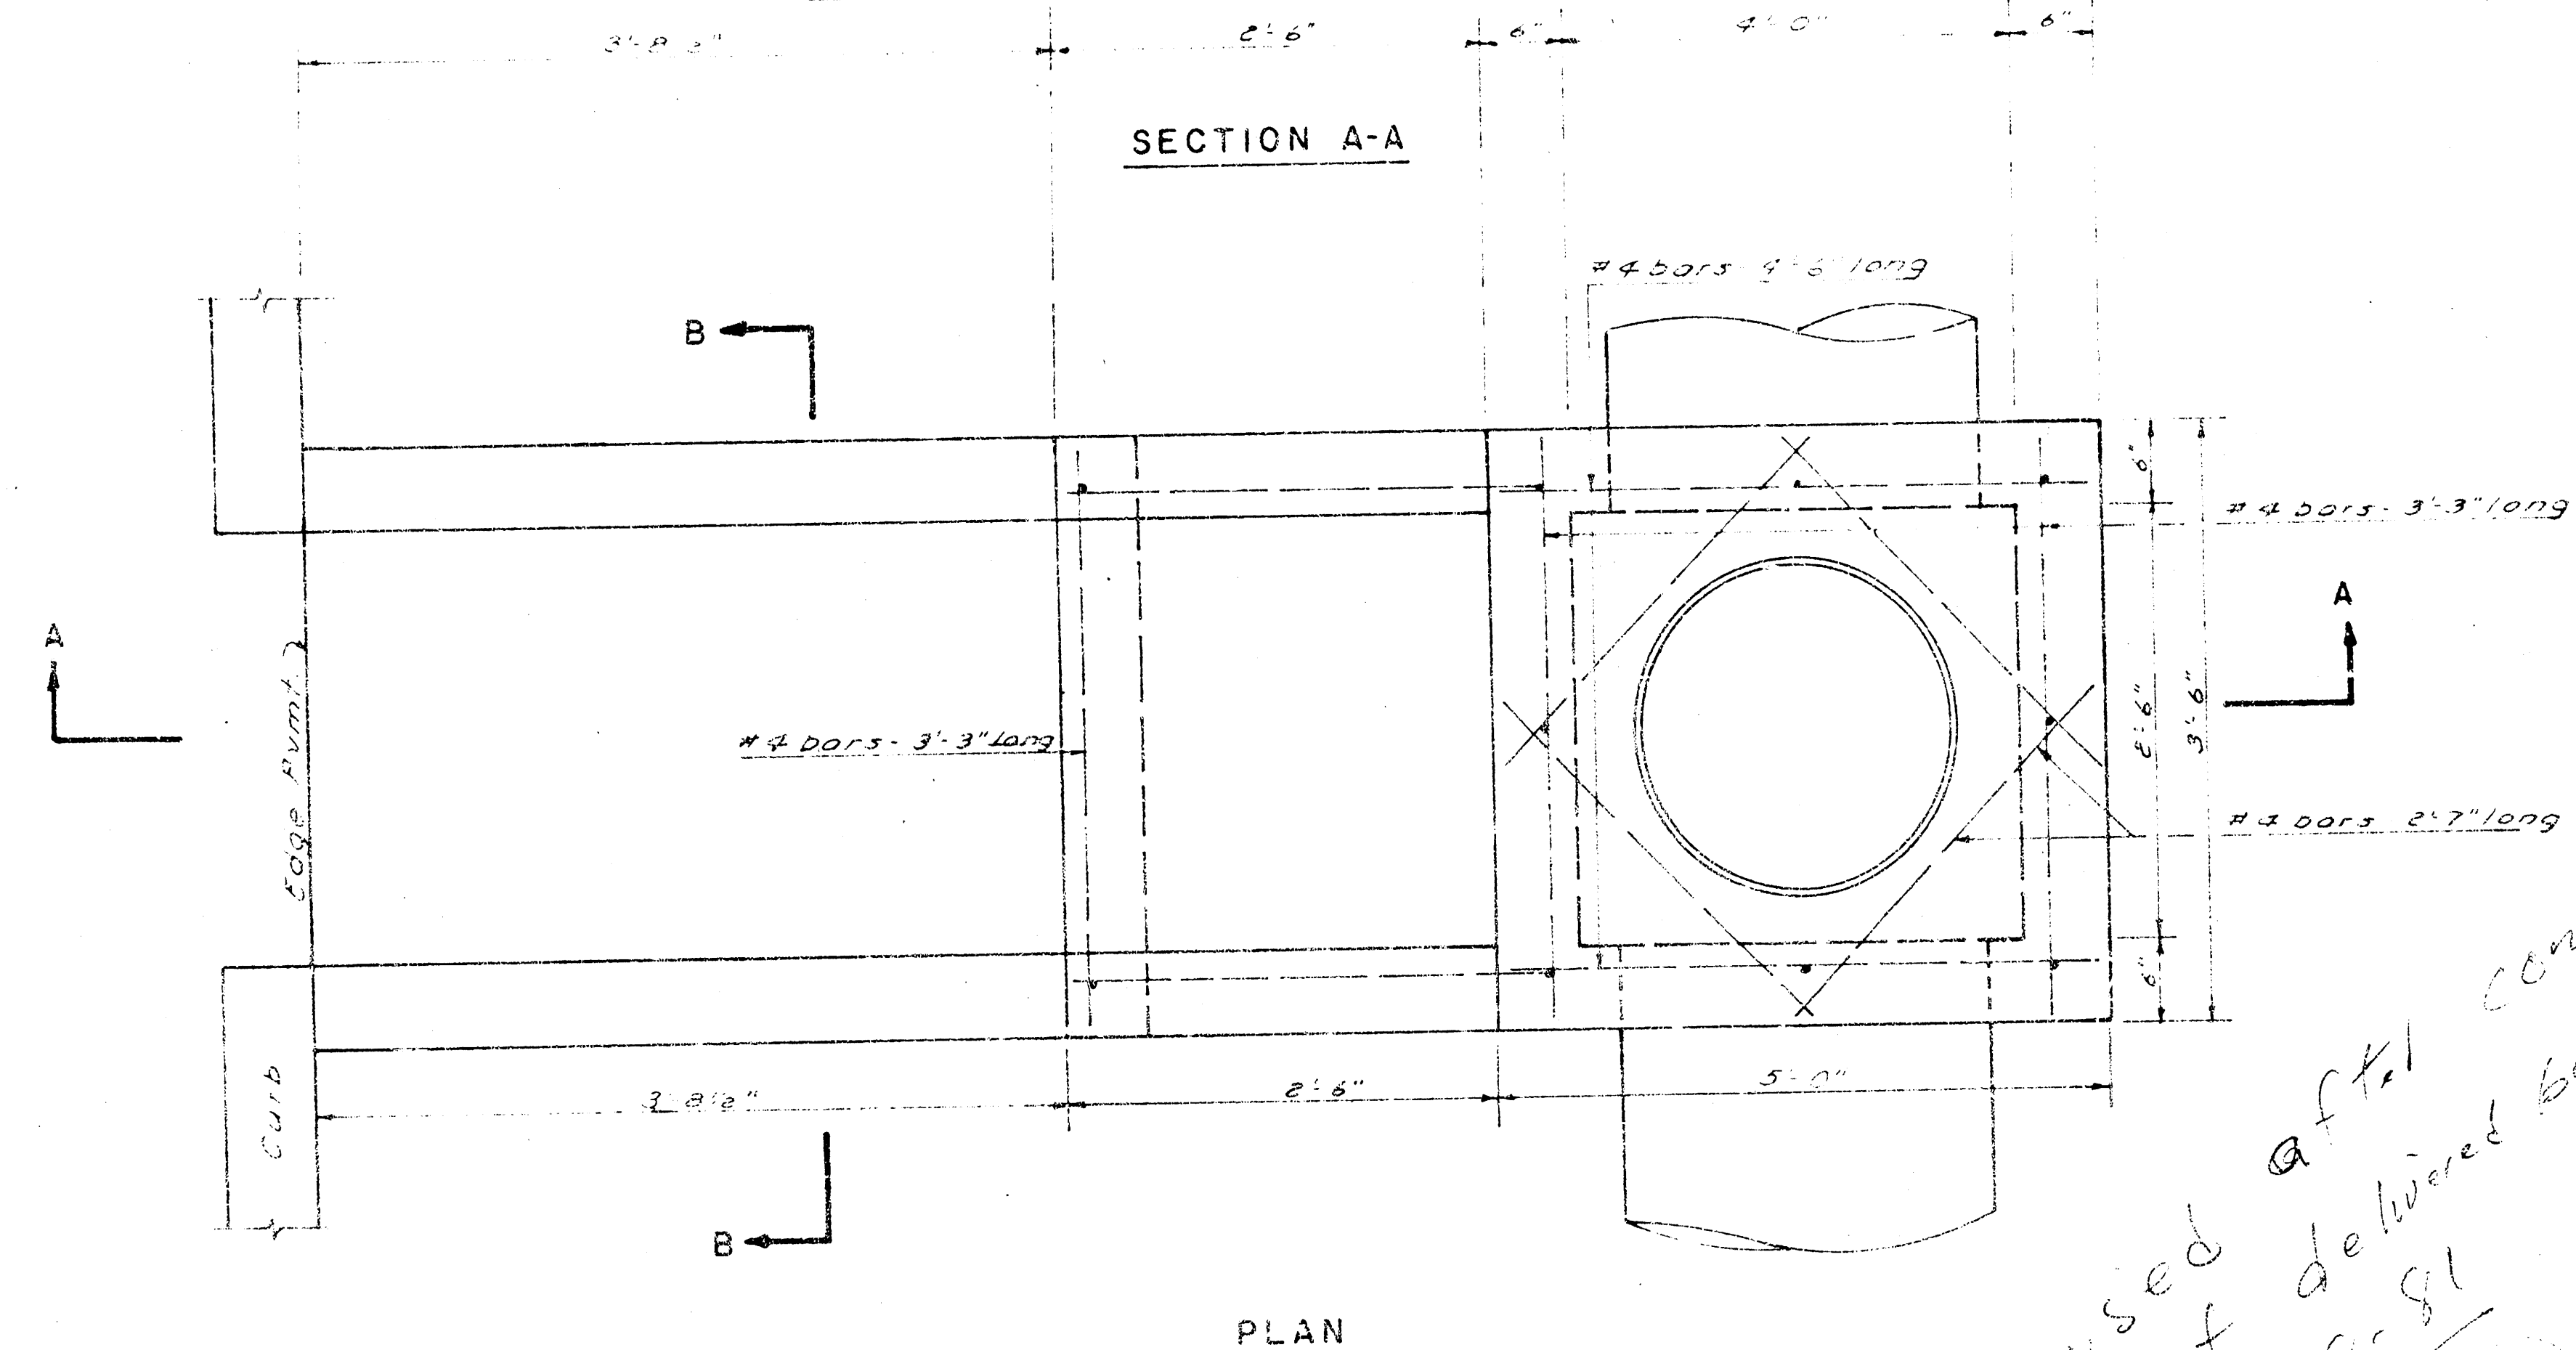


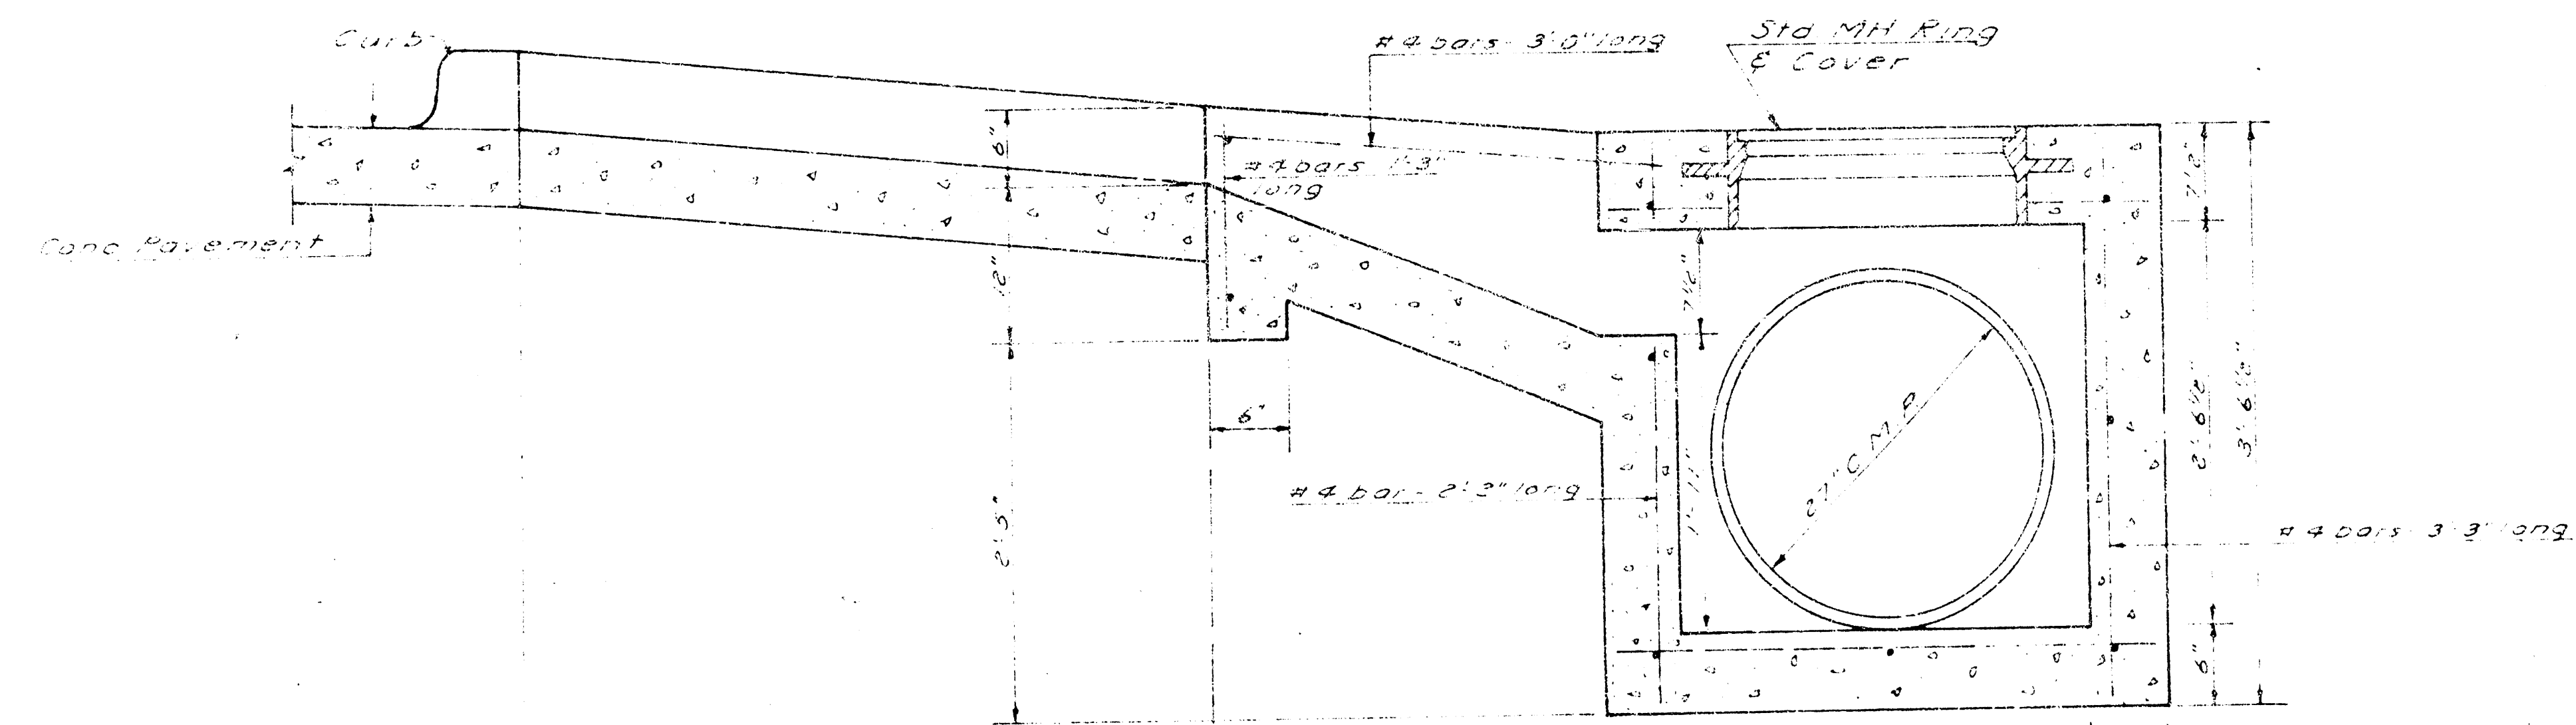

SPECIAL DITCH INLET DETAILS
Scale: 1" = 1'-0"

*Revised after contract
was let delivered by Baughman & Co
6-8-81*

DATE ISSUED	6-8-81
REVISIONS	
DATE DRAWN	

JEFF KREHBIEL ASSOCIATES, AIA
architecture · planning


NORTHEAST FAMILY HEALTH CARE CENTER
THE EAST 6TH STREET
WICHITA, KANSAS

Sheet title
DITCH INLET DTLS

sheet
SS2
of 3 sheets