


STORM SEWERS VRH 6/10/06



NOTE TO CONTRACTOR

GENERAL NOTES

10. CONTRACTOR SHALL RESEED AND MULCH ALL DISTURBED AREAS NOT REQUIRED TO BE SODDED. COST SHALL BE CONSIDERED SUBSIDIARY TO SITE RESTORATION.

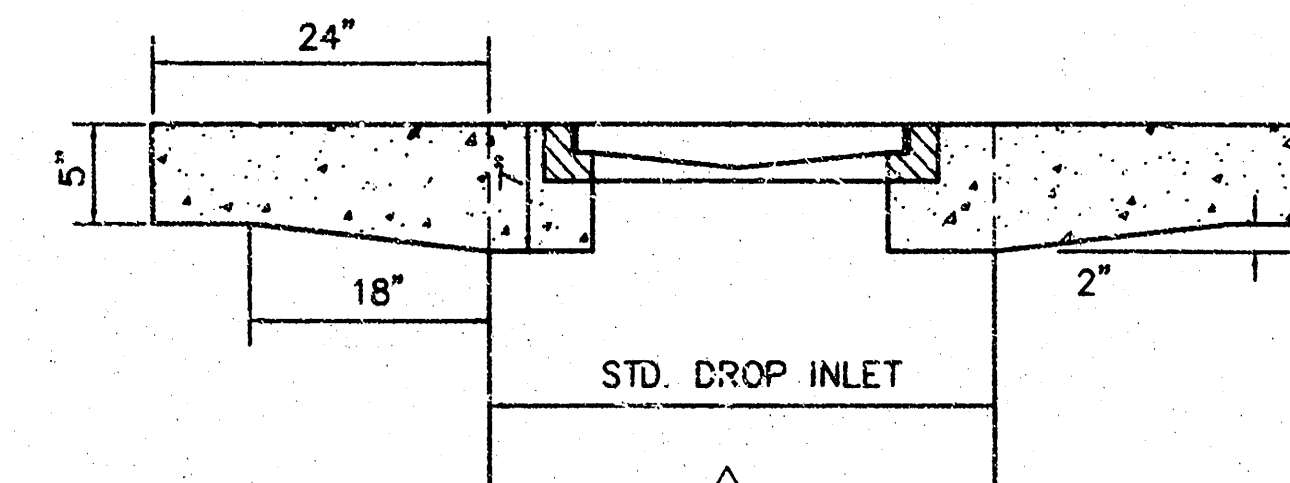

CONCRETE COLLAR DETAIL

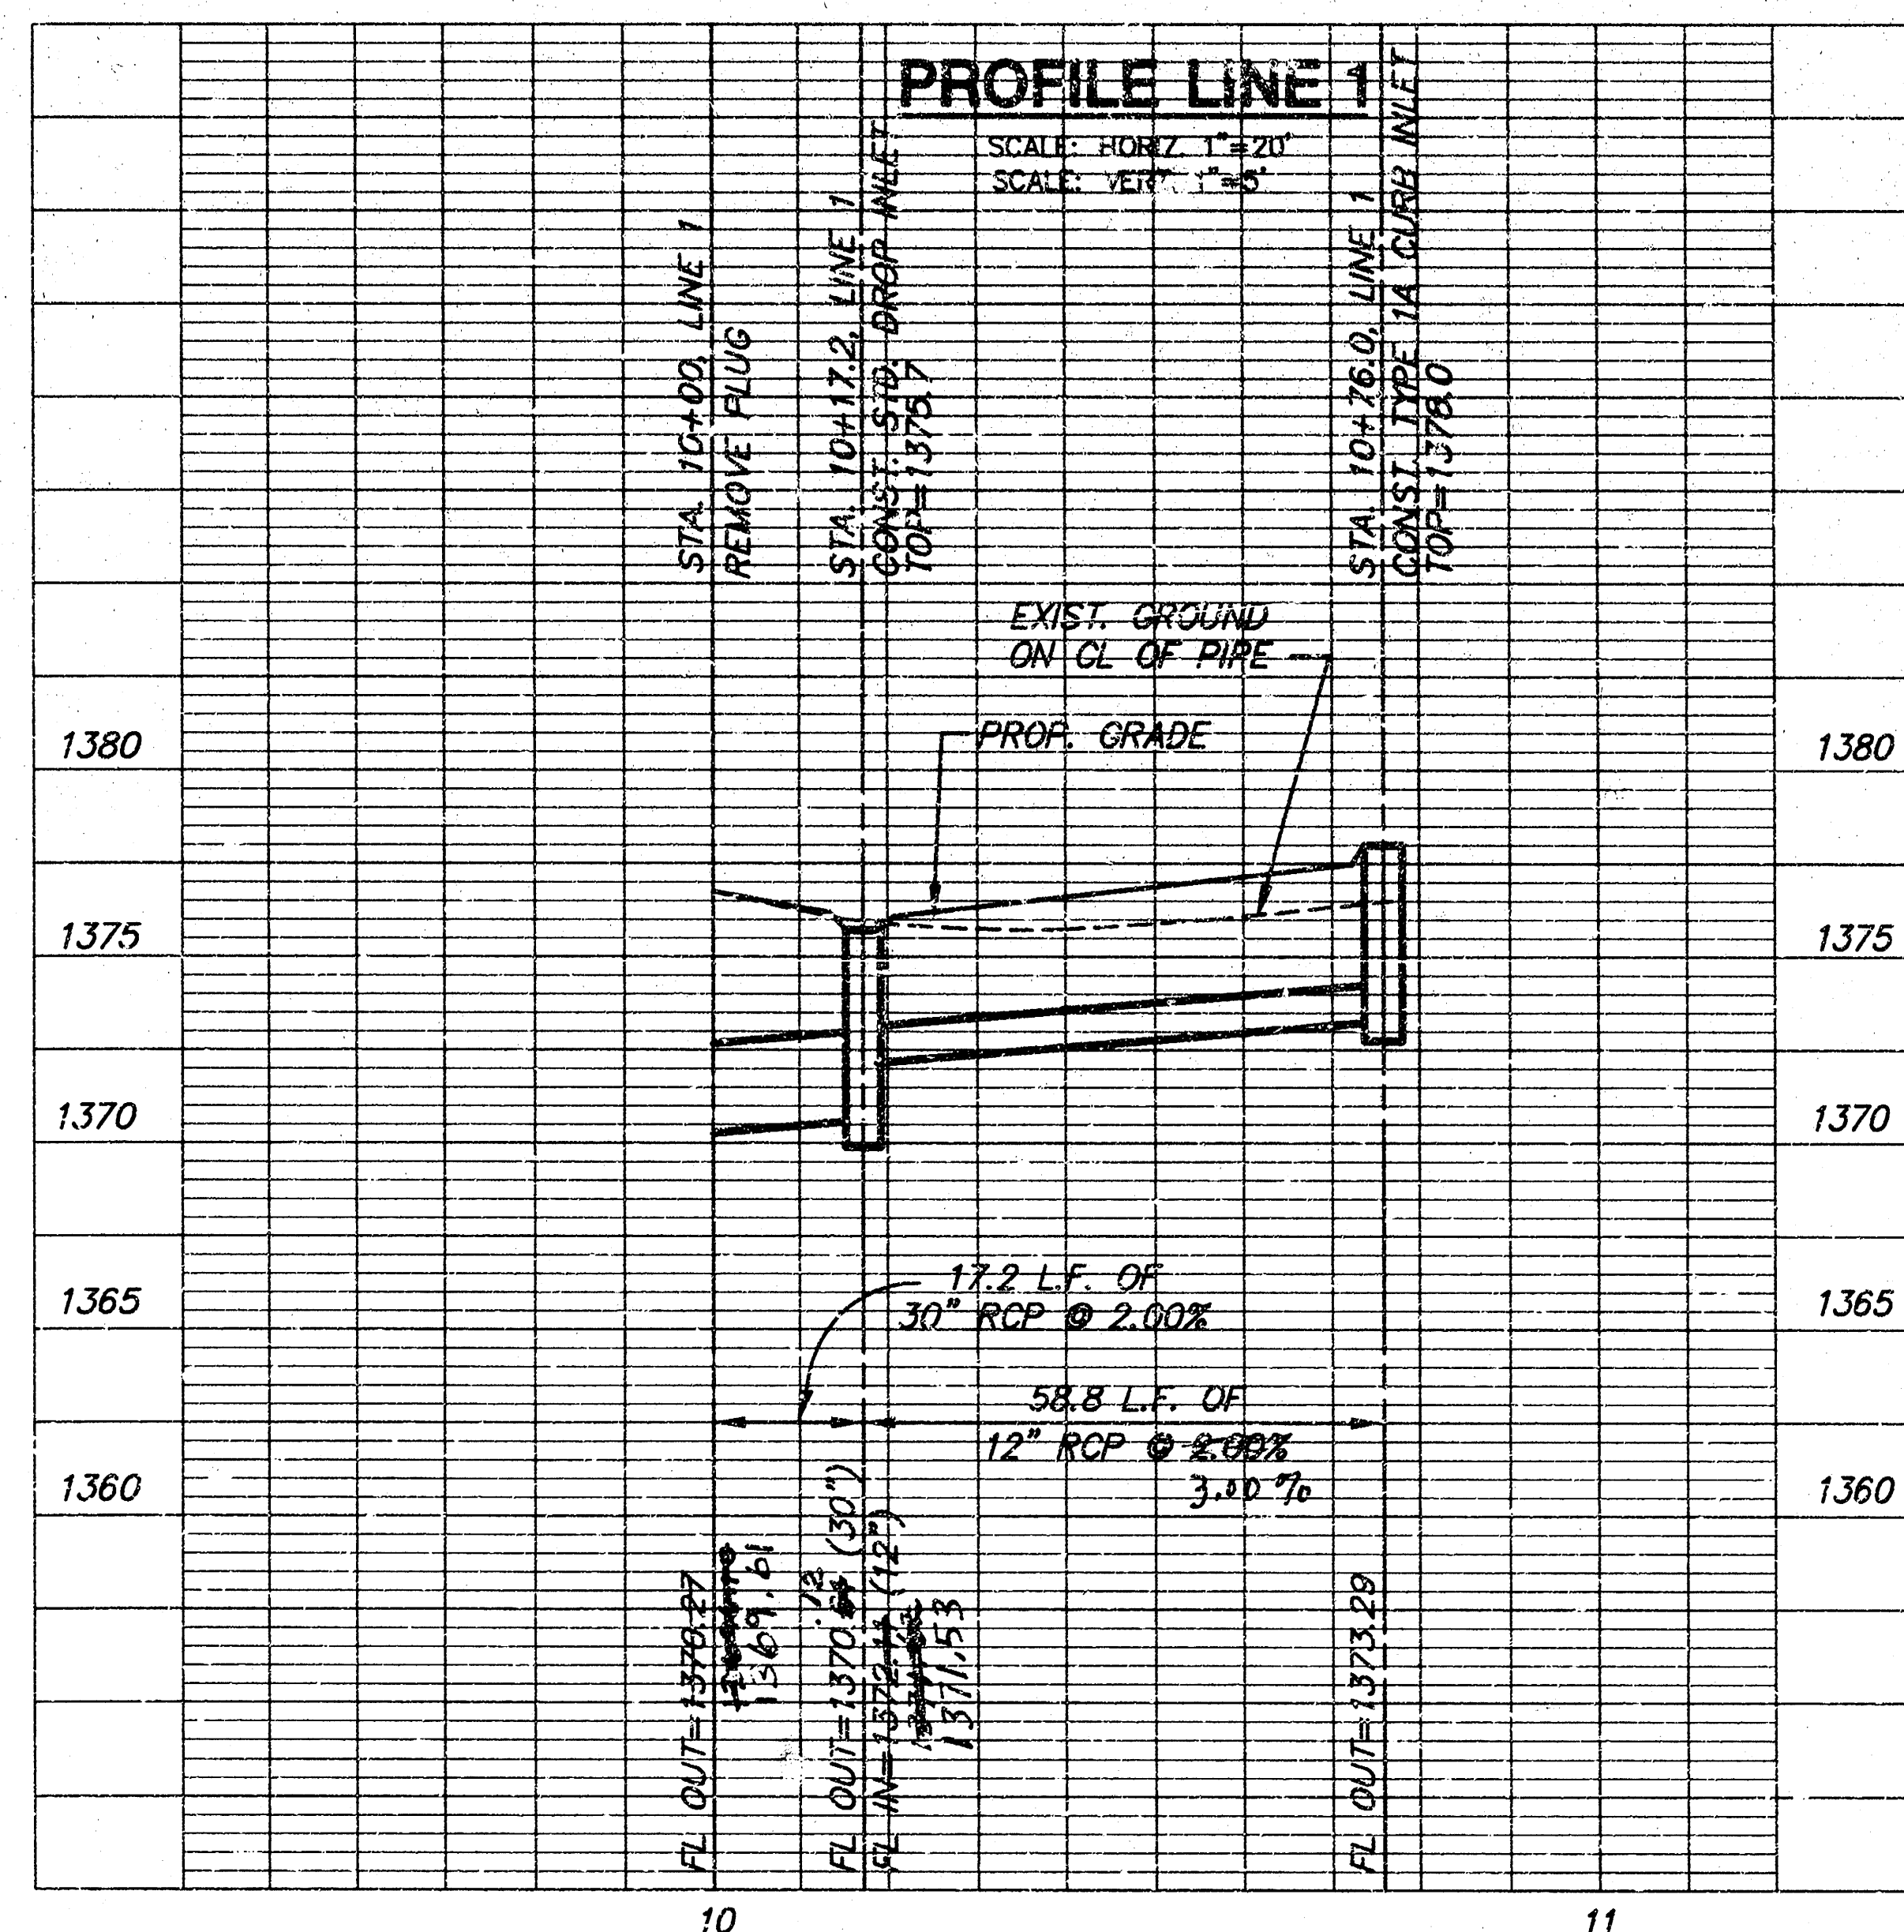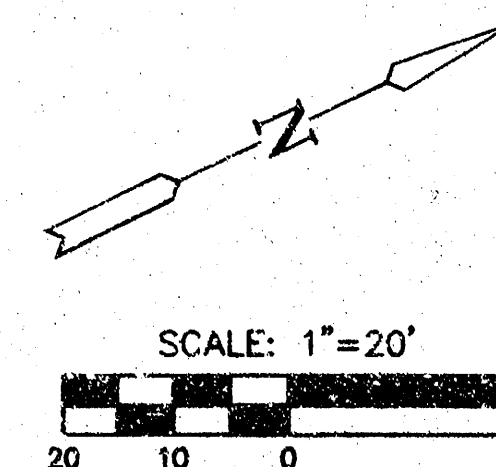


BM #1 "D" TOP OF CURB AT SOUTH END OF 4TH ISLAND NORTH
OF 13TH ST. NORTH, CL WATERFRONT PKWY., NEAR SW
COR. LOT 5, BLK 1, WATERFRONT 2ND ADD.
ELEV=1375.49

BM #2 BRASS DISC IN TOP OF WEST CURB OF WATERFRONT
PKWY., BY INLET SOUTH OF BOX IN RESERVE "D".
ELEV=1376.81

BM #3 BRASS DISC IN TOP OF WEST CURB OF WATERFRONT
PKWY., 292' NE OF SE COR. LOT 5, BLK 1,
WATERFRONT ADDITION
ELEV=1374.91


Long Na
Street

NOTE:
CONTRACTOR TO VERIFY
LOCATION AND ELEVATION OF
EXIST. UTILITIES PRIOR TO
CONSTRUCTION.

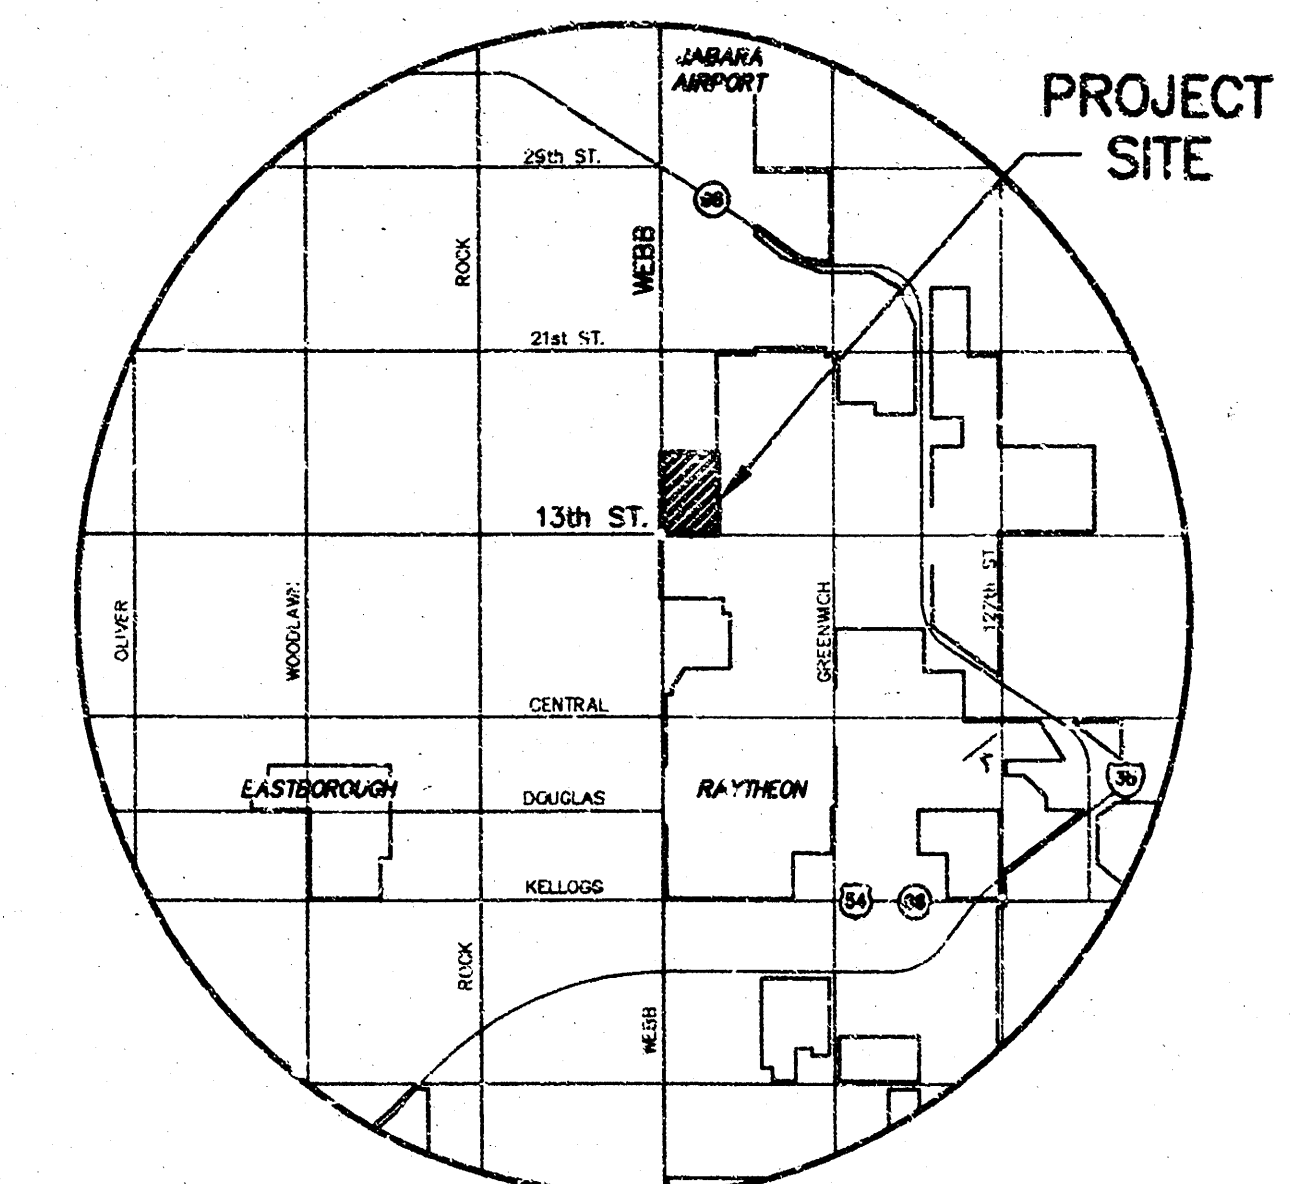

VICINITY MAP

NO SCALE

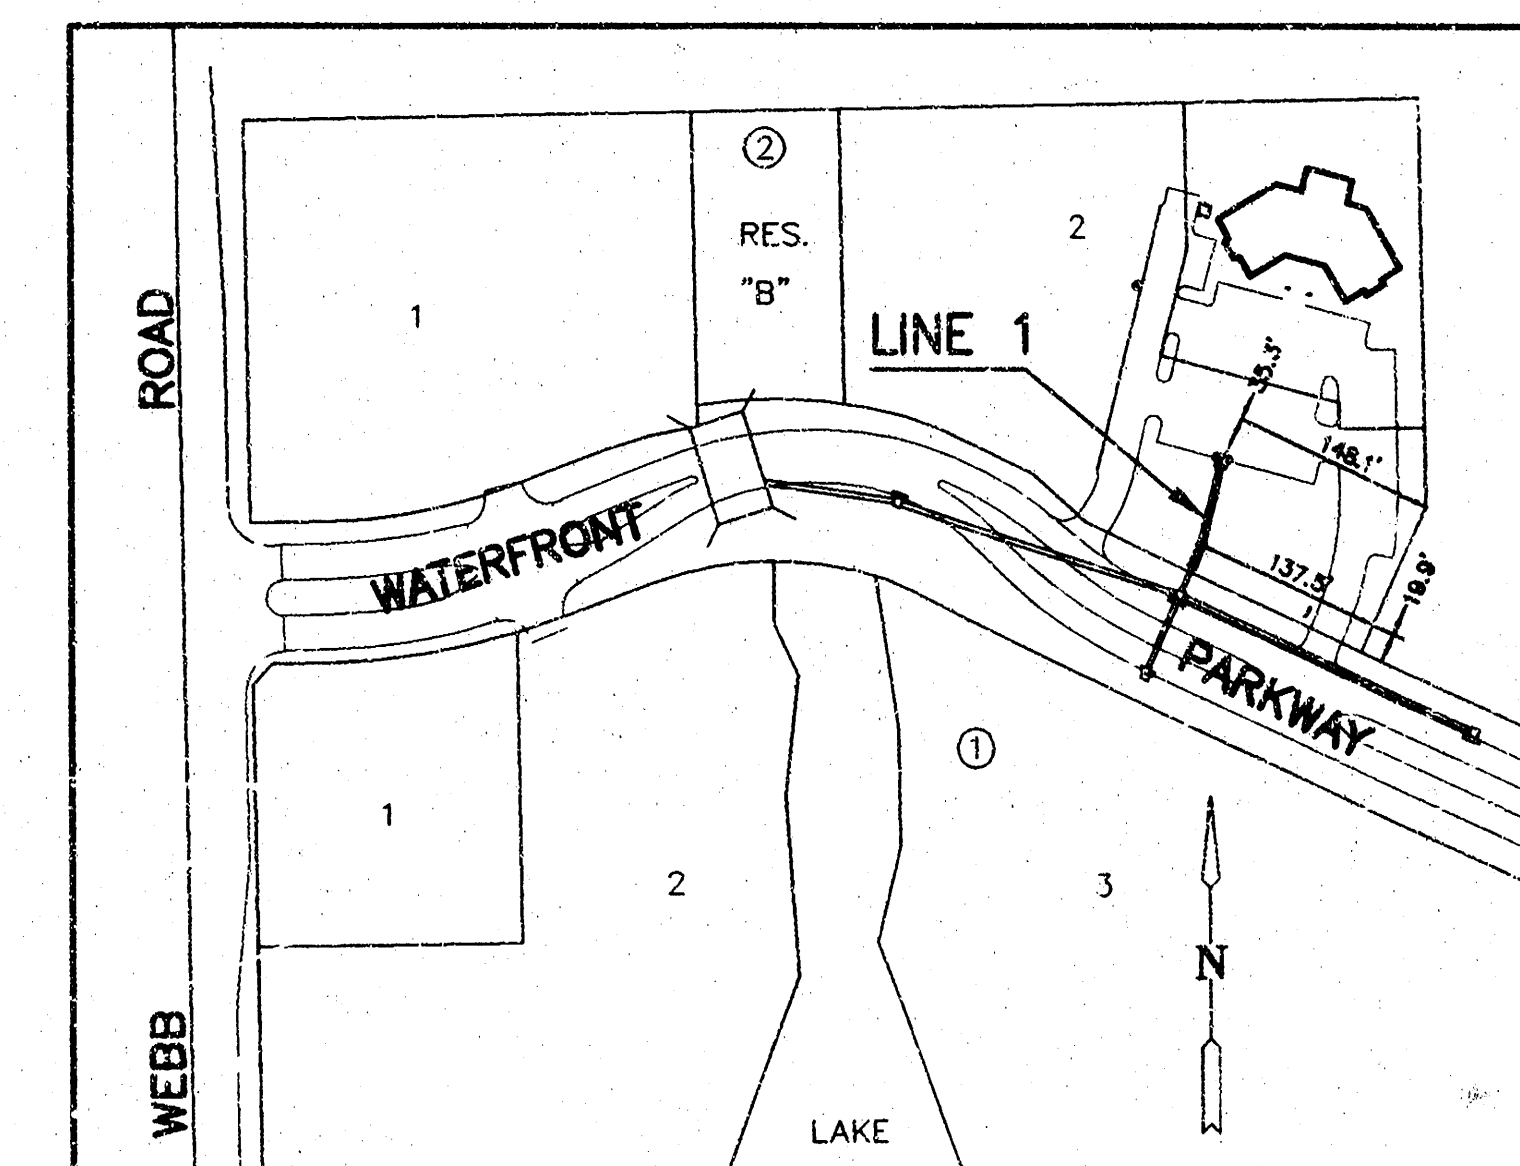

LOCATION MAP

SCALE: 1"=150'

**CITY OF WICHITA
PRIVATE PROJECT
NO. 1458 PPS (607861)**

REVISED MAY 12, 2004



MKEC
ENGINEERING
CONSULTANTS

411 N. WEBB ROAD
WICHITA, KS. 67206
316 - 684 - 9600

**OIL PRODUCERS BUILDING
LOT 2, BLOCK 2 - THE WATERFRONT ADD.**

STORM SEWER PLANS

SHEET TITLE

SKS
DESIGN BY:

DESIGN BY:

APRIL 2004

DATE

KKL
DRAWN BY:

DRAWN BY:

03014 01

JOB NO.

GJA
CHECKED B

CHECKED B

6 /

SHEET/OF

31 10-40 41