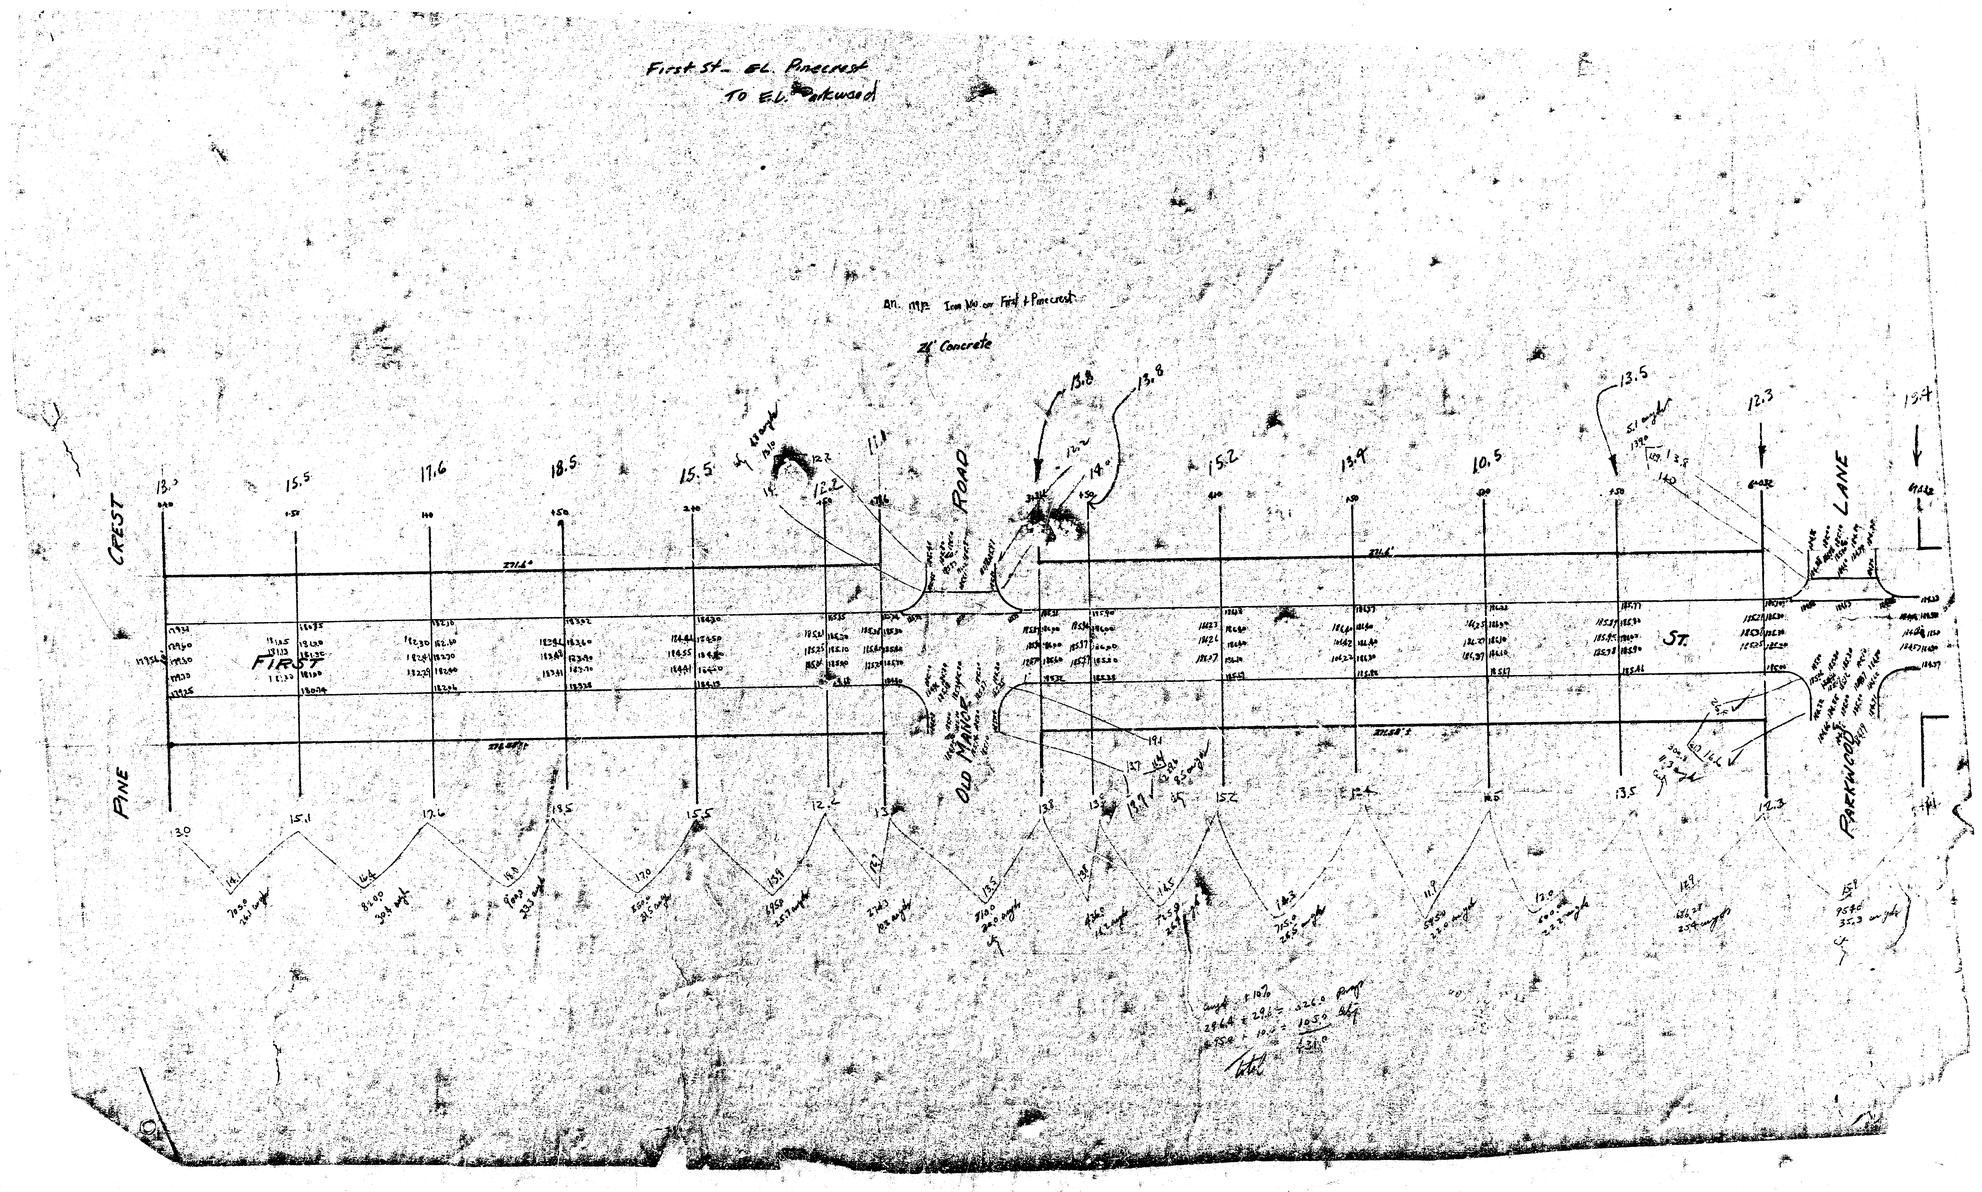
First St. at. Pinecrest
To E.L. Parkwood
24' Concrete
PINE CREST
FIRST
OLD MANOR ROAD
ST.
PARKWOOD LANE