


2nd E.L. Old Manor W.L. Parkwood
26' Concr.

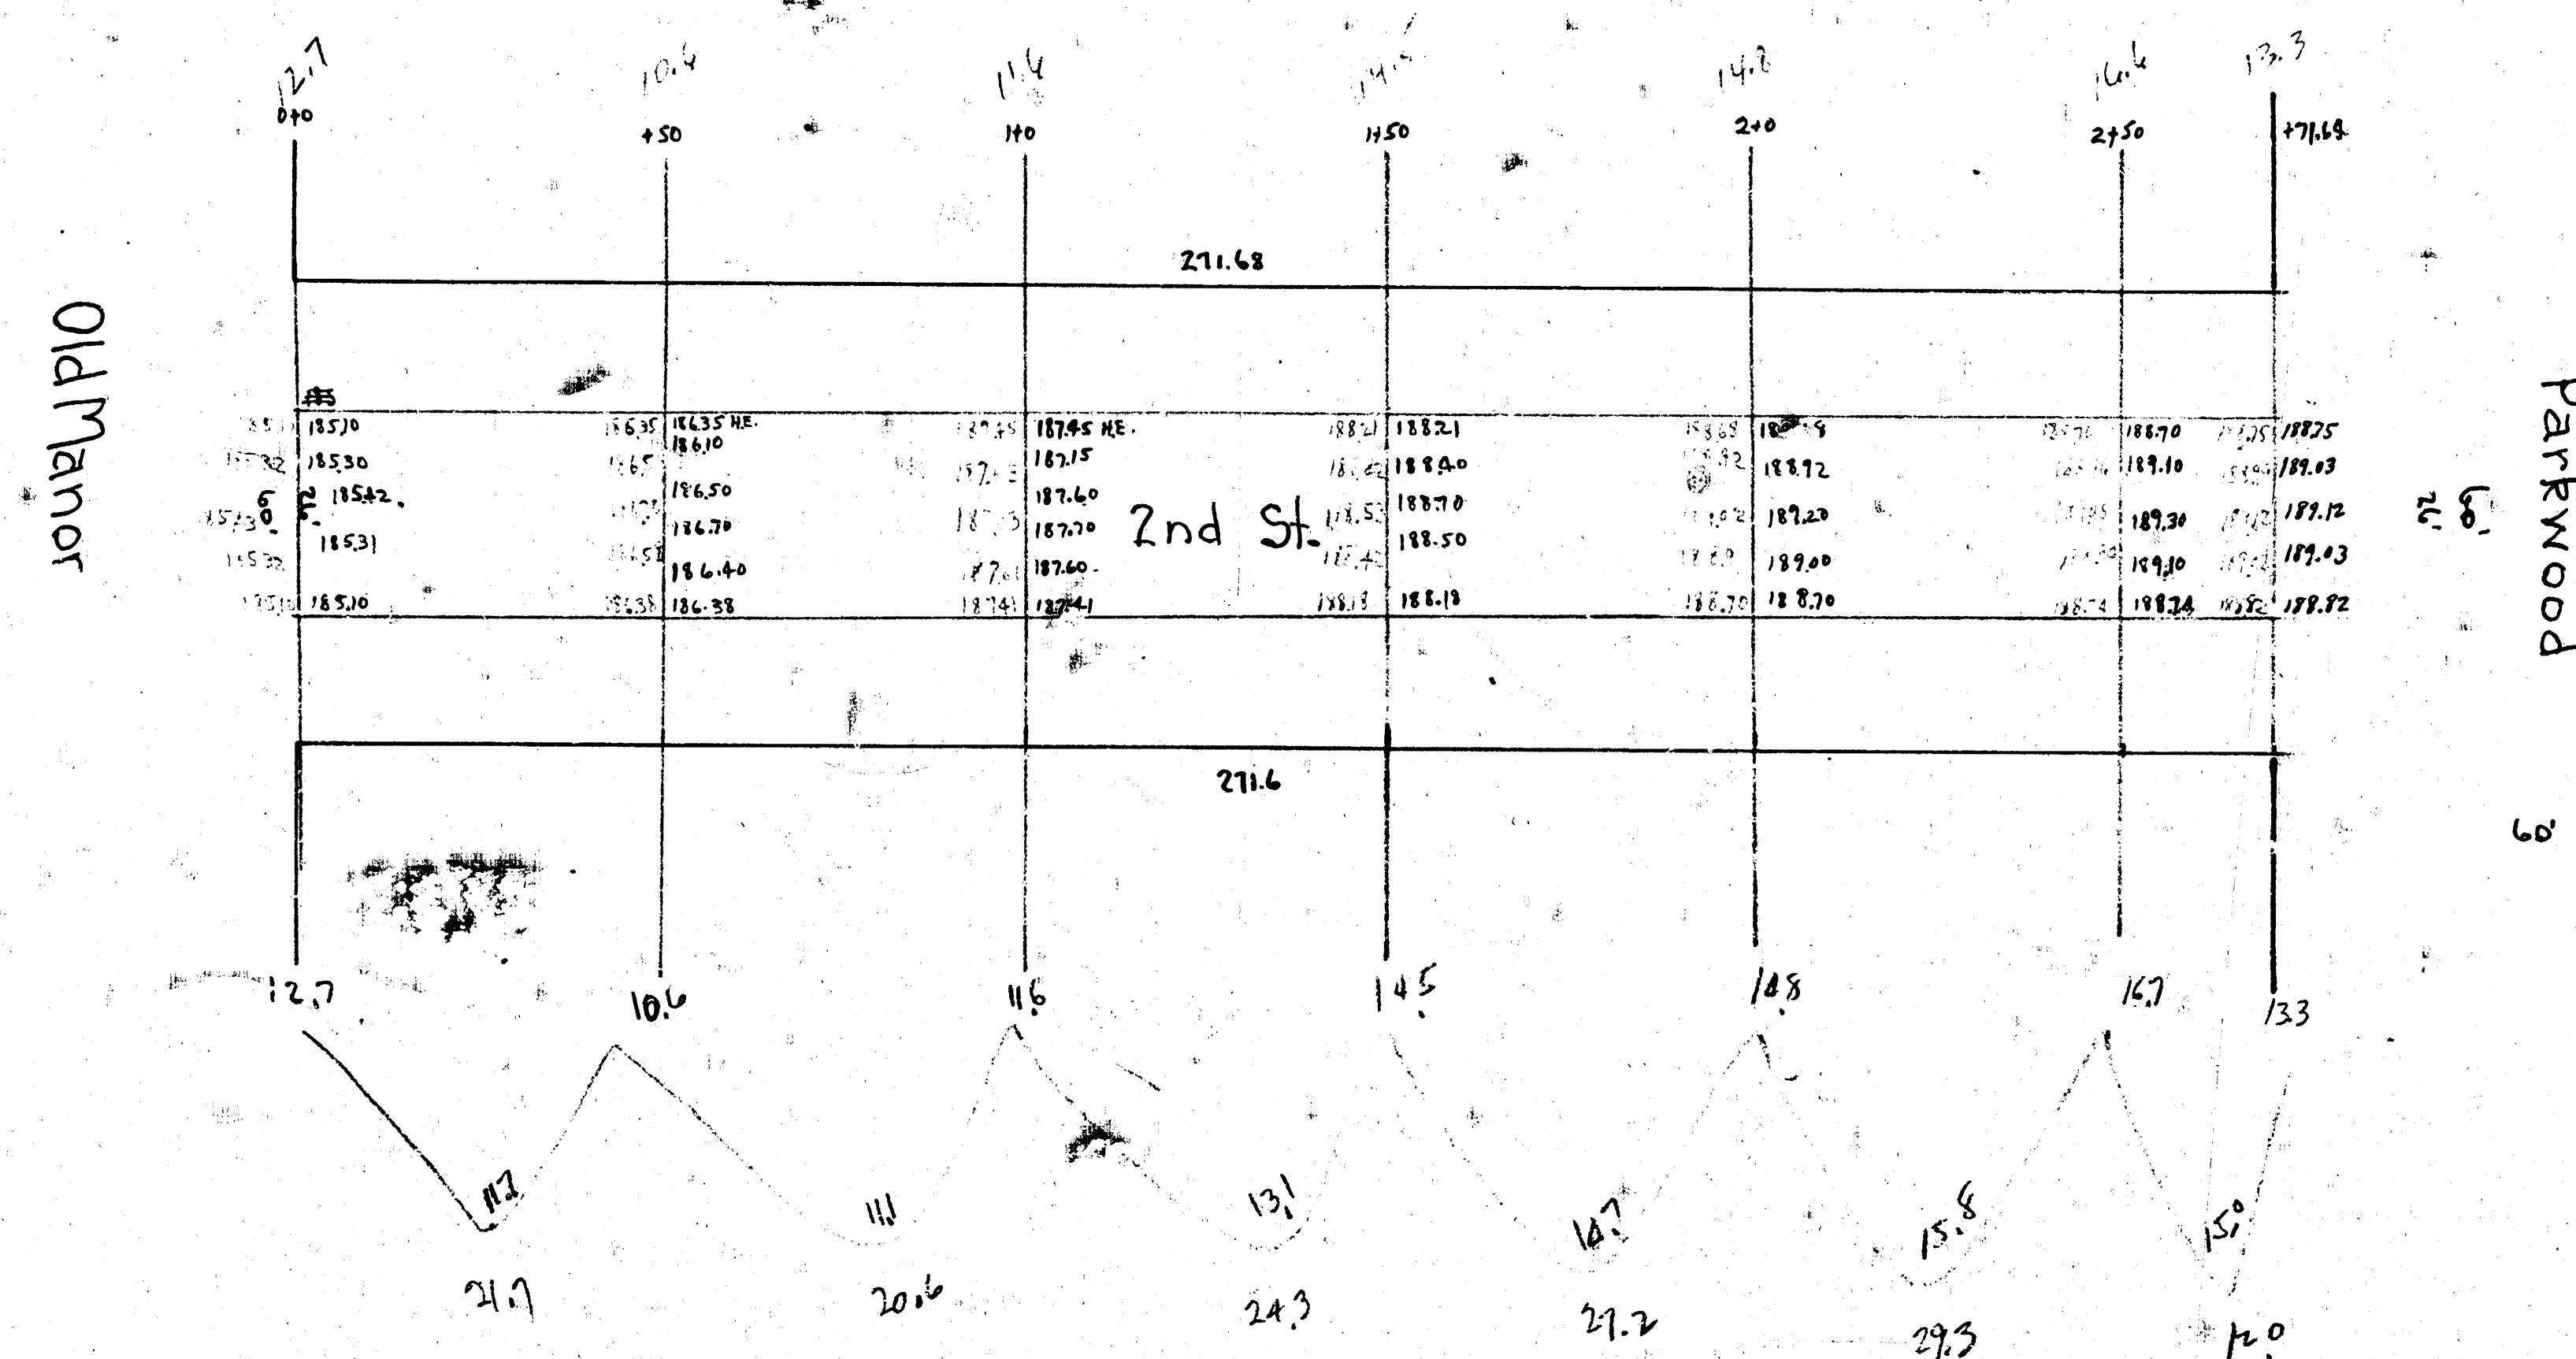

Prop. 135.1
+18.7 13.5
148.6

By Elev. 117.24 "B" in 2nd E.L. of Parkwood 2nd St.

Paving Plan
2nd
E.L. Old Manor
W.L. Parkwood
1940