


2nd E.L. Old Manor W.L. Parkwood
26' Concr.

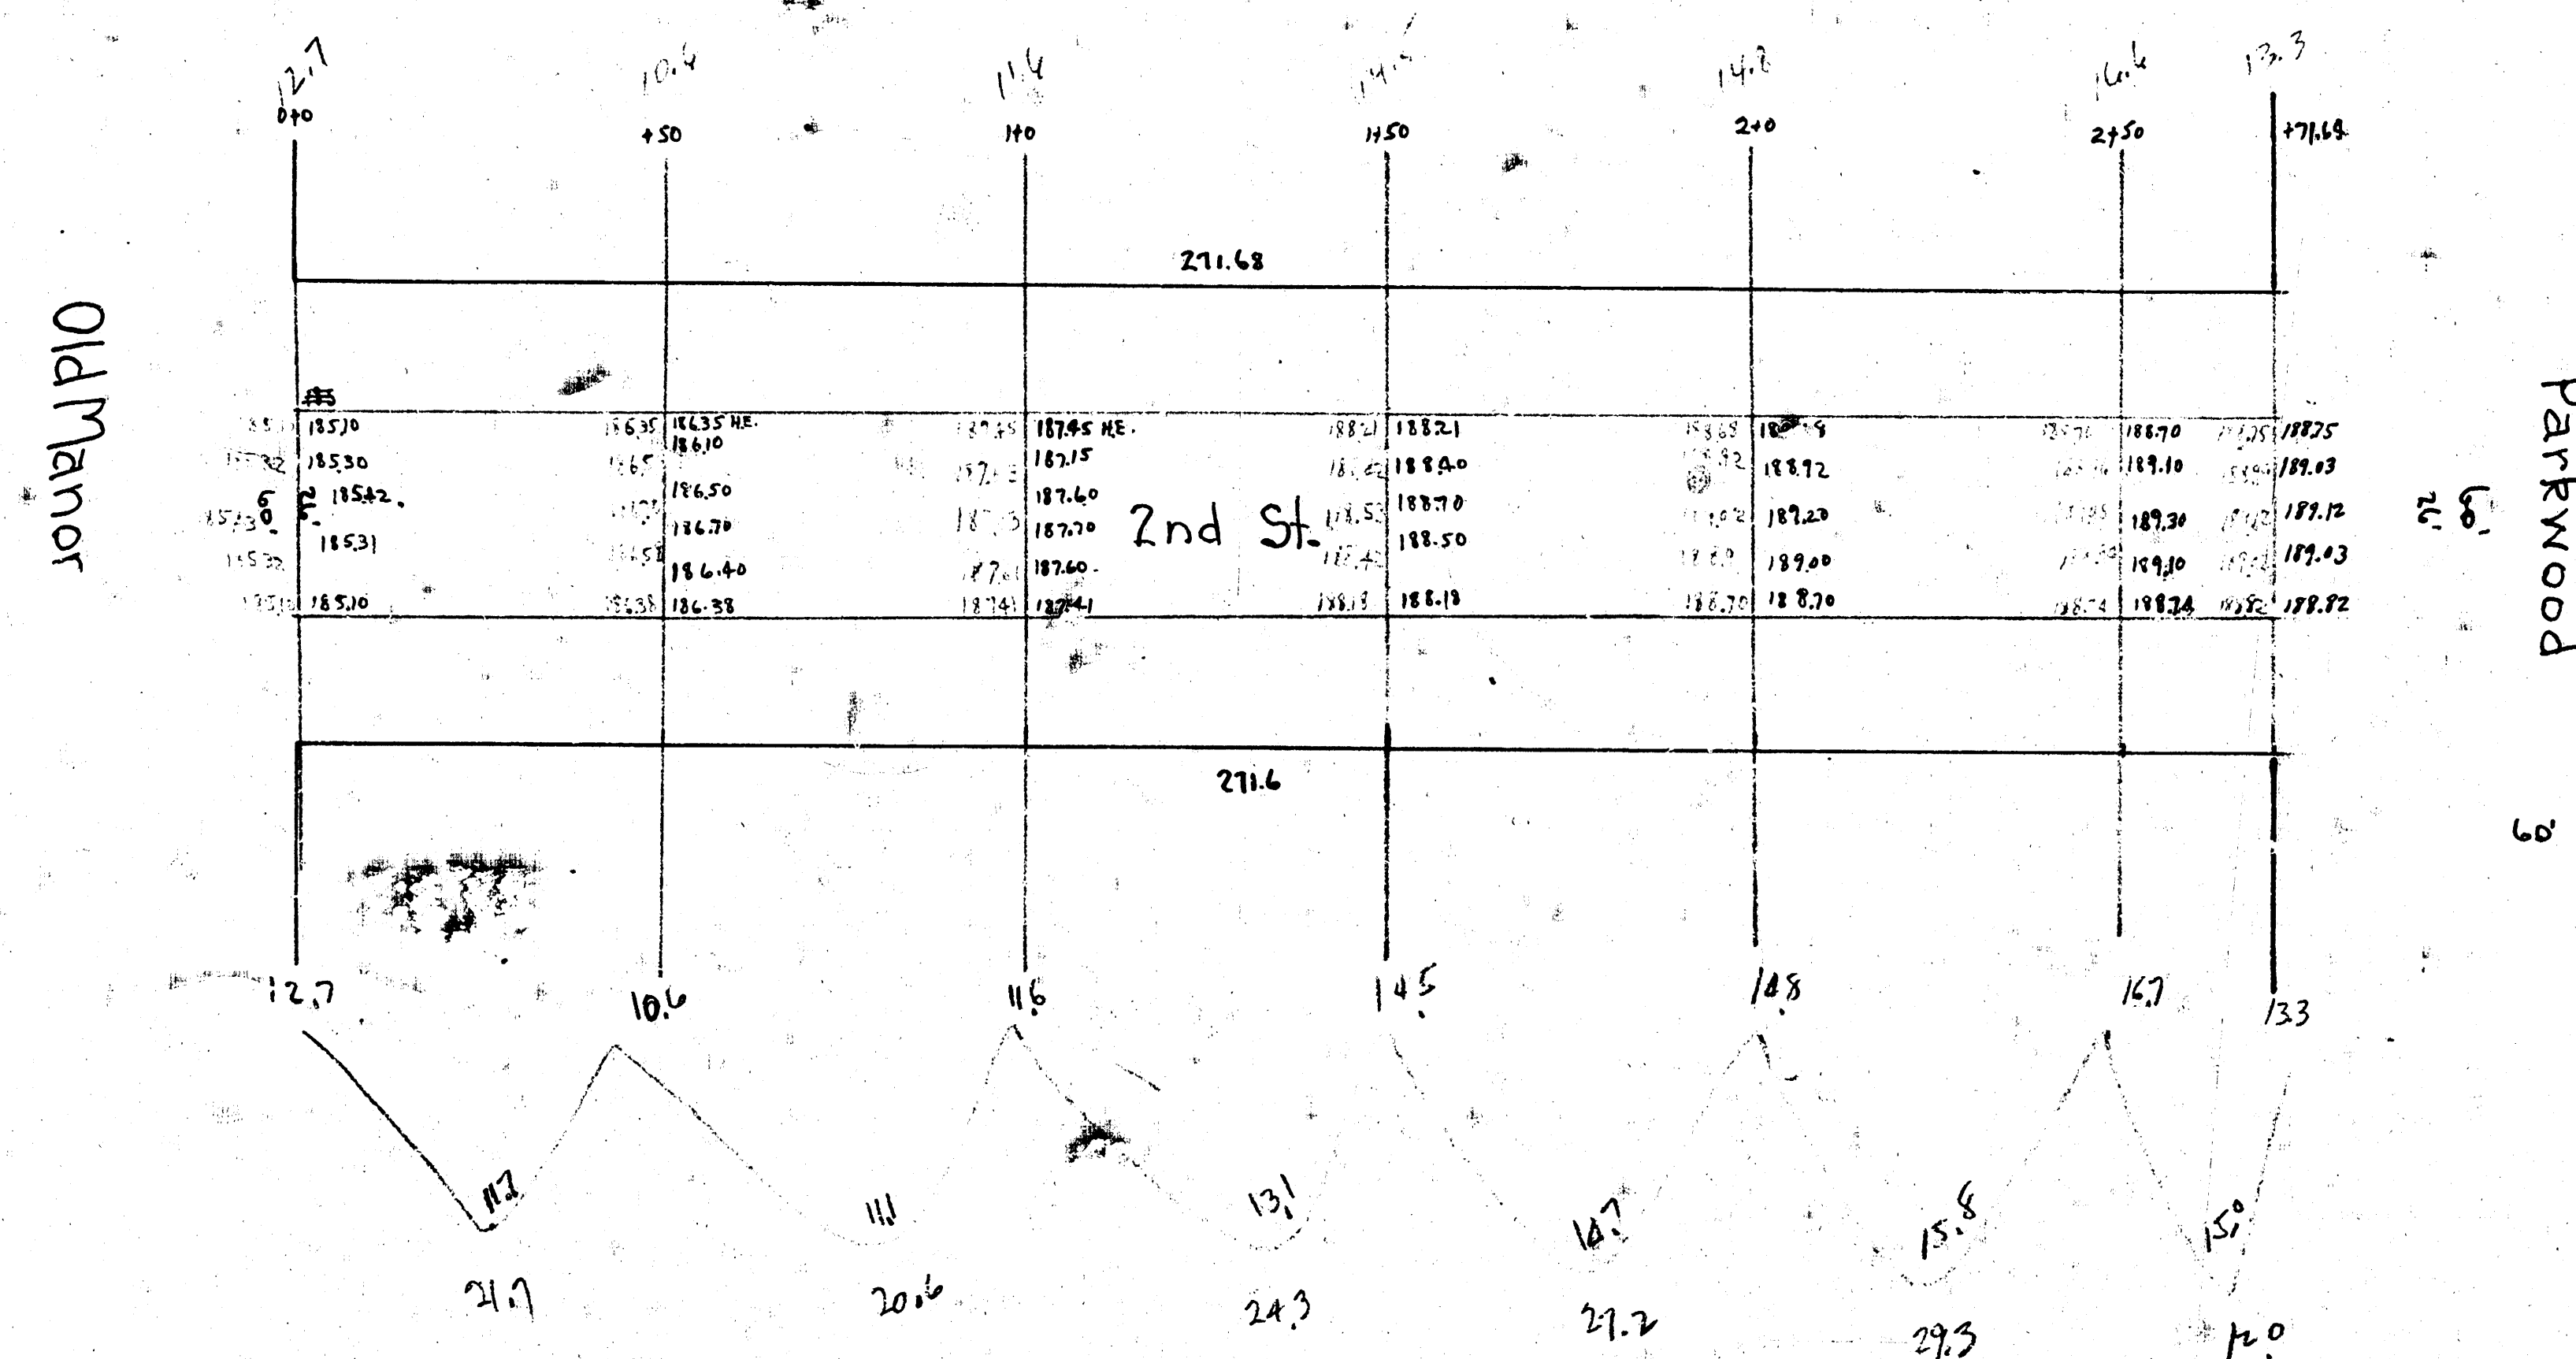

Prop. 135.1
+187 13.5
148.6

Prop. Elev. 117.24 "B" in Old Manor W.L. Parkwood 2nd St.

Paving Plan
2nd
E.L. Old Manor
W.L. Parkwood
1940