


Parcel  
 B.M. 17913 Iron Riv. cor Pinecrest & 1st  
 176.86 Wood 2nd W. Pinecrest

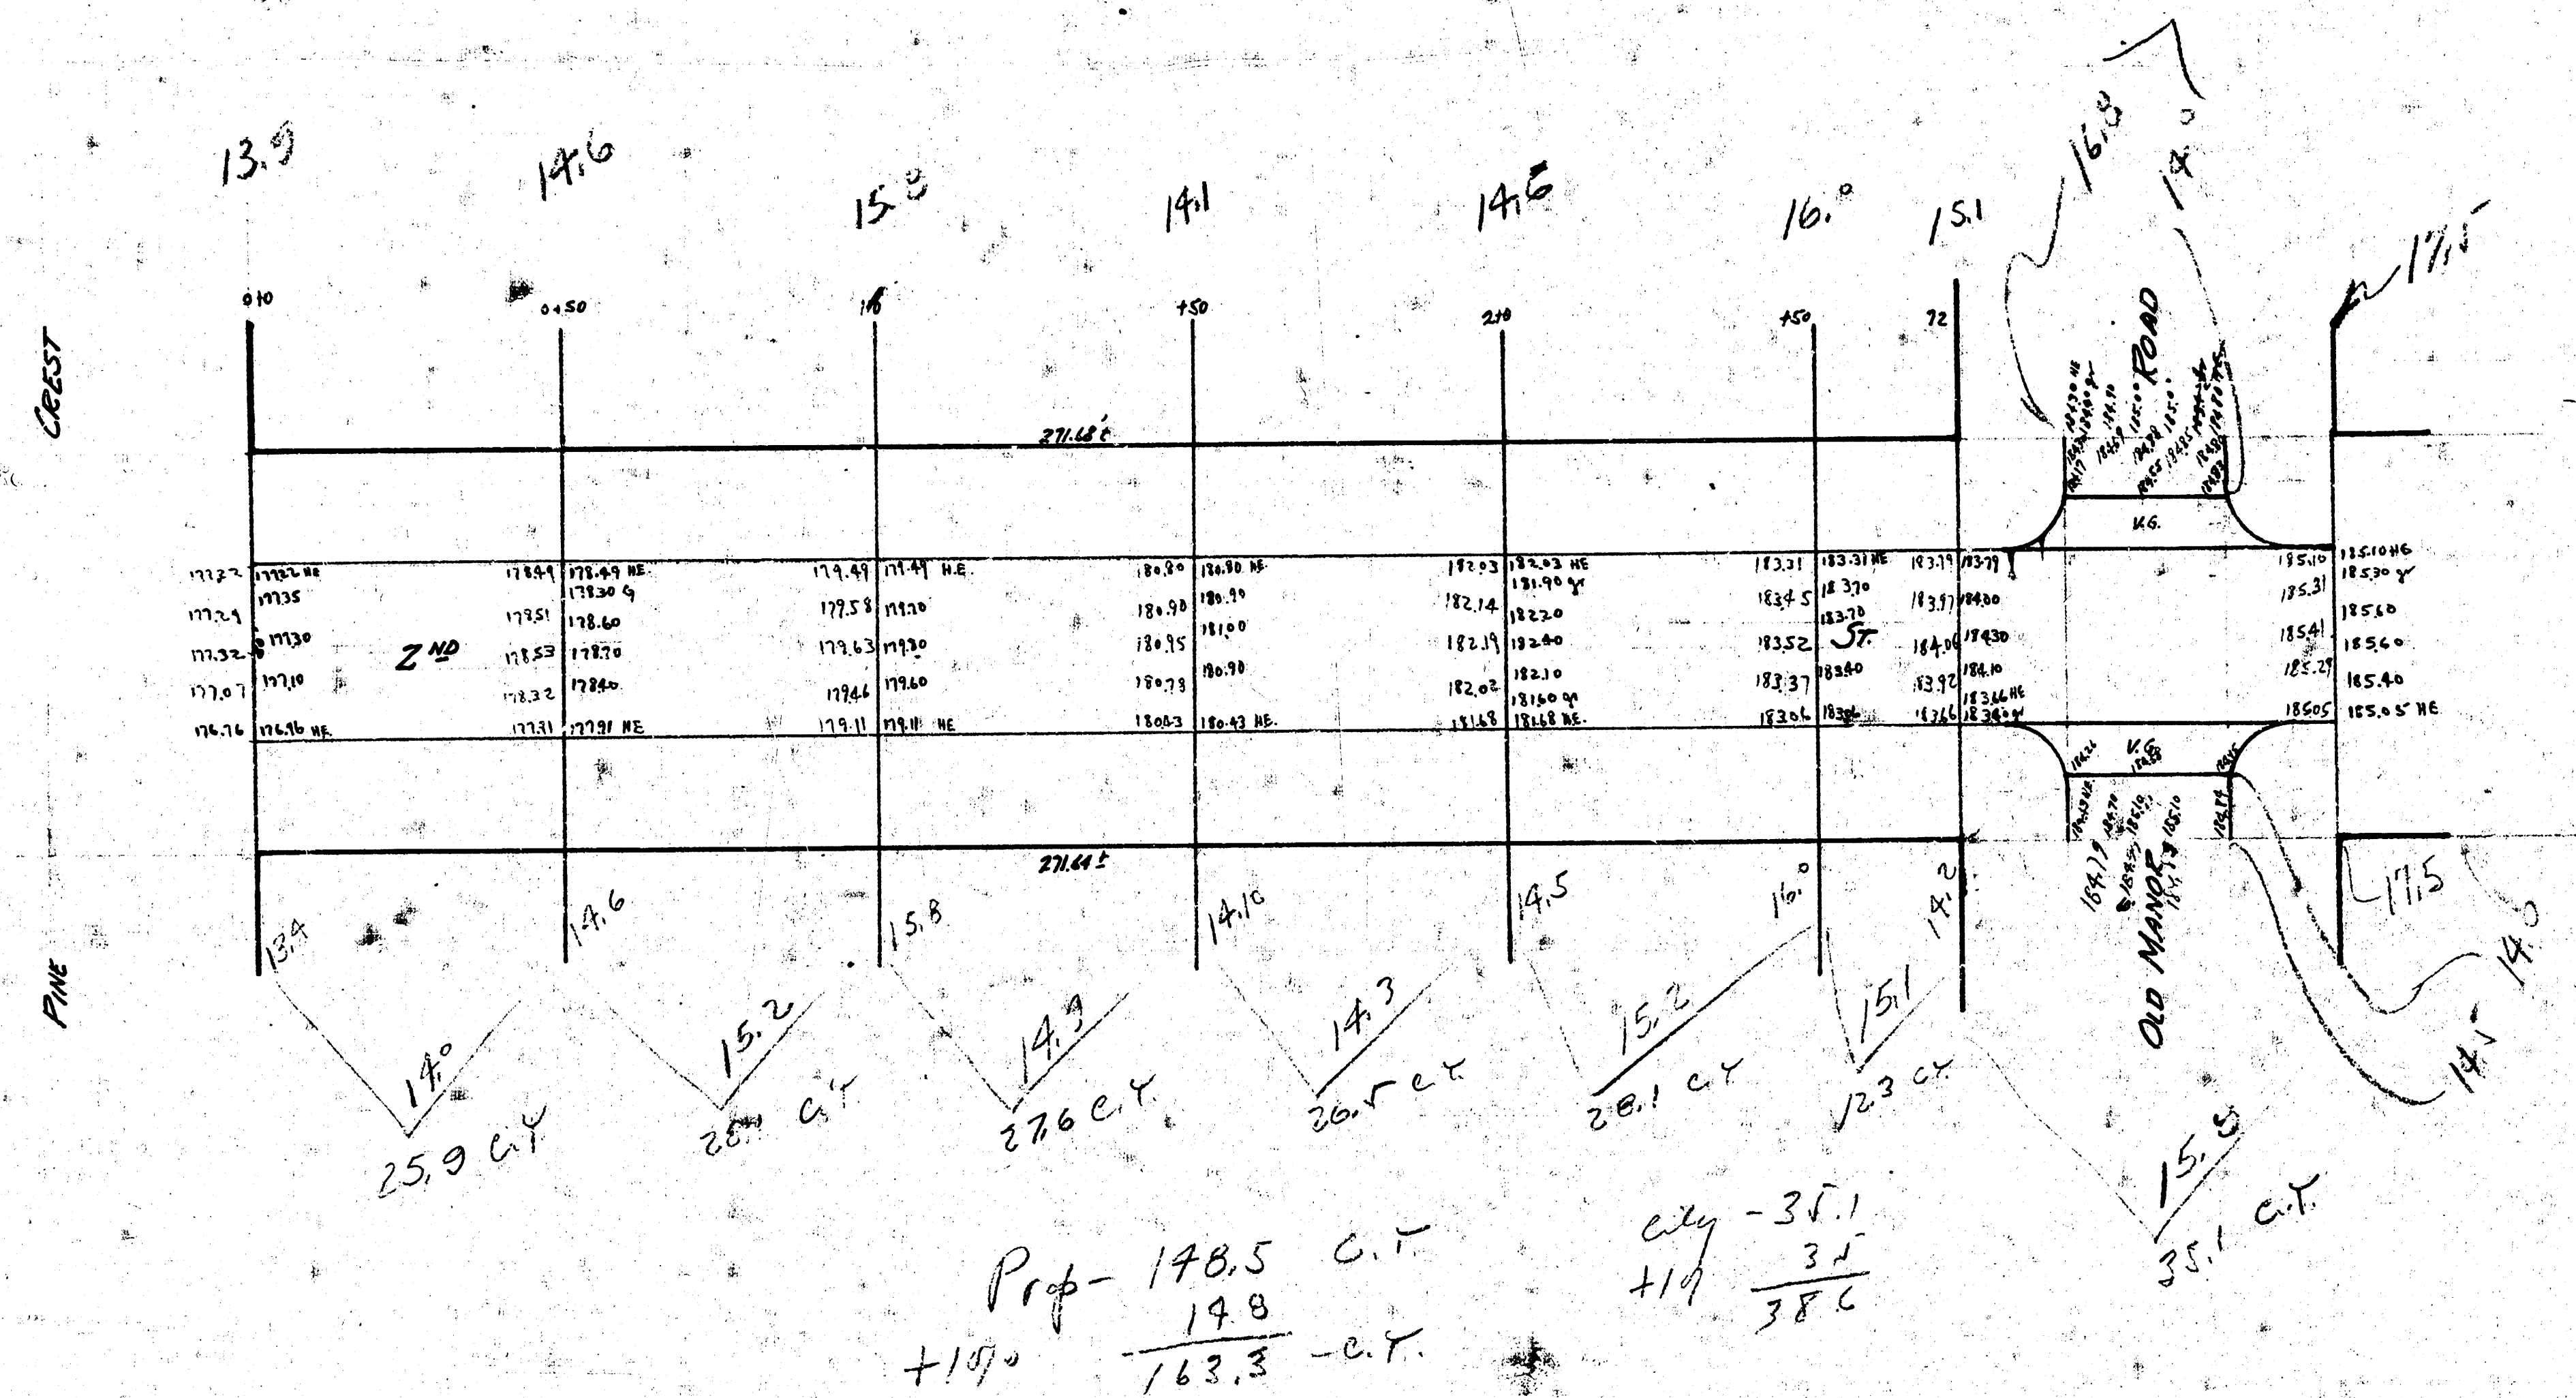

Survey Plan  
 17913  
 2nd St.  
 6th Pinecrest  
 6th Outflow