


PLANS PLAN
 1942
 Second St
 E.L. Ridgewood
 to
 W.L. Edgemoor

1942
 Second St - E.L. Ridgewood to W.L. Edgemoor
 30' Conc. - Int. Cb.

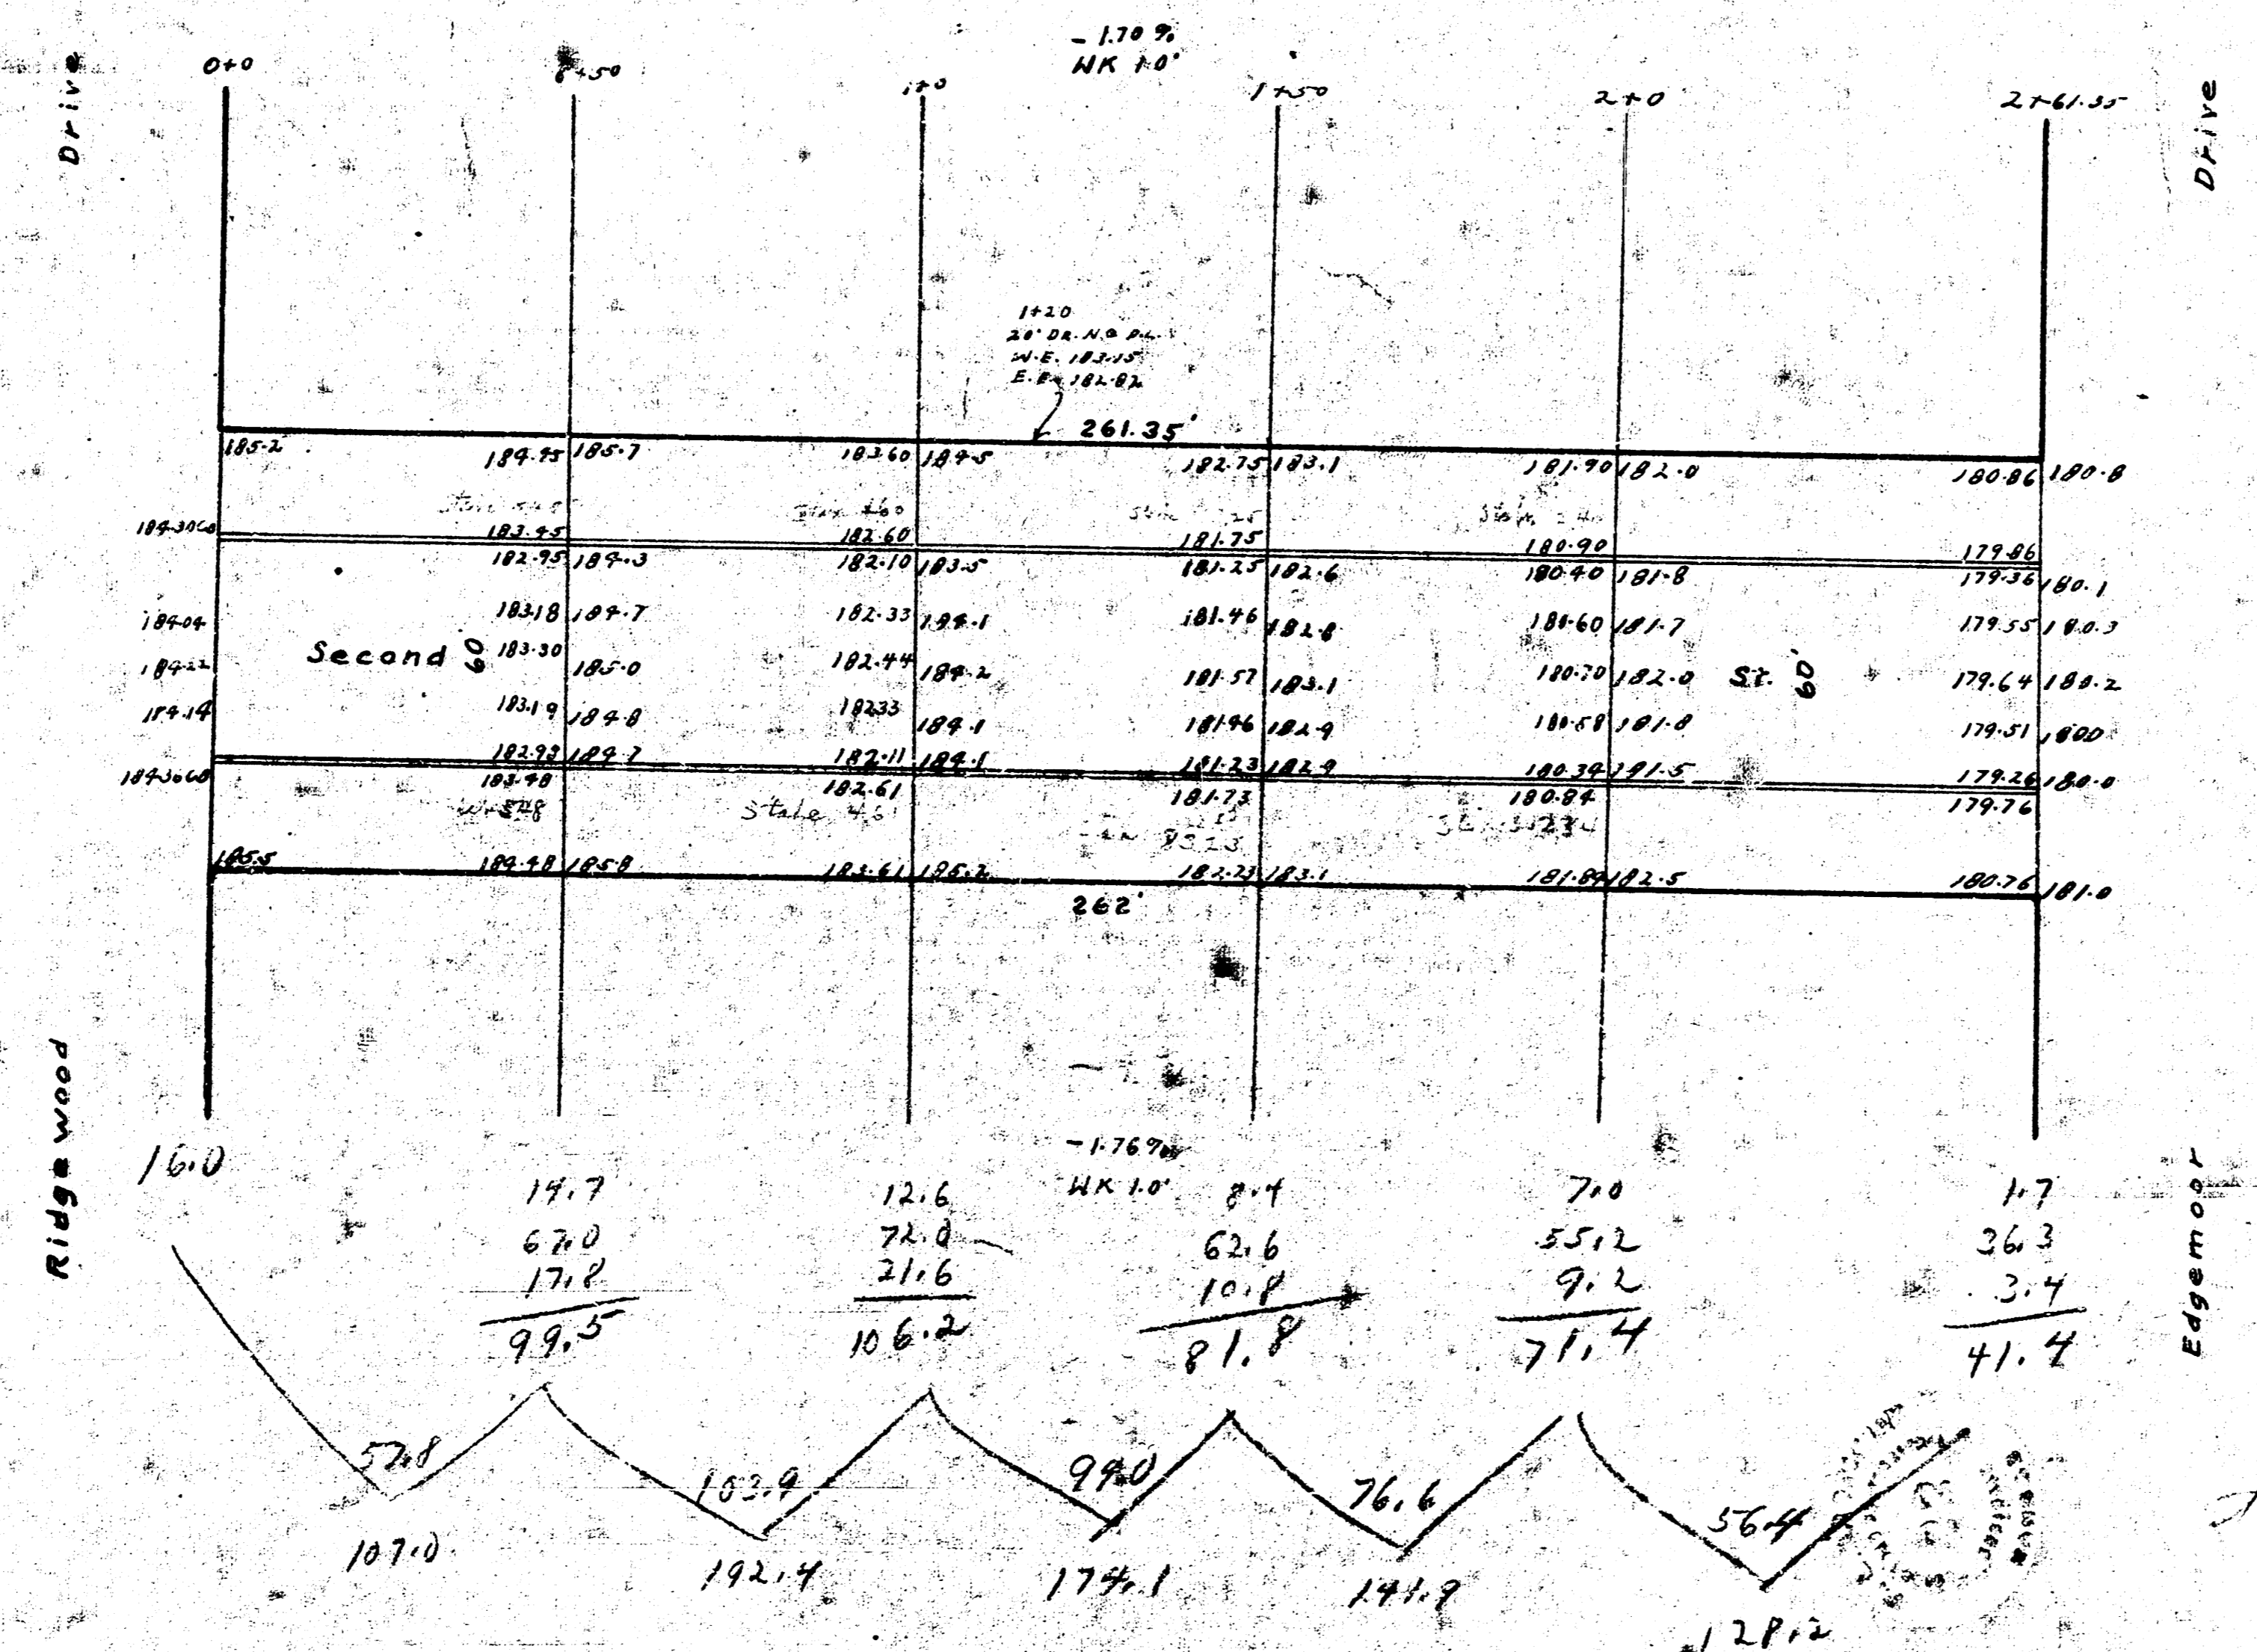

107.0
 172.4
 177.1
 141.7
 122.2
 743.6
 74.4
 818.0

B.M. 17941 "G" IN GLOBE W. CO. EDGEMOOR S.L. 2nd