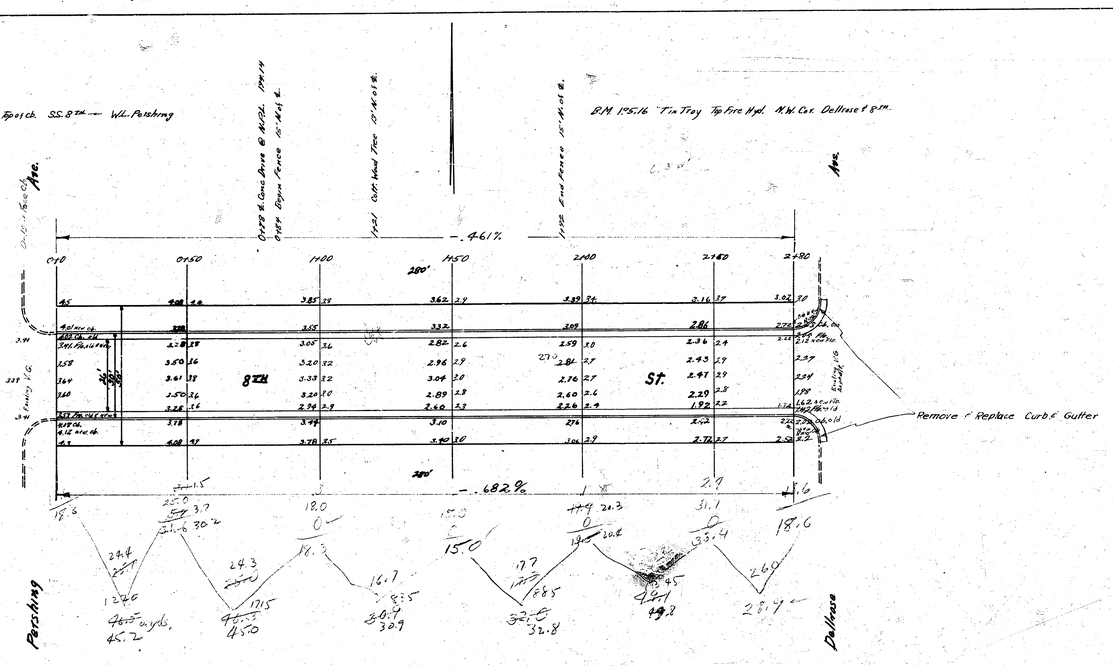

8th St.

E.L. Pershing ~ W.L. Dellrose

26'-2'-30' A.C.

City of Wichita, Kansas

L.K. White — City Engineer

June 1949 — Project CIP-117