


B.M. 12328 Top Iron 3L 10" St. E.L. Estelle

A 0.19%
WK 0.4'

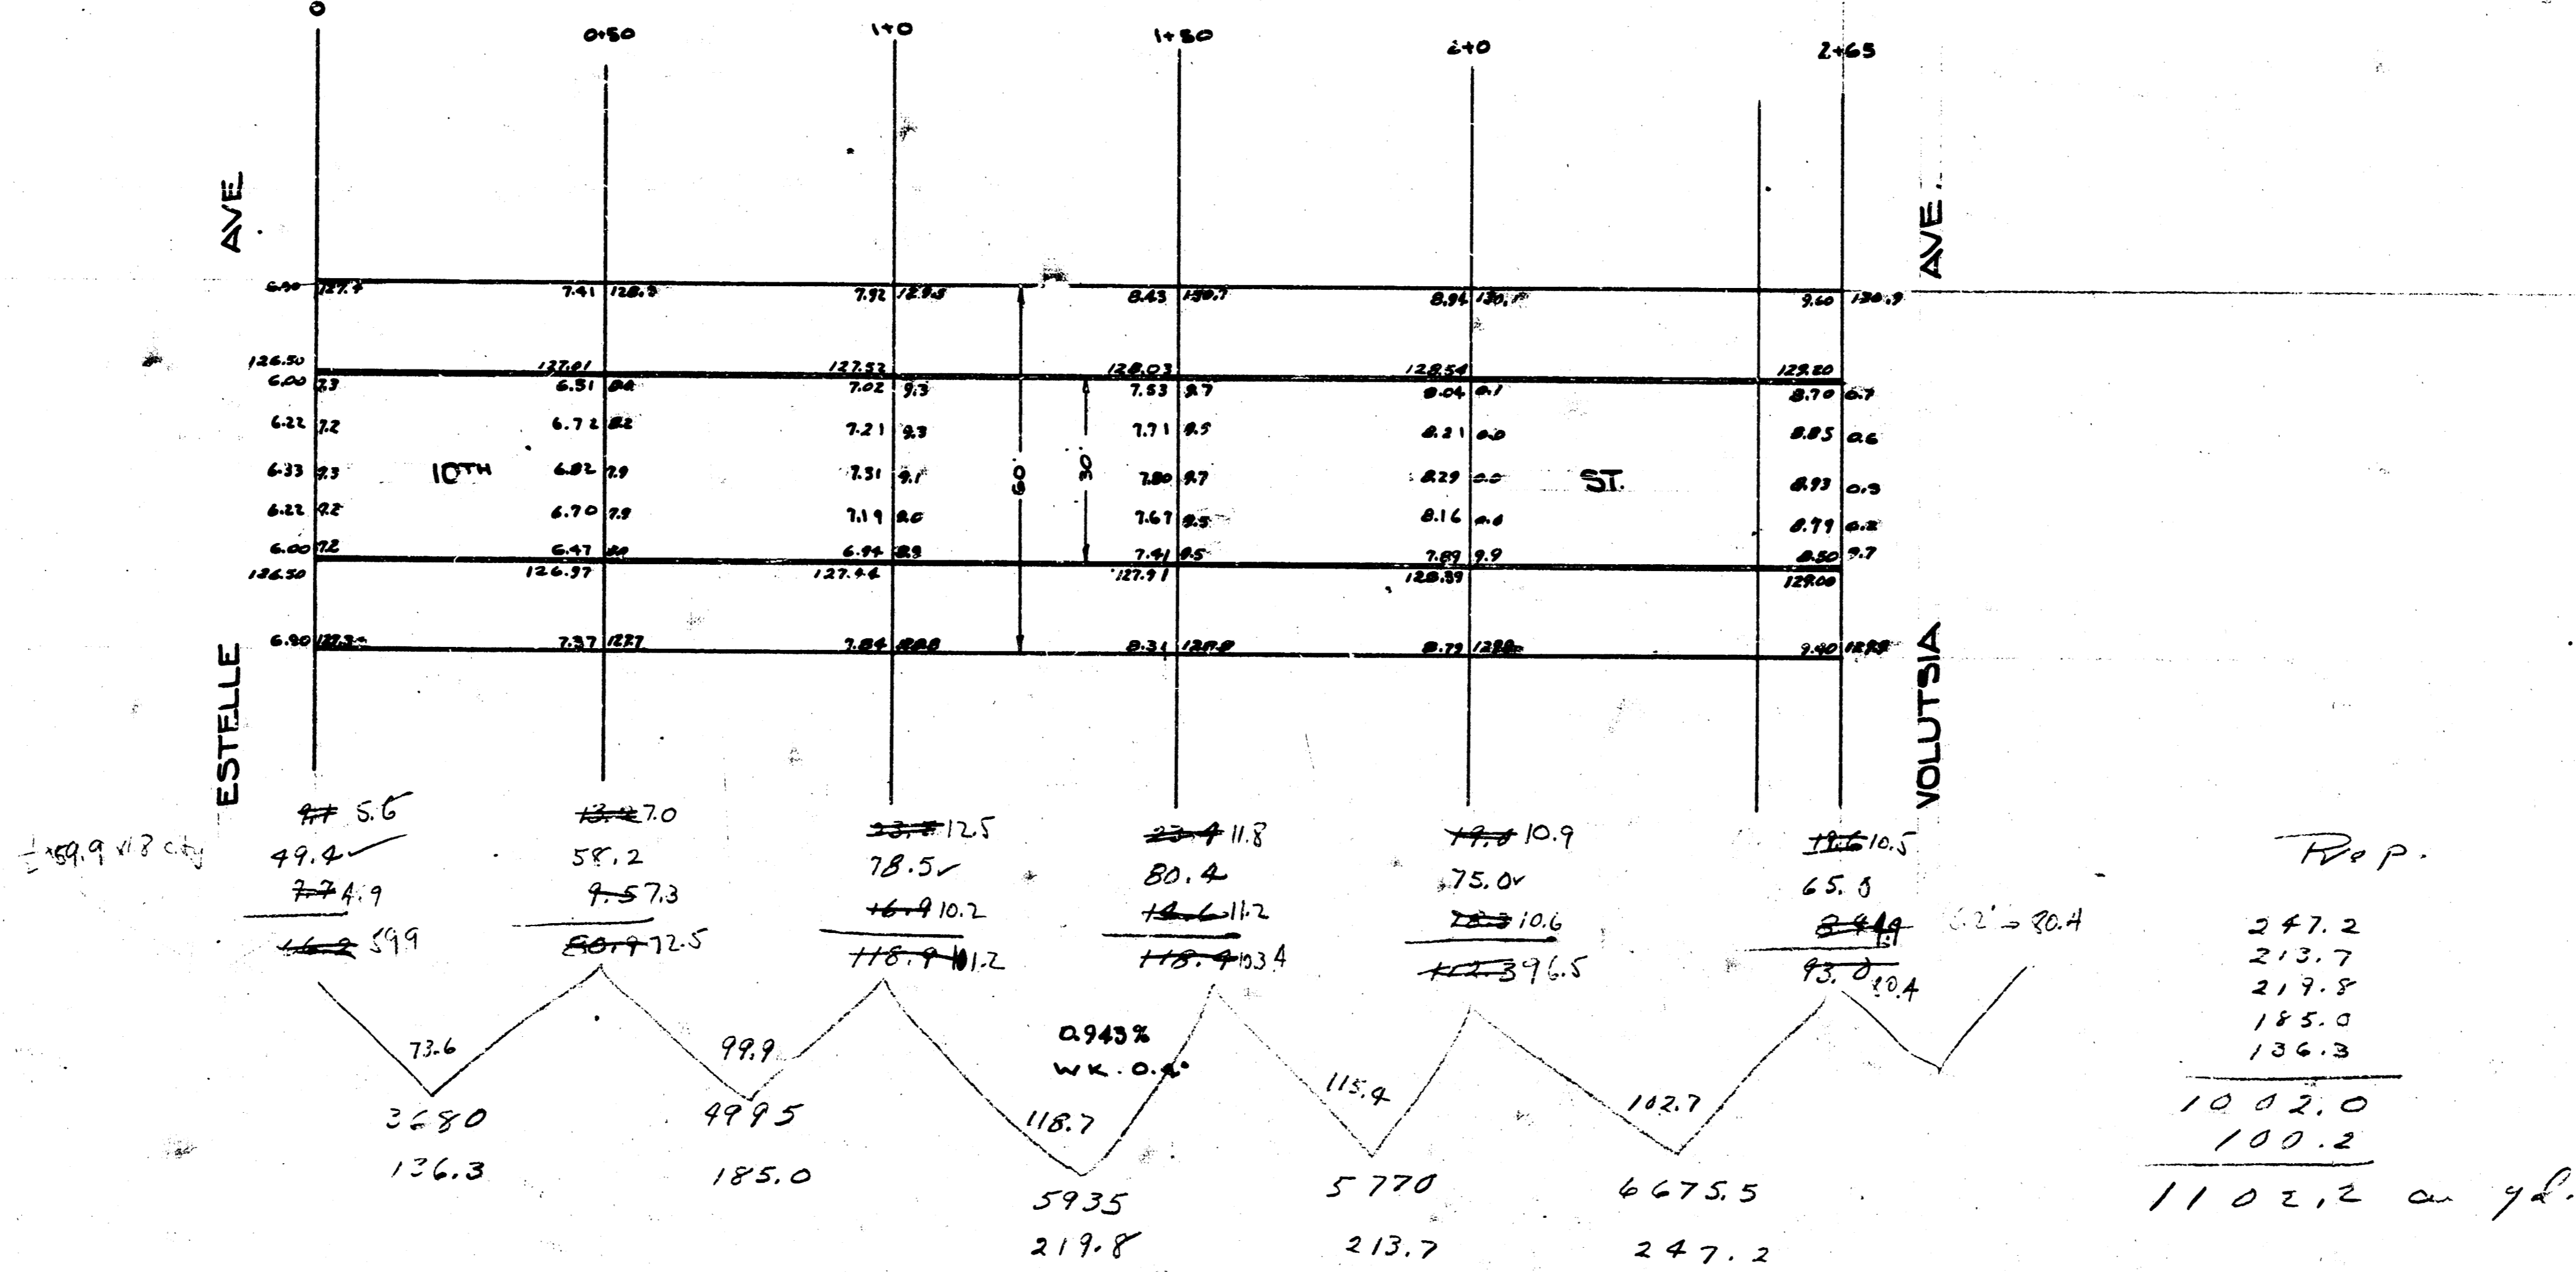

TENTH ST.
E.L. ESTELLE + W.L. VOLUTSIA
30' CONCRETE
CITY OF WICHITA, KANS.
L.K. WHITE - CITY ENGR
MARCH 1947

10 1 8