


Continuous pavement
 offset above curb

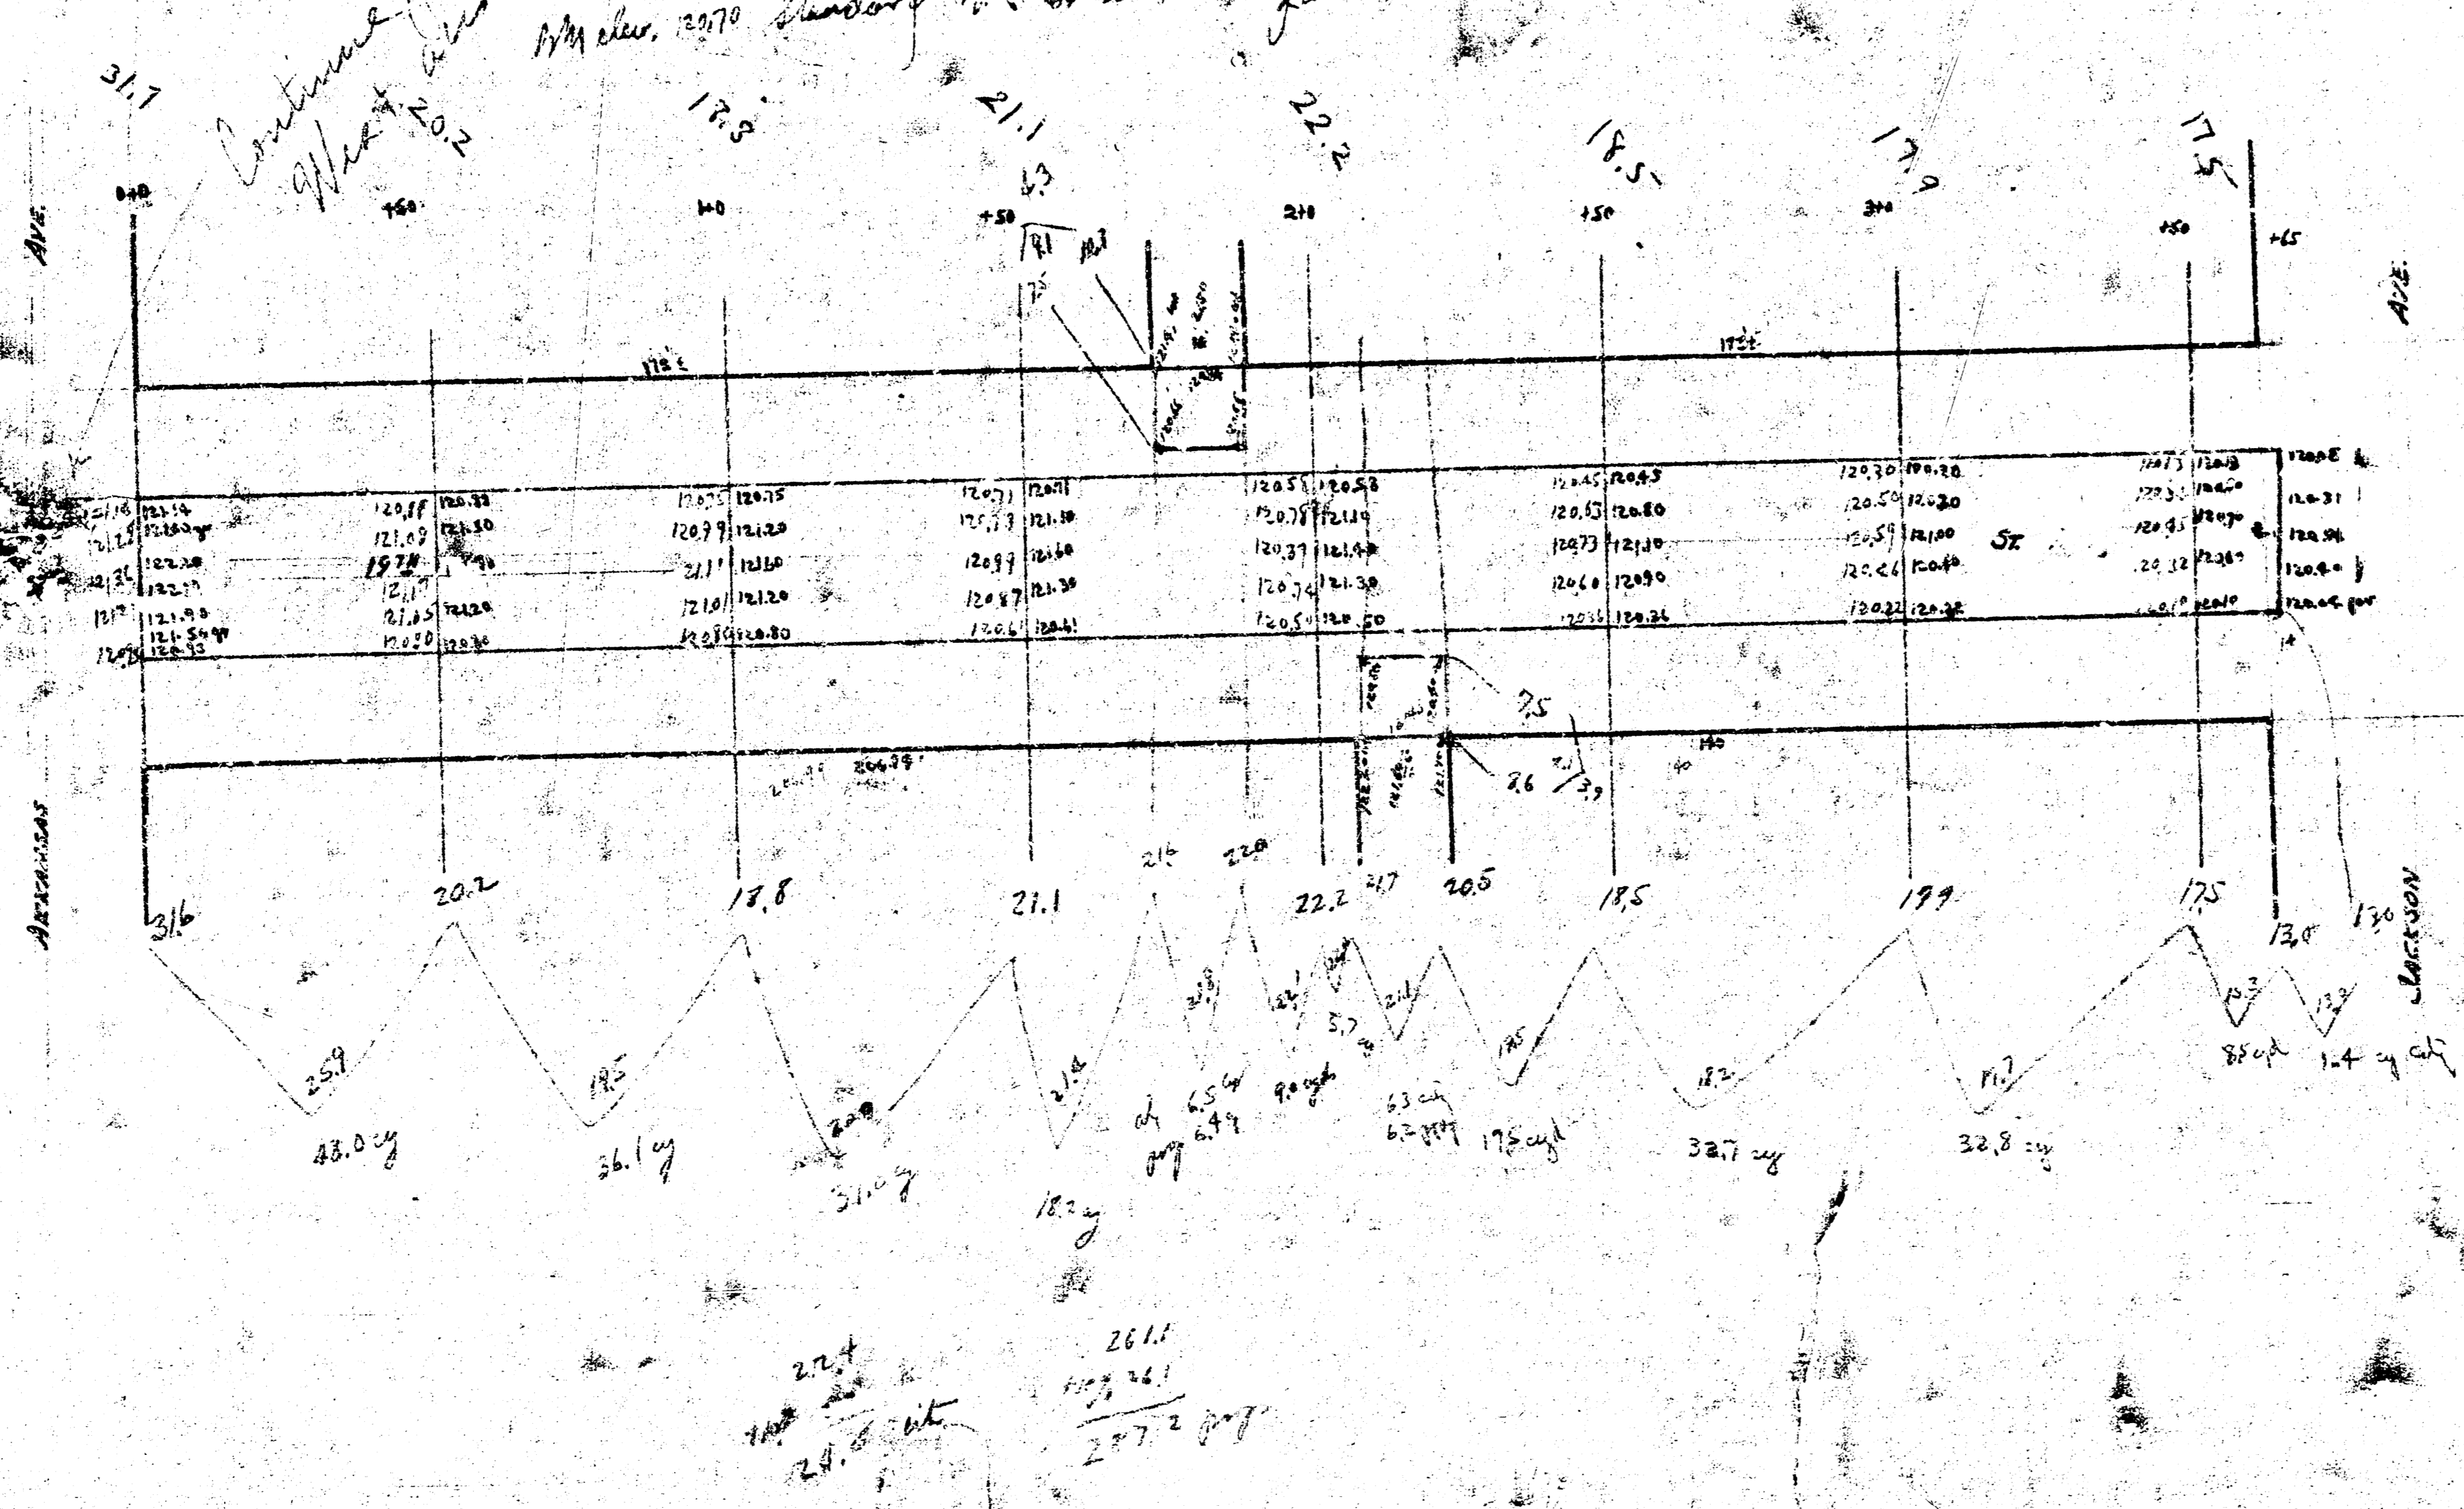

193 St.
 St. Arkansas
 St. Jackson