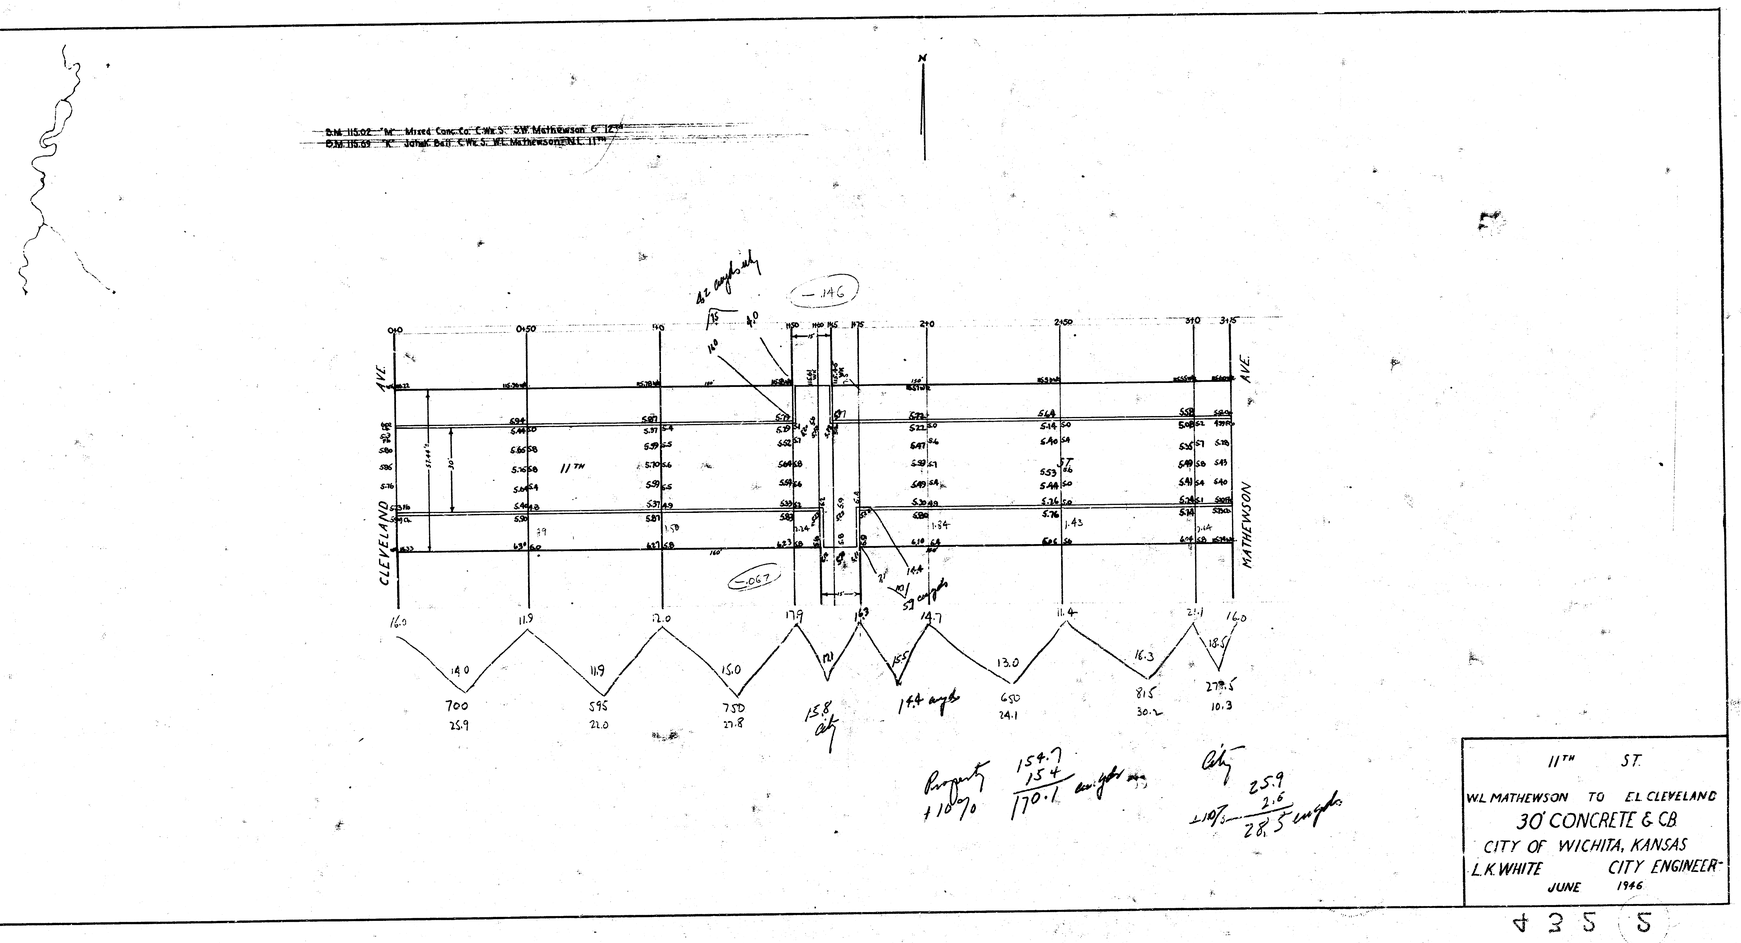

11TH ST.

W.L. MATHEWSON TO E.L. CLEVELAND

30' CONCRETE & CB

CITY OF WICHITA, KANSAS

L.K. WHITE CITY ENGINEER

JUNE 1946

4355