
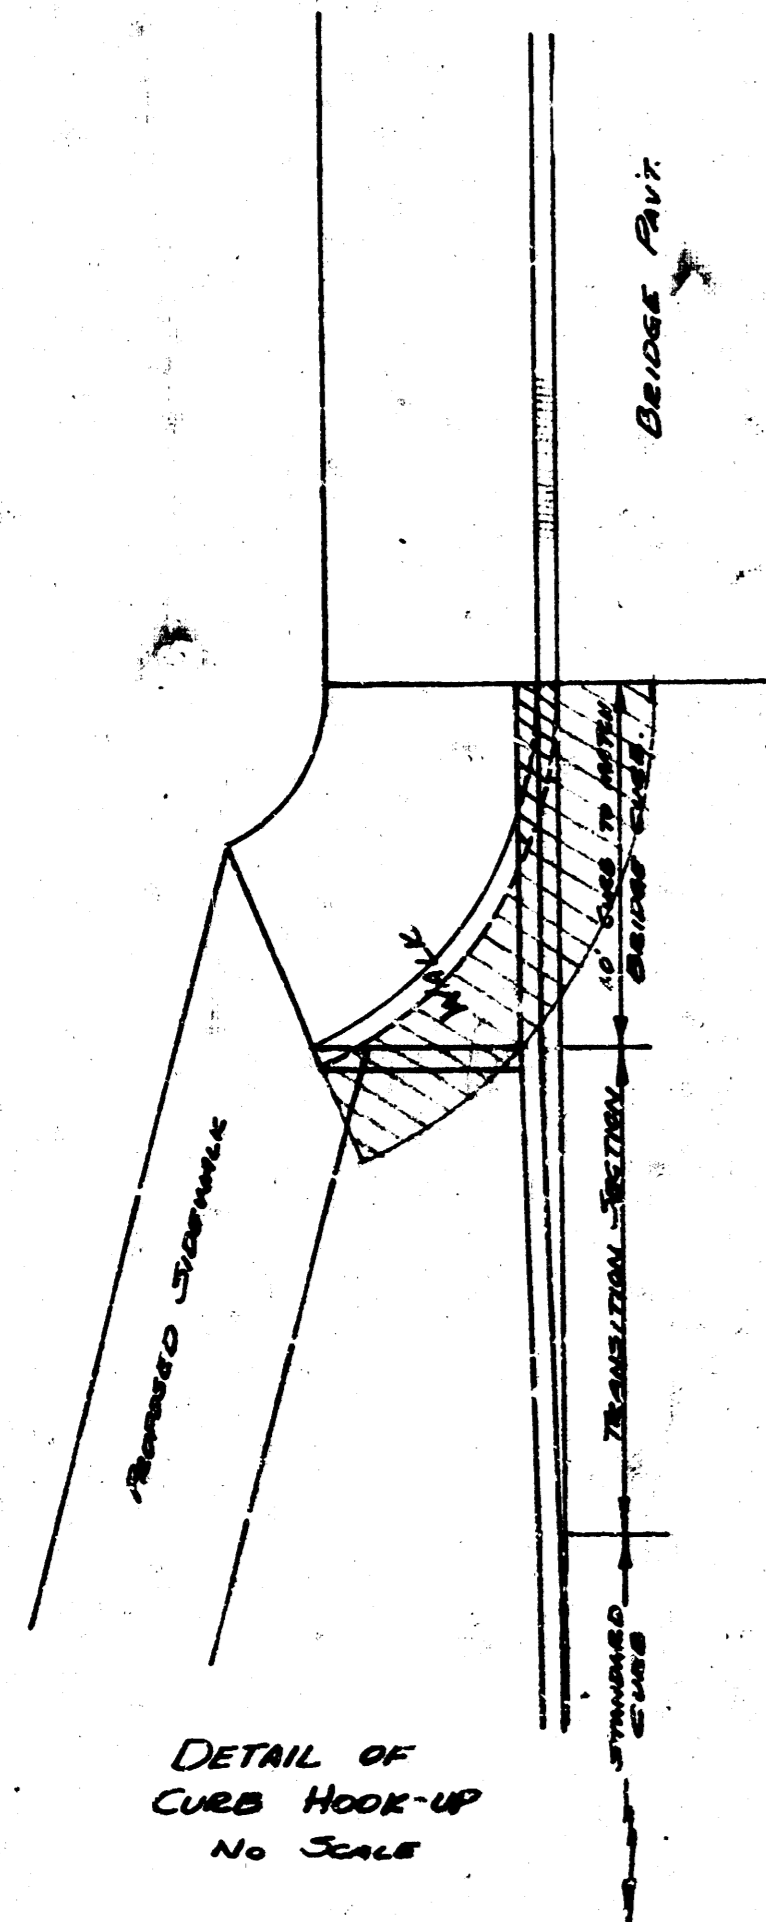


B.M. 124.85 TOP U.S.G.S. B.M. 50' SE OF S.E. COR. CONC. BRIDGE

CURVE DATA:

SEPARATE STATIONING ON EACH CURB.
ELEVATIONS ON CONST. JOINTS ARE SHOWN EVERY 50' STARTING AT 0+00

2 - 20' Drives
if not otherwise shown
assume 2' clearance
from top of curb
to top of drive
7/14/52

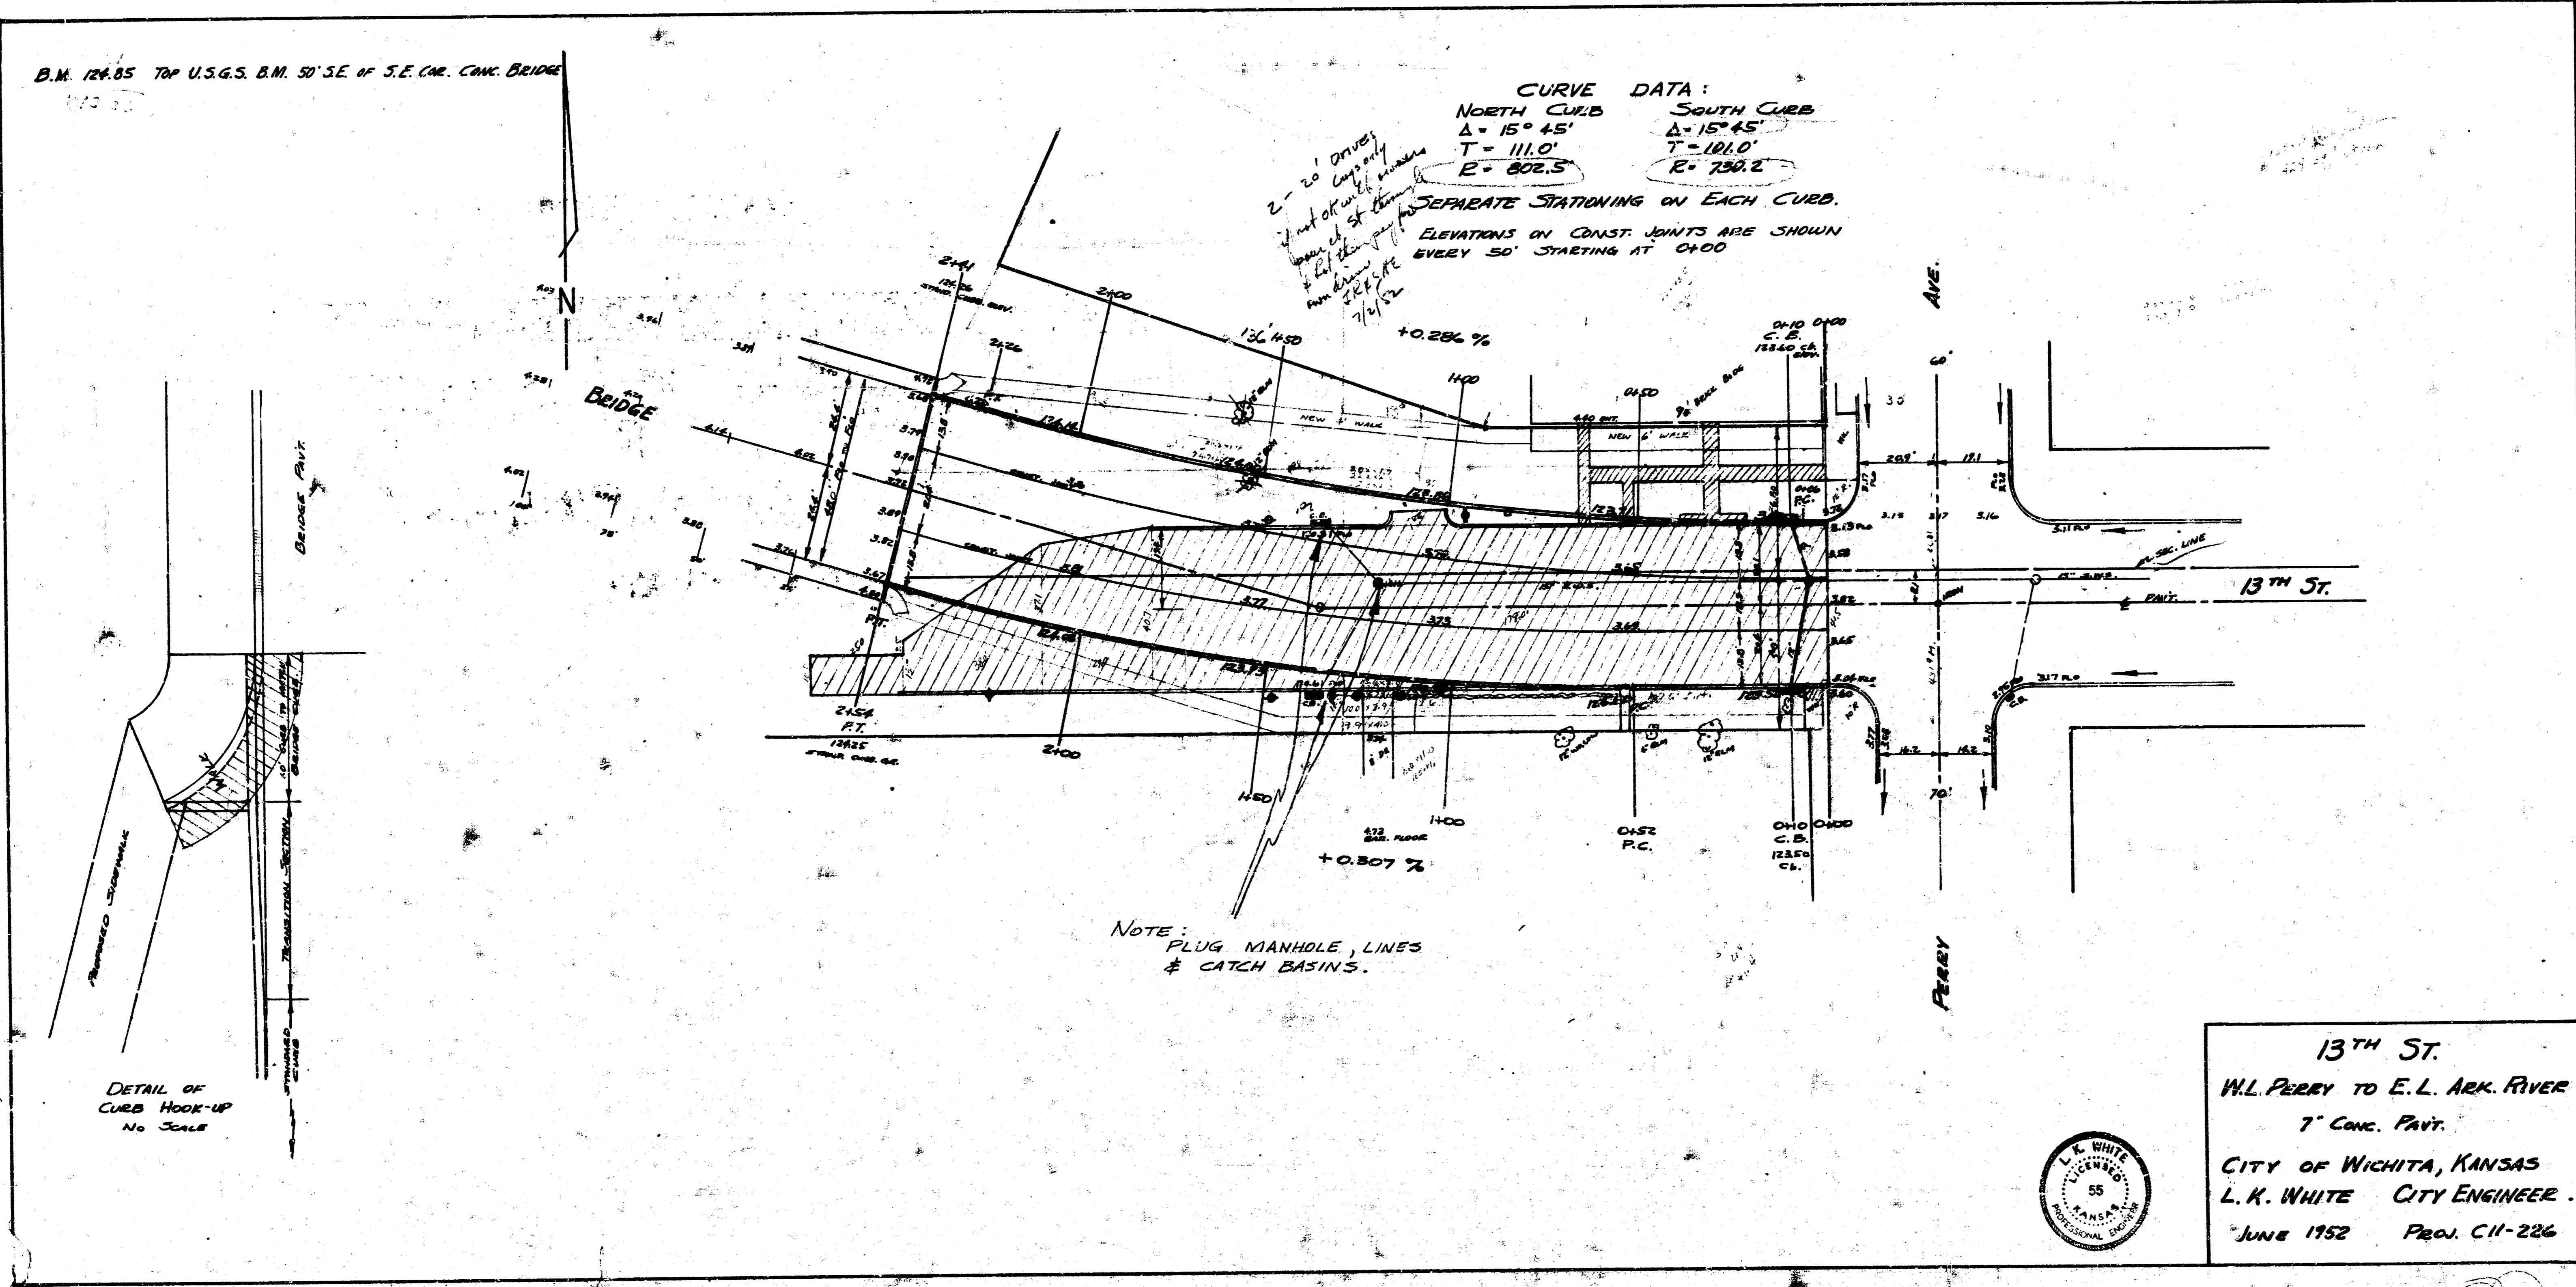

NOTE: PLUG MANHOLE, LINES & CATCH BASINS.

13TH ST.
W.L. PERRY TO E.L. ARK. RIVER
7" CONC. PAVT.
CITY OF WICHITA, KANSAS
L.K. WHITE CITY ENGINEER.
JUNE 1952 PROJ. C11-226

