


B.M. 11916 574, N.E. Cor. 17th & Arkansas
 B.M. 11934 Iron in Thumb 4 Jackson No. N.A. 16th

X

NOTE: REMOVE CROSS
 WALKS AT E. & W. SIDES
 OF INTERSECTION.

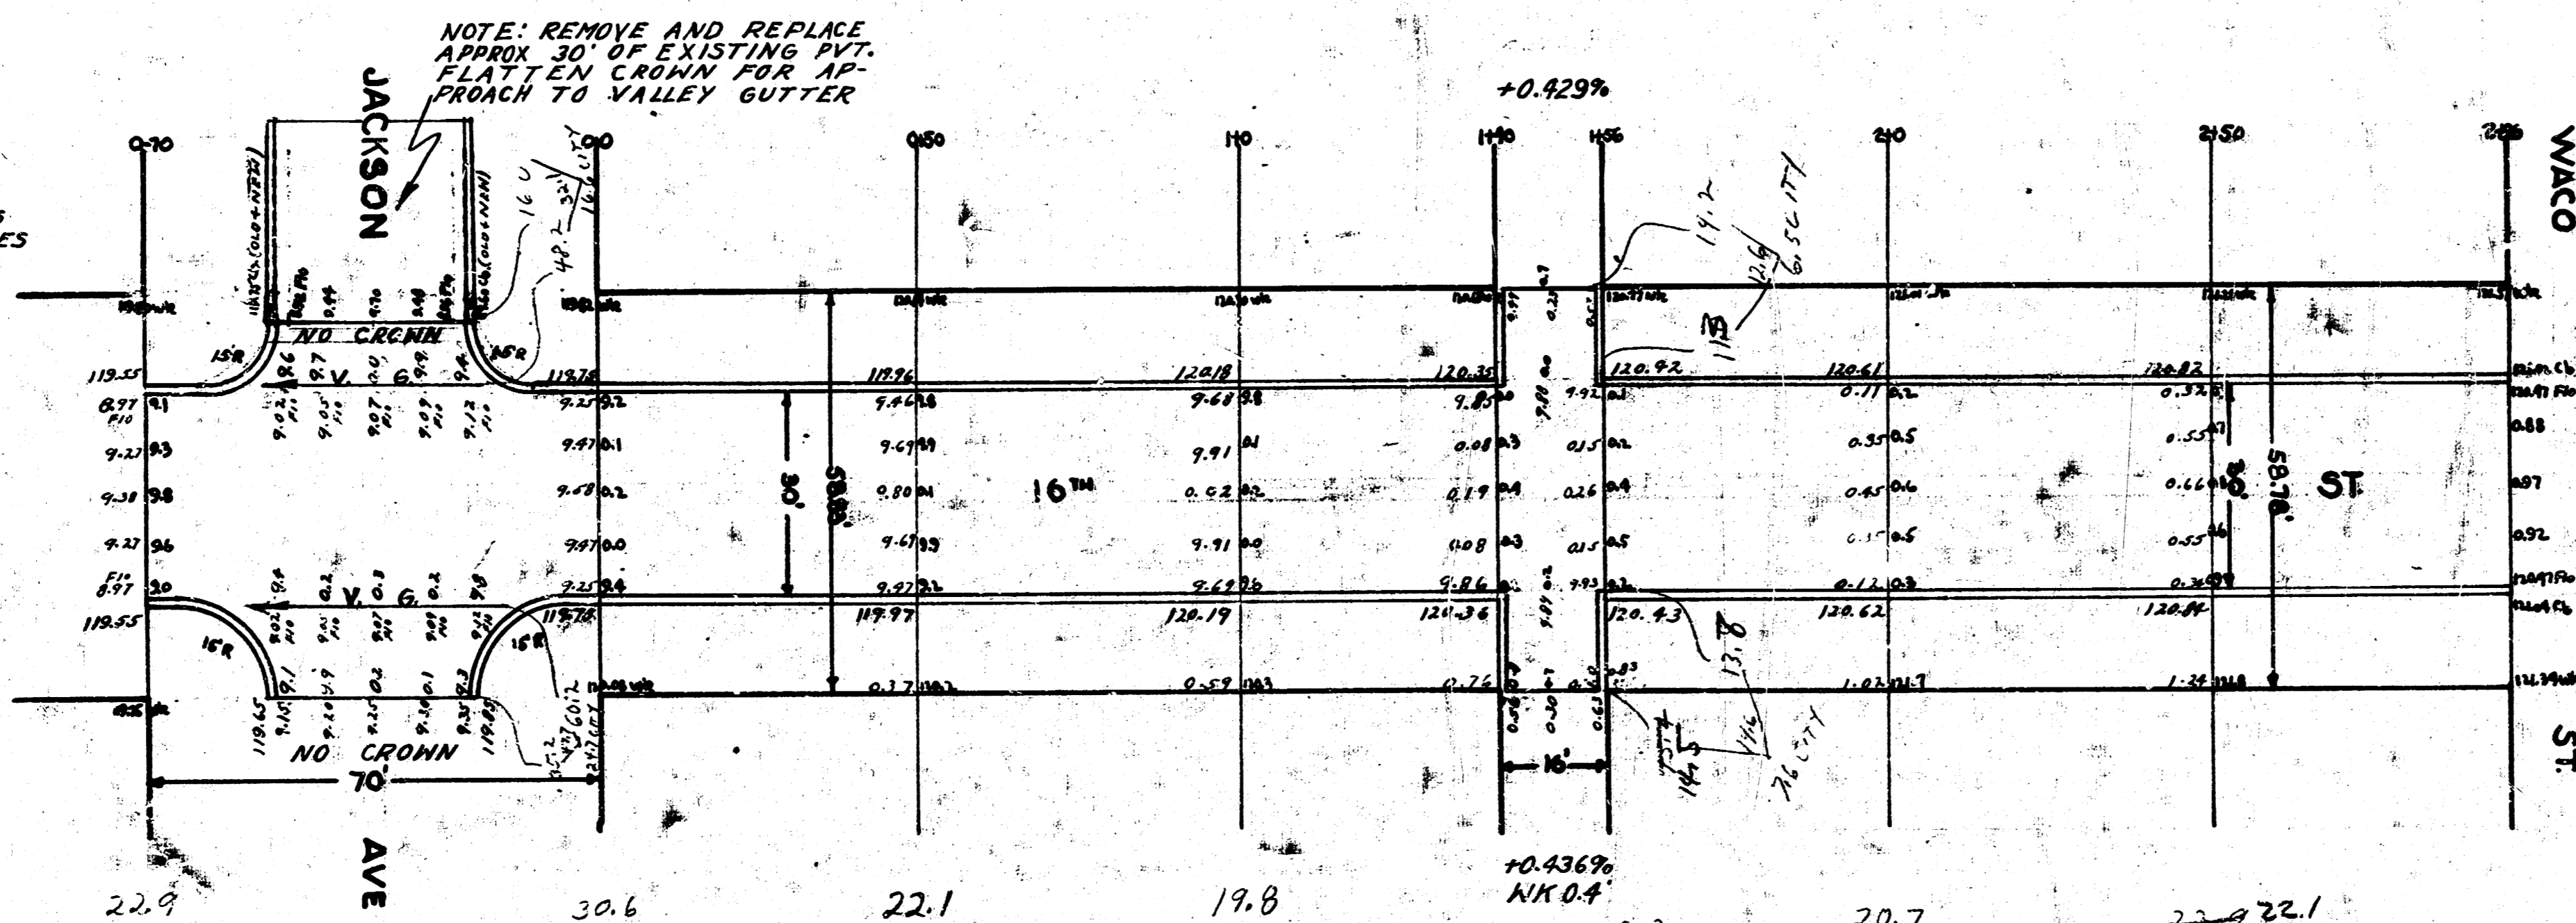

NOTE: REPLACE
 BROKEN CB & STR
 IN RETURN.

4472	235	258.9
4473	235	258.9
16th ST.
 W.L. WACO TO W.L. JACKSON
 30' CONCRETE & CB.
 CITY OF WICHITA, KANSAS
 L.K. WHITE CITY ENGINEER
 AUG. 1946