


B. M. 2633 N.E. COR. PORCH 2ND HOUSE N. OF 13TH W.S. SHADOWLAWN

0+54.6 & CONC. G.M. FLOOR N. 207.40

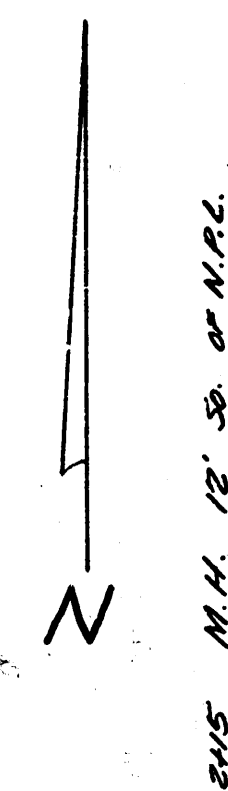


3+31.1 & CONC. G.M. FLOOR 207.42

