


1941
 14TH ST - E. L. WOODLAND W/L JEANNETTE
 26' conc - int cb

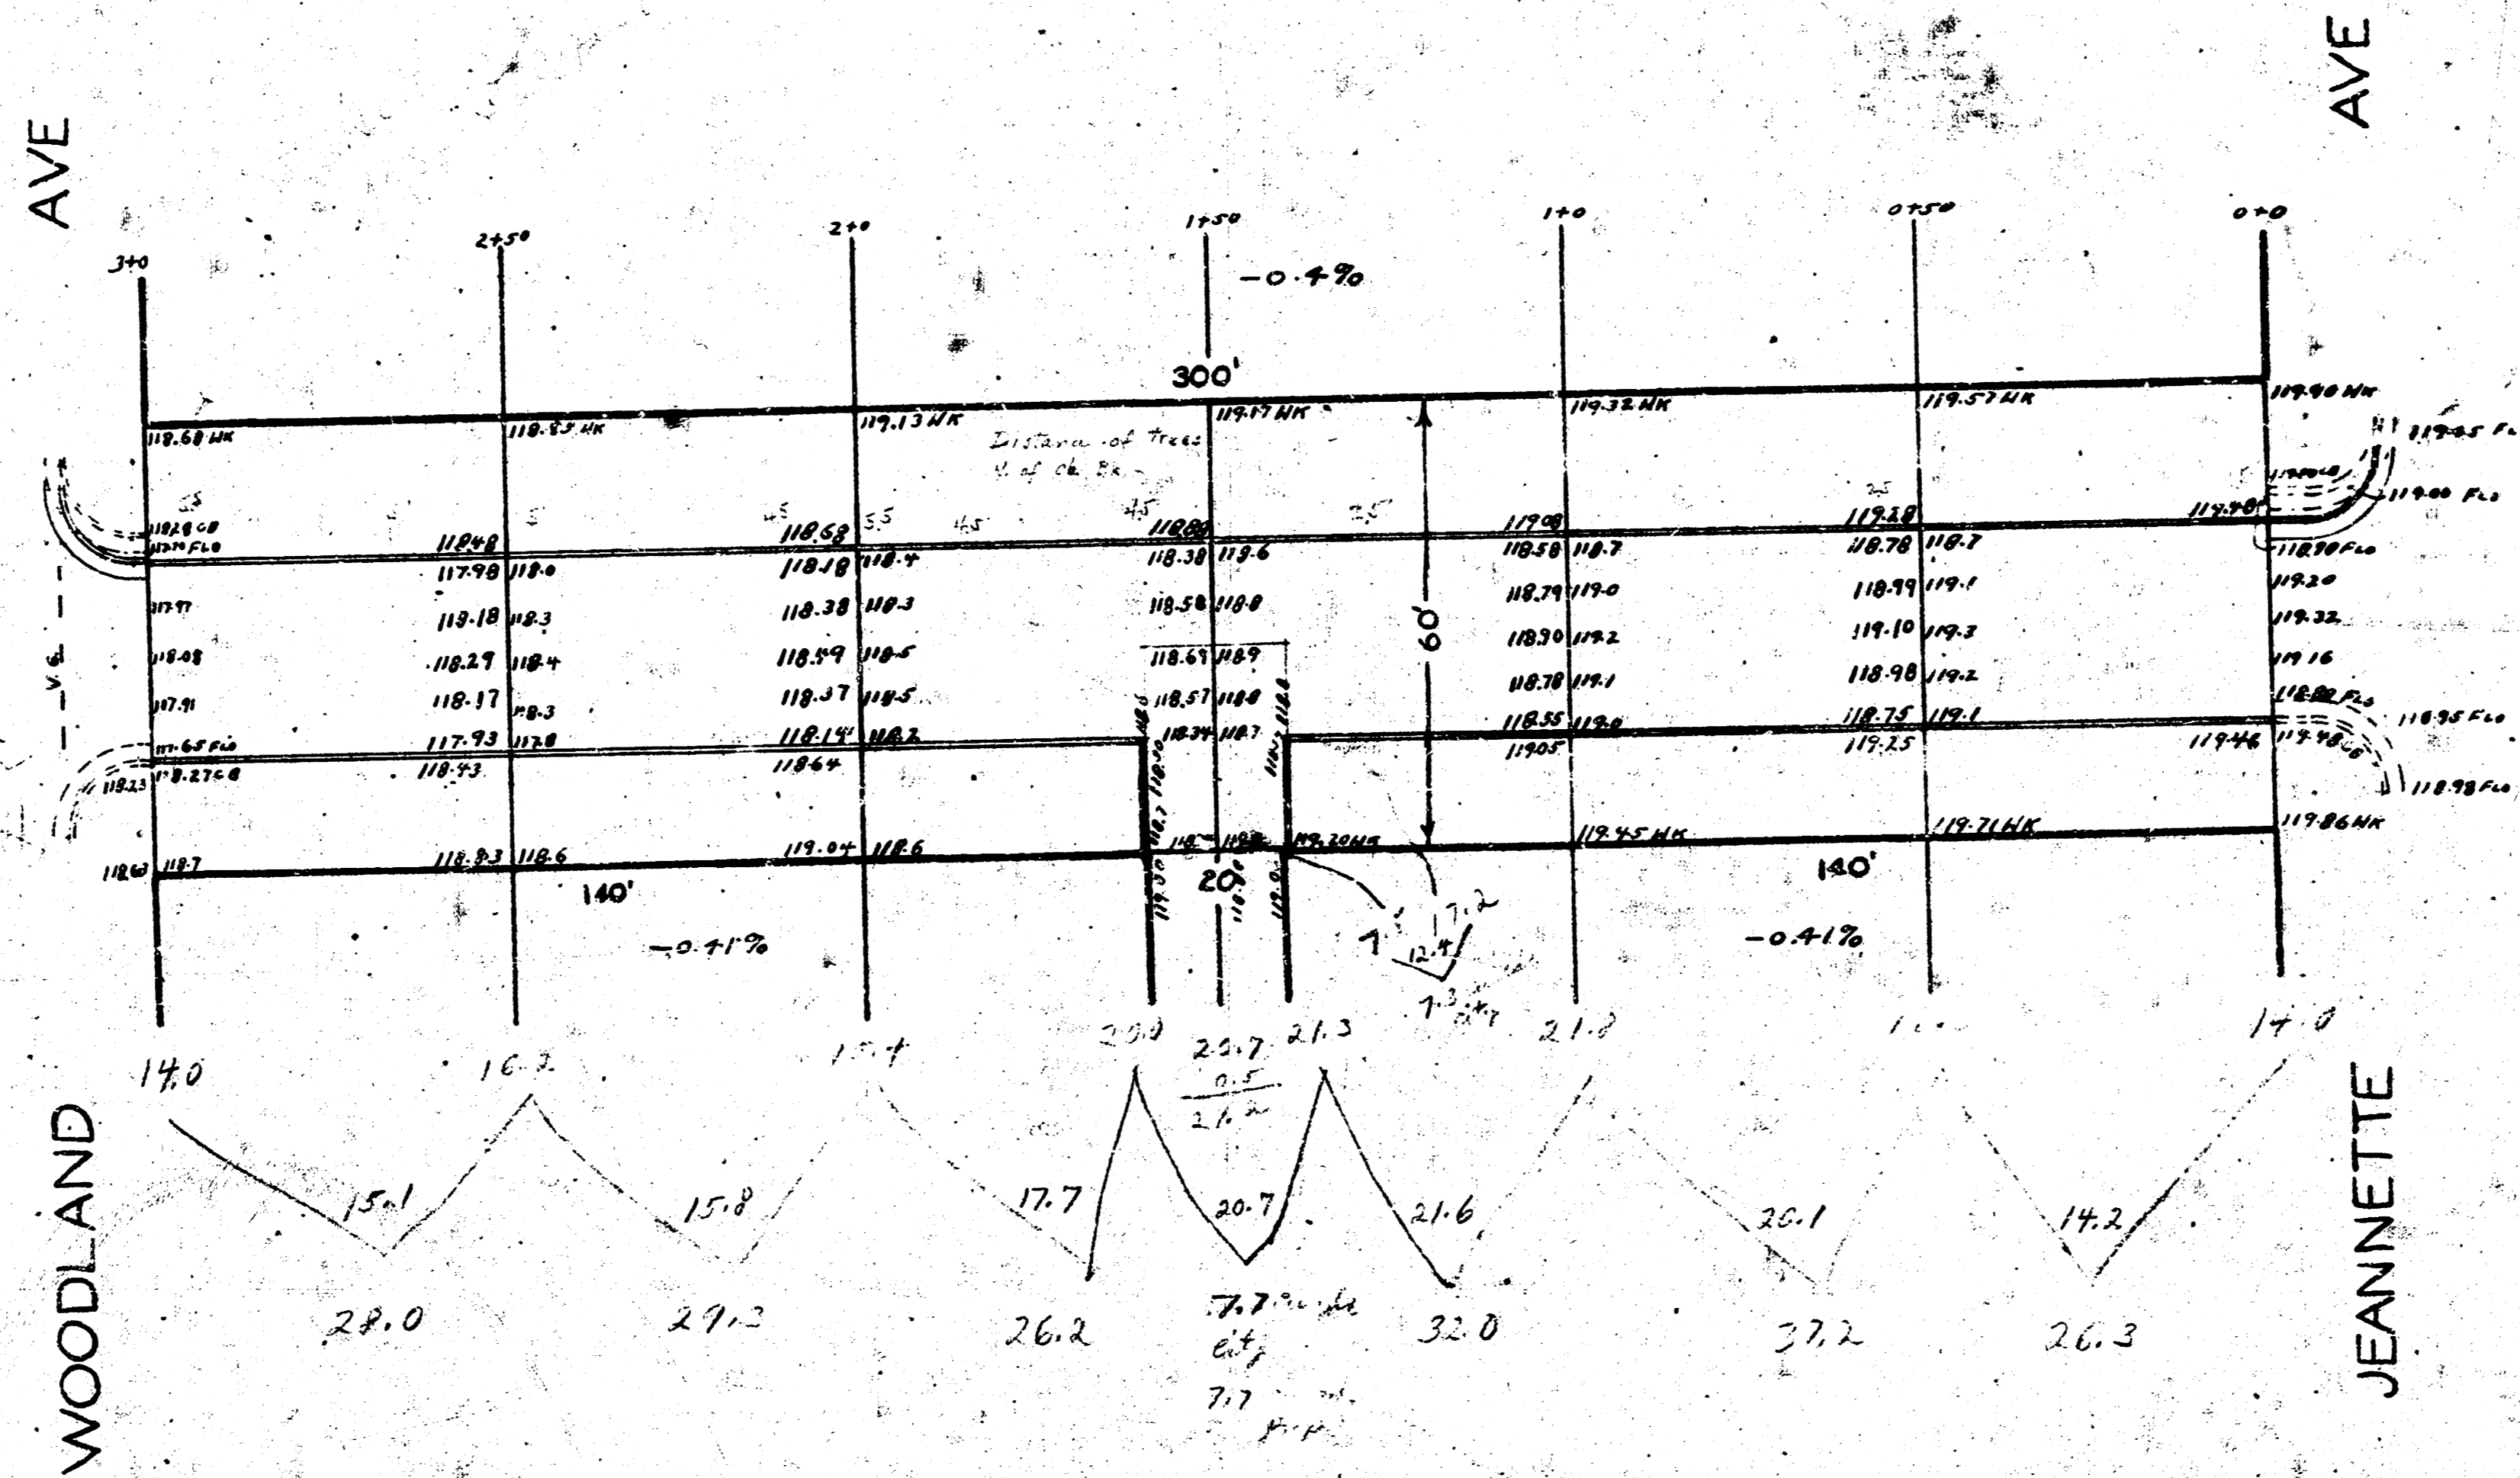

BM 113.83 B in Blane ctr. W/S. S.W. cor 14th + Jeannette

29.8	7.7
29.3	7.3
26.2	
32.0	15.0
27.2	1170 11.5
26.3	
7.7	16.5
186.7	
181.7	
205.4	

205.4
 16.5
 Sub Total → 221.9