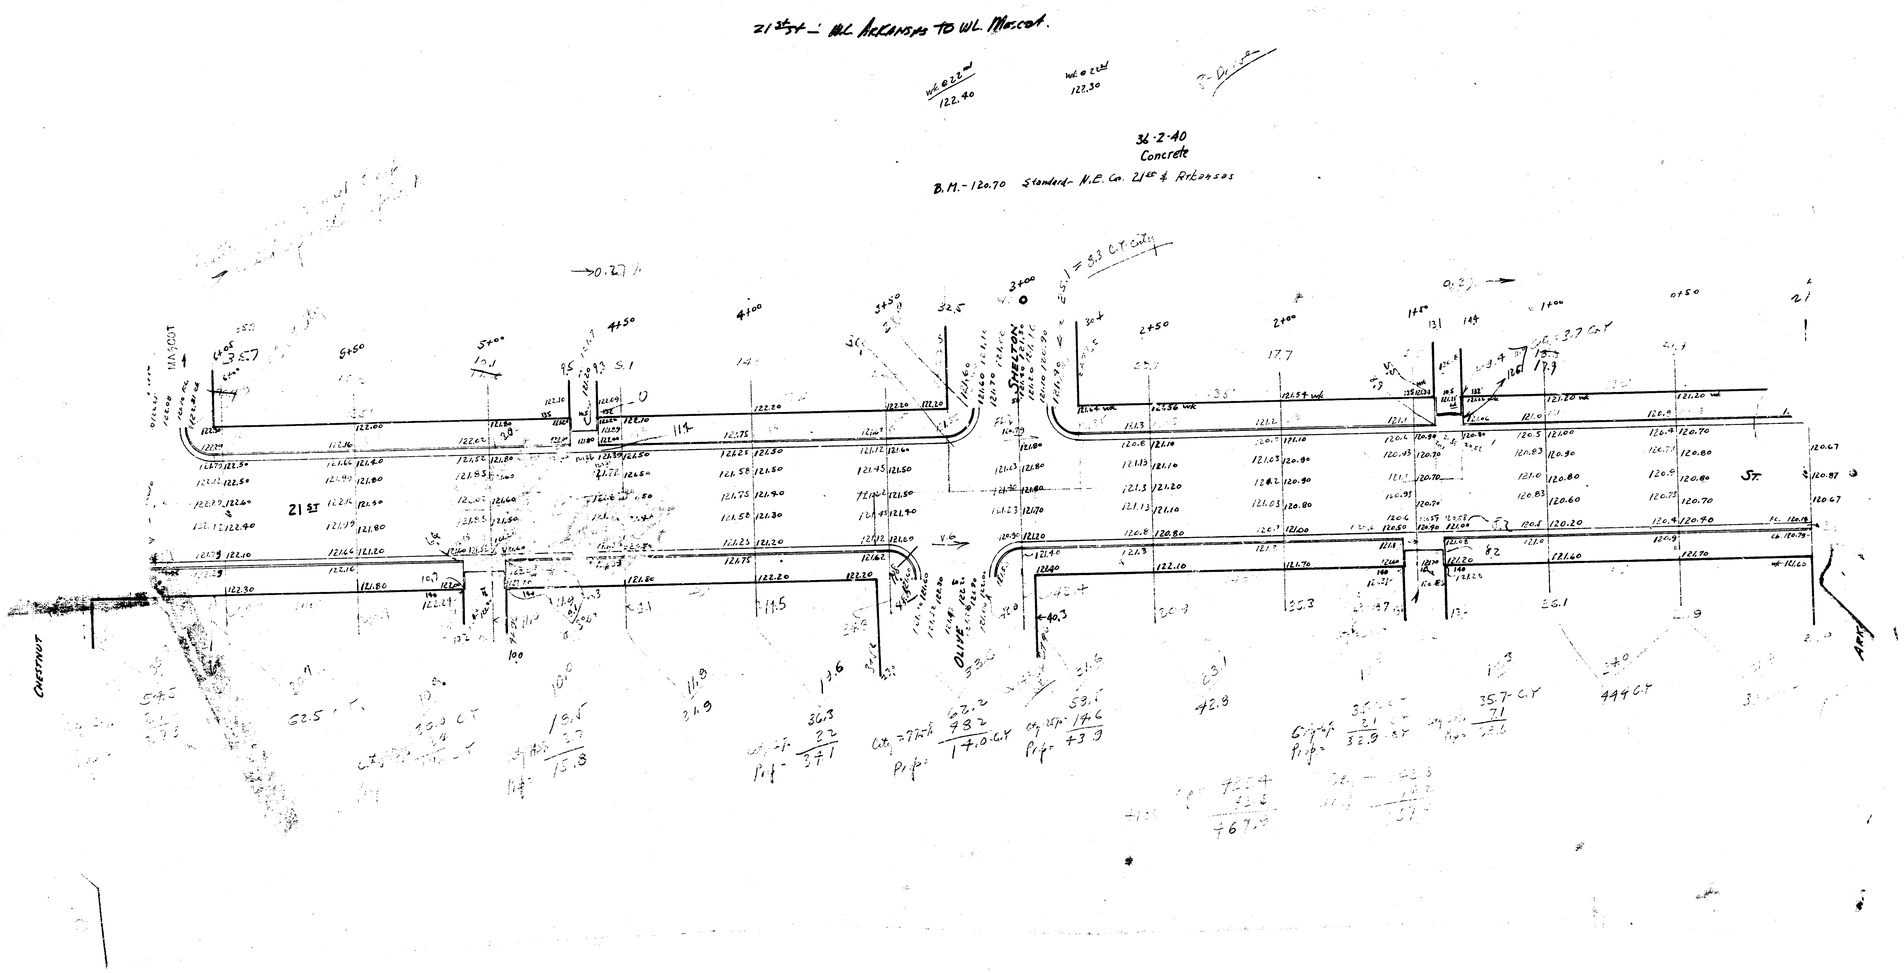21st St. – W.L. Arkansas to W.L. Mascot.