


Survey
 1/2" = 100'
 1/4" = 200'
 1/8" = 400'

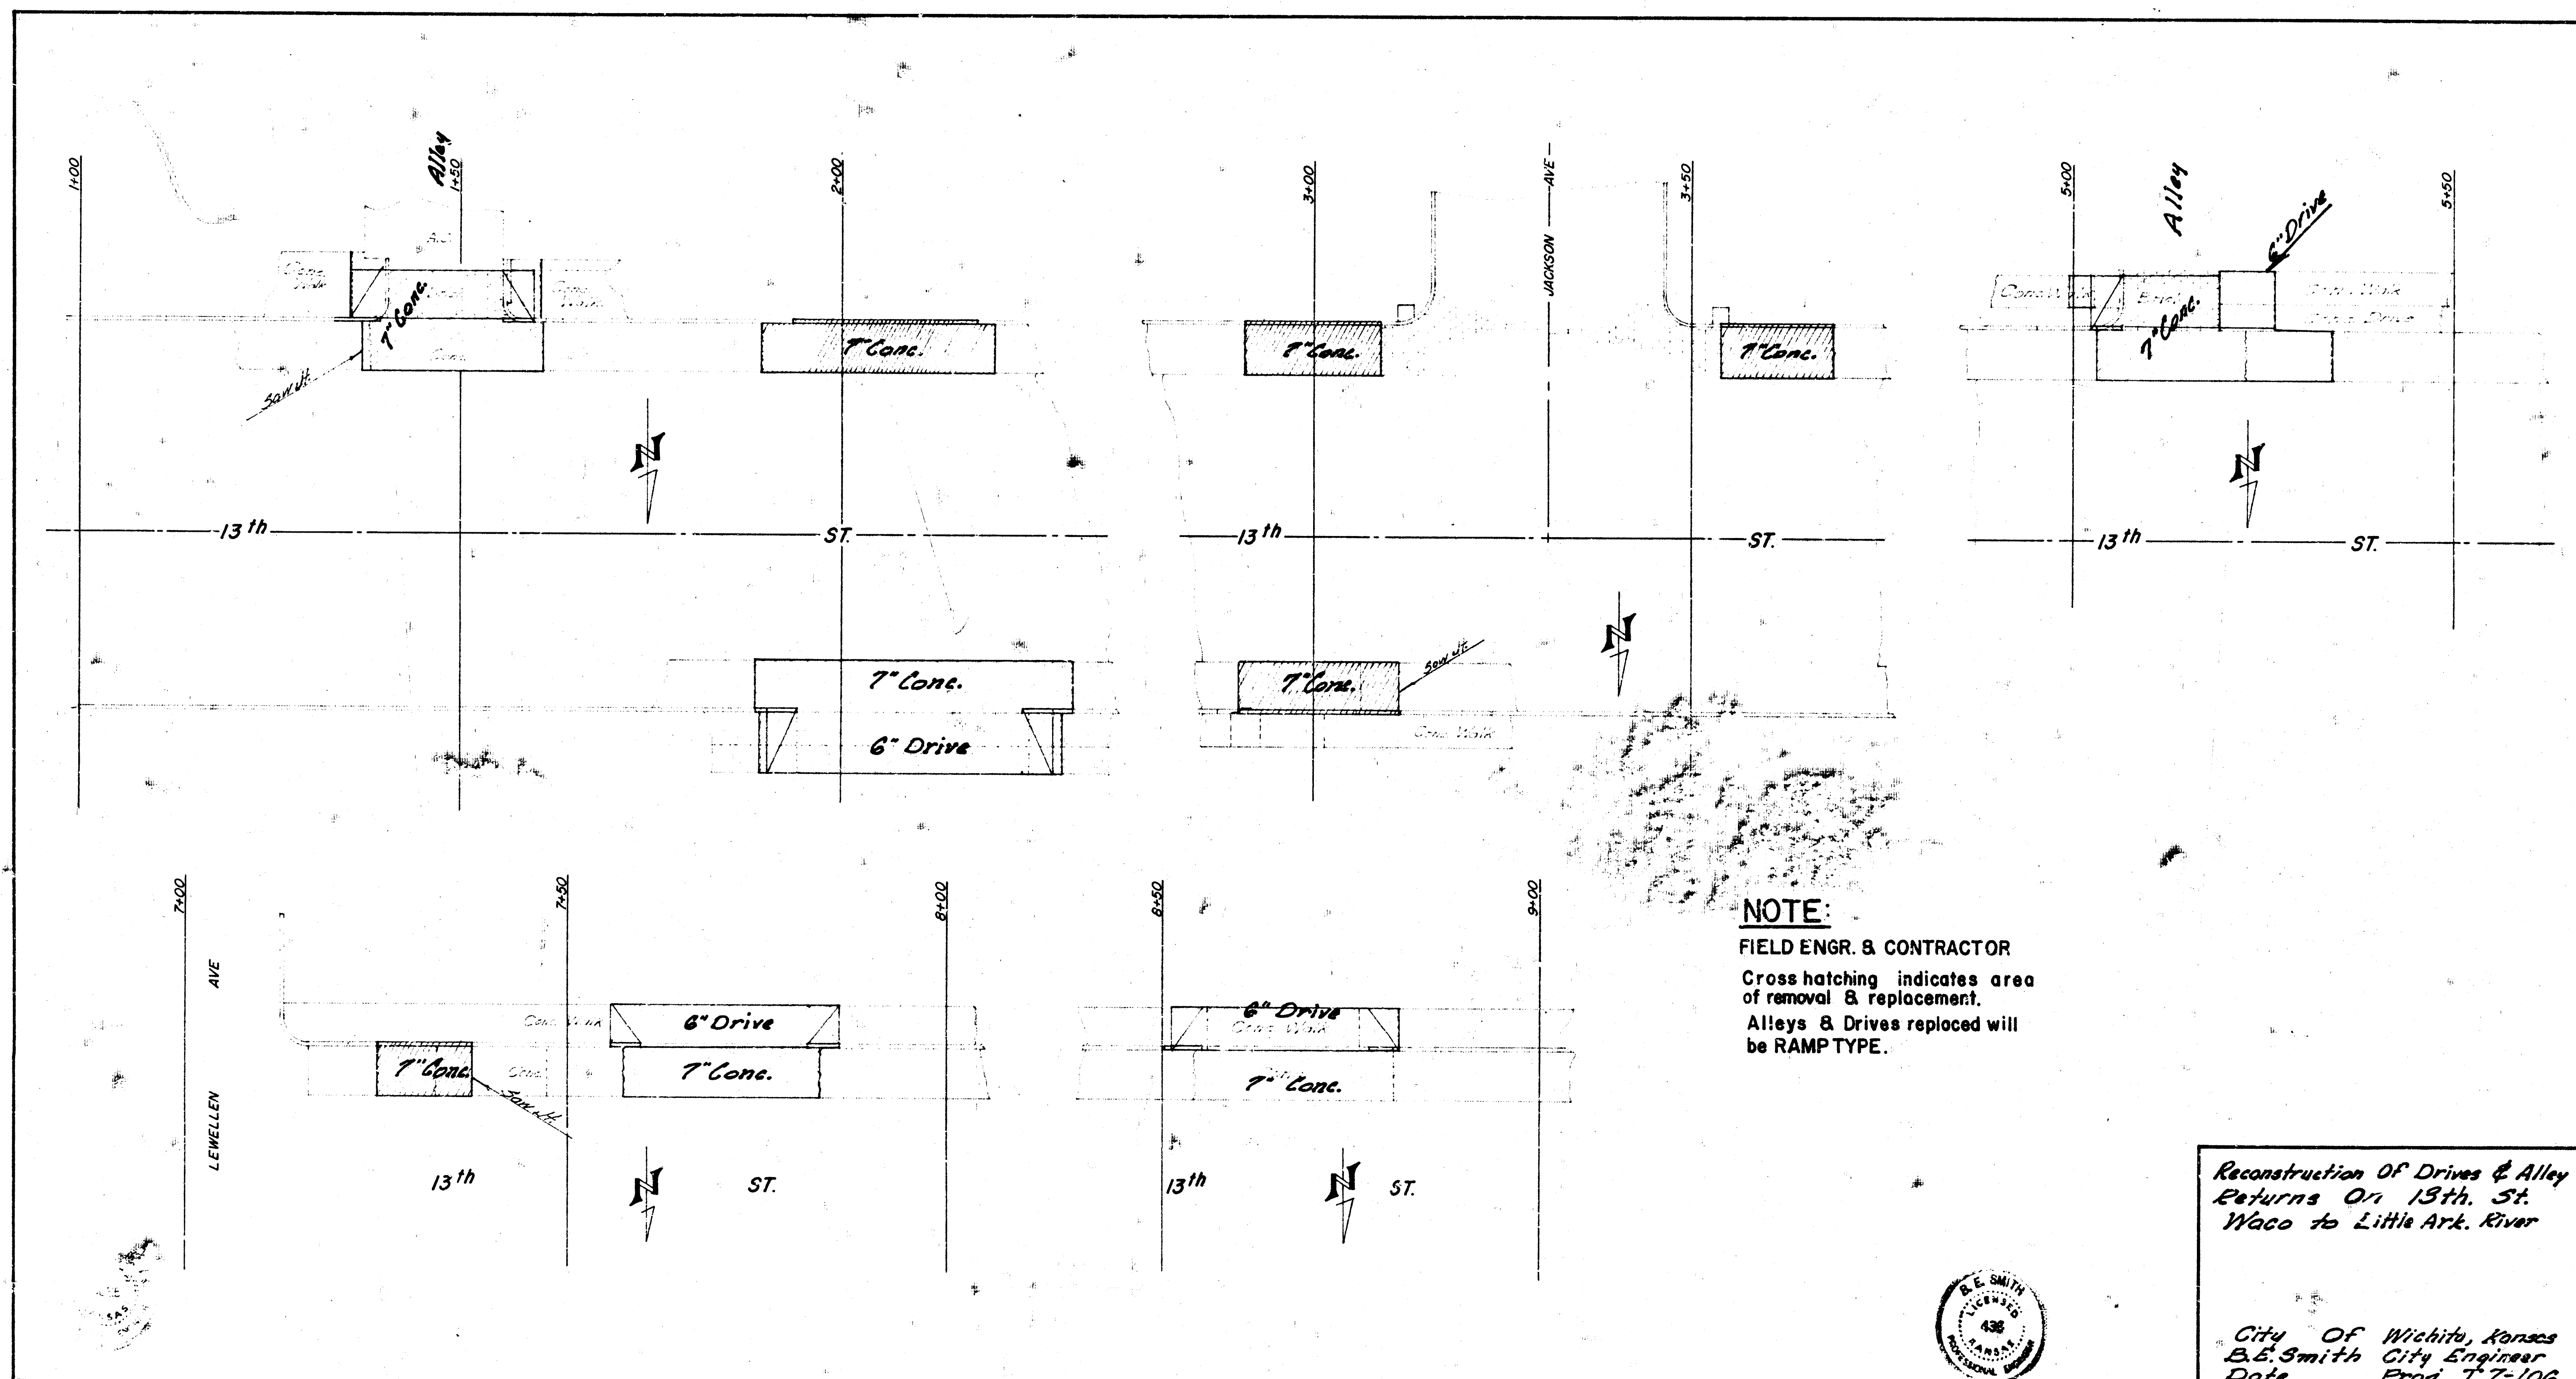


NOTE:
 FIELD ENGR. & CONTRACTOR
 Cross hatching indicates area
 of removal & replacement.
 Alleys & Drives replaced will
 be RAMPTYPE.

Reconstruction Of Drives & Alley
 Returns On 13th St.
 Waco to Little Ark. River

City Of Wichita, Kansas
 B.E. Smith City Engineer
 Date Proj. 7-7-06



Survey J.A. BURNS
Plan 27600
Checked

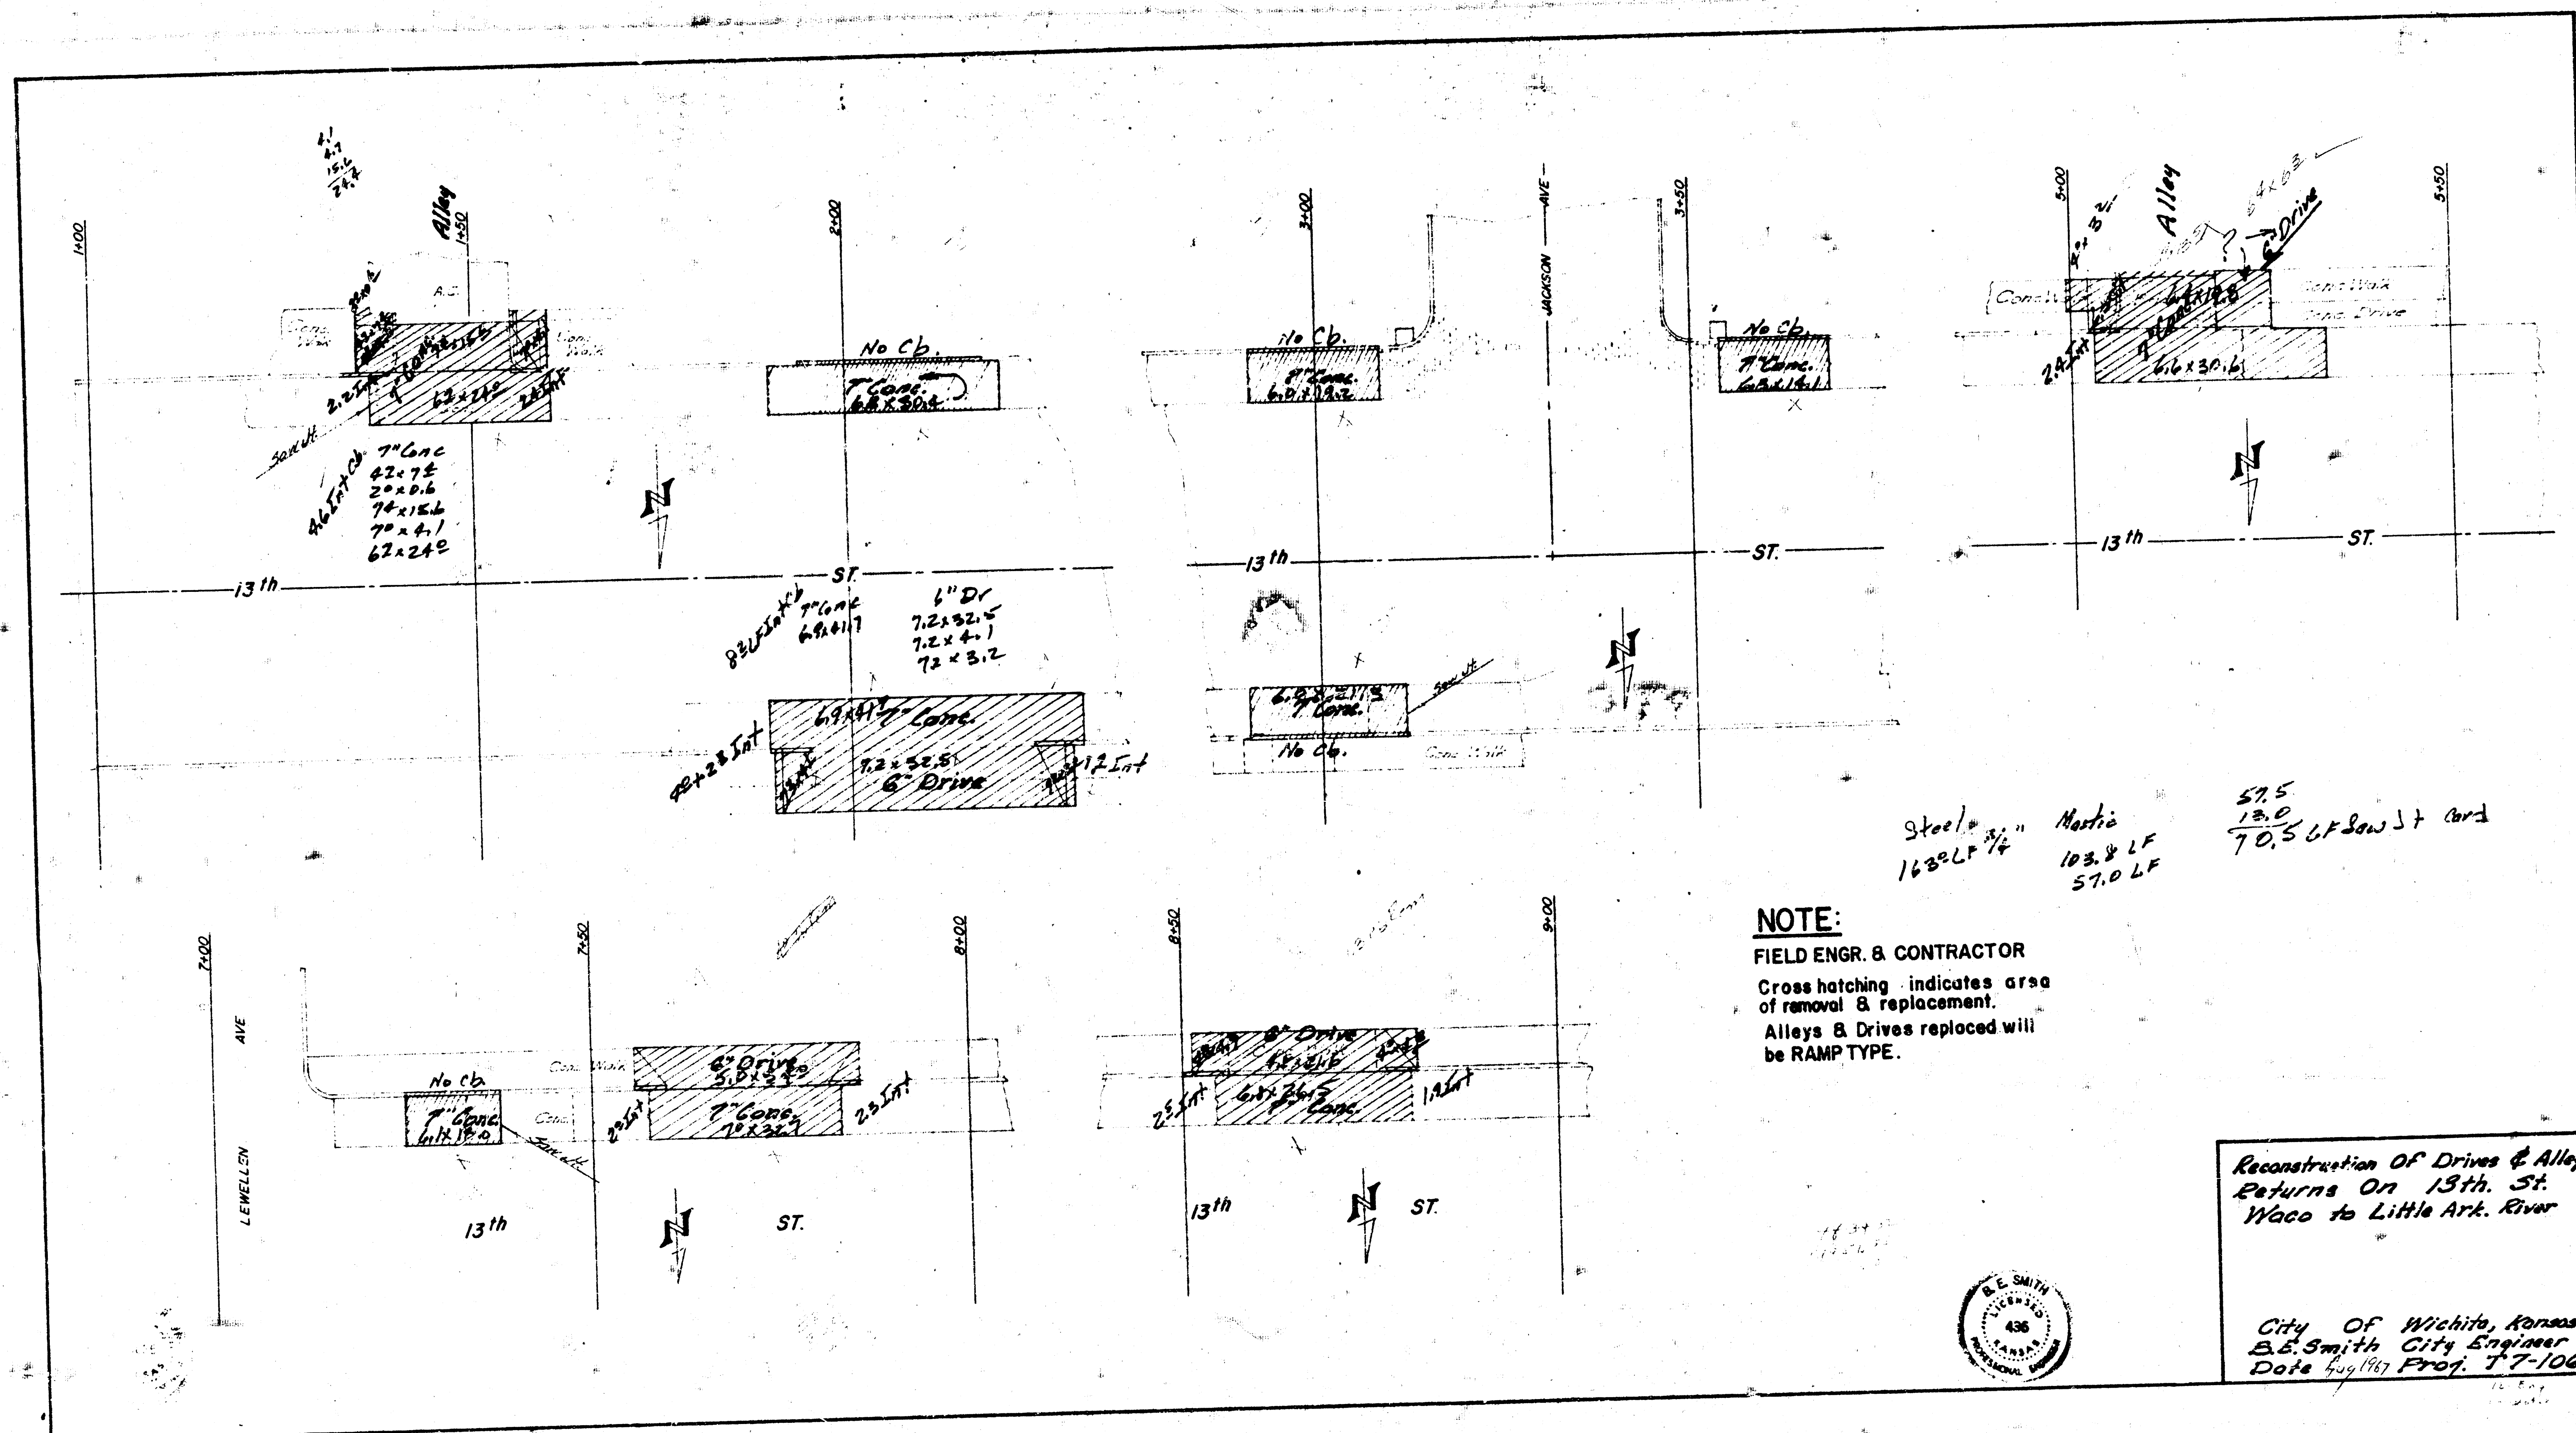

NOTE:

FIELD ENGR. & CONTRACTOR
Cross hatching indicates area
of removal & replacement.
Alleys & Drives replaced will
be RAMP TYPE.

Steel 1/4" 1630 LF
57.5 LF
12.0 LF
70.5 LF Saw St Card



Reconstruction Of Drives & Alley
Returns On 13th St.
Waco to Little Ark. River

City Of Wichita, Kansas
B.S. Smith City Engineer
