



13th St.
LITTLE ARK RIVER to W.L. WACO
PROJ. NO. DAKM 572009
CITY OF WICHITA, KANSAS
R. W. LINN, CITY ENGINEER

SAWED CONTRACTION JOINTS ARE TO BE CONSTRUCTED AT 30' 0" INTERVALS EXCEPT WHERE AN EXPANSION JOINT IS USED.

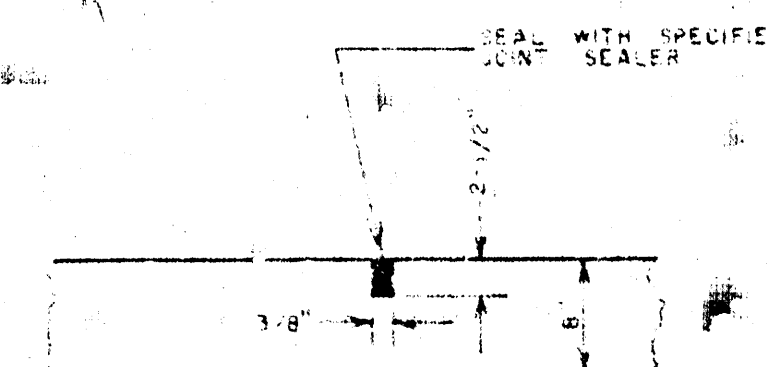


DETAIL OF SAWED CONTRACTION AND LONGITUDINAL JOINTS

EXPANSION JOINTS ARE TO BE CONSTRUCTED AT MAXIMUM INTERVALS OF 120' 0".




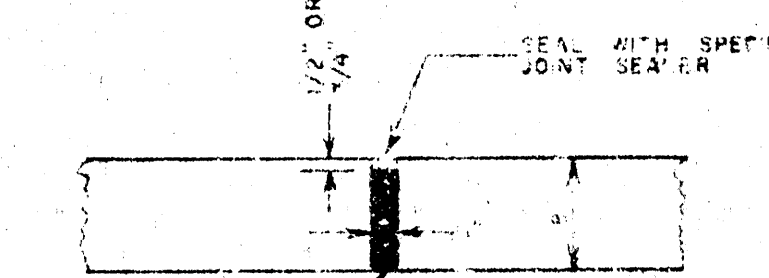


DETAIL OF EXPANSION JOINT

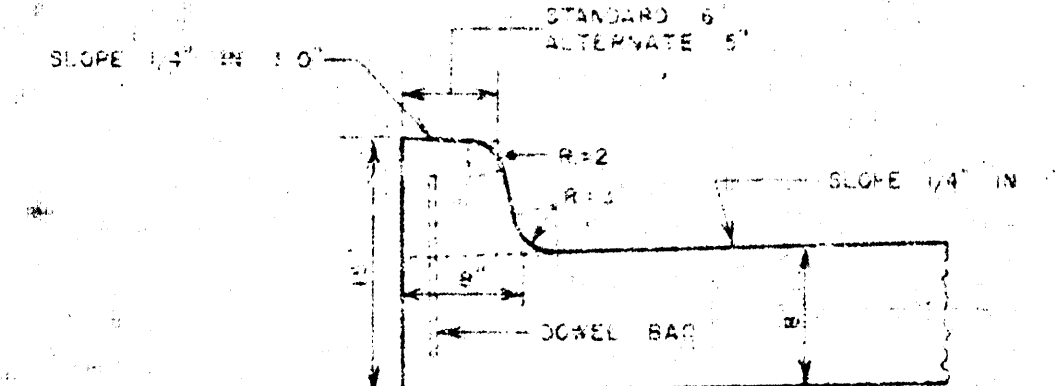

DETAIL OF INTEGRAL CURB

INTEGRAL CURB SHALL BE CUT THROUGH TO THE PAVEMENT IN UNIFORM LENGTHS OF NOT MORE THAN TEN FEET INTERVALS BETWEEN EXPANSION JOINTS HAVING THE SAME THICKNESS AS THE EXPANSION JOINTS IN THE PAVEMENT SHALL BE CONSTRUCTED IN THE INTEGRAL CURB AT THE SPECIFIED LOCATIONS. NUMBER 4 OR NUMBER 6 COWELS SHALL BE INSTALLED IN THE INTEGRAL CURB AS SHOWN ON APPROXIMATELY 2' 6" CENTERS. PAVEMENT GRADES SHOWN ON PLANS ARE FOR STANDARD CROWN.

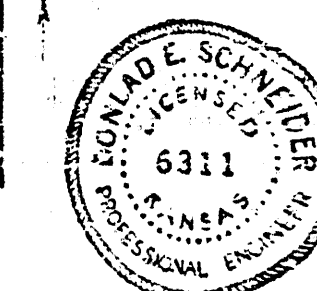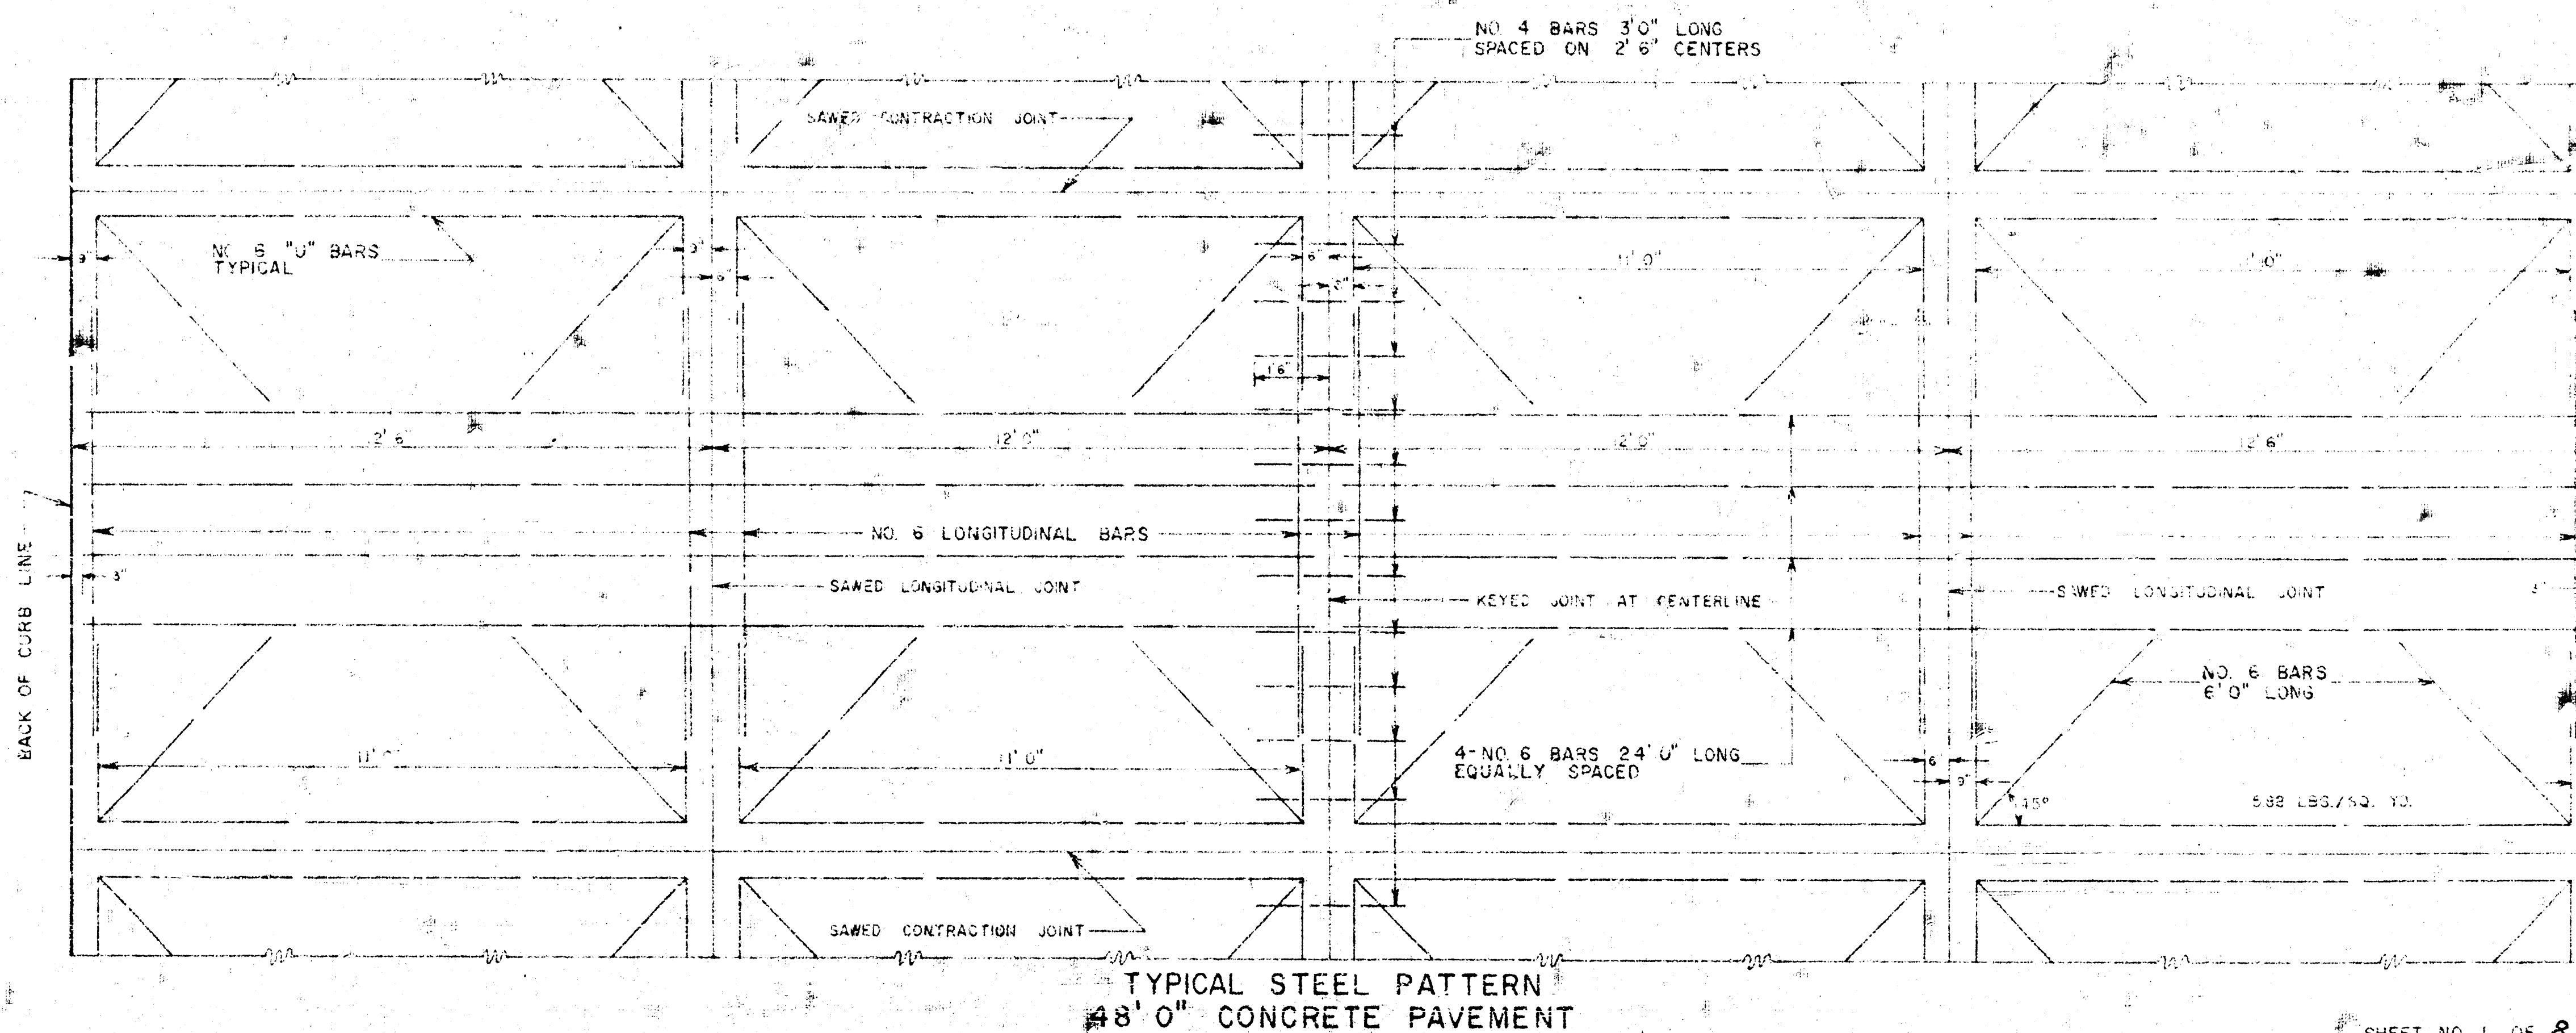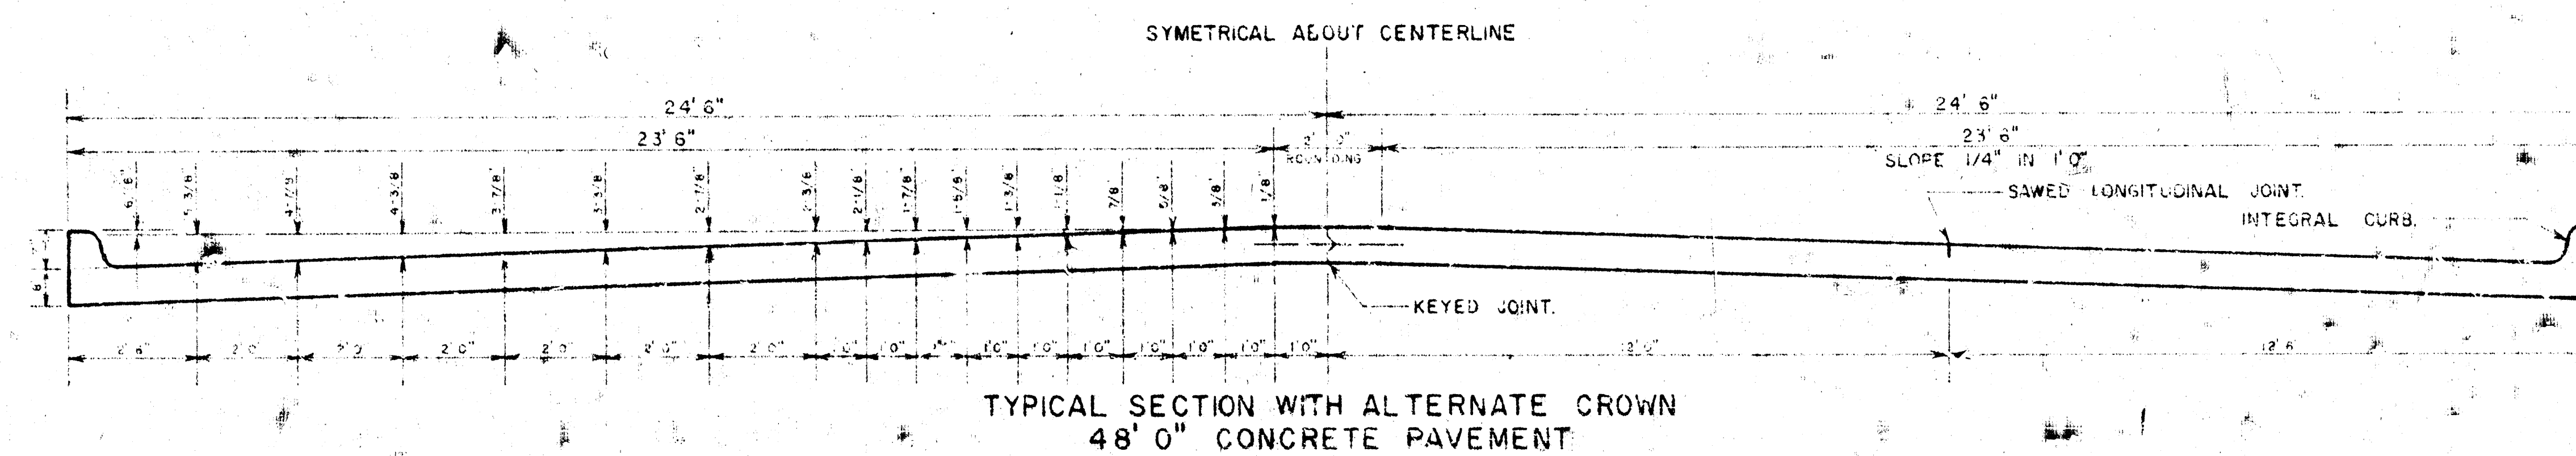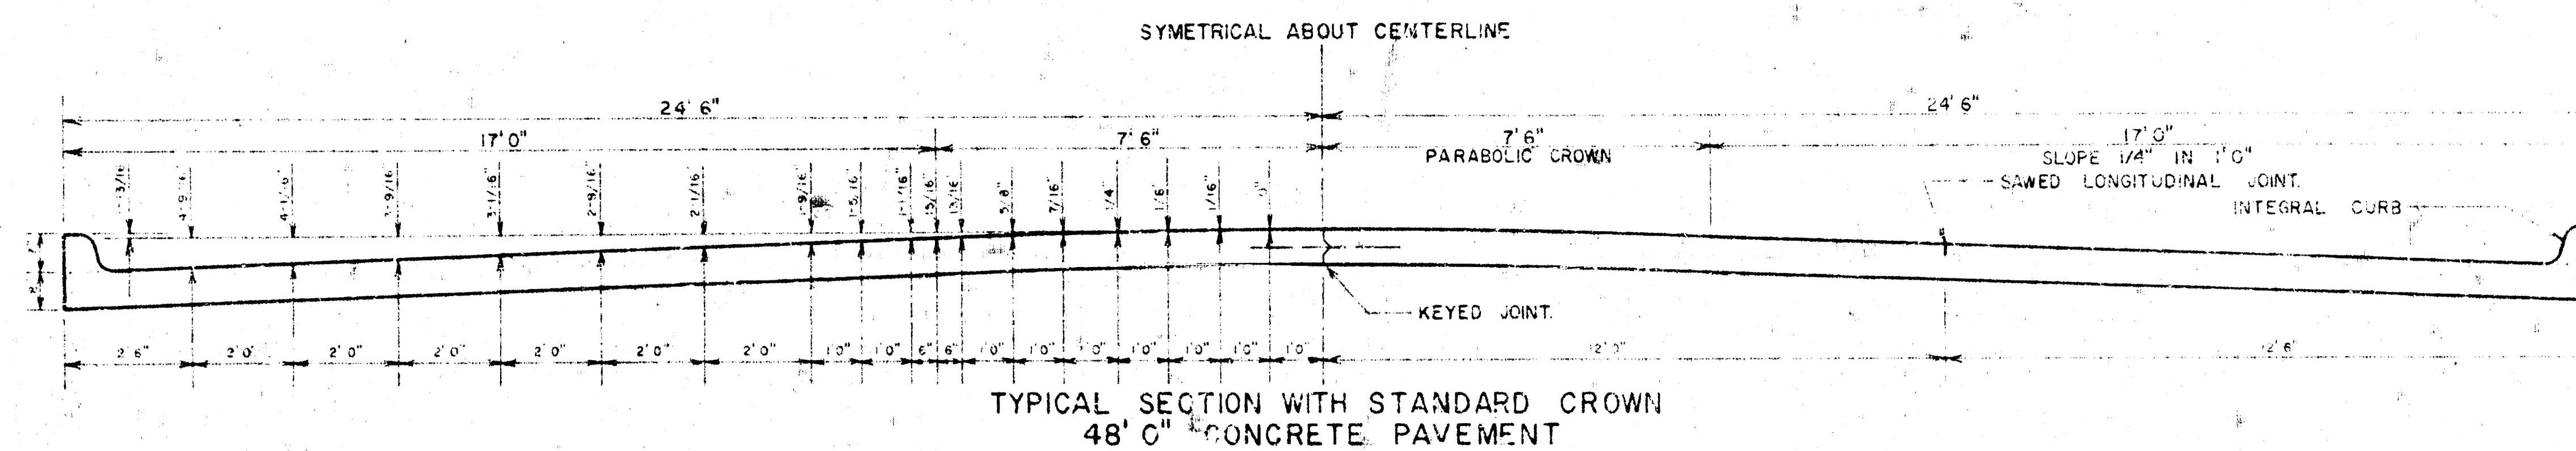

Survey: Dulles
 Station: Lacey
 Date: 10-1-72

B.M. 116.20 Brass Rod in concrete post
 37'E. and 23'S. of 13th and Broadway
 Thumbe #1, Sta. 4+00, on Section line
 Thumbe #2, Sta. 4+57, 29' S. of Section line
 Thumbe #3, Sta. 4+57, 24'S. of Thumbe #2

B.M. 124.07 NE. corner, base of signal control
 box at R.R. S. of 13th and W. of Market
 B.M. 124.07 City of Wichita bench mark, disc
 at end of N.E. wingwall of bridge.


Note: All kind and pipe removal will
 be done by drainage contractor.


Note: Engineer and contractor
 need to determine location of two
 drives for North High by contacting
 Board of Education.

Note: The adjustment of manholes shall be considered
 incidental to the bid price per sq. yd. of pavement.
 The field engineer shall determine where new
 manhole frames and covers are needed. New
 manhole frames and covers shall be paid by force account.

Note: Field engineer to re-cross-section areas
 where storm sewer contractor stored excavated
 material over new storm sewer trench.

N
 Scale 1"=20'



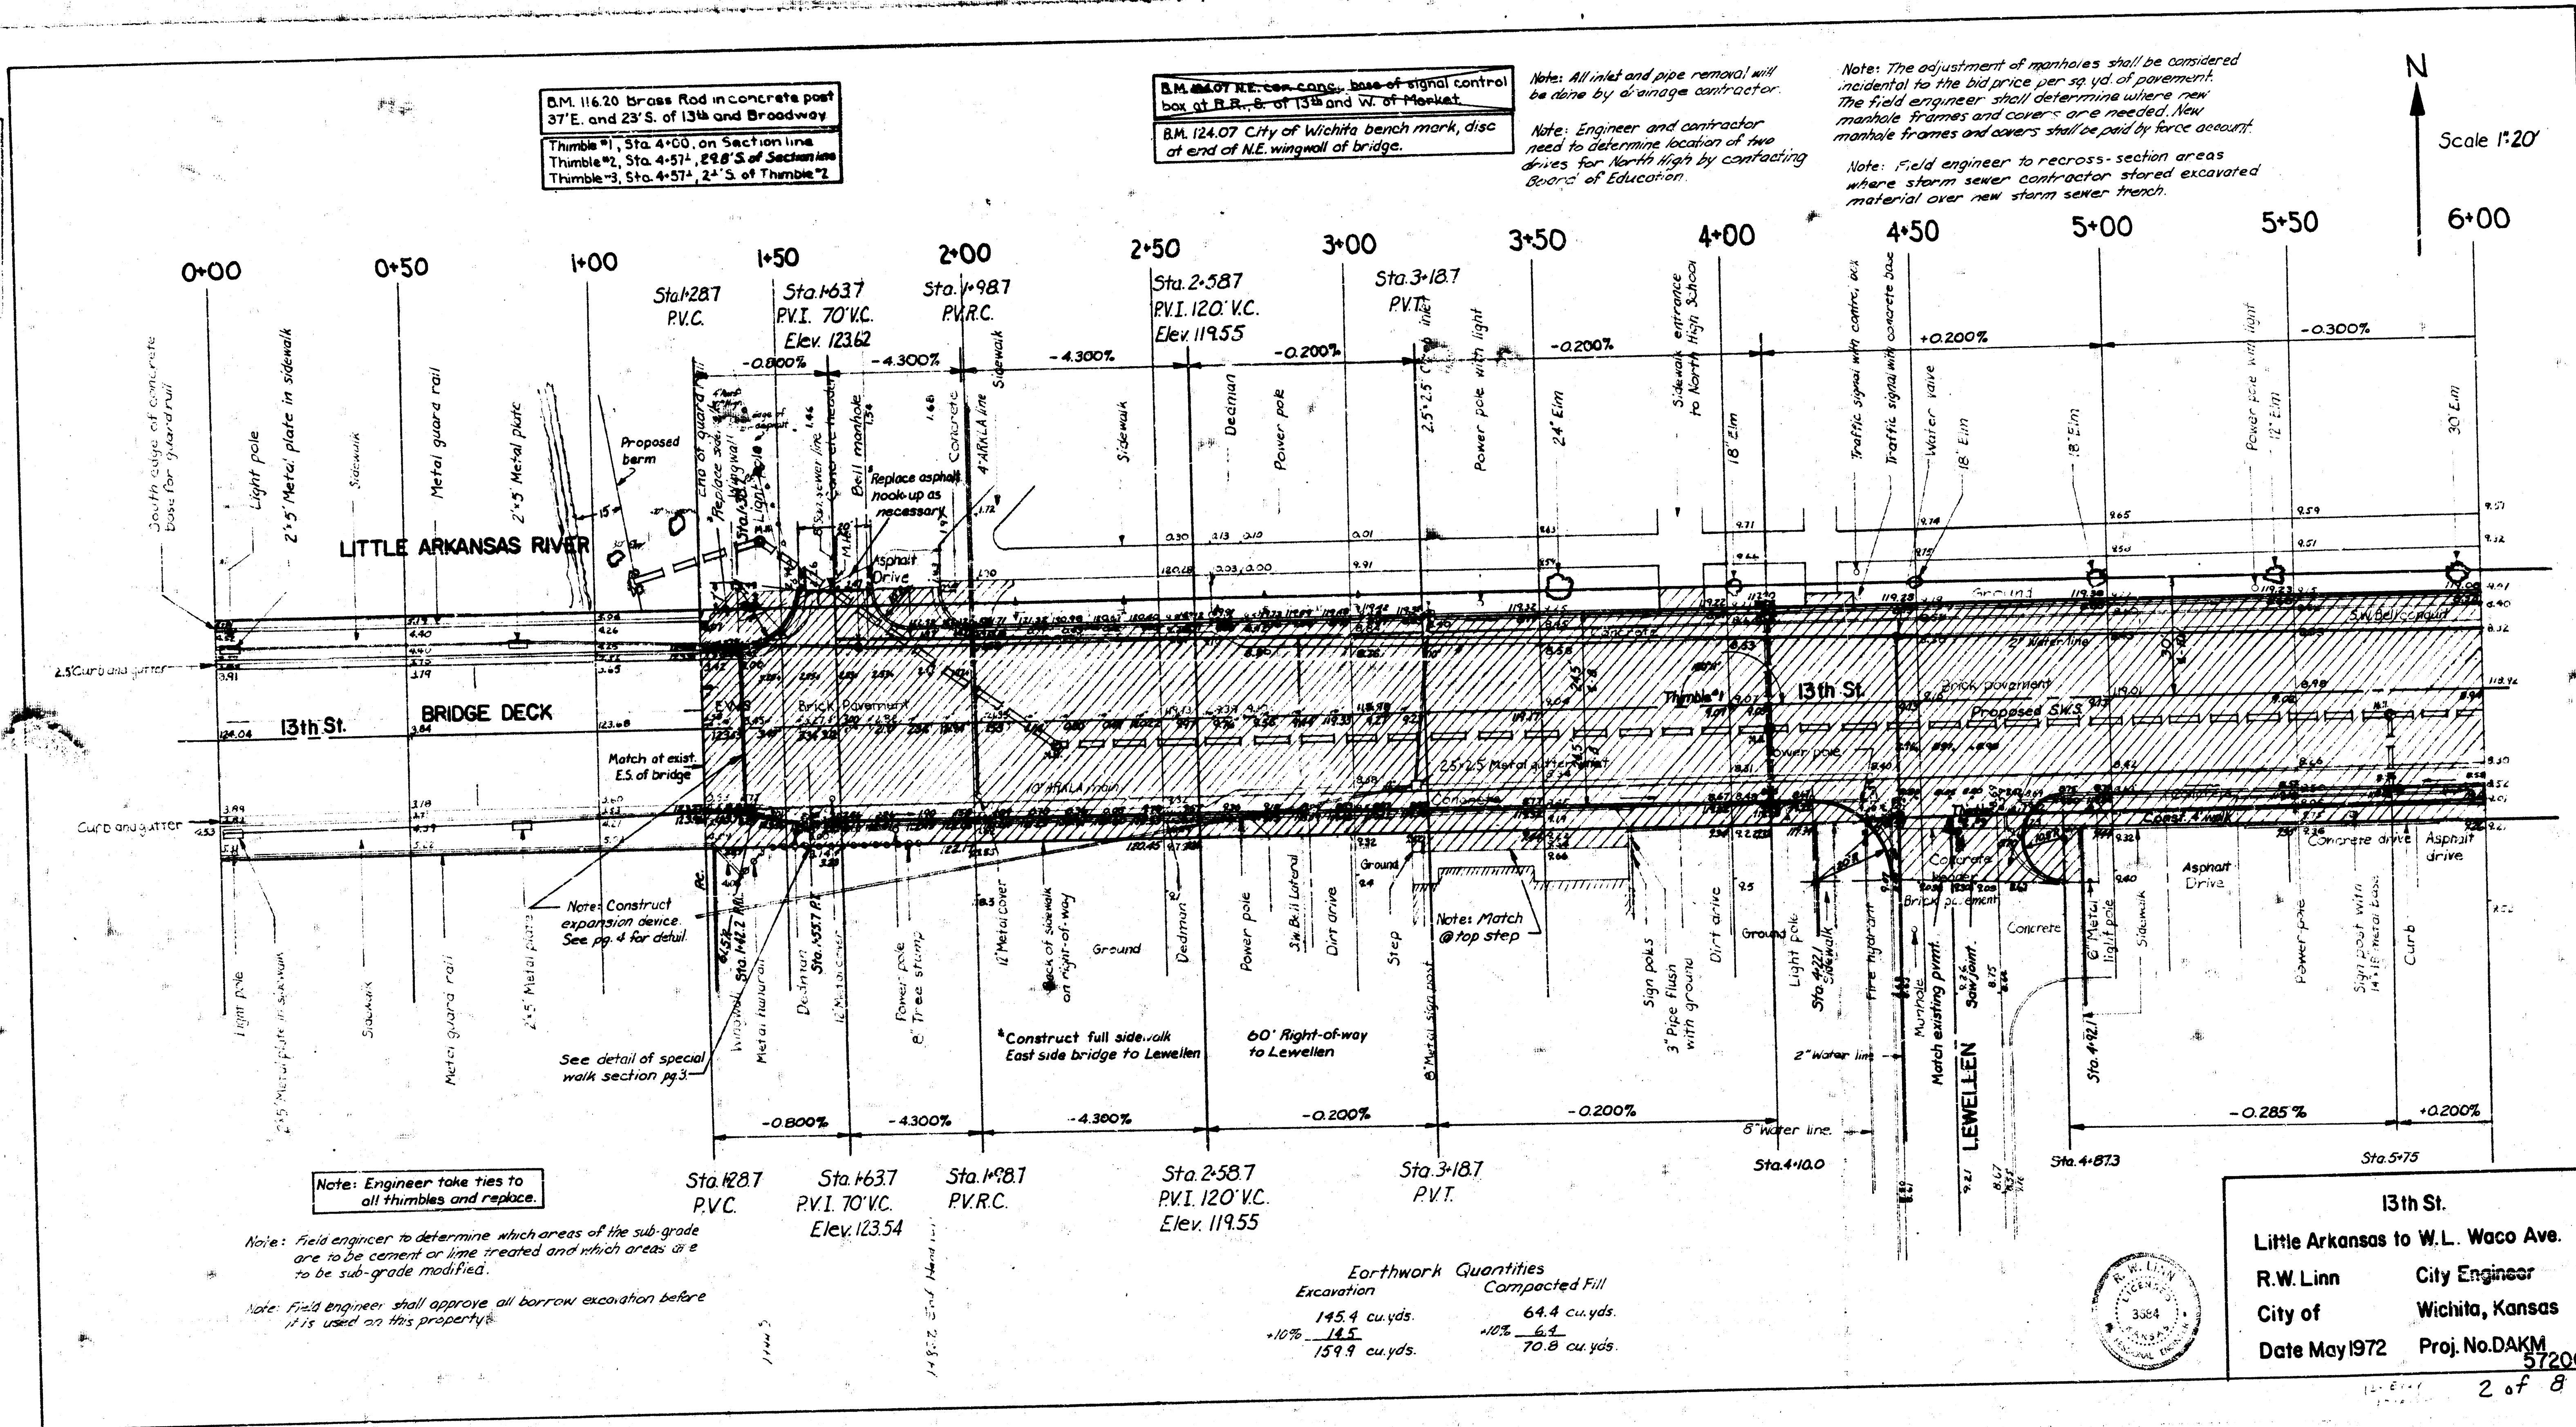


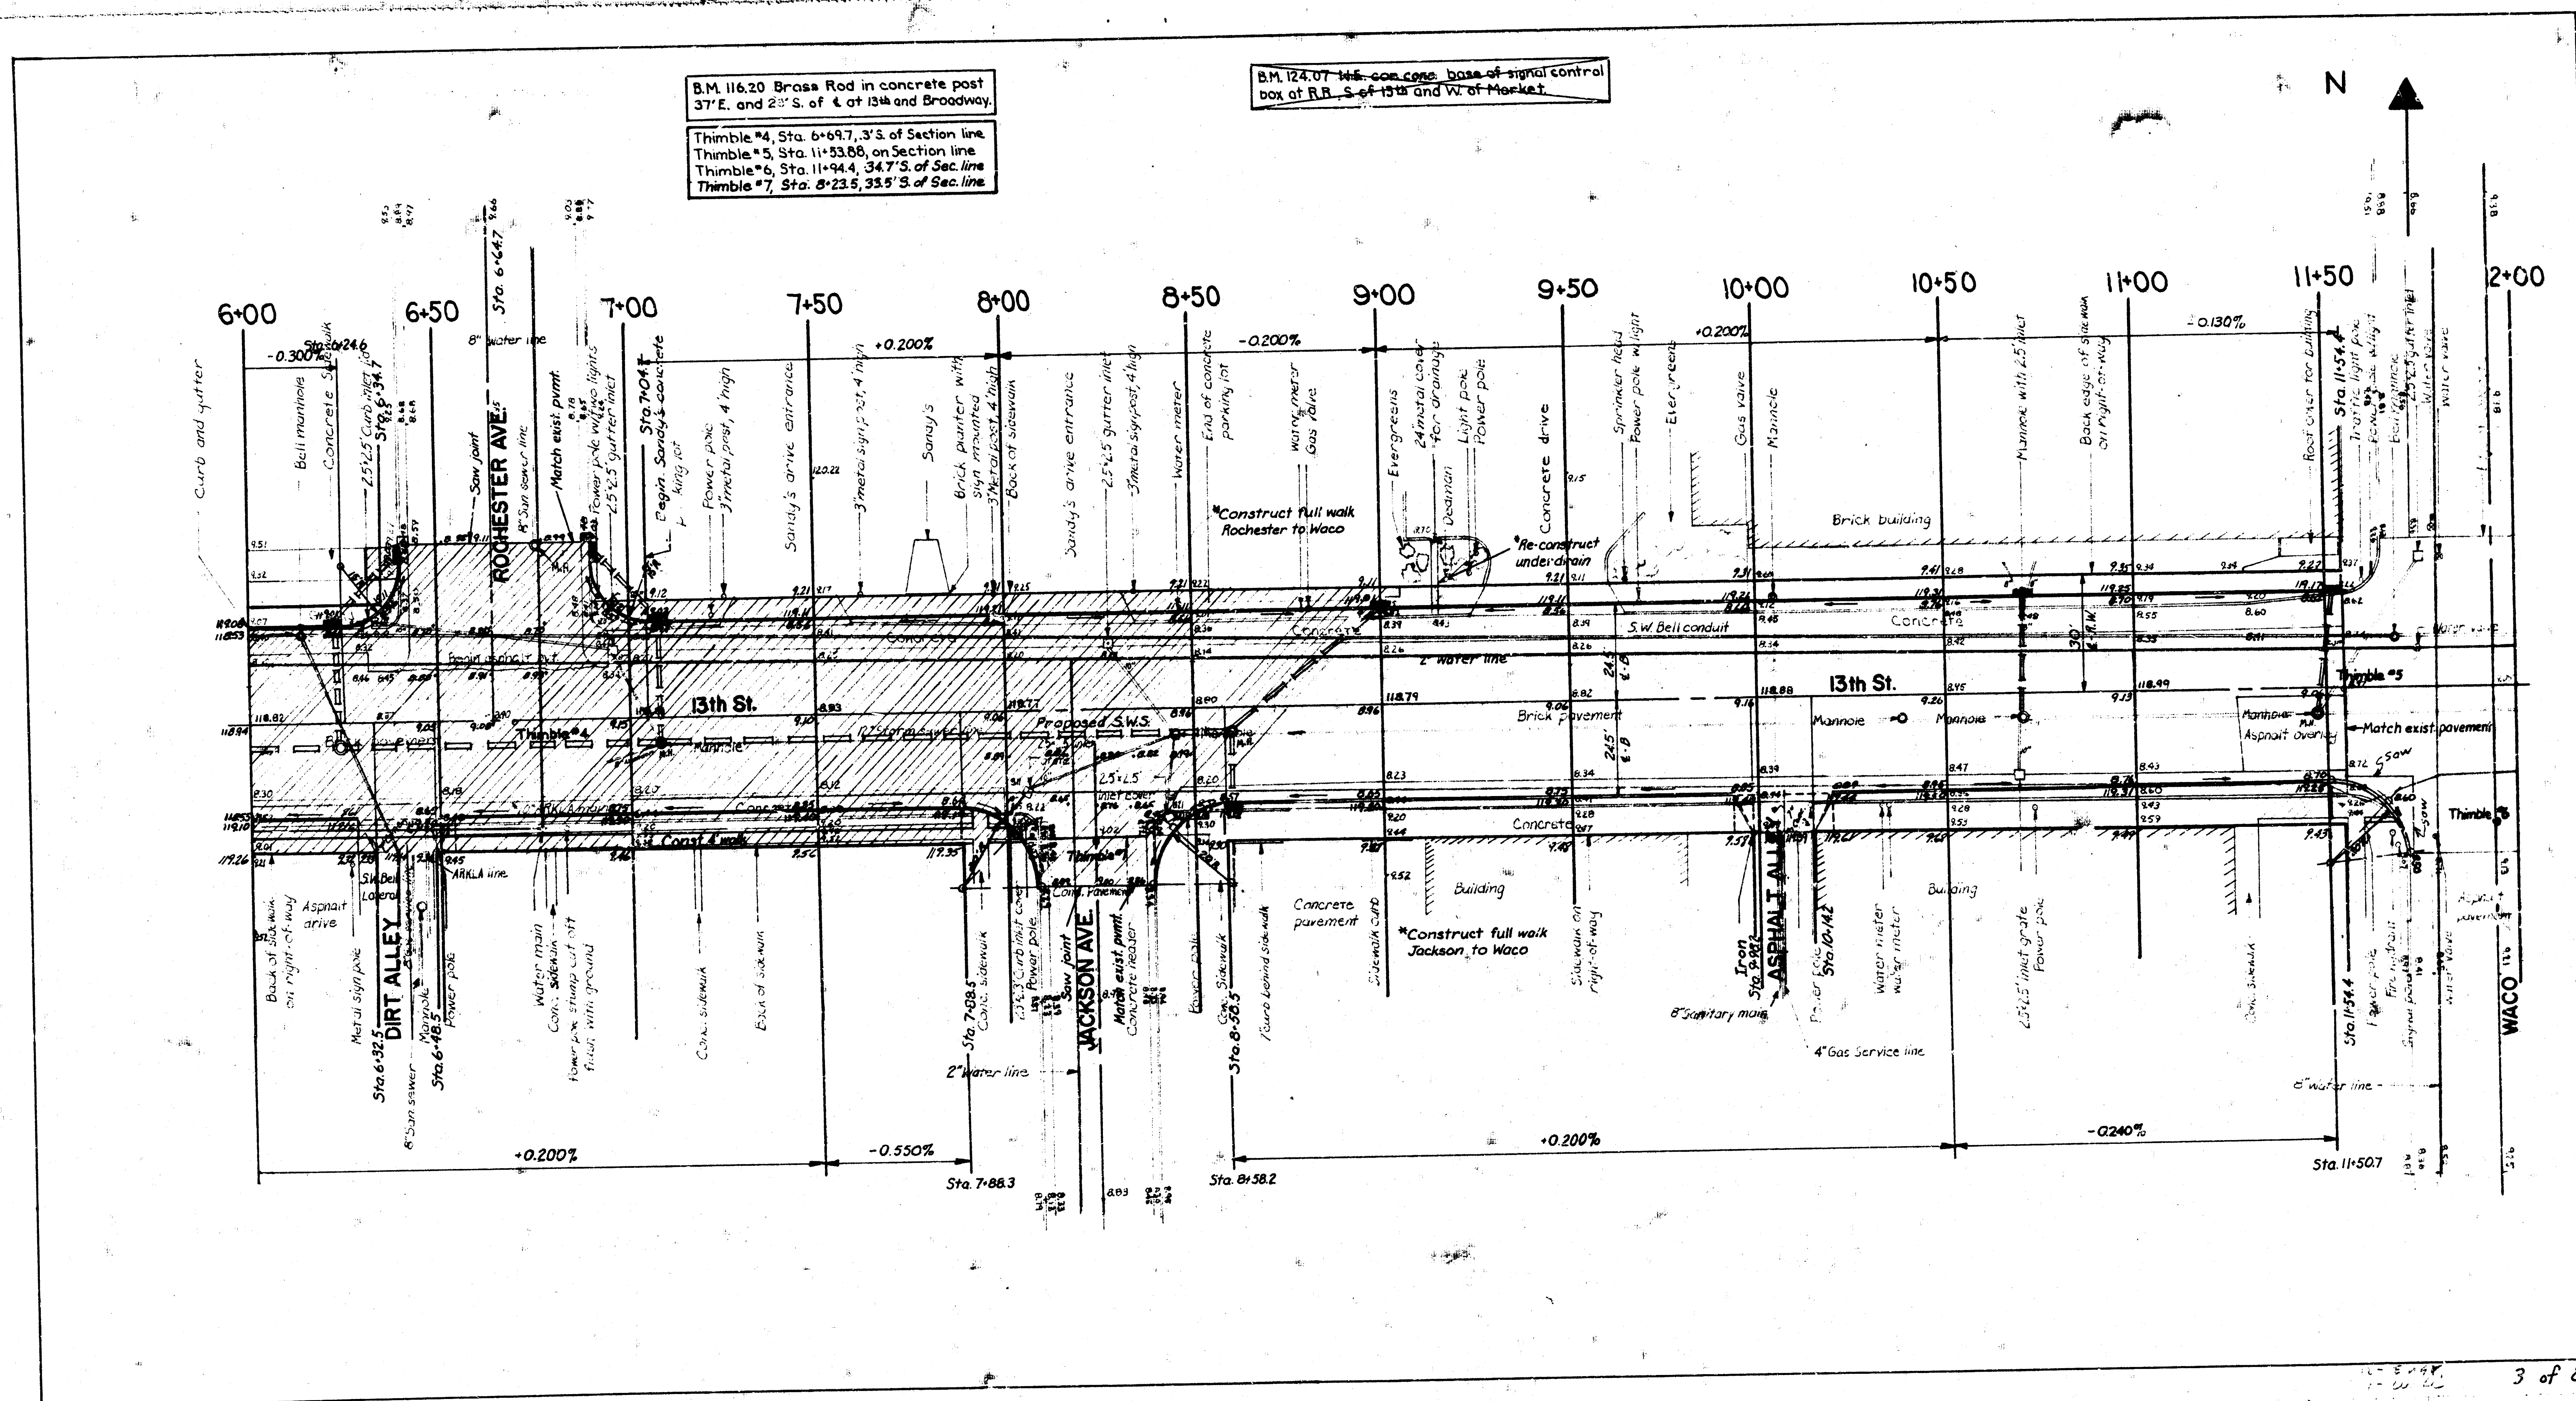

BM 11620 Brass Rod in concrete post
37' E. and 29' S. of E 13th and Broadway.




Thimble #5, Sta. 11+53.66, on Section line
Thimble #6, Sta. 11+94.4, 347.5 of Sec. line
Thimble #8, Sta. 12+34.7, 346.5 of Sec. line

BM 12407 NE corner concrete base signal control
box at R.R. S. of 13th and W. of Market.

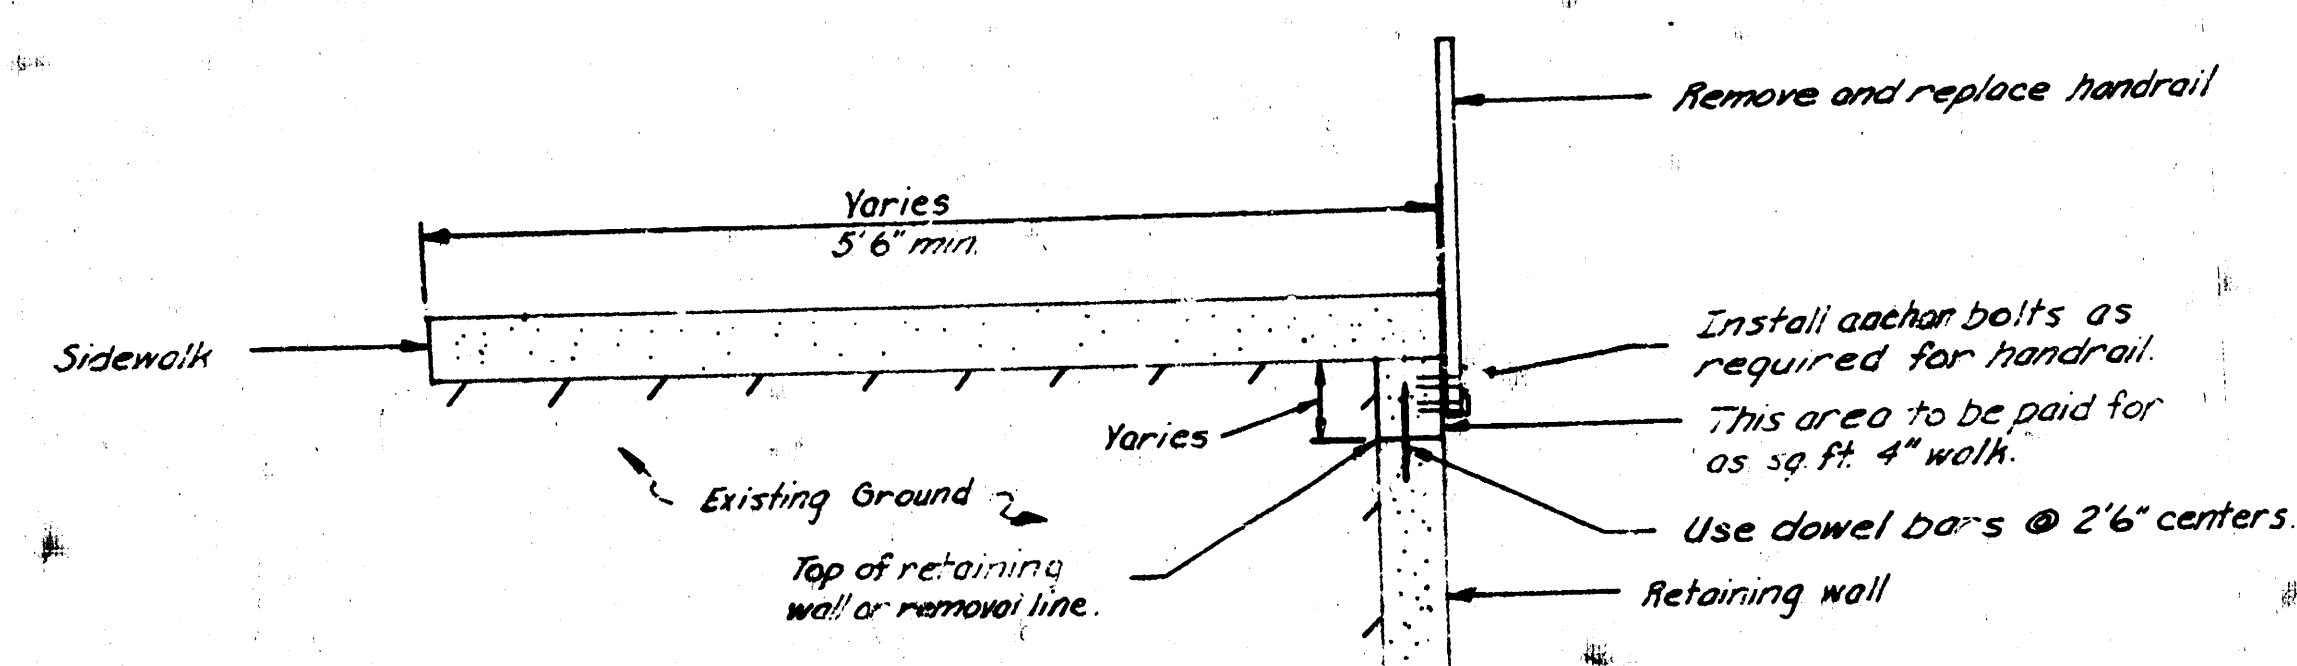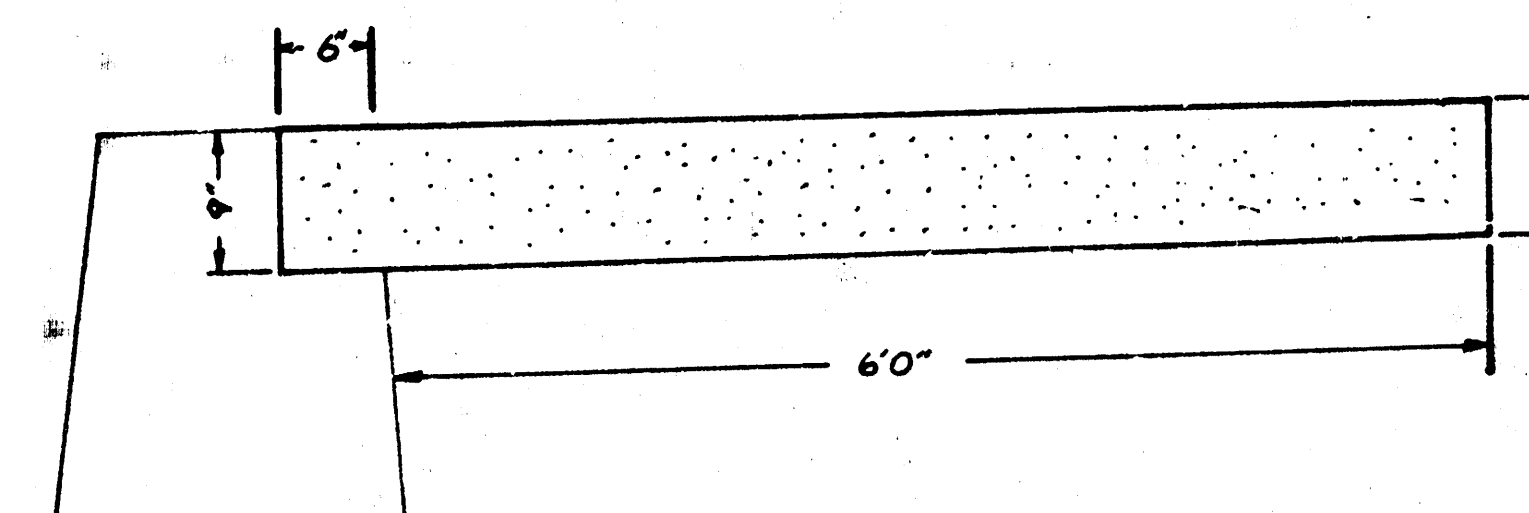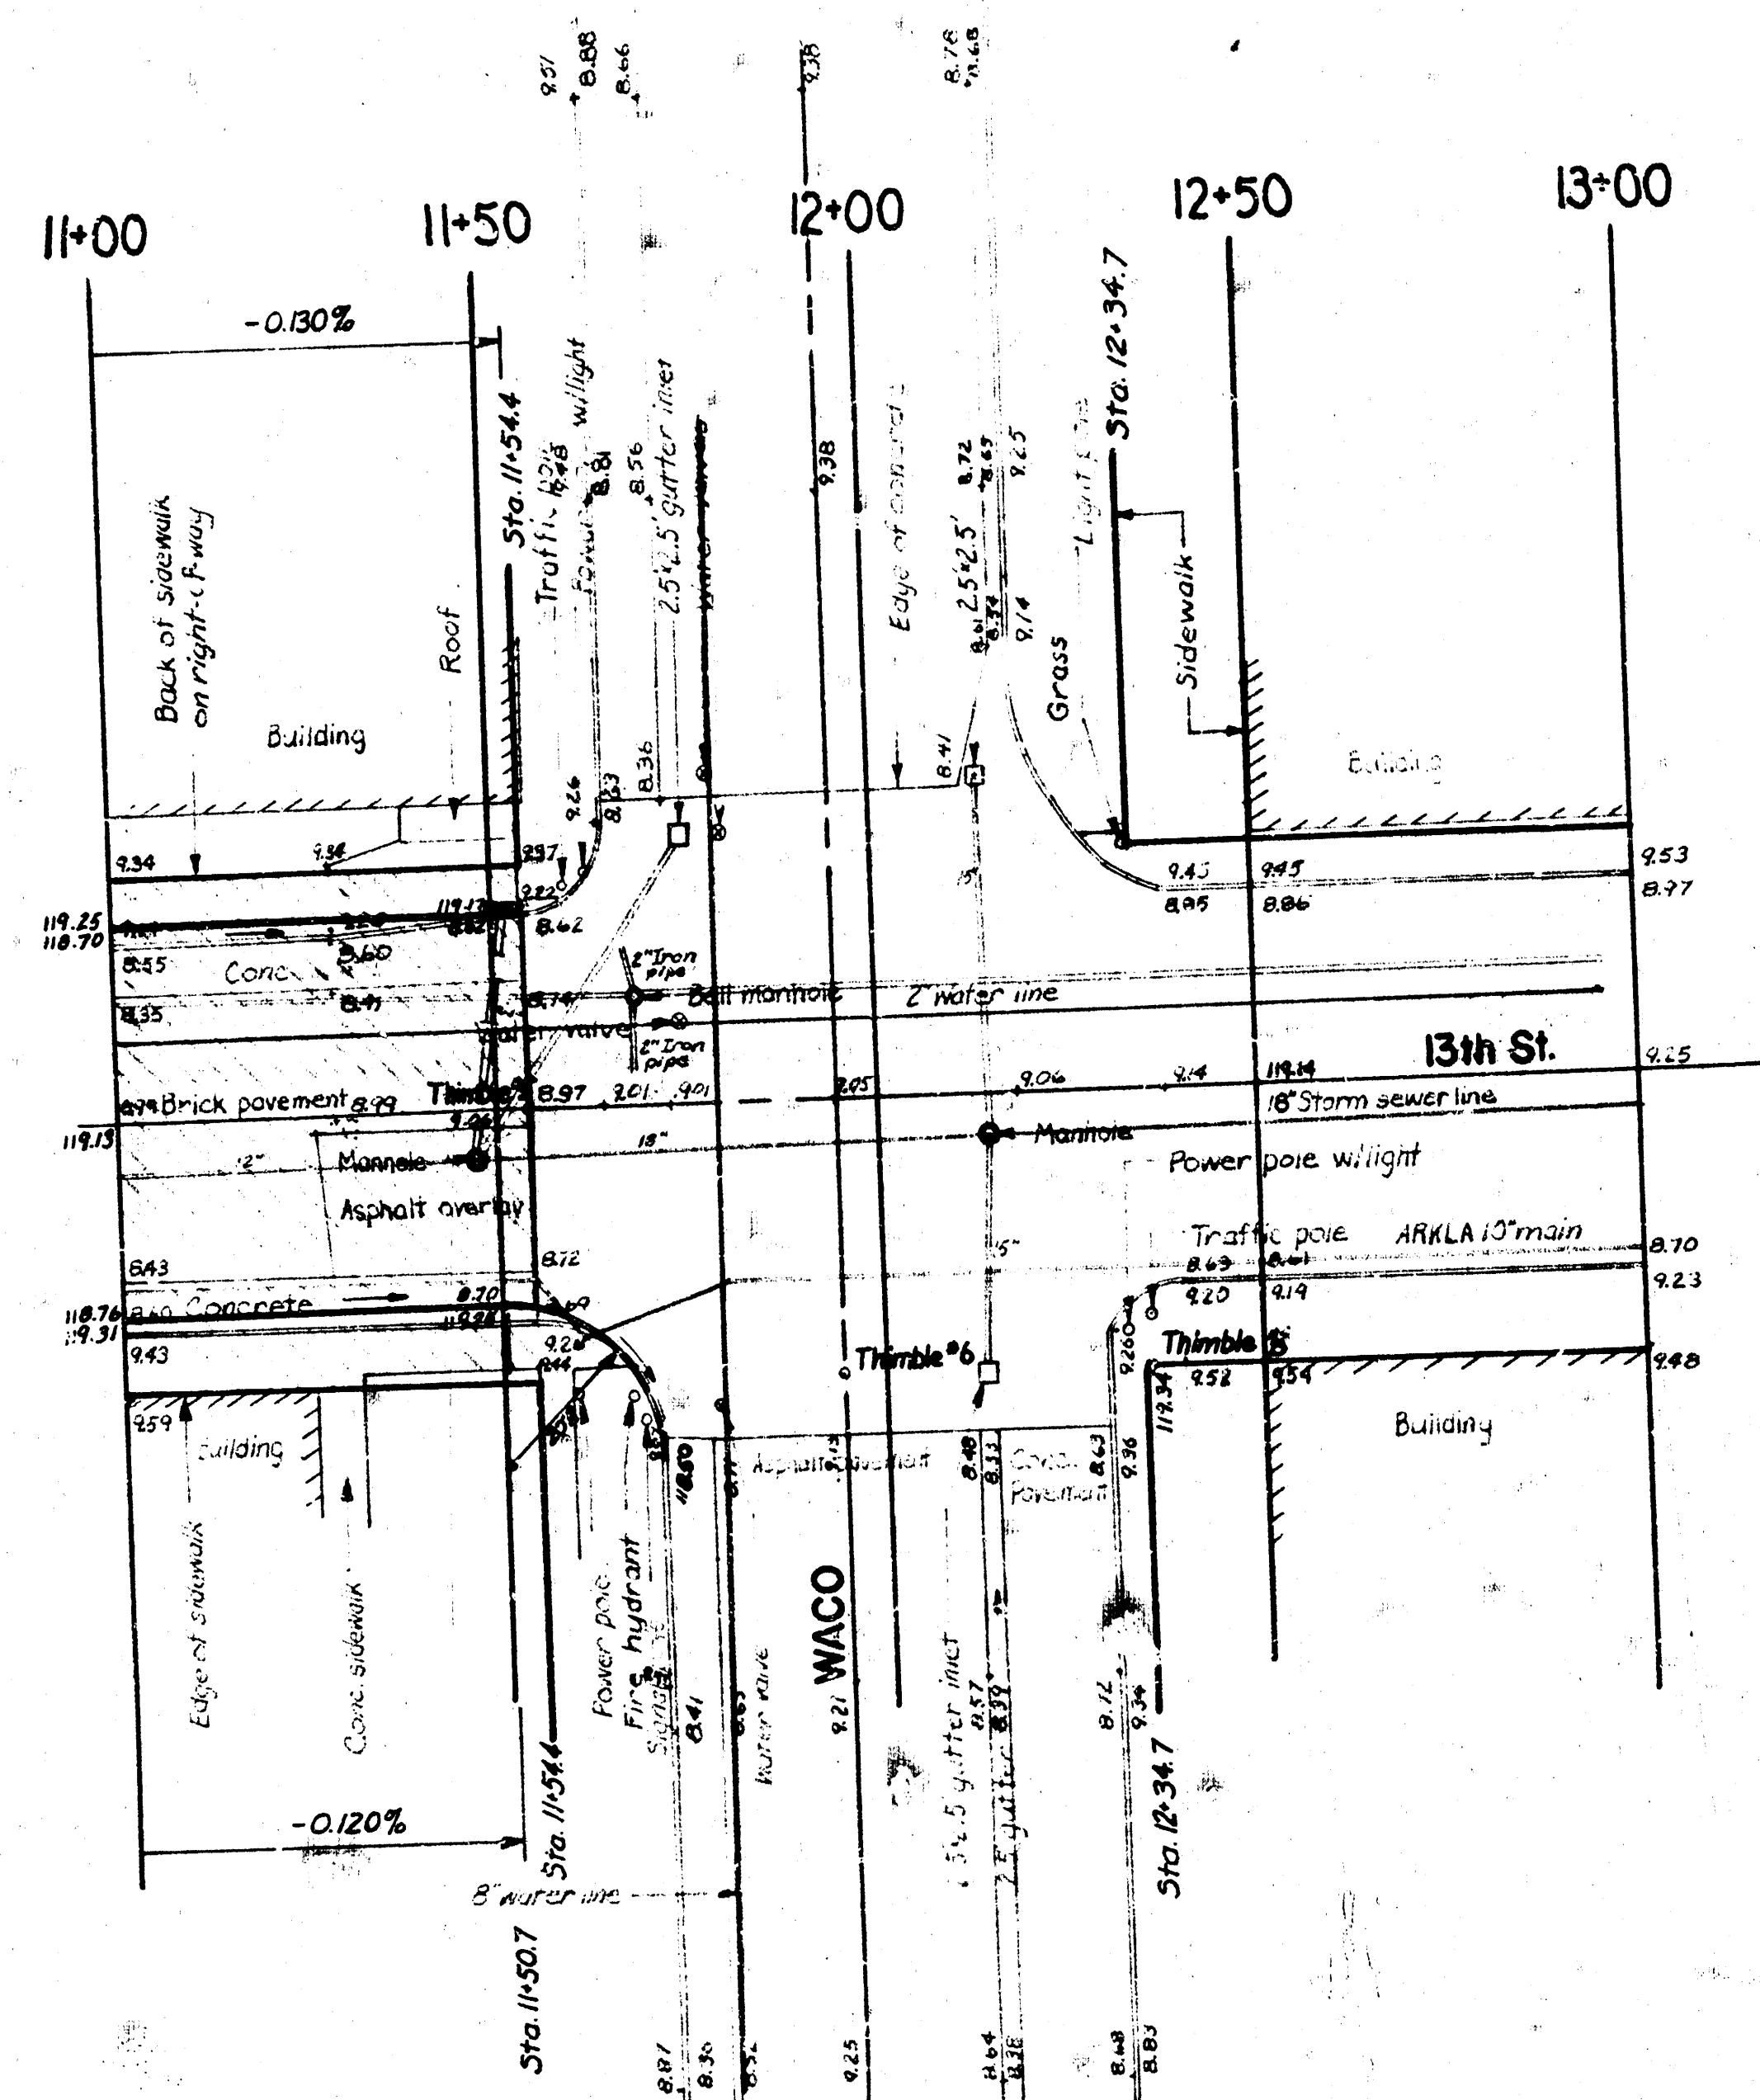

Note: Cost of furnishing and installing anchor bolts to be included in bid price for removing and replacing handrail.


LITTLE ARKANSAS 13th RIVER BRIDGE

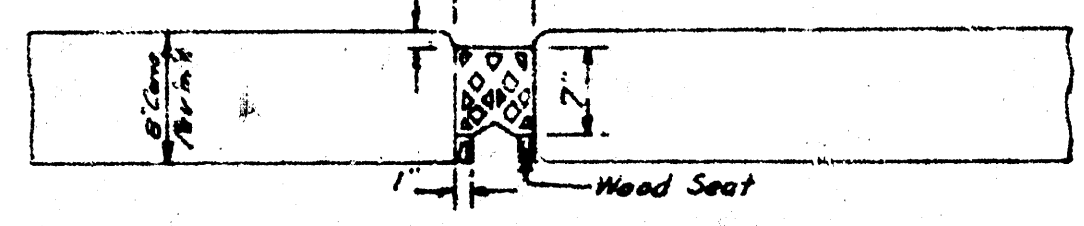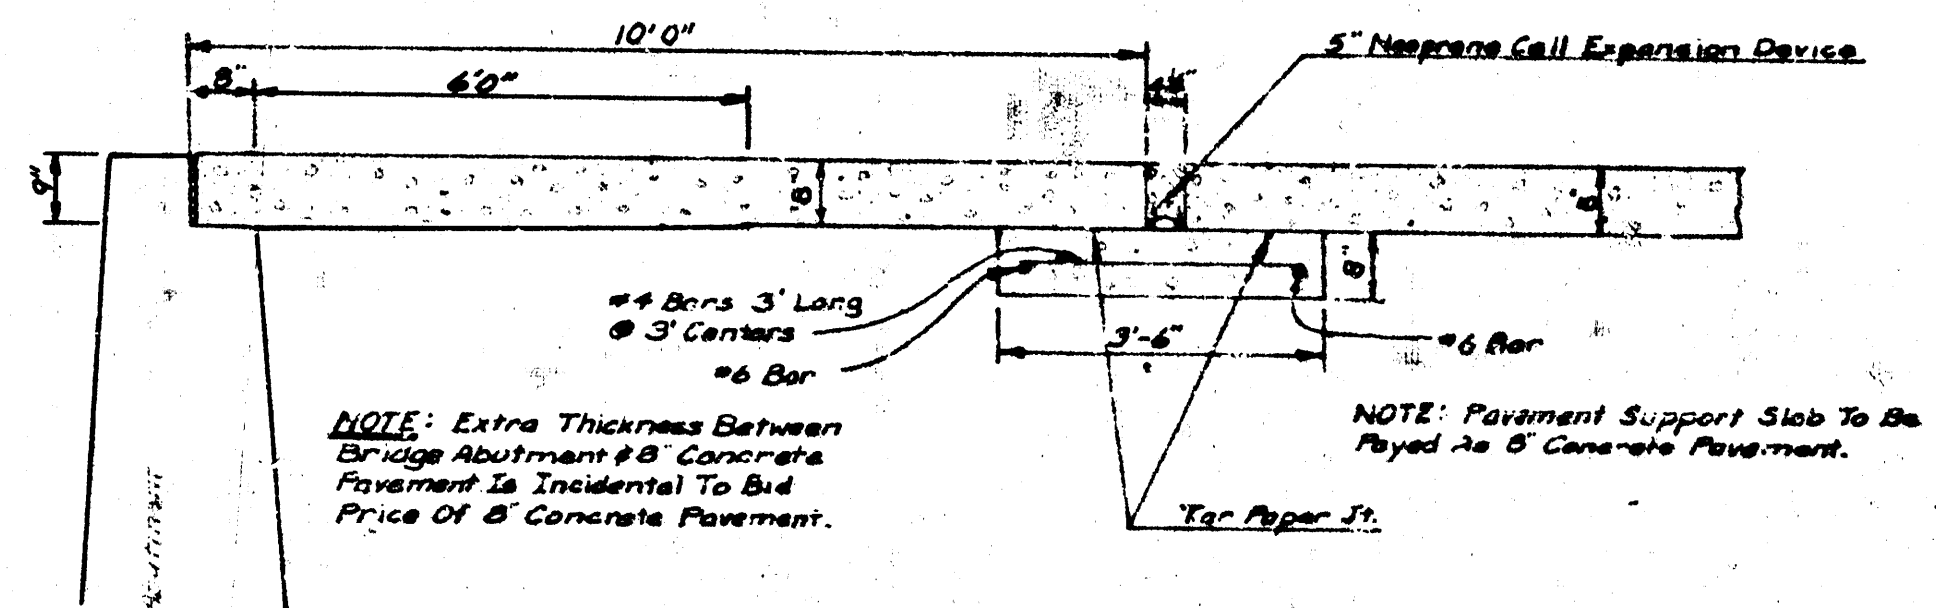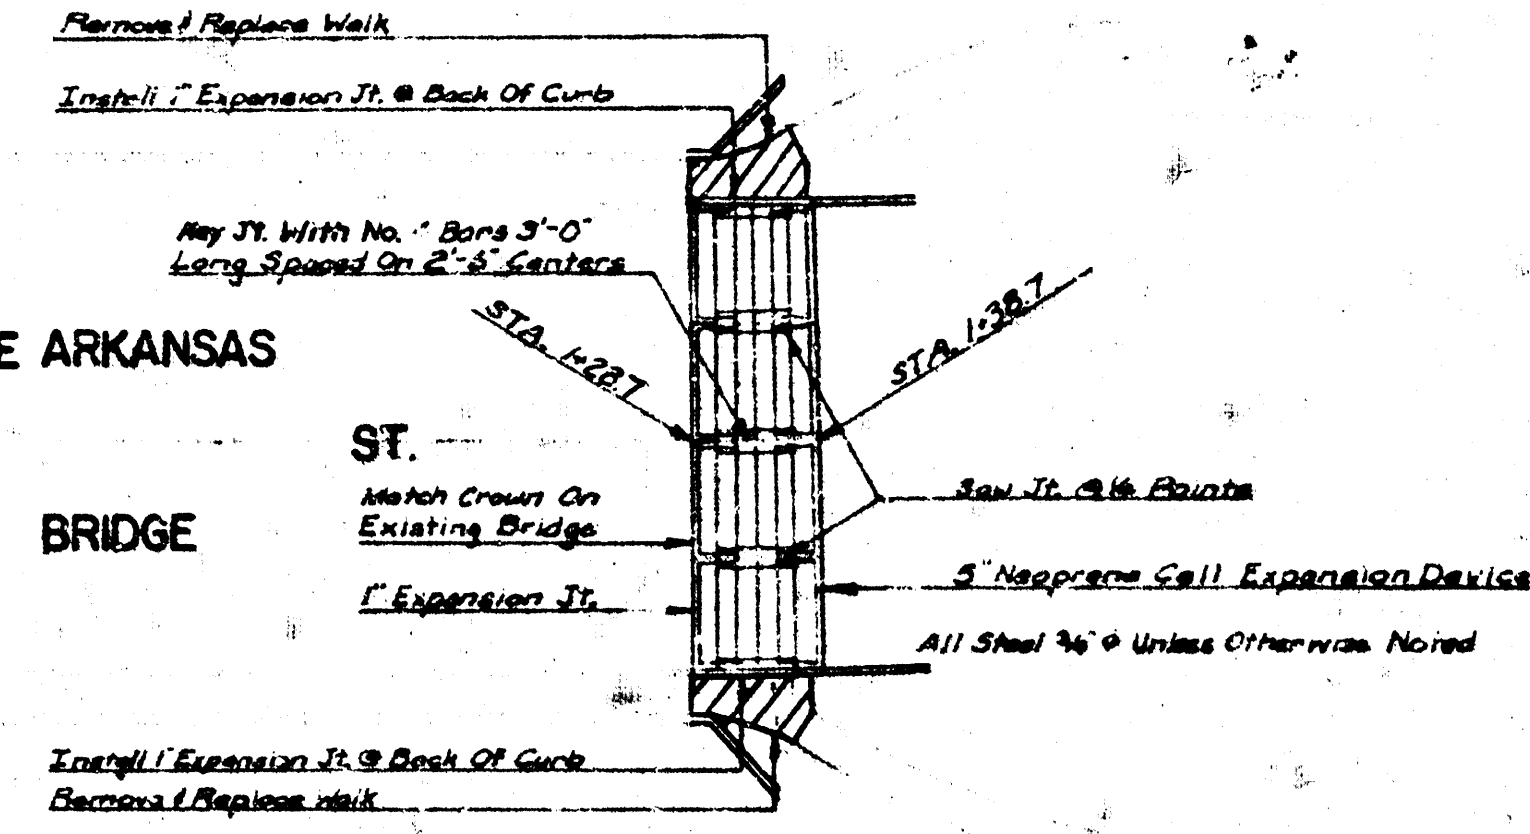

Install 5' Wide Prefabricated Open Cell Neoprene Joint Seal. Use "H" Series Delectic Bridge Seal Catalog No. H-5000, D.S. Brown Co. Or An Approved Equal.

The Neoprene Joint Material Shall Be Machine Installed With Equipment Capable Of Placing The Strips At The Specified Depth Without Increasing Or Decreasing The Length As Taken From The Roll Or Box By More Than 5%. No Splices Will Be Permitted Across The Roadway. 6' Long Sections Are To Be Installed Vertical In The Curb Section Of The Roadway Pavement. The Seals Shall Be Secured In Place With An Approved Lubricant Adhesive Which Shall Cover Both Sides Of The Seal Over The Full Contact Area. The Seals And Installation Shall Not Be Paid For Directly, But Shall Be Subordinate To The Bid Item Of 8' Concrete Pavement.


EXPANSION DEVICE DETAILS

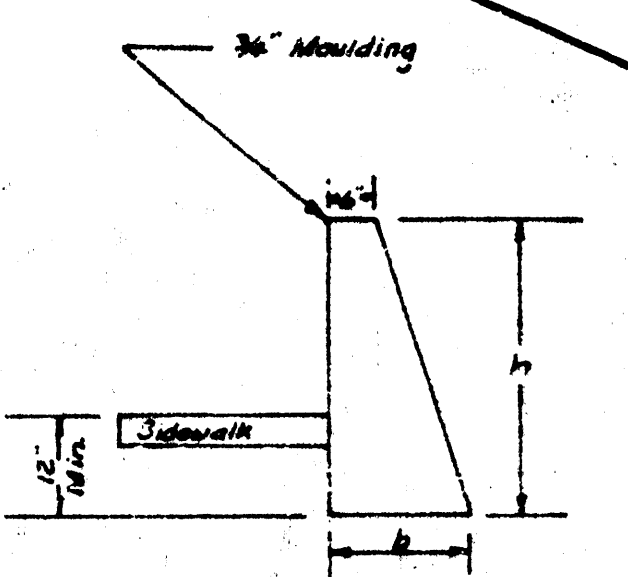


GRAVITY TYPE
(Concrete)

Construct Top Paper & Keyed Construction Joints @ 60' Intervals. Discontinue Reinf. Steel In L-Type Retaining Walls

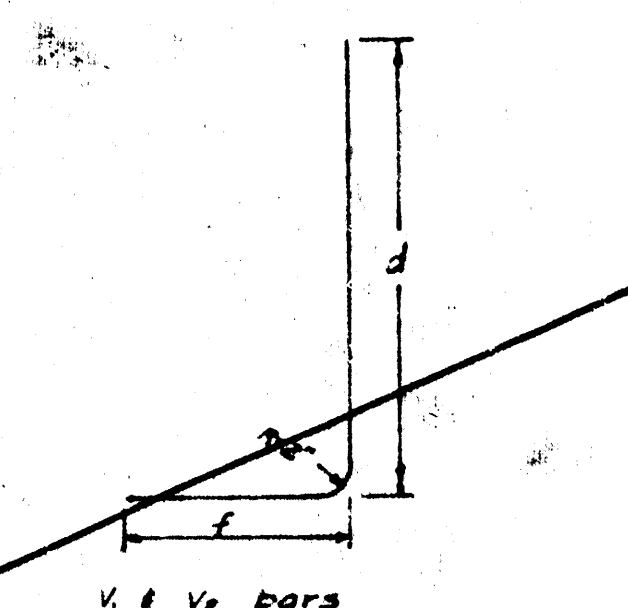

TYPE A STEP DETAIL


1/4" Bars Alternately @ 18" o.c.


Expansion Joints @ 100' Maximum Spacing. 1' Preplaced Expan. Jt. Material. Discontinue Reinf. Steel.

L-TYPE RETAINING WALL FOR DRIVEWAYS

REINF. STEEL SCHEDULE									
L-TYPE RETAINING WALL FOR DRIVEWAYS									

NOTE: All excavation for retaining walls shall be included in the bid price per Lin. Ft. of retaining wall. The 4' file washpans & crushed rock or coarse gravel for drainage, shall be included in the bid price per Lin. Ft. of retaining wall.



Note: The Field Engineer shall final measure retaining walls prior to backfill operations

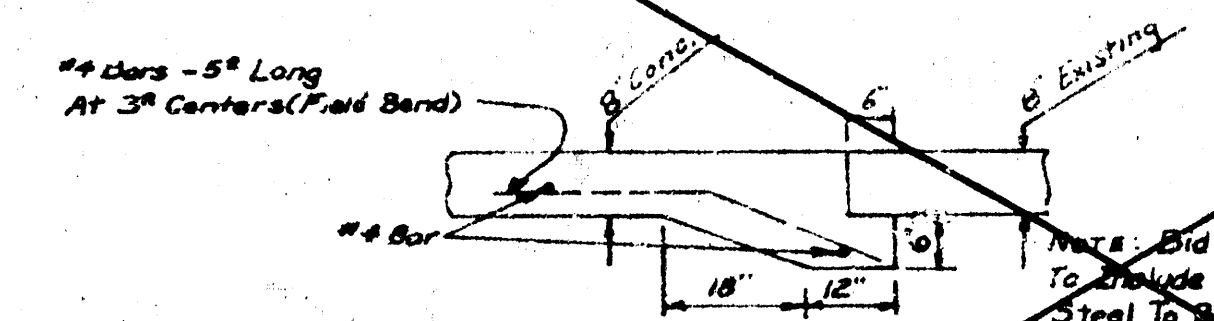



"UNDER-PINNING
DETAIL"

Note: Bid Item For "L.F. Under-Pinning To Bridge Cast Of Concrete & Excavation. Steel To Be Paid As Lbs. Of Reinf. Steel.

Surveyed by: [illegible]
 Date: [illegible]
 Checked: [illegible]

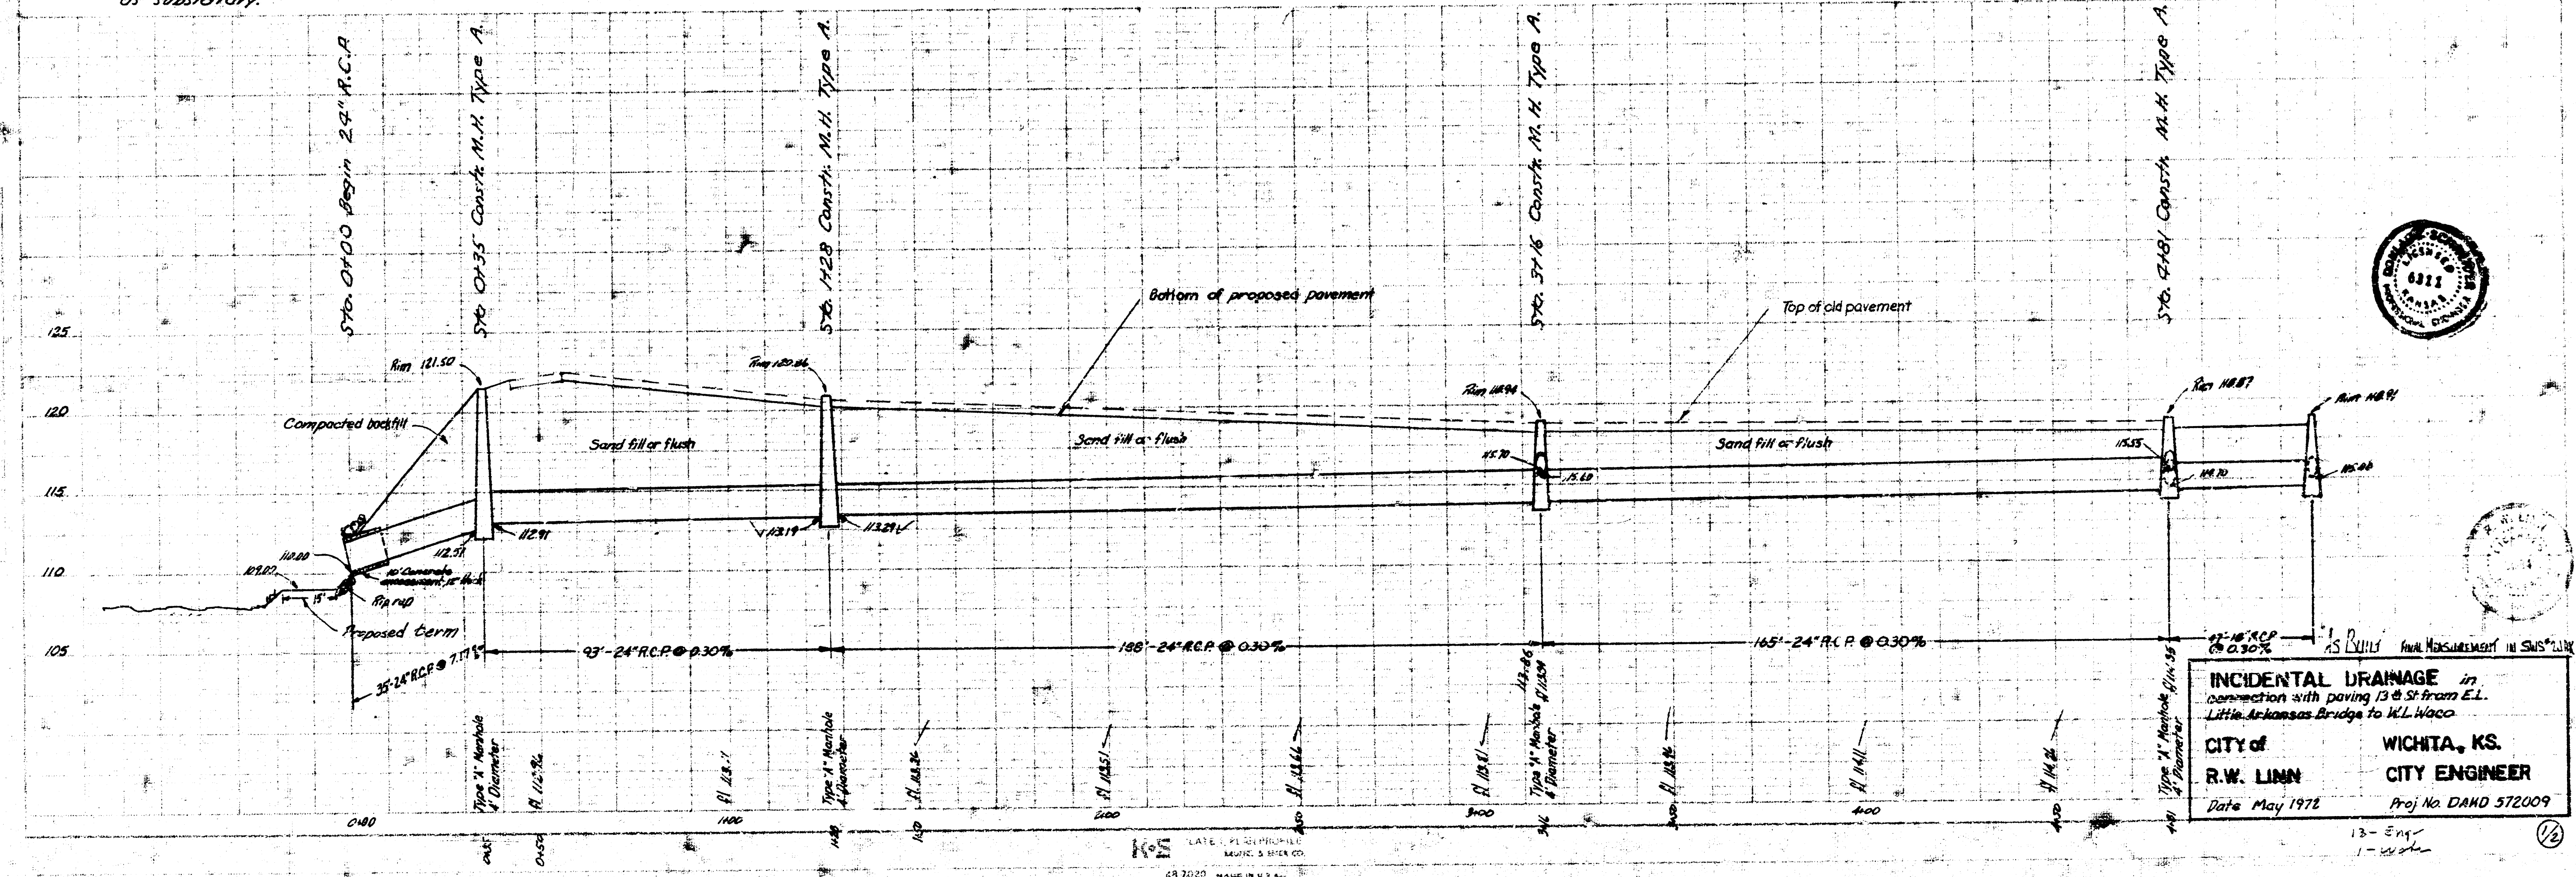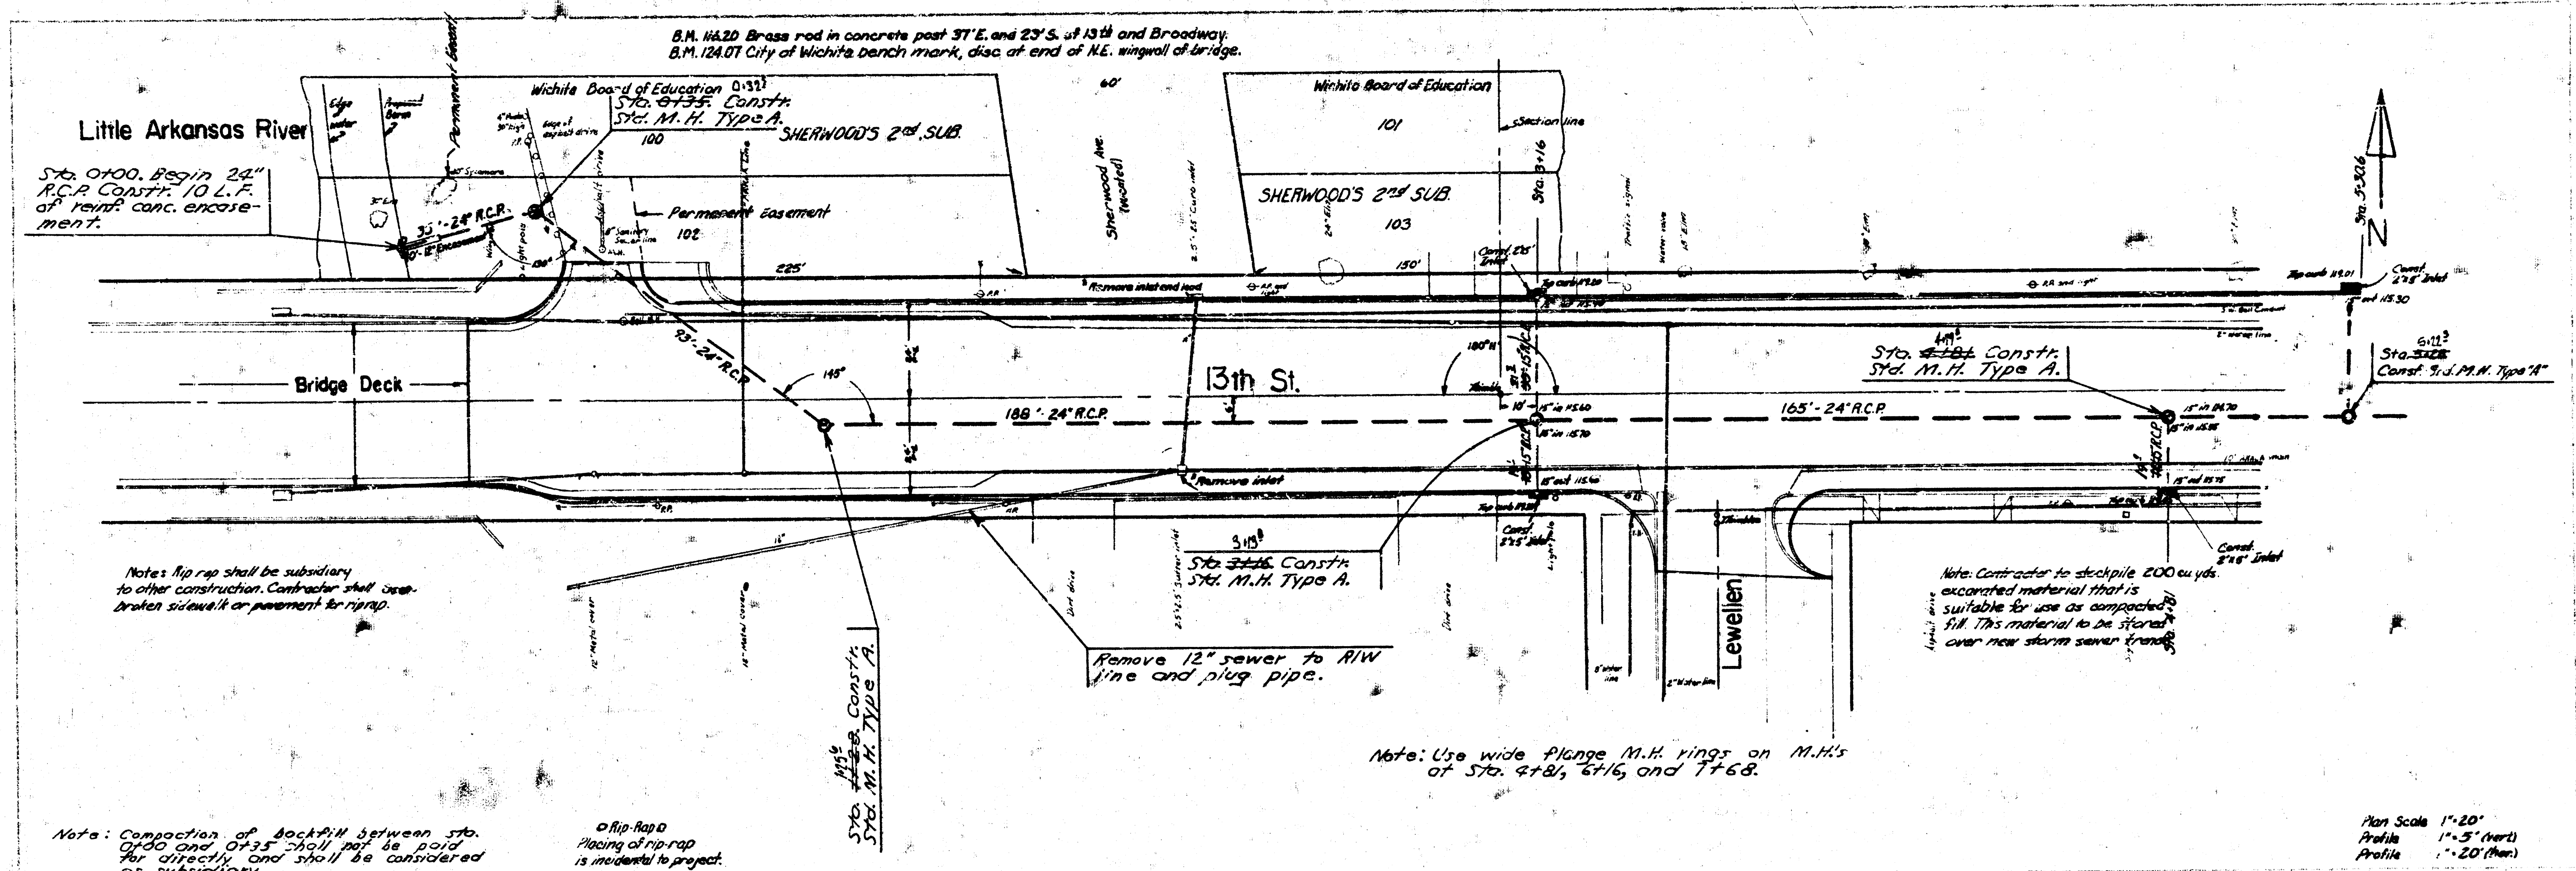

Survey Data
 Plan
 Date
 Scale

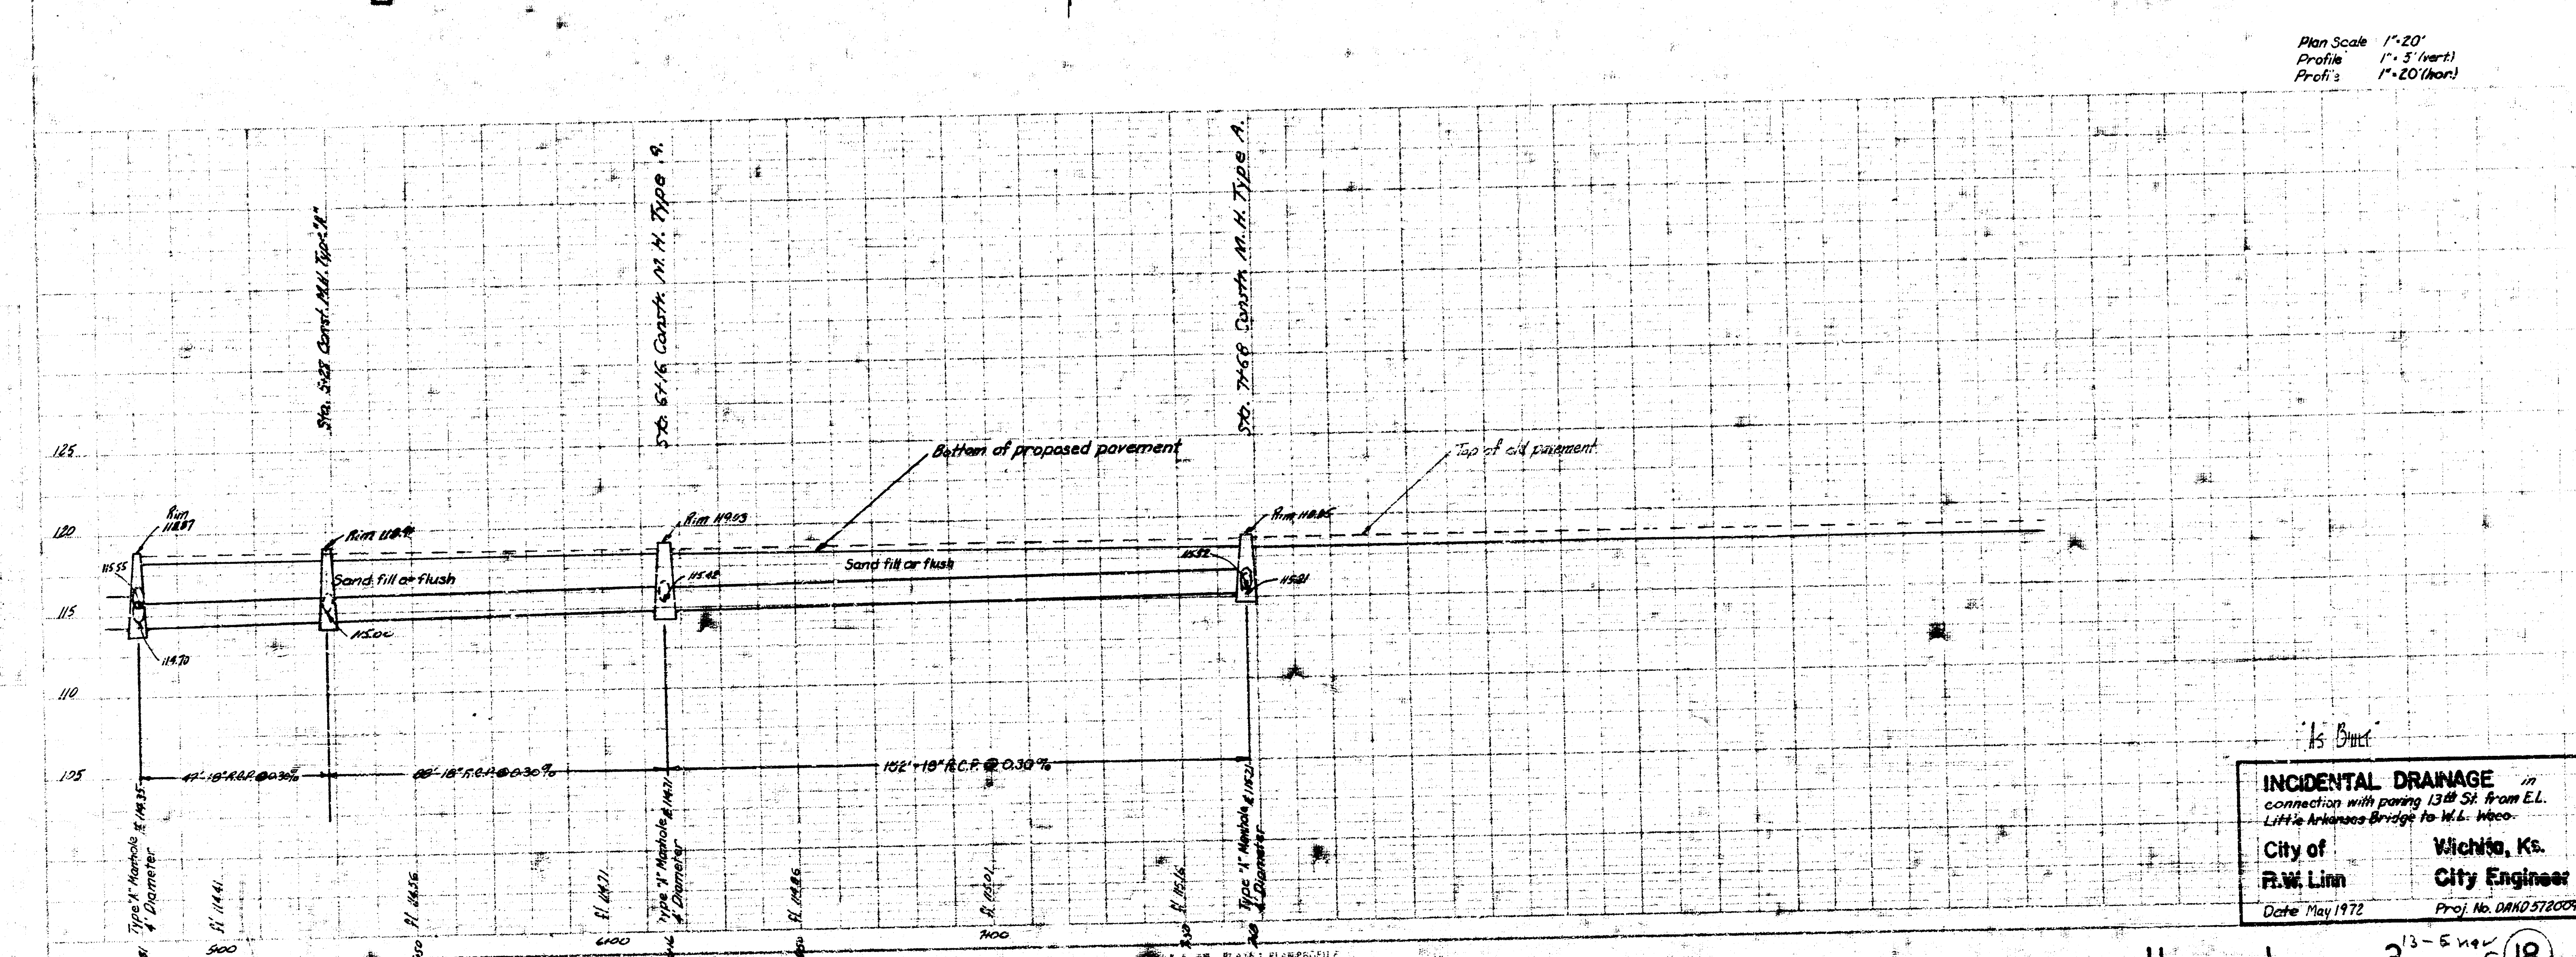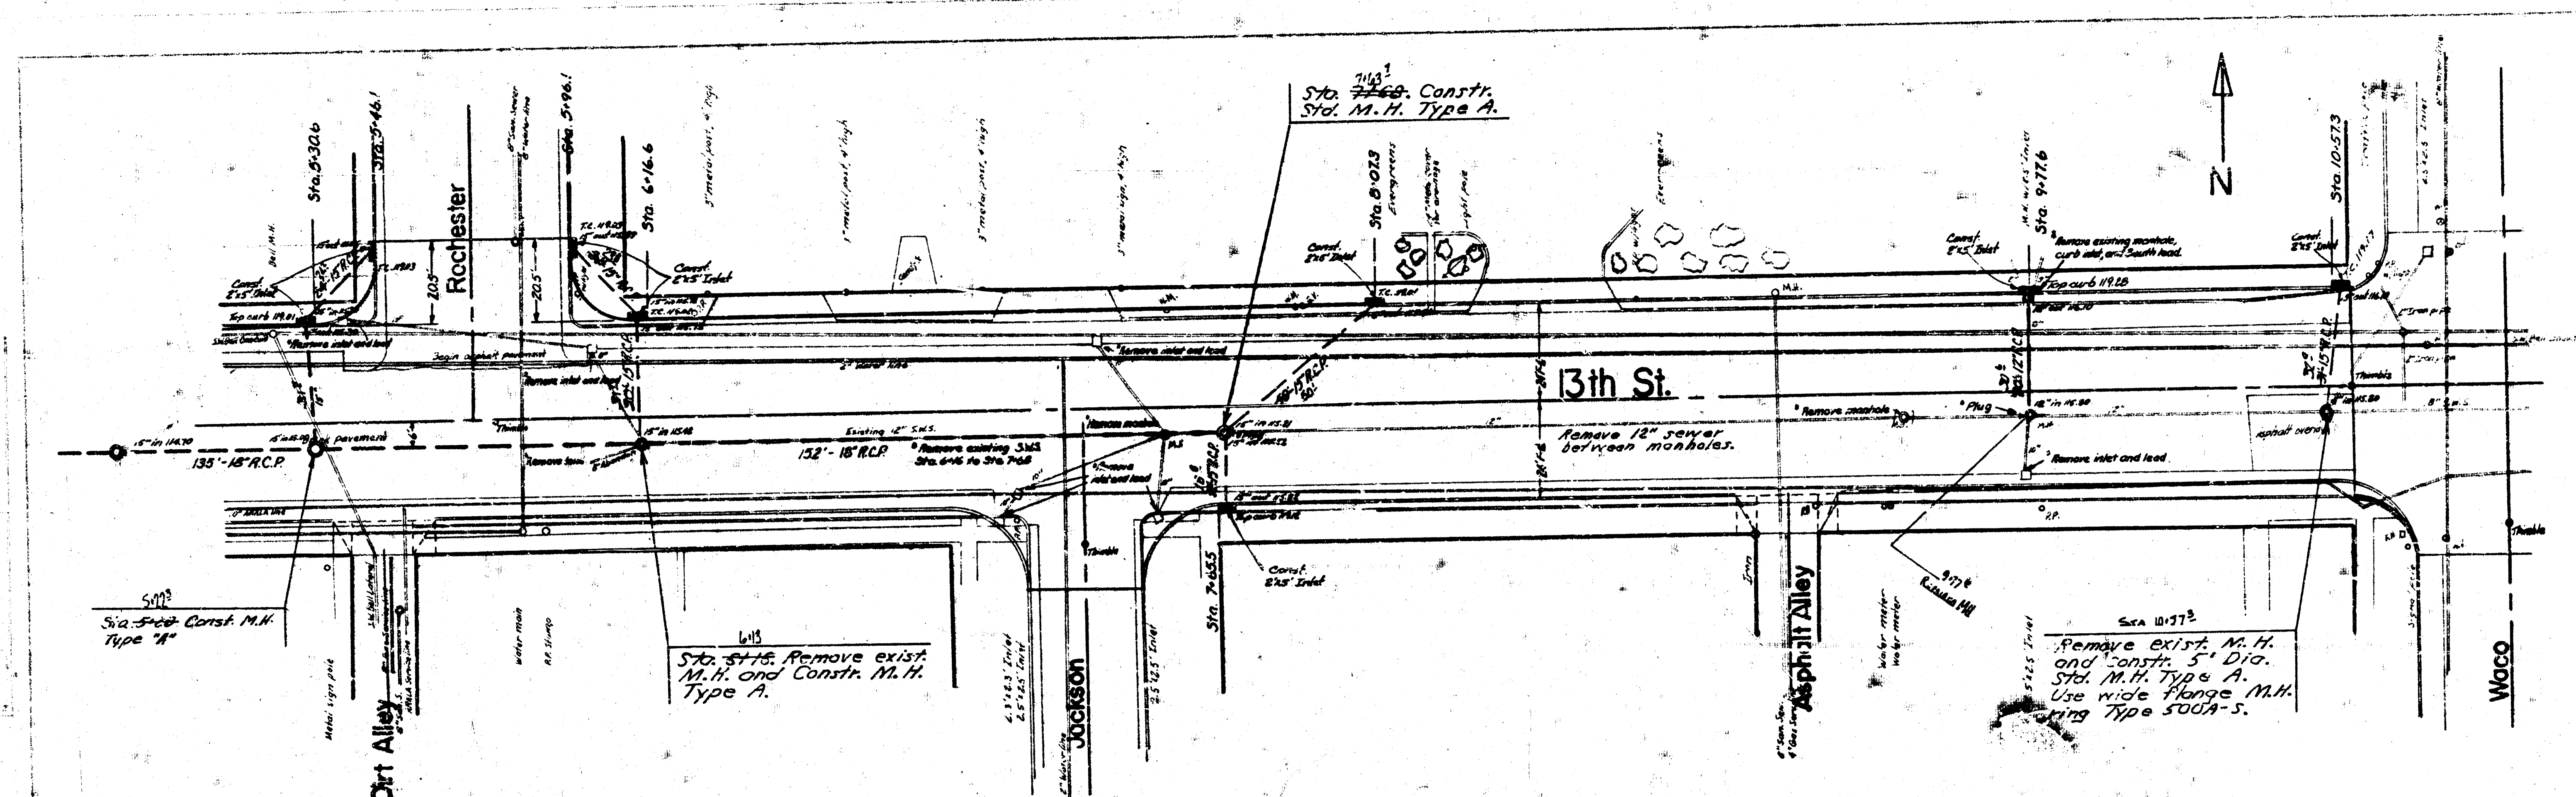

Plan Scale 1"=20'
 Profile 1"=5' (vert)
 Profile 1"=20' (horiz)

INCIDENTAL DRAINAGE
 connection with paving 13th St. from E.L.
 L.H. Arkansas Bridge to Waco.
 City of **Wichita, Ks.**
R.W. Linn City Engineer
 Date May 1972 Proj. No. DND 578009