EXCAVN FOR DITCH
3'X10'X125'

1942

THIRTEENTH ST—W.L. YALE TO E.L. CITY LIMITS.

26-2-30—A.C.

DESCENDING GRADES TO 150' NORTH OF M.L. 13TH.

-1.178%

-.338%

+.426%

YALE BLVD

YALE AV.

13TH ST.

13TH

ST.

END PRESENT PAVEMENT

WARP GRADE TO PUT LOW POINT AT BOX.

-.688%

+3.07%

+6.07%

R.I. 200' V.C.
177.56

22.6

31.5

171.0

197.2

16.2

22.4

33.2 S.C.

33.2 S.C.

25.0

47.8

26.0

68.9

33.5

32.5

60.2

31.5

57.9

45.7

1/2

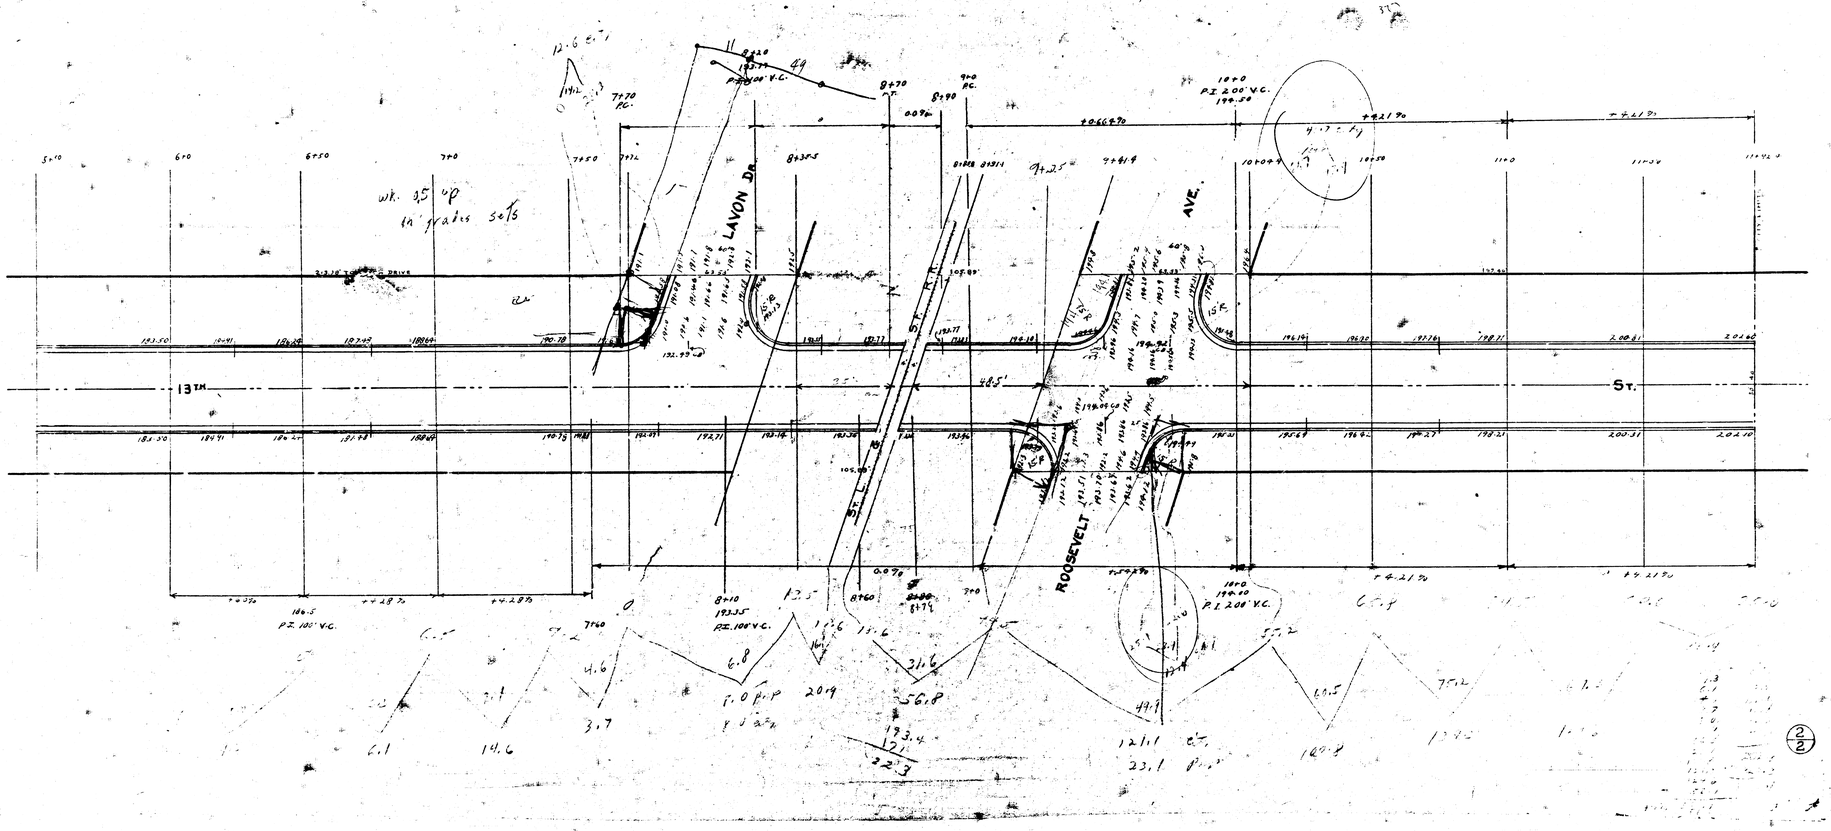
LAVON DR.
ROOSEVELT AVE.
13TH ST.
wk. 3.5 up
in grates sets
485'
0.07%
0.07%
8+10
193.35
PI 100' V.C.
9+20
193.44
PI 100' V.C.
7+70
P.C.
9+70
P.T.
9+90
P.C.
10+90
199.20
PI 200' V.C.
10+10
199.40
PI 200' V.C.
10+90
P.T.
7+40
7+50
8+30.5
9+41.9
11+0
11+42.9
7+28.7
7+39.6
7+66.70
7+42.70
7+42.70
7+42.70
7+40
7+60
8+60
9+20
9+40
9+60
BK 61Y

BM. 195.07 60d Spike Southeast side Guy pole North side 13th & East line Frisco R/W.

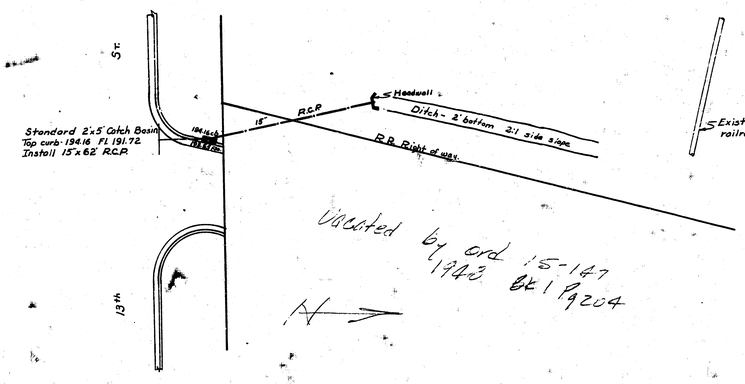

Vacated by Ord. 15-147 1943 BK 1 Pg 204

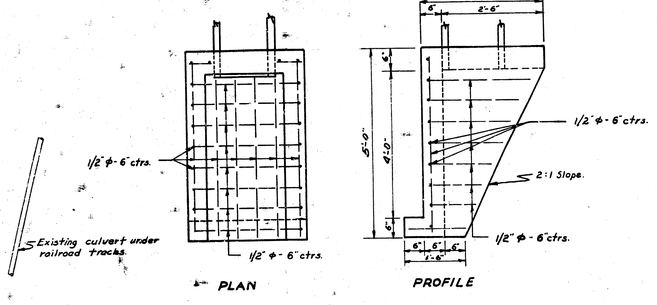

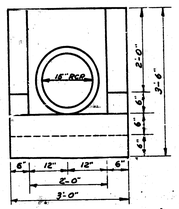

DETAILS OF HEADWALL
Showing dimensions & steel placement
Scale 3/4"=1'

NOTE: Headwall may be constructed of brick.

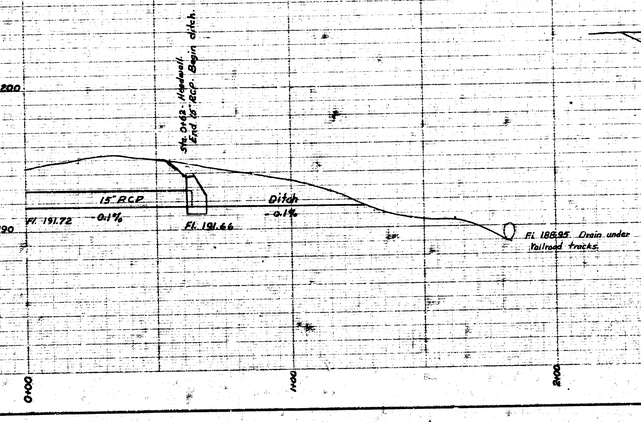

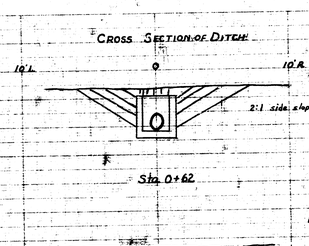

Attach to 13th St
as the drainage

DRAINAGE 13th & ROOSEVELT

City of Wichita, Kansas
L.K. White — City Engineer
January 1951 — Proj. No.

L. K. WHITE — KANSAS — 55 — REGISTERED PROFESSIONAL ENGINEER

4 10 1 (18)