


S.M. 11746 'L' in Lefever & Work & S.W. Cor
WASHINGTON & 14TH STREET.

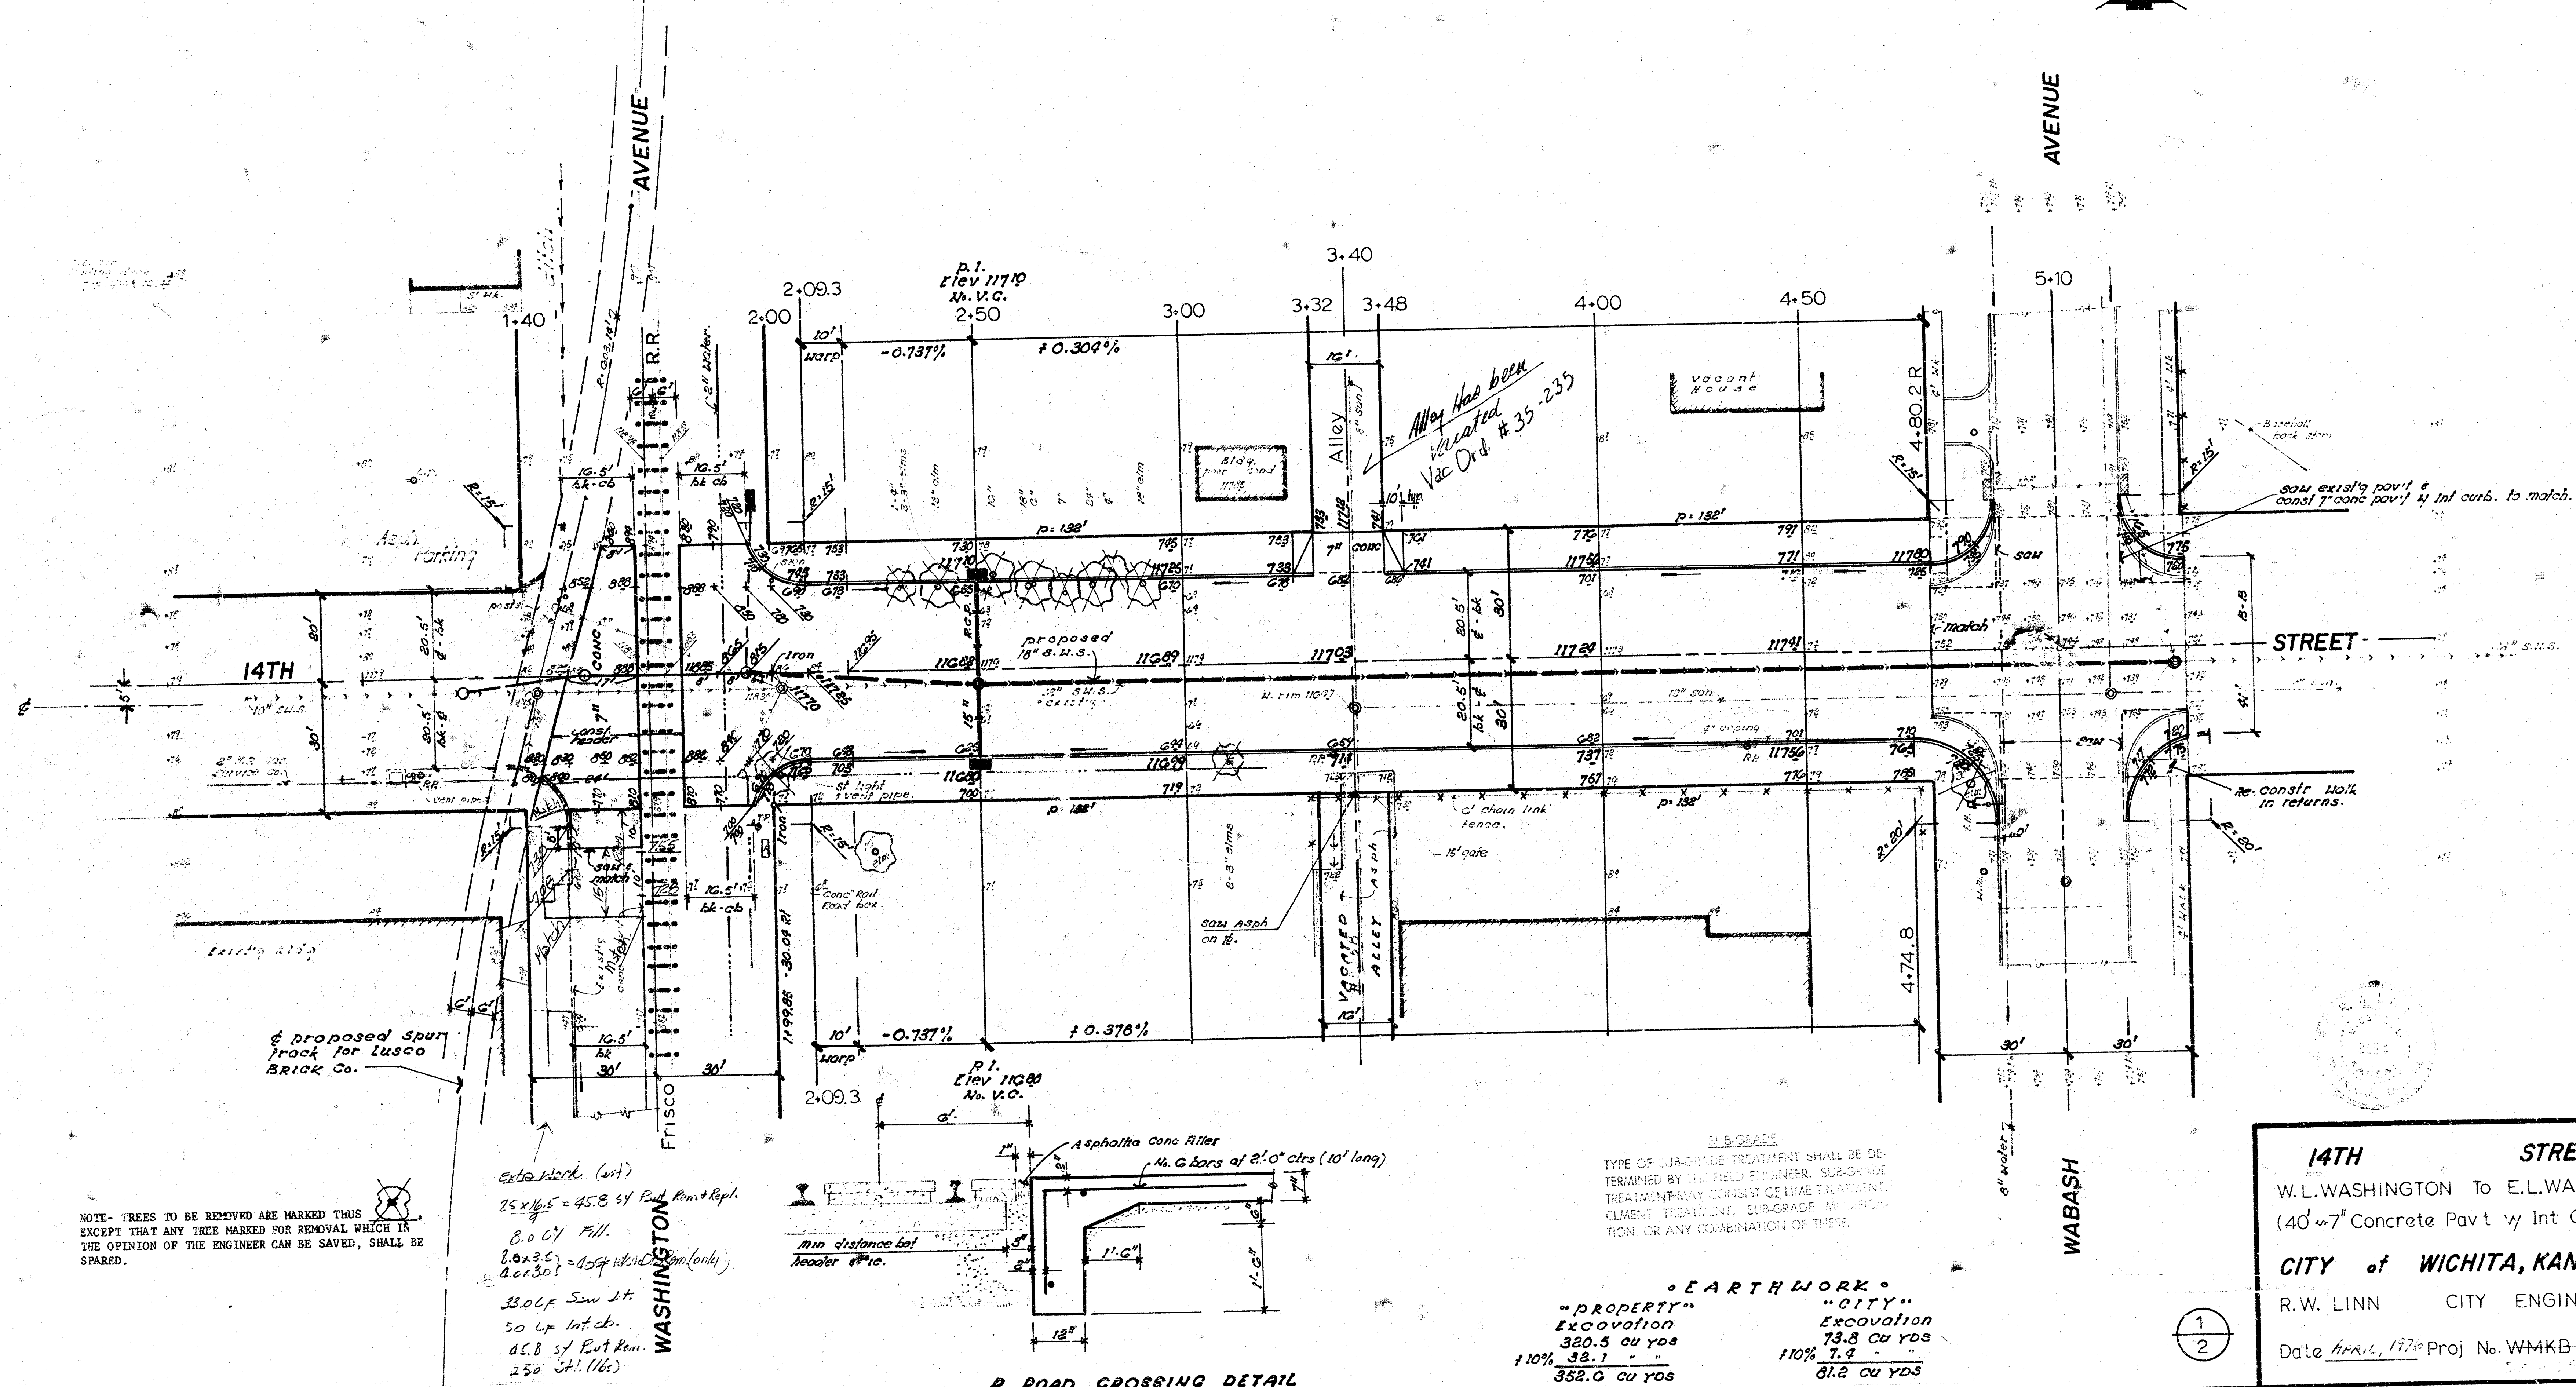

NOTE- TREES TO BE REMOVED ARE MARKED THUS
EXCEPT THAT ANY TREE MARKED FOR REMOVAL WHICH IN
THE OPINION OF THE ENGINEER CAN BE SAVED, SHALL BE
SPARED.

Extra Work (est)
25 x 16.5 = 412.5 sq ft. Rem't Rpt.
8.0 cu yd. Fill.
2.0 x 3.5 = 7.0 sq ft. (est.)
2.0 x 3.0 = 6.0 sq ft. (est.)
33.0 cu yd. Saw Lt.
50.0 cu yd. Int. ch.
45.8 sq ft. Rem't Rpt.
250 sq ft. (est.)

R. ROAD CROSSING DETAIL
1/2" = 1' Scale

EARTHWORK

PROPERTY	CITY
Excavation	Excavation
320.5 cu yds	13.8 cu yds
110% 32.1 "	110% 1.4 "
352.6 cu yds	15.2 cu yds

14TH STREET
W.L. WASHINGTON To E.L. WABASH
(40' x 7' Concrete Pav't w/ Int Curb)
CITY of WICHITA, KANSAS
R.W. LINN CITY ENGINEER
Date APRIL, 1976 Proj. No. WMKB 533430

1
2

