


ST. 119.17 "X" IN KEELAR 1 BK OF BK OF NW SW COR 15TH & WOODLAND
 ST. 120.50 "X" IN 1926 BK OF NW SW COR 17TH & WOODLAND

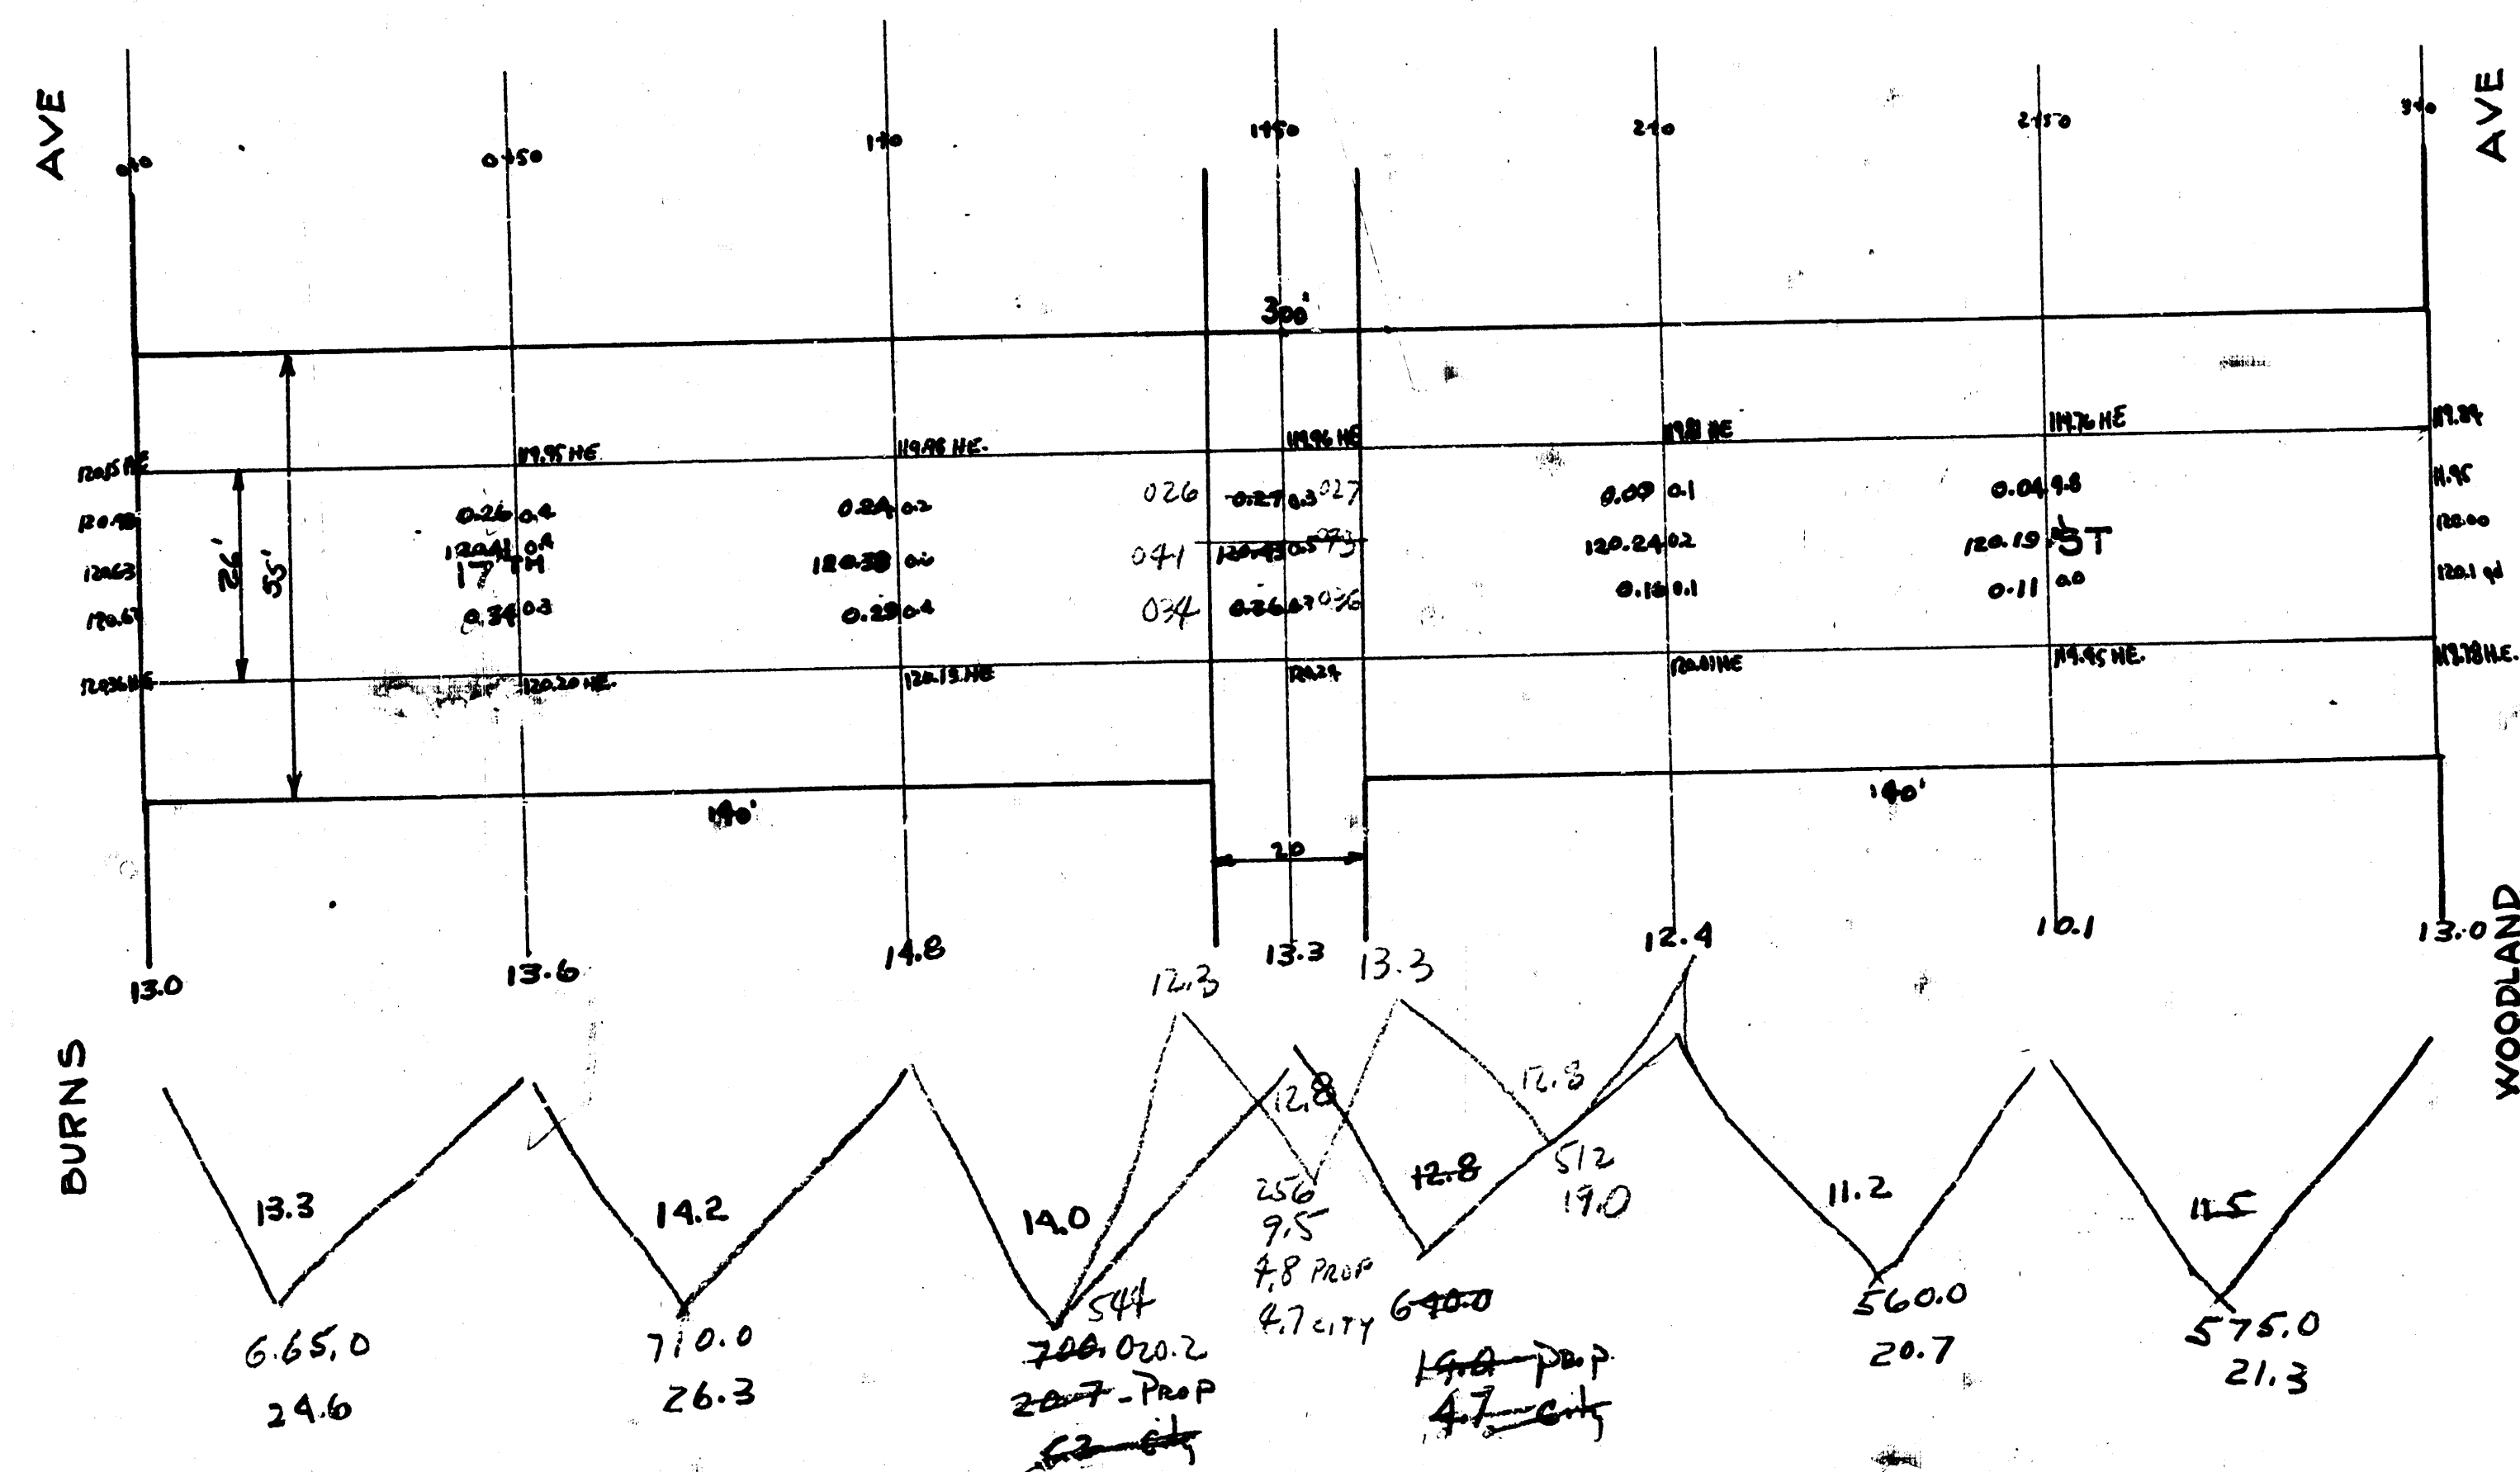

Proposed
 24.6
 26.3
 19.0
 20.7
 21.3
 Total 132.6

CH
 52
 4.7
 Total 9.9

17TH ST
 EL BURNS TO WL WOODLAND
 26' CONCRETE
 CITY of WICHITA, KANSAS
 LK WHITE CITY ENGINEER
 APRIL 1947

