


B.M. 118.90 K in Keeler & Wk. S. N.W. Cor 17th & Mosley
 B.M. 119.04 M in Moore & Wk. E. N.E. 17th & Washington
 B.M. 119.19 M in Moore & Wk. E. N.E. 17th & Webster
 B.M. 119.00 S.E. Cor Int D Endowment S.E. 17th & Ohio
 B.M. 122.90 N.W. Cor SW Wing W.S. Bridge 17th & Canal D in Corp. Wk.

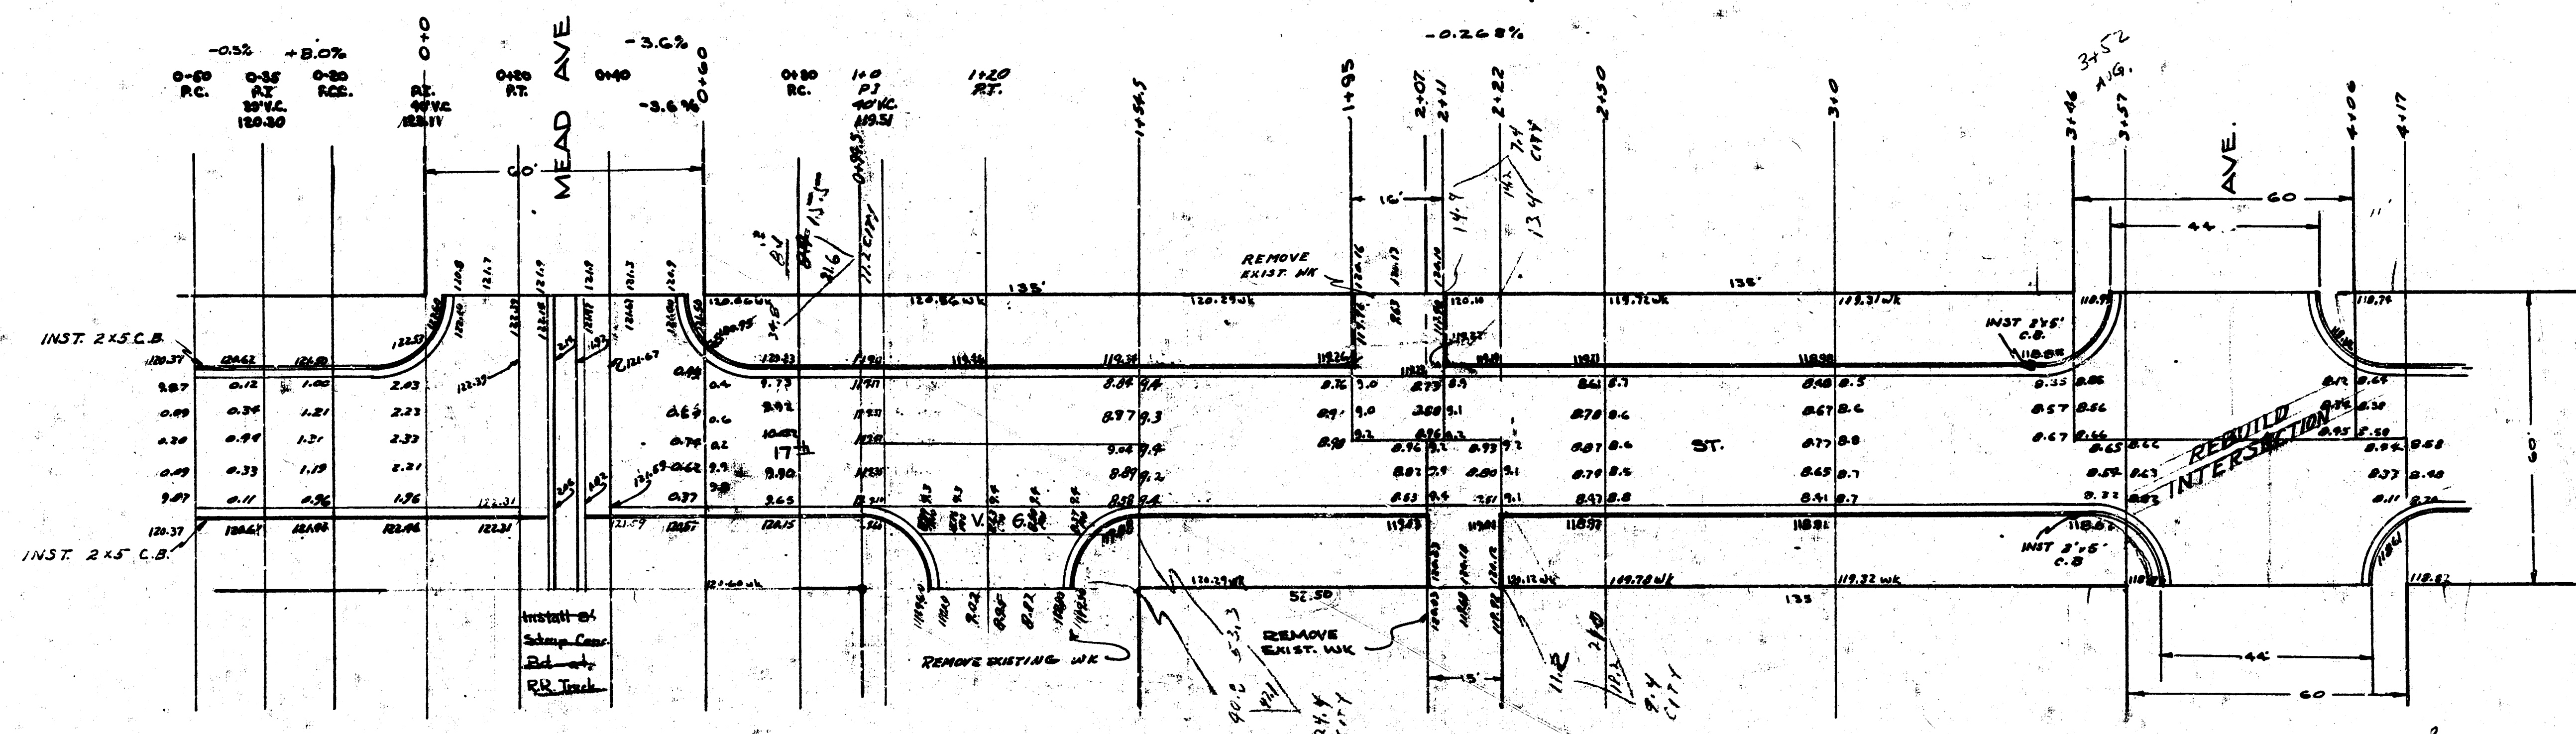


Notes:
 Existing P.V. from RR. to 0+50 to be removed & replaced as shown on plan.


Notes:
 At 0+00 Begin to Raise P.V. Line so that At 0+20 P.V. & Cb. Grade are Same. At 0+40 Begin to Lower P.V. Line so that At 0+60 P.V. is Normal.

17th St


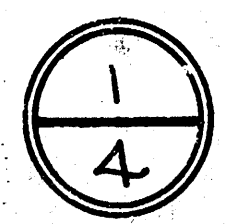


17th St
 W.L. MEAD & W.L. CANAL
 CITY OF WICHITA, KANS.
 26-2-30 ASPHALTIC CONCRETE
 LK WHITE - CITY ENGINEER
 FEB. 1947

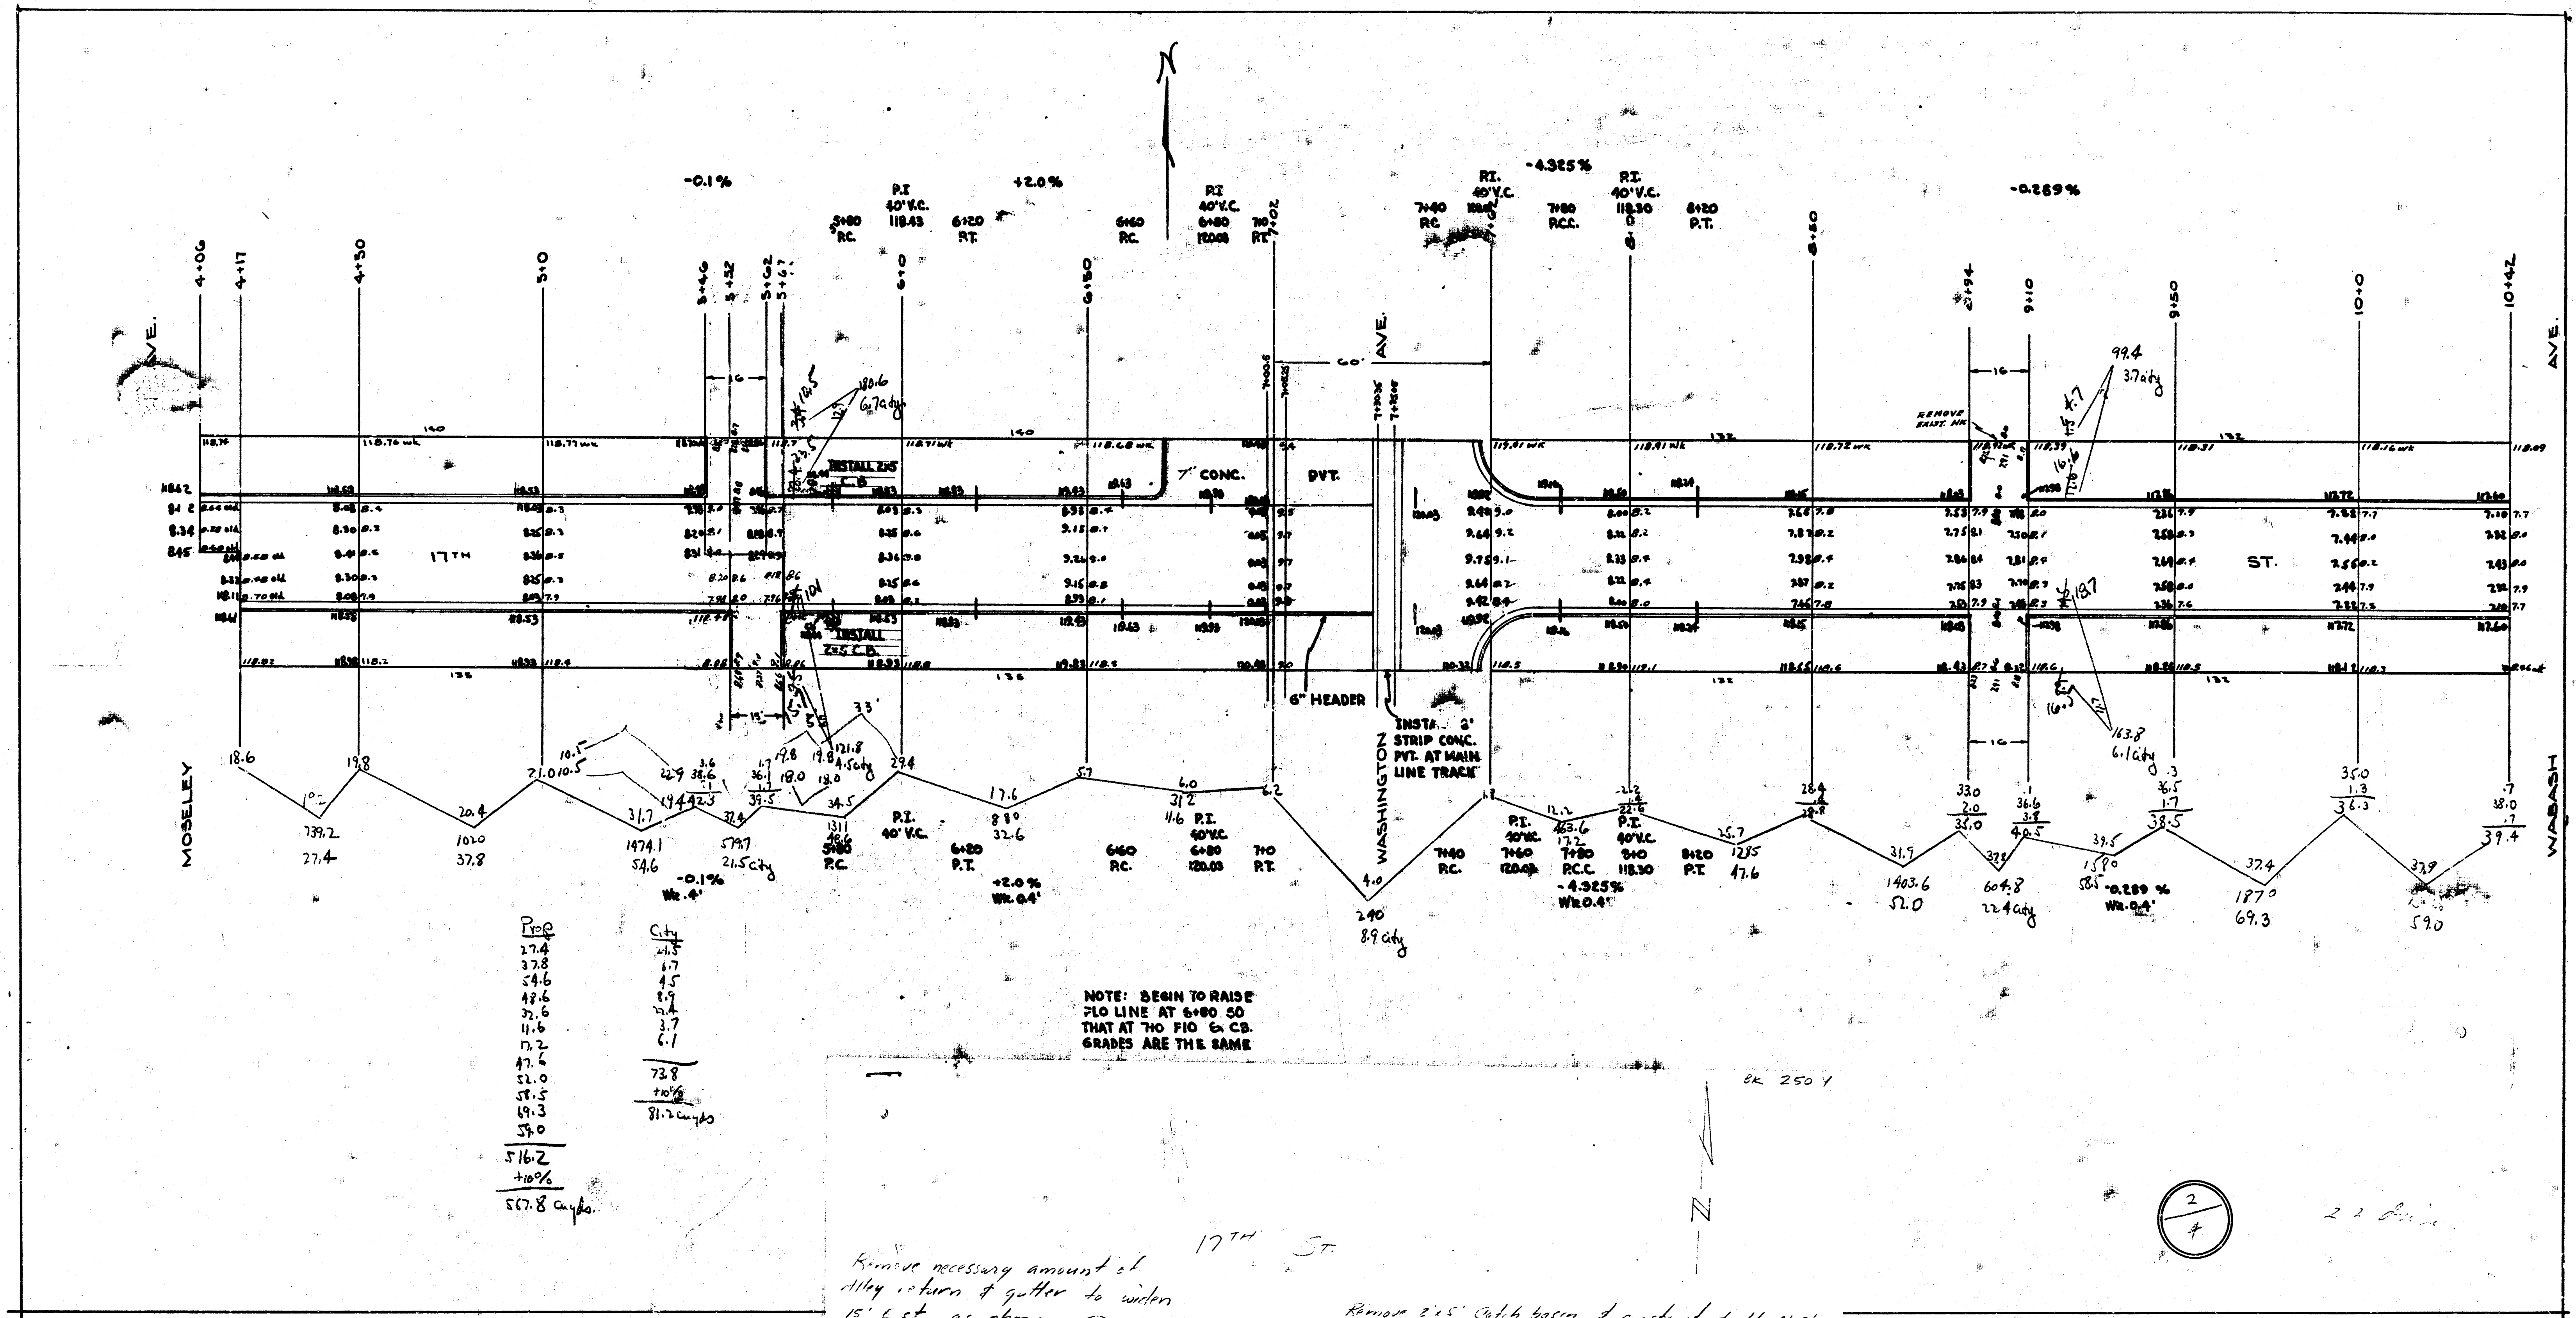


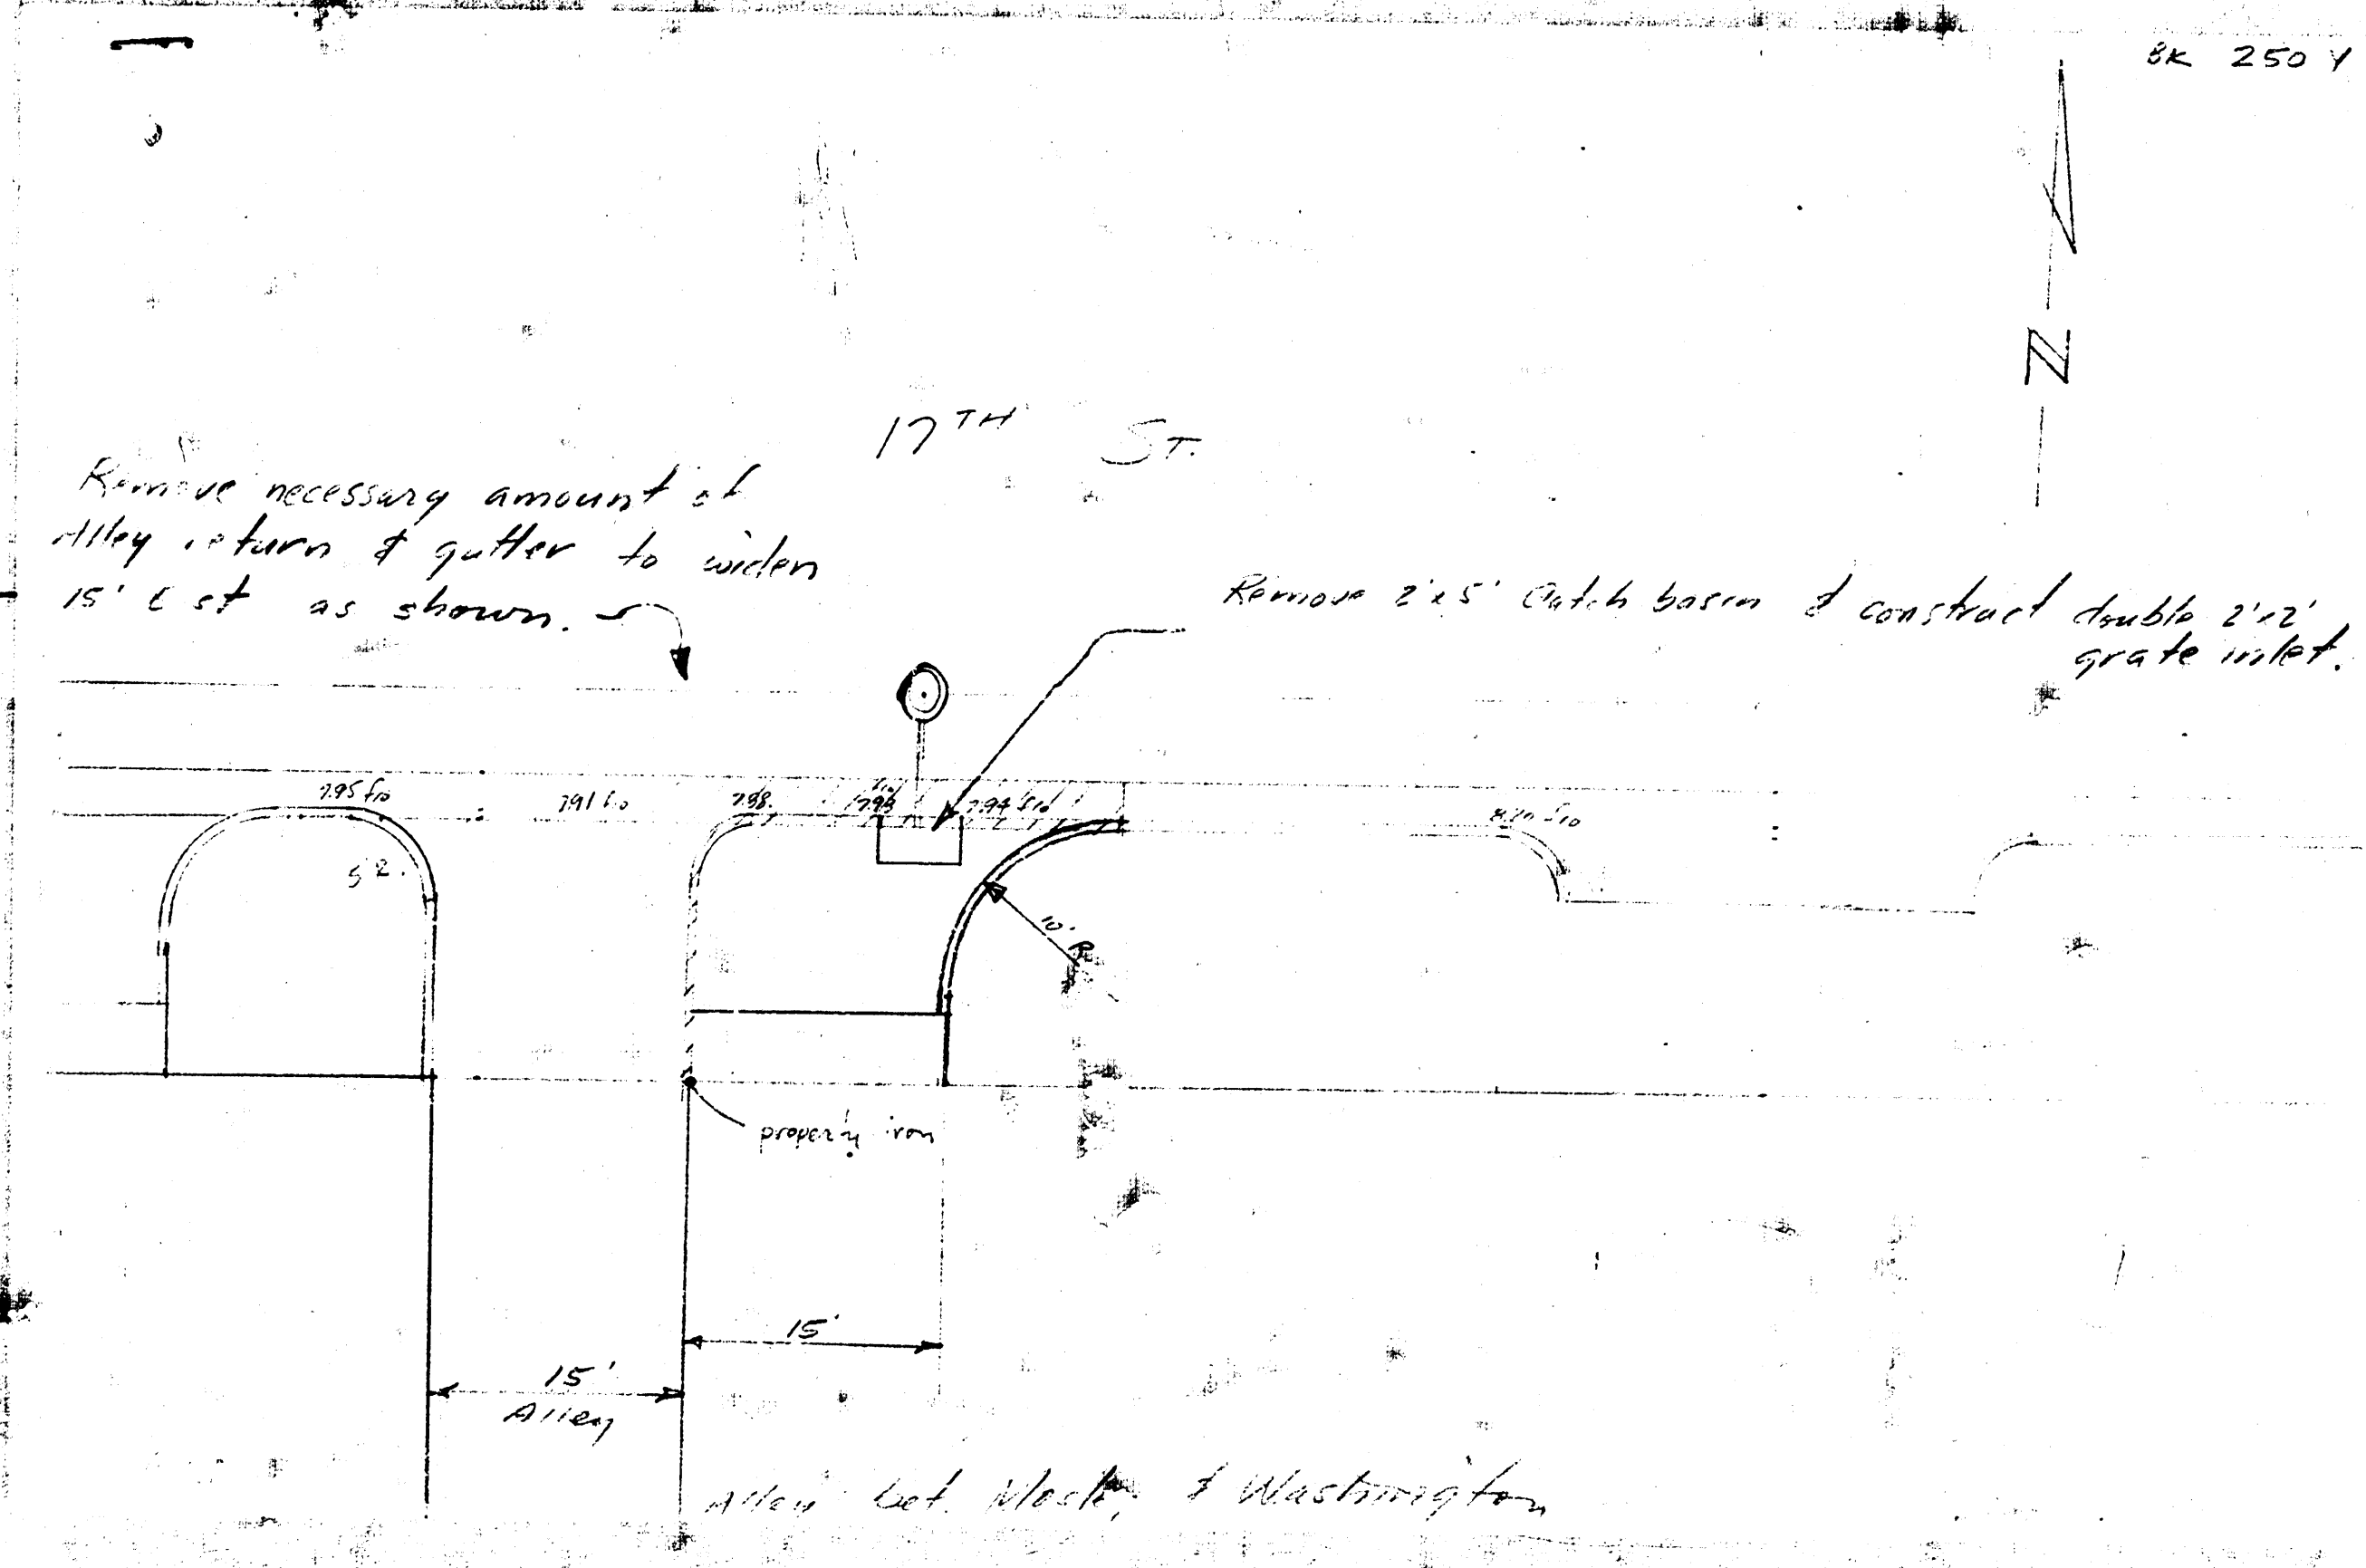

2

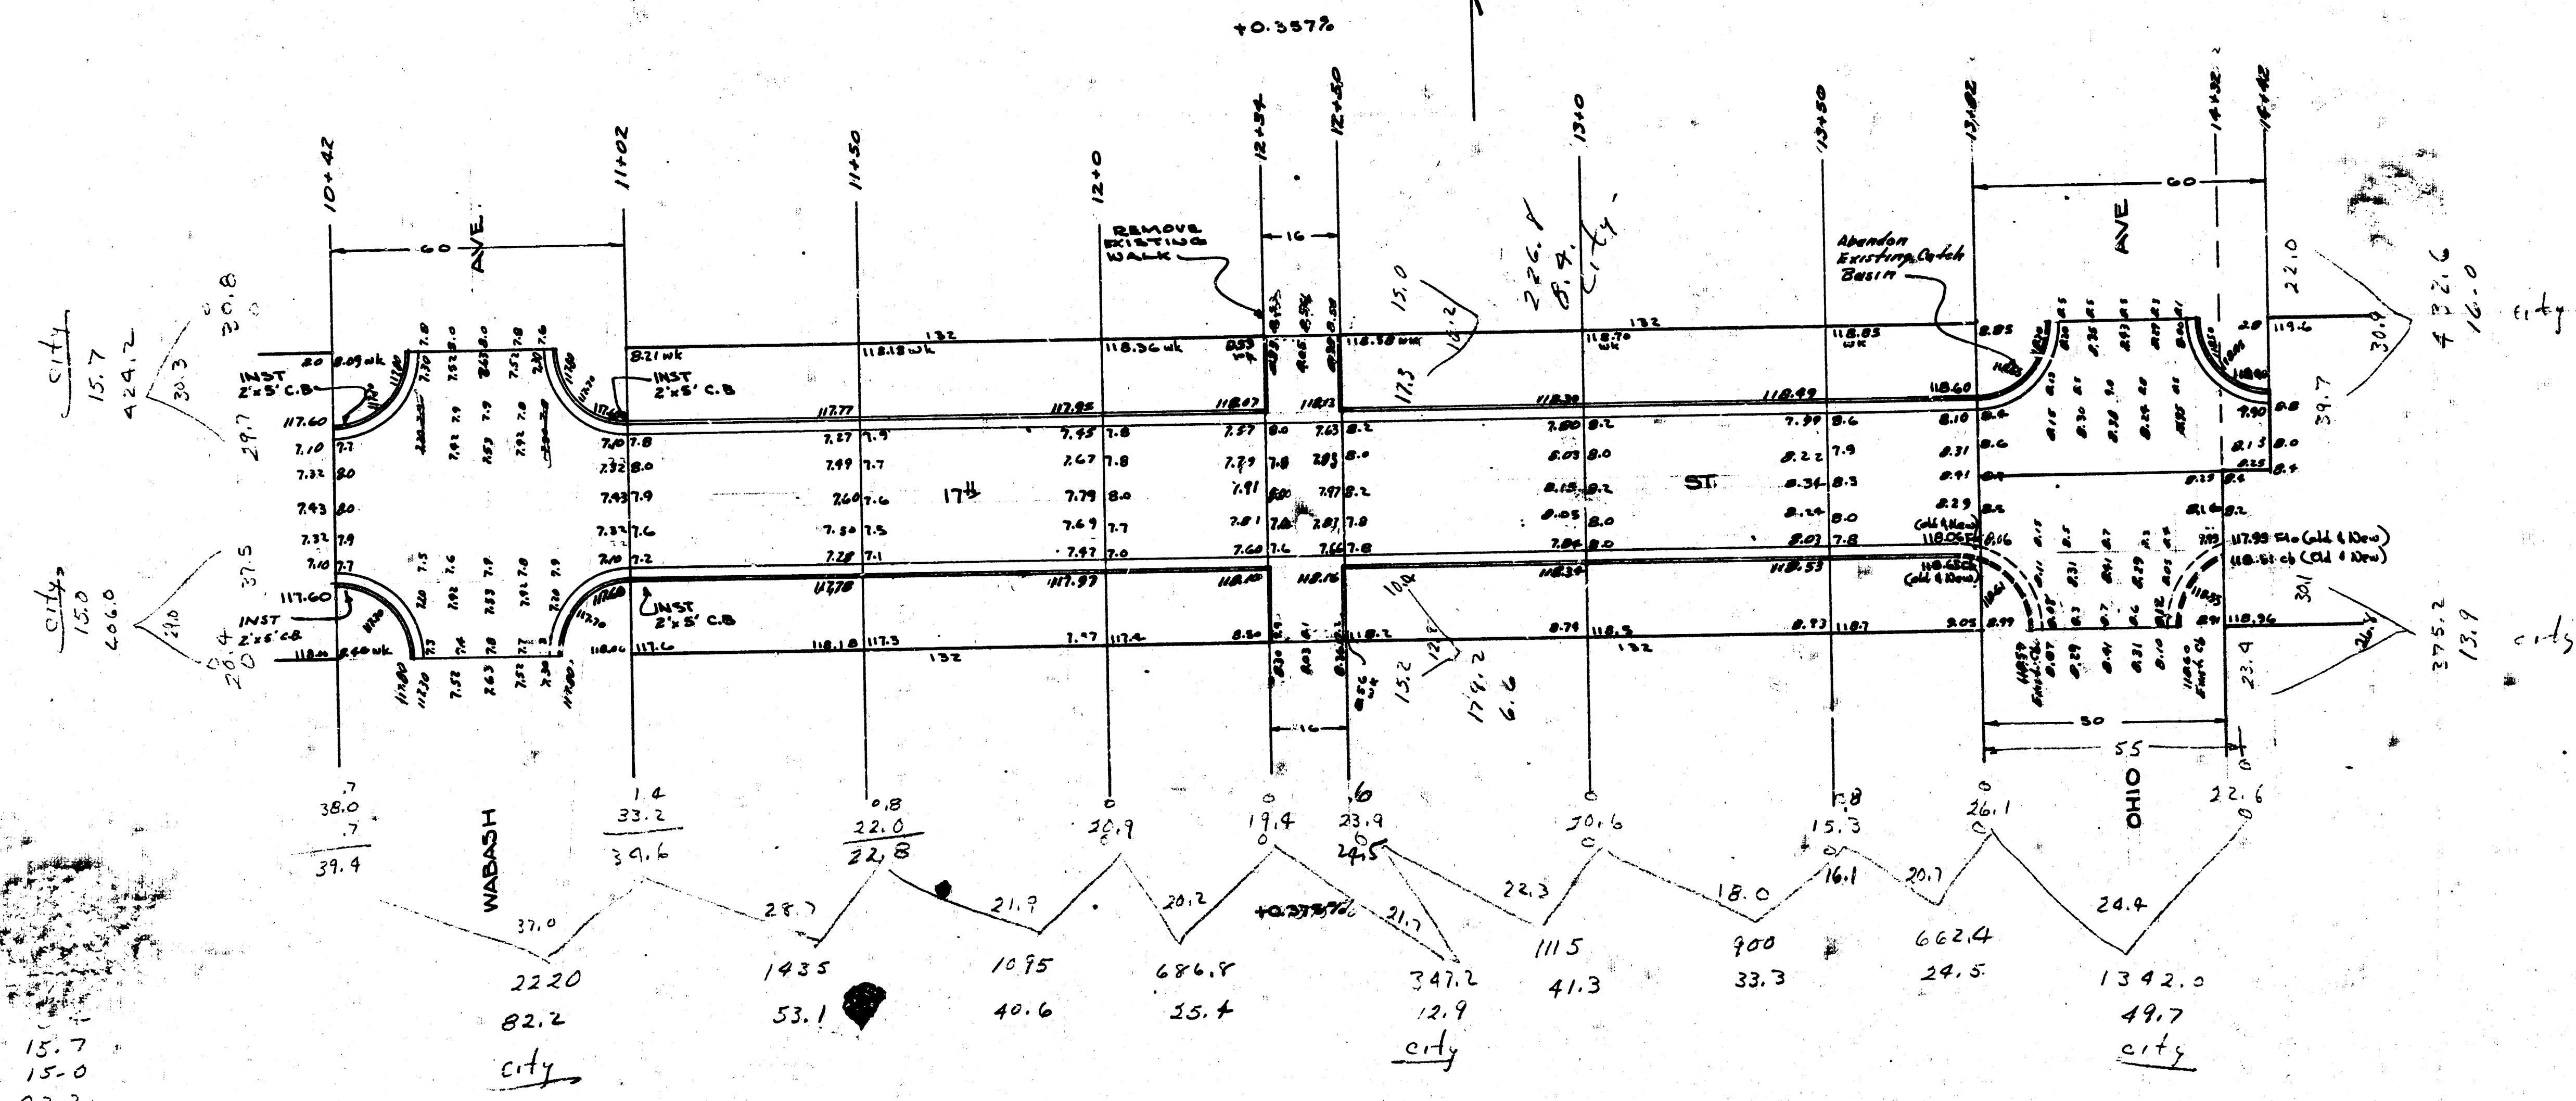

15.7
 15.0
 82.2
 12.9
 41.7
 13.7
 16.0

 220.4
 220.4
 220.4

+ Prop.
 53.1
 40.6
 25.9
 41.3
 33.3
 24.5

 218.2 cu yds.
 21.8
 239.0

3
 4

