



B.M. 12454 C. in Center S.S. of Bldg. S.W. Cor. Park Place & 22nd

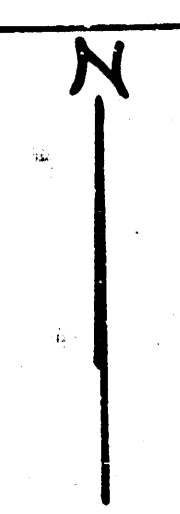

Prop
29.4
29.8
25.1
35.0
14.1
46.4
48.0
10.6
40.0
38.5
393.6
+10.92
433.0 cu yds

Cut
9.4
9.1
11.8
6.1
7.7
7.6
53.9
18.0
11.2
152.9
+10.92
163.8 cu yds

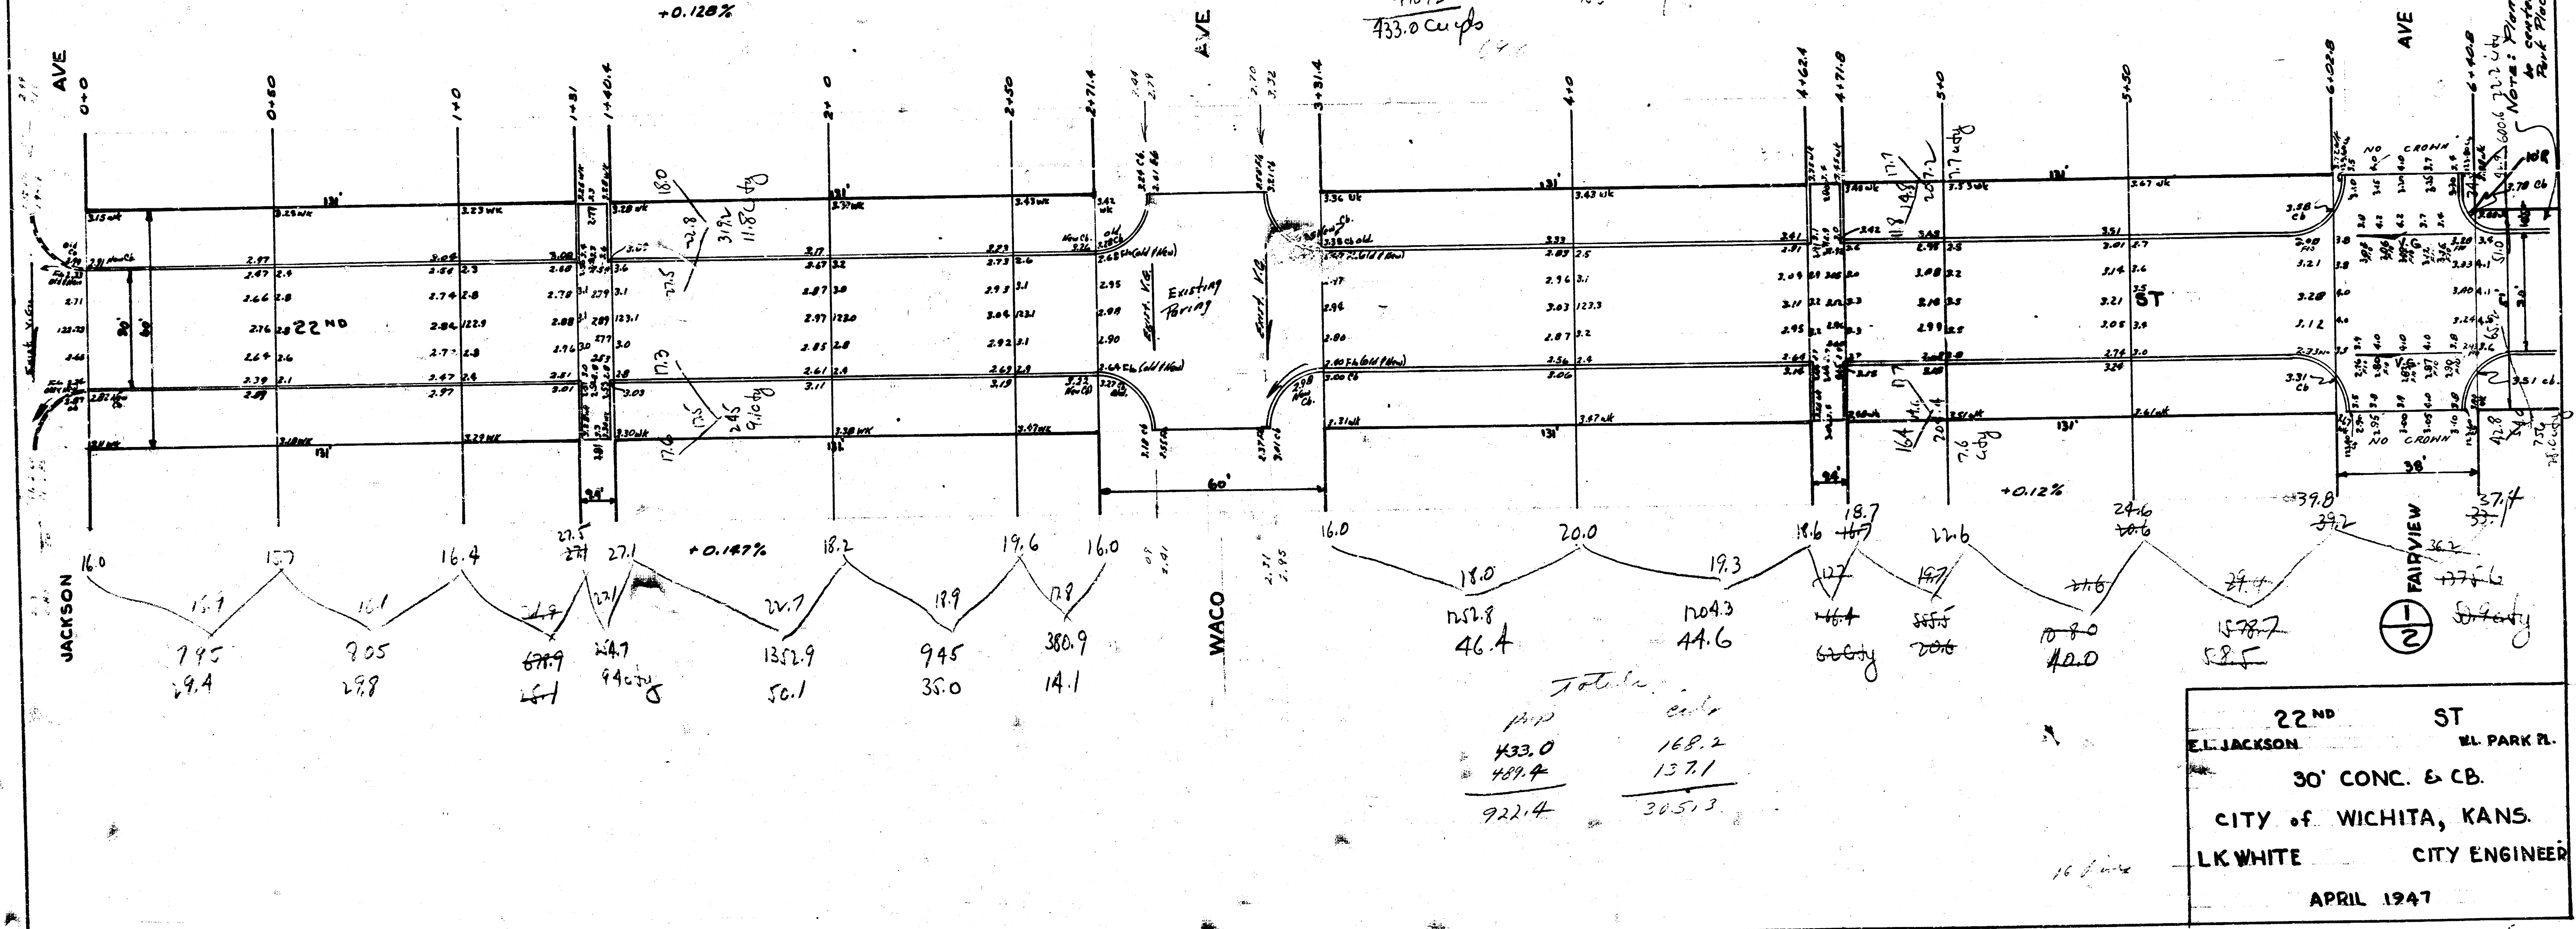


Note: Plan is drawn to show proposed street layout. Elevation of ground is shown on 31' B.M. reference to Park Place.

B.M. 124.54 C.M. Carter S.S. 11 Bt 341 Cor. Park Place & 22nd

NOTE:

PLAN IN ERROR - PAVEMENT IS TO BE
CENTERED ON S.I. R/W.

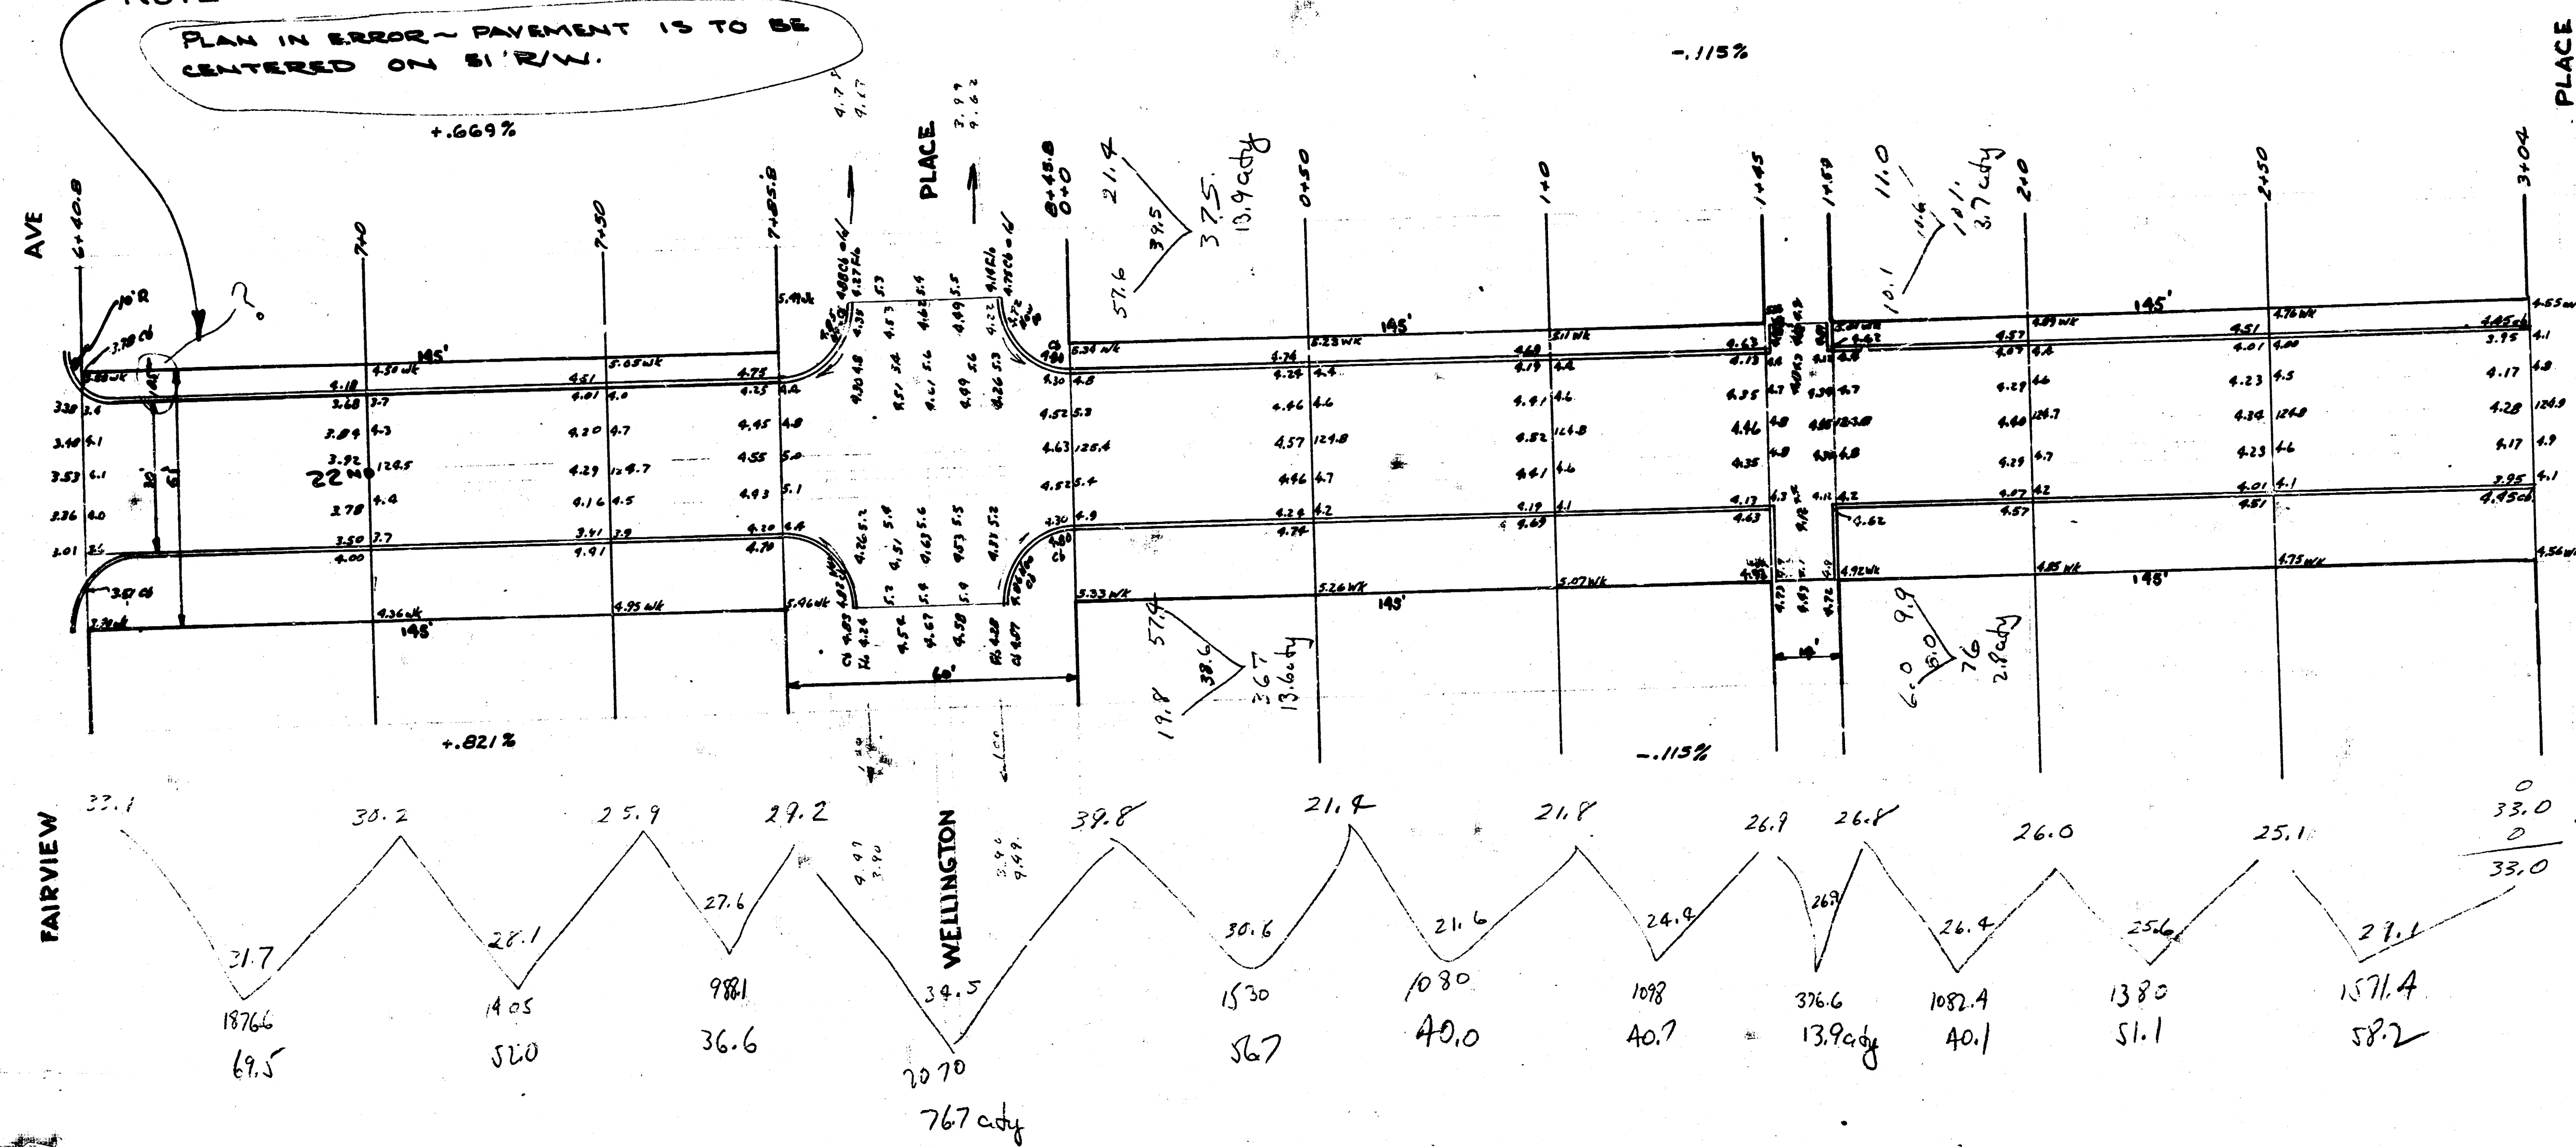

PAGE	CH
61.5	76.7
51.0	13.9
36.6	13.6
36.7	13.9
40.0	2.8
40.7	5.7
40.1	124.6
51.1	710.6
58.2	137.1 w/pts
444.9	
710.6	
489.4 w/pts	

2/2

101 (12)