
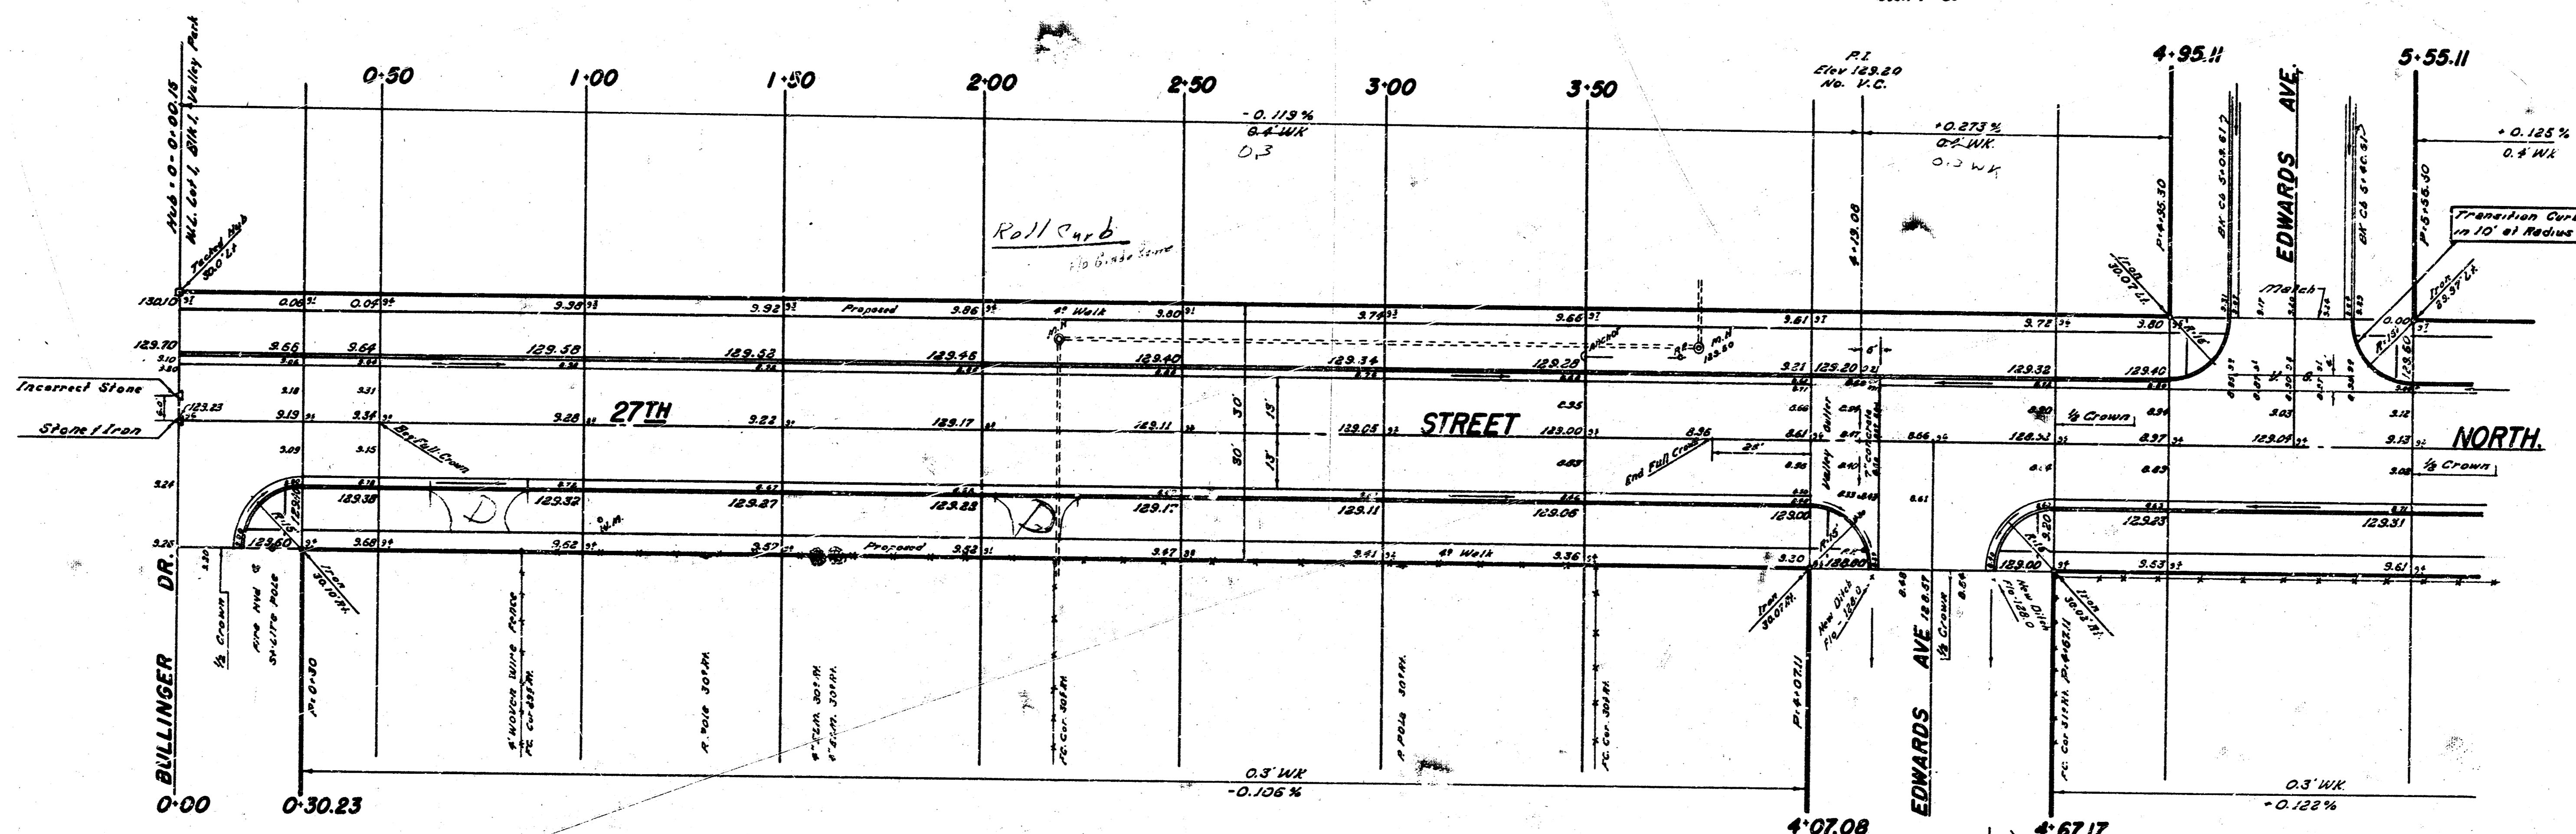


park

B.M. 130.07 R.R. Spike E.S. Guy pole on W.S. Bullinger at S.L. 27th East.

BASE LINE is on Center Line

Line to Stake 1-102
 5.6' N. to E. Steel Fence West
 23.9' N.W. to 2nd Steel Post
 22.9' N.W. to Steel Cor. Post.

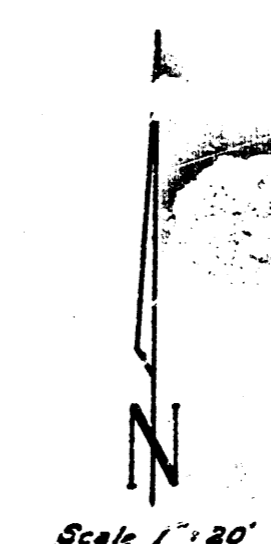

Surveyed by
 B. BRZEZY
 Plotted by
 J. ELLIOTT
 Checked by
 J. ELLIOTT

NOTE To FIELD ENGINEER and CONTRACTOR
 Grade Parking and Clear Right of Way
 for Proposed SideWalk. COMPACT BACK FILL IN
 SIDEWALK AREA.
 SideWalk to be Constructed by Others.

CITY	
Excavation	183.7 Cu Yards
+10% 18.4	-
Total	202.1 Cu Yards

PROPERTY	
Excavation	650.3 Cu Yards
+10% 65.0	-
Total	715.3 Cu Yards

Comp. Fill	
	32.8 Cu Yards
+10% 3.3	-
Total	36.1 Cu Yards

Grade existing ditches and roadway to new elevations. Adjust entrance pipes to new grades if necessary.

27TH STREET NORTH.
 From: W.L. lot 1, Blk 1, Valley Park Addition.
 To: E.L. lot 11, Blk 3, Valley Park Addition.
26'-2'-30' ASPHALTIC-CONC
 CITY OF WICHITA, KANSAS
 B. E. SMITH CITY ENGINEER
 Date: JUNE 1966 Proj No. C16-9

