


Glantz JF6112
D.C.B.
D.C.B.

P.I
Elev 97.33
No H.C

303101720

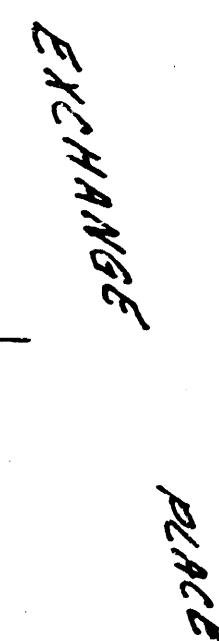

CREW!

$\frac{1}{2}$