


B.M. 98.04 Standard S.W. Cor. 27th & Glenn.

Stationing on S.R.

Drawn by S.E. BR 625
 C.E. JAZ
 Checked

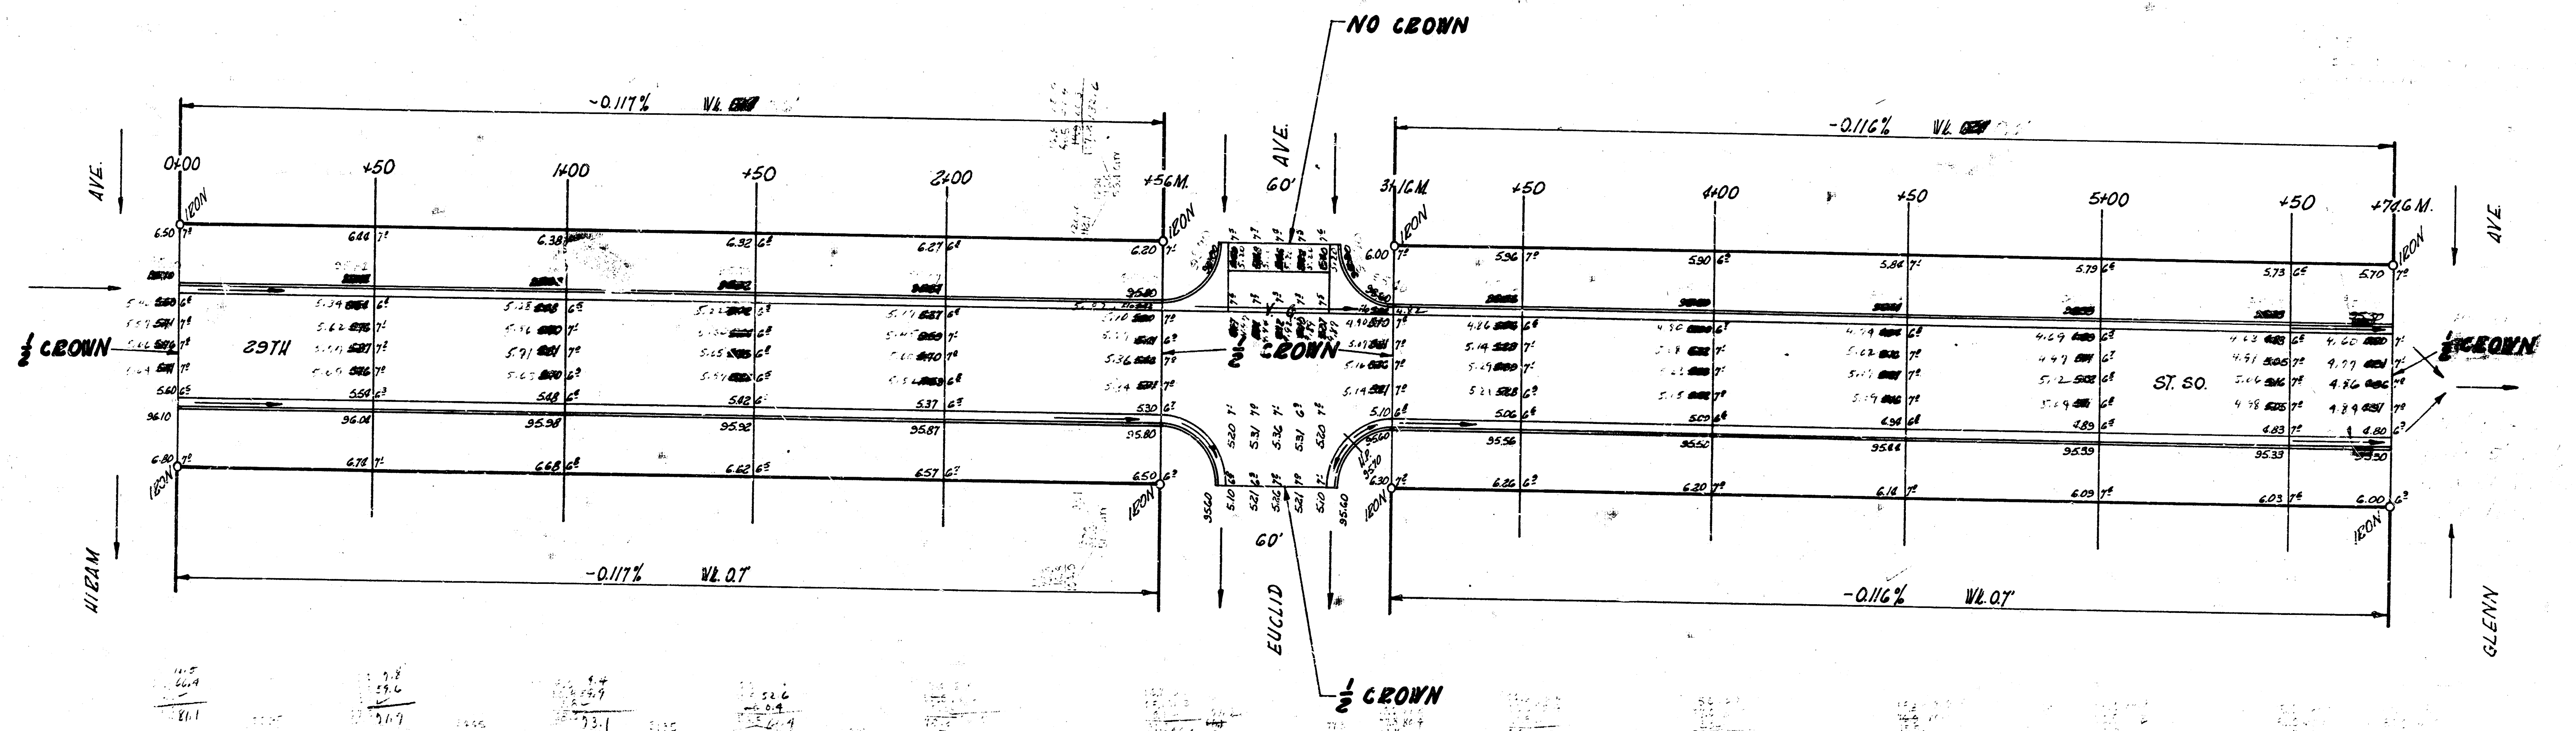

29TH ST. 50
 E.L. WIZAM - W.L. GLENN
 26'-2'-30" A.C.
 CITY OF WICHITA, KANS.
 B.E. SMITH CITY ENGINEER
 JULY, 1954 PROJ. NO. C14-296

