
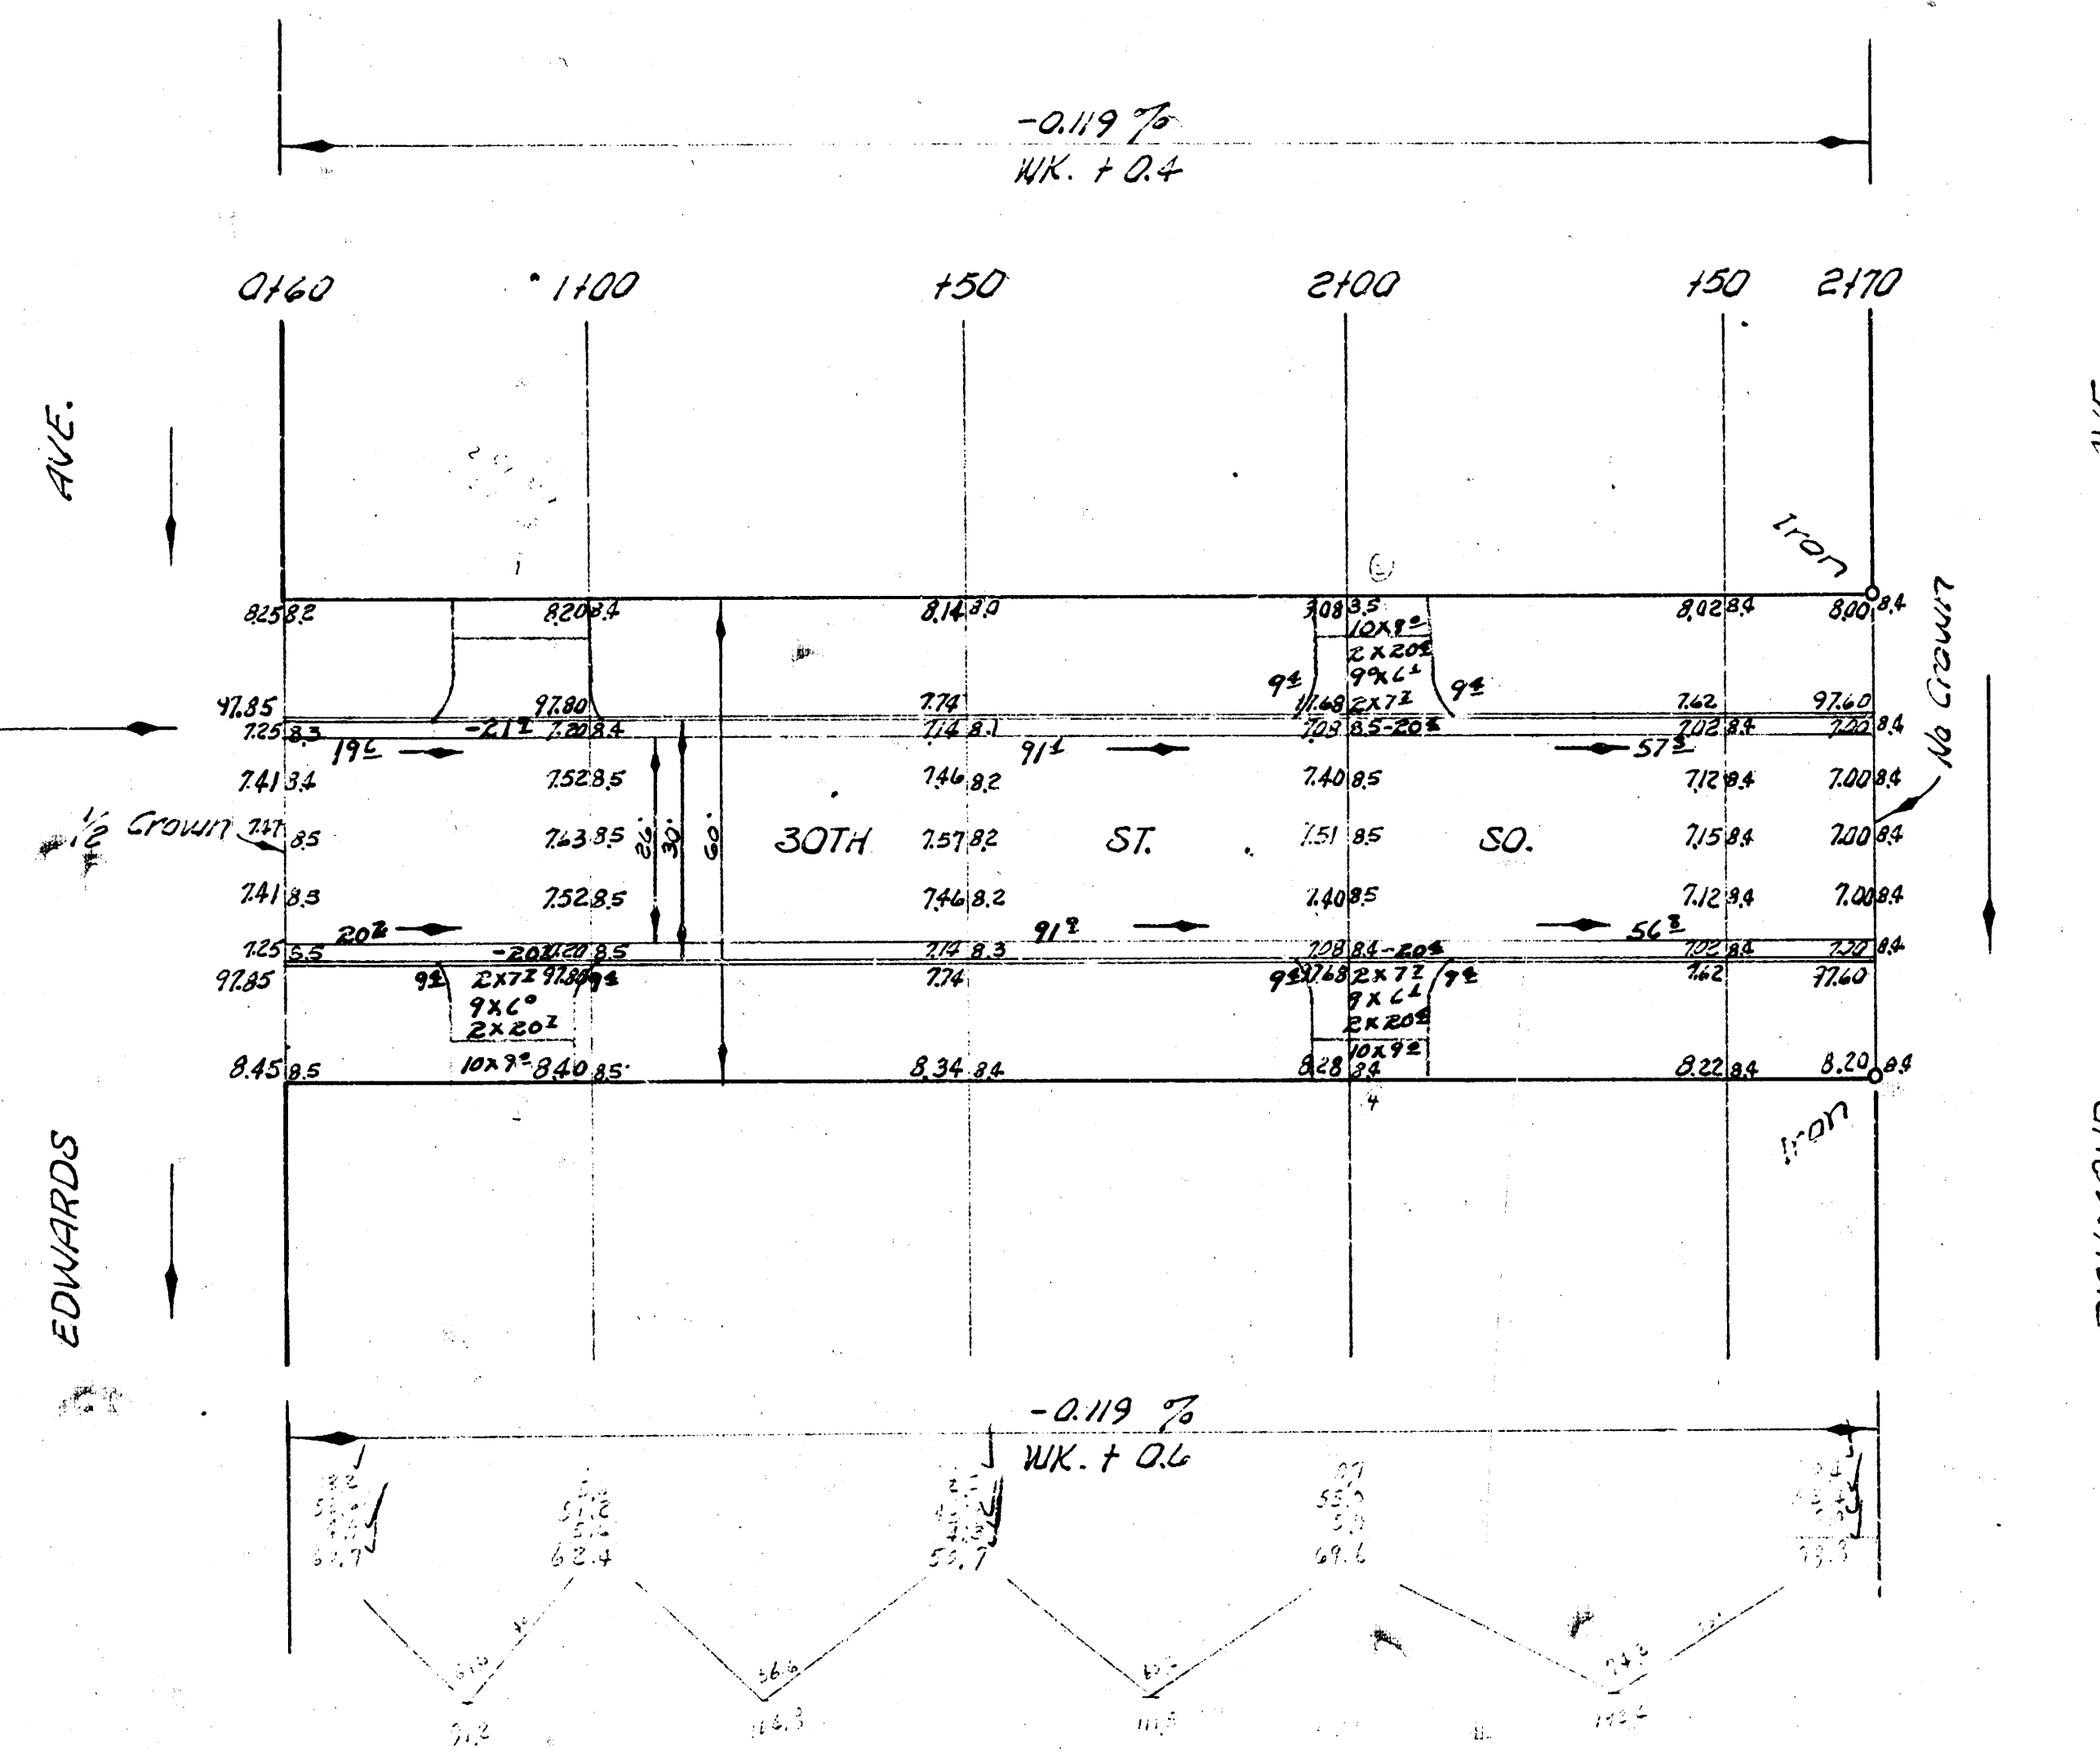




B. M. 97.605 U. S. G. S. Standard SW 1st of Meridian
Stationing and base line on North 12.

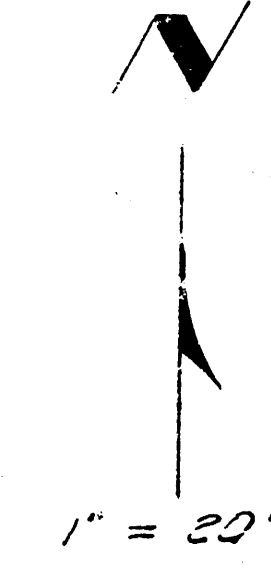

ESTIMATE OF QUANTITIES			
QUANTITY	UNIT	ITEM	FINAL
2345.8	Sq. Yd.	Asphalt CONC.	2345.8
1545.7	Lin. Ft.	Comb. ch. & gtr.	1134.8
6382.8	Lbs.	Reinf. Steel	6470
1809.6	Cu. Yds.	Excavation	1845.8
	Sq. Ft.	GUTTER	
	Sq. Ft.	6" DRIVE	

NOTE TO CONTRACTOR
This sheet will be furnished under the supervision of the CITY ENGINEER and conforming to the SPECIFICATIONS of the CITY OF WICHITA. The CONTRACTOR will reimburse the City of Wichita for all cost of Engineering, Plans, and Inspection.

EARTH WORK
EXCAVATION
1809.6 Cu. Yds.

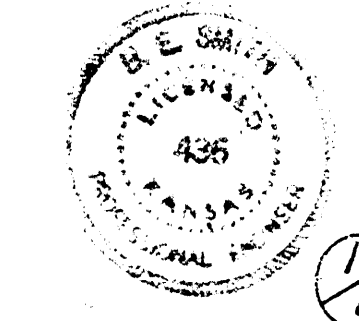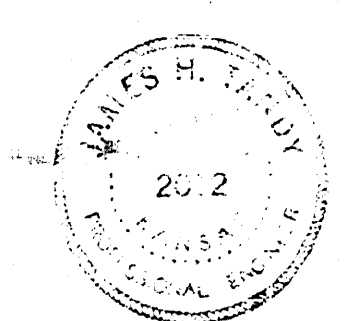

30TH ST. SO.
EL EDWARDS TO WL MERIDIAN
26' - 2' - 30' A.C.
CITY OF WICHITA, KANSAS
B. E. SMITH CITY ENGINEER
PRIVATE CONTRACT

B. M. 97605 U. S. G. S. Standard SW 1st of Meridian.
 Stationing and base line on South R.

