
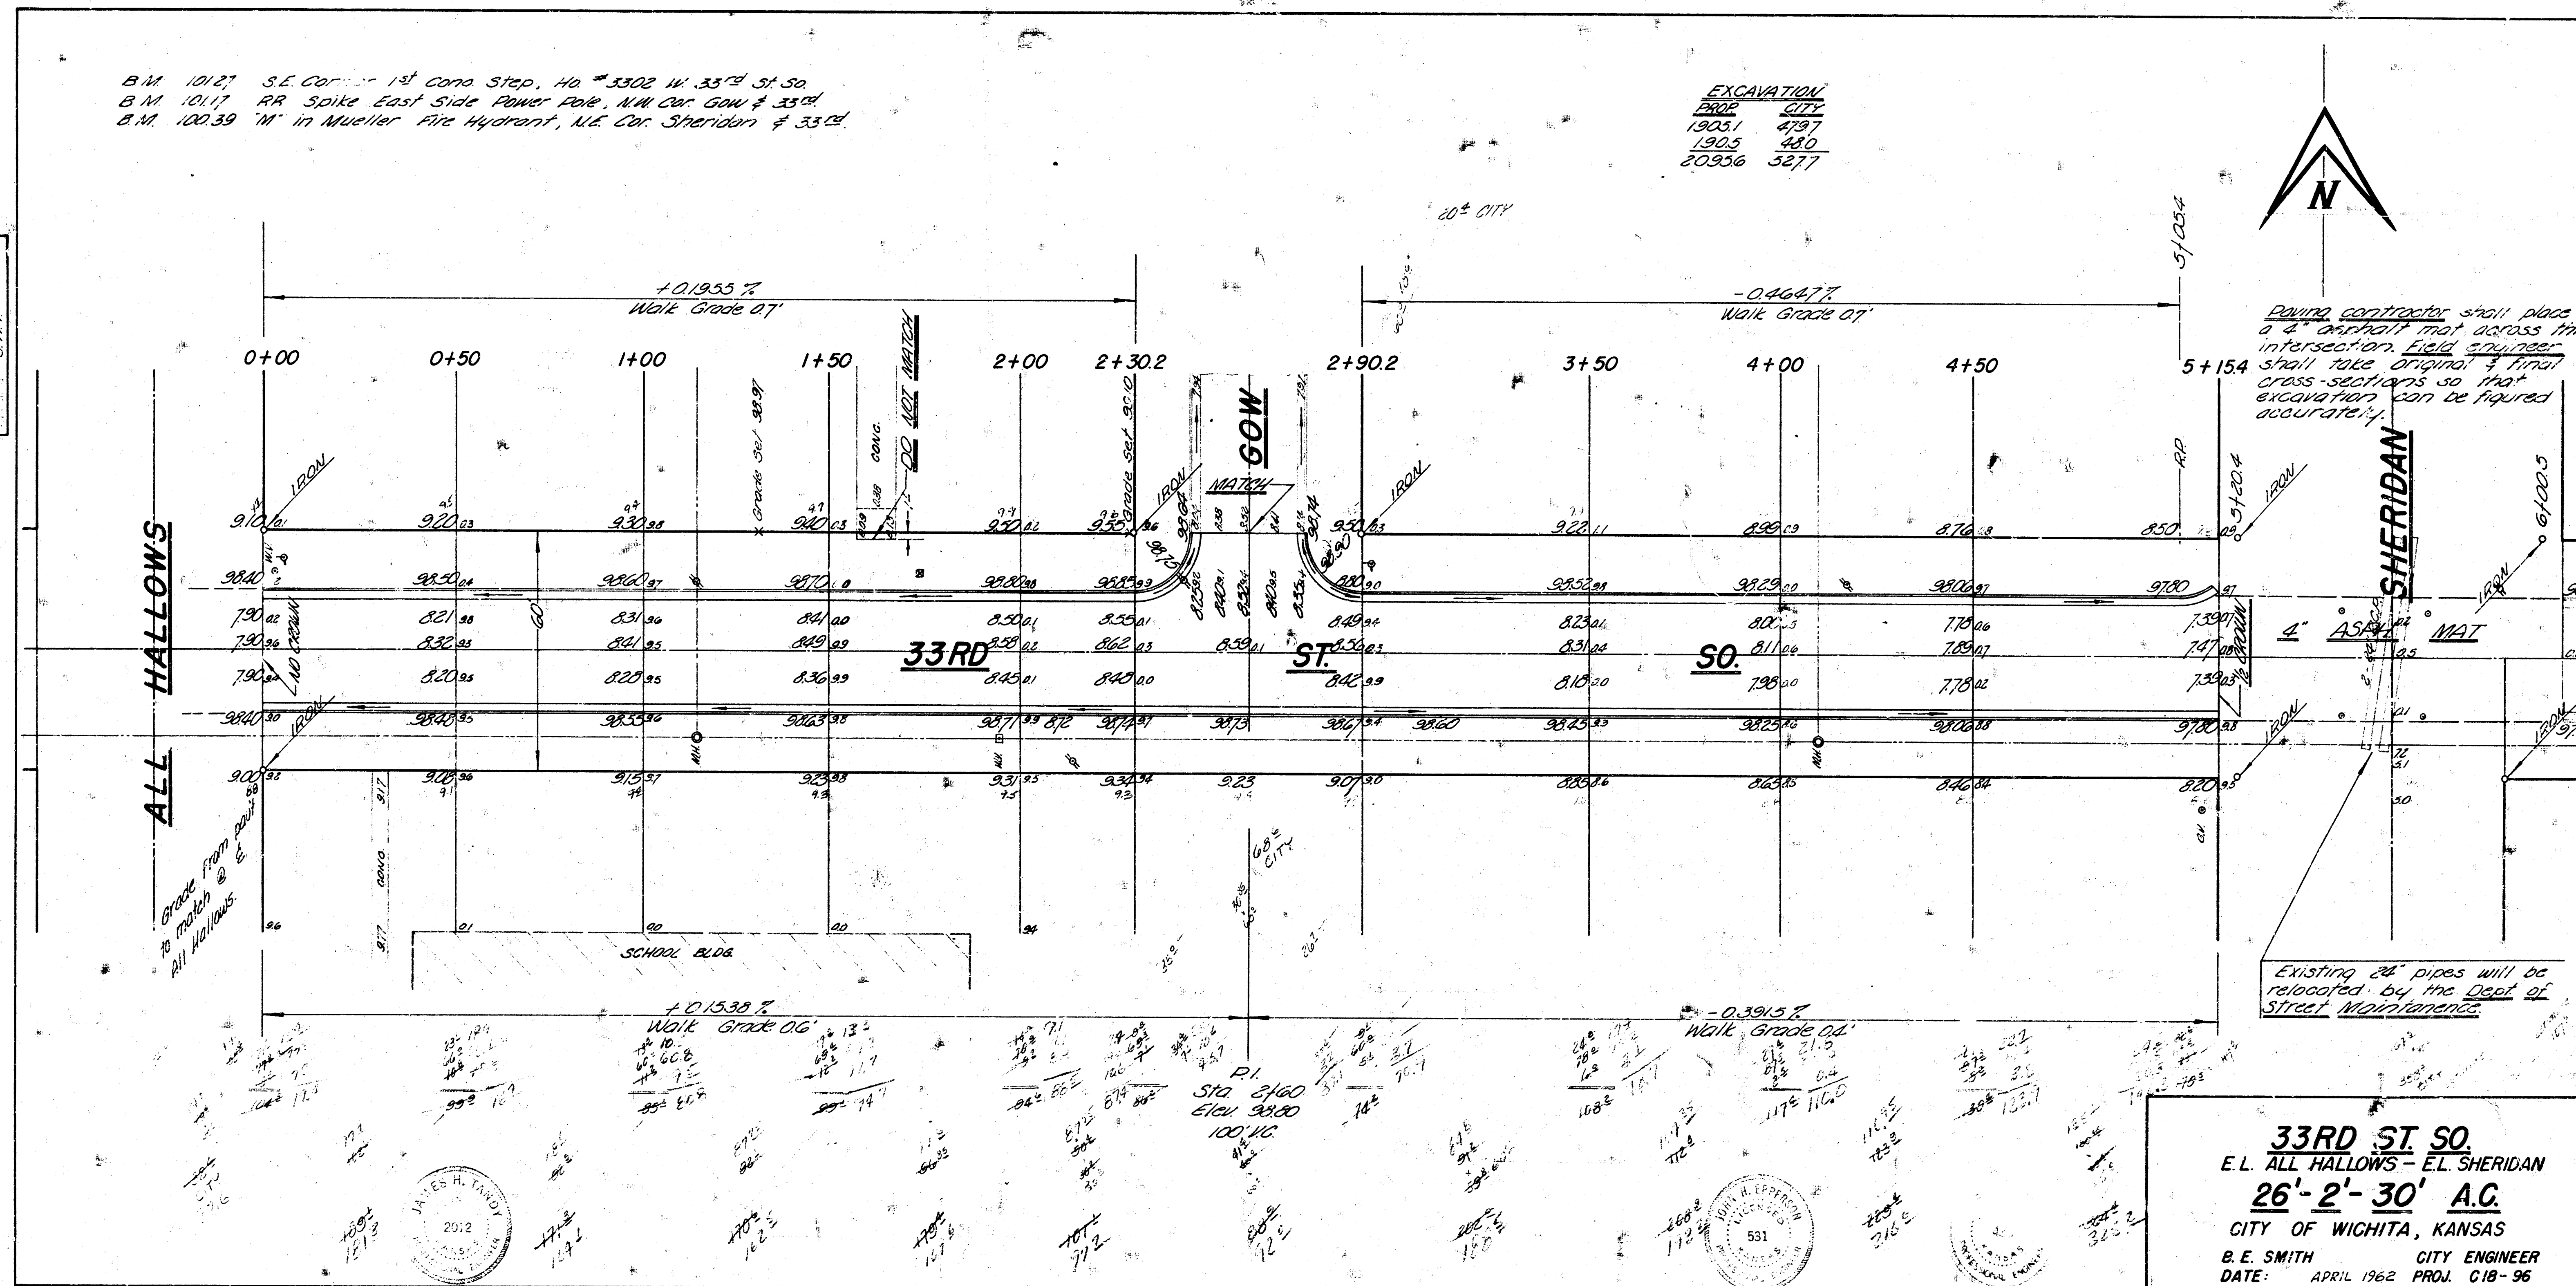


B.M. 10127 S.E. Cor. 1st Cond. Stp. 40' x 3302 W. 33rd St. 50
 B.M. 10117 RR Spike East Side Power Pole, NW Cor. GOW # 33rd
 B.M. 10039 'M' in Mueller Fire Hydrant, N.E. Cor. Sheridan # 33rd


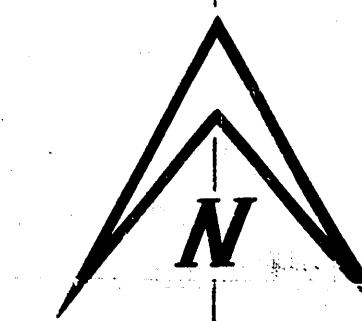

33RD ST. SO.
 E.L. ALL HALLOWS - E.L. SHERIDAN
26'-2'-30' A.C.
 CITY OF WICHITA, KANSAS
 B. E. SMITH CITY ENGINEER
 DATE: APRIL 1962 PROJ. C18-96