B.M. #1 95.36 N.W. Cor. Concrete Po. House on S.E. Corner Gold & 33rd St.
B.M. #2 96.20 N.W. Corner Conc. Po. No. 407 W. 33rd St.
B.M. #3 96.74 N.W. Corner Concrete Po. No. 301 33rd St.

Chaining from W. to E. on S. P.L.

EXCAV.
Prop. 1003.2 Cu.Yd.
City 529.0 Cu.Yd.

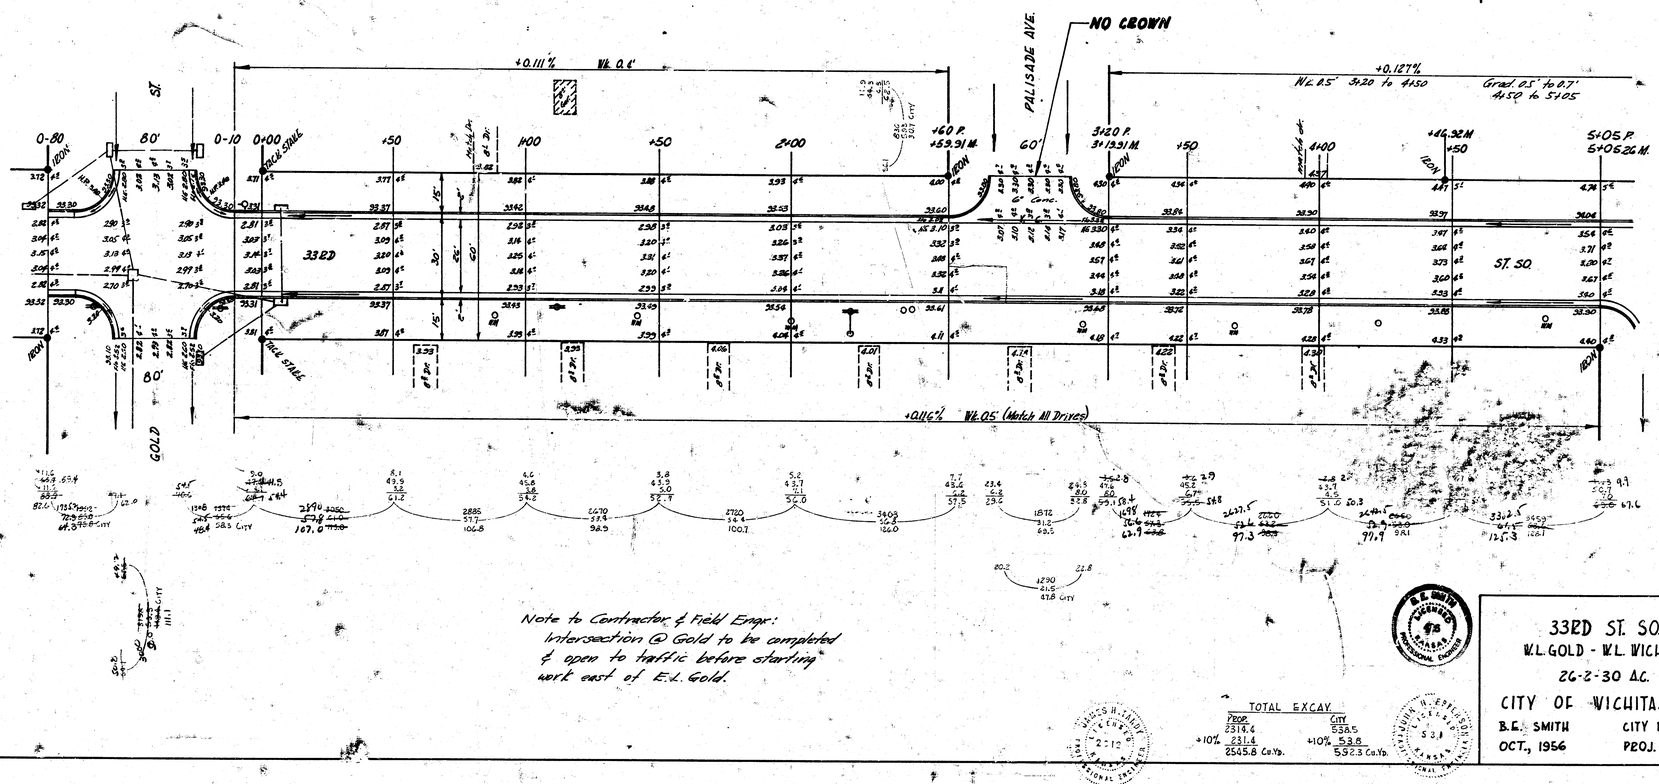

Note to Contractor & Field Engr:
Intersection @ Gold to be completed & open to traffic before starting work east of E.L. Gold.

TOTAL EXCAV.

Prop.	City
2314.4	538.5
+10% 231.4	+10% 53.8
2545.8 Cu.Yd.	592.3 Cu.Yd.

1/2

33RD ST. SO.
W.L. GOLD - W.L. WICHITA
26-2-30 A.C.
CITY OF WICHITA, KANS.
B.E. SMITH — CITY ENGINEER
OCT., 1956 — PROJ. NO. C14-75

EXCAV.
PROP. 1311.2 Cu.Yds.
CITY 2095 Cu.Yds.

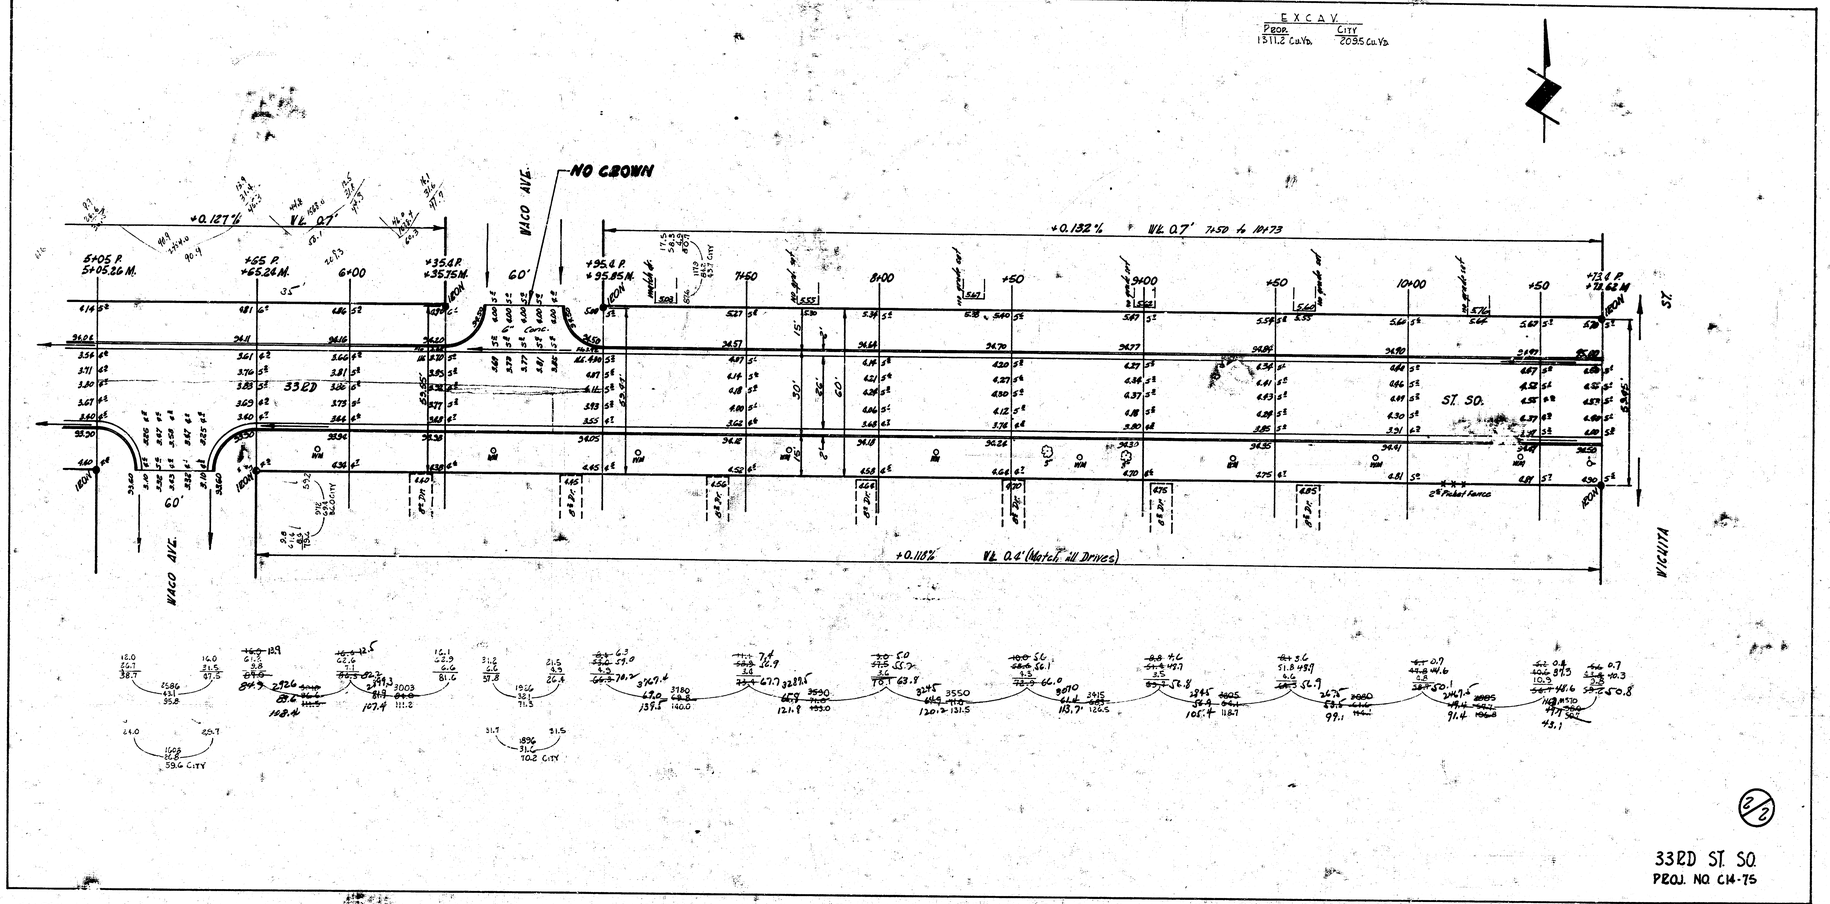

2/2

33RD ST. SO.
PROJ. NO. C14-75

1 1 2 15