


Ark Valley Christian Church Addition

ARK VALLEY CHRISTIAN CHURCH ADDITION WICHITA, SEDGWICK COUNTY, KANSAS

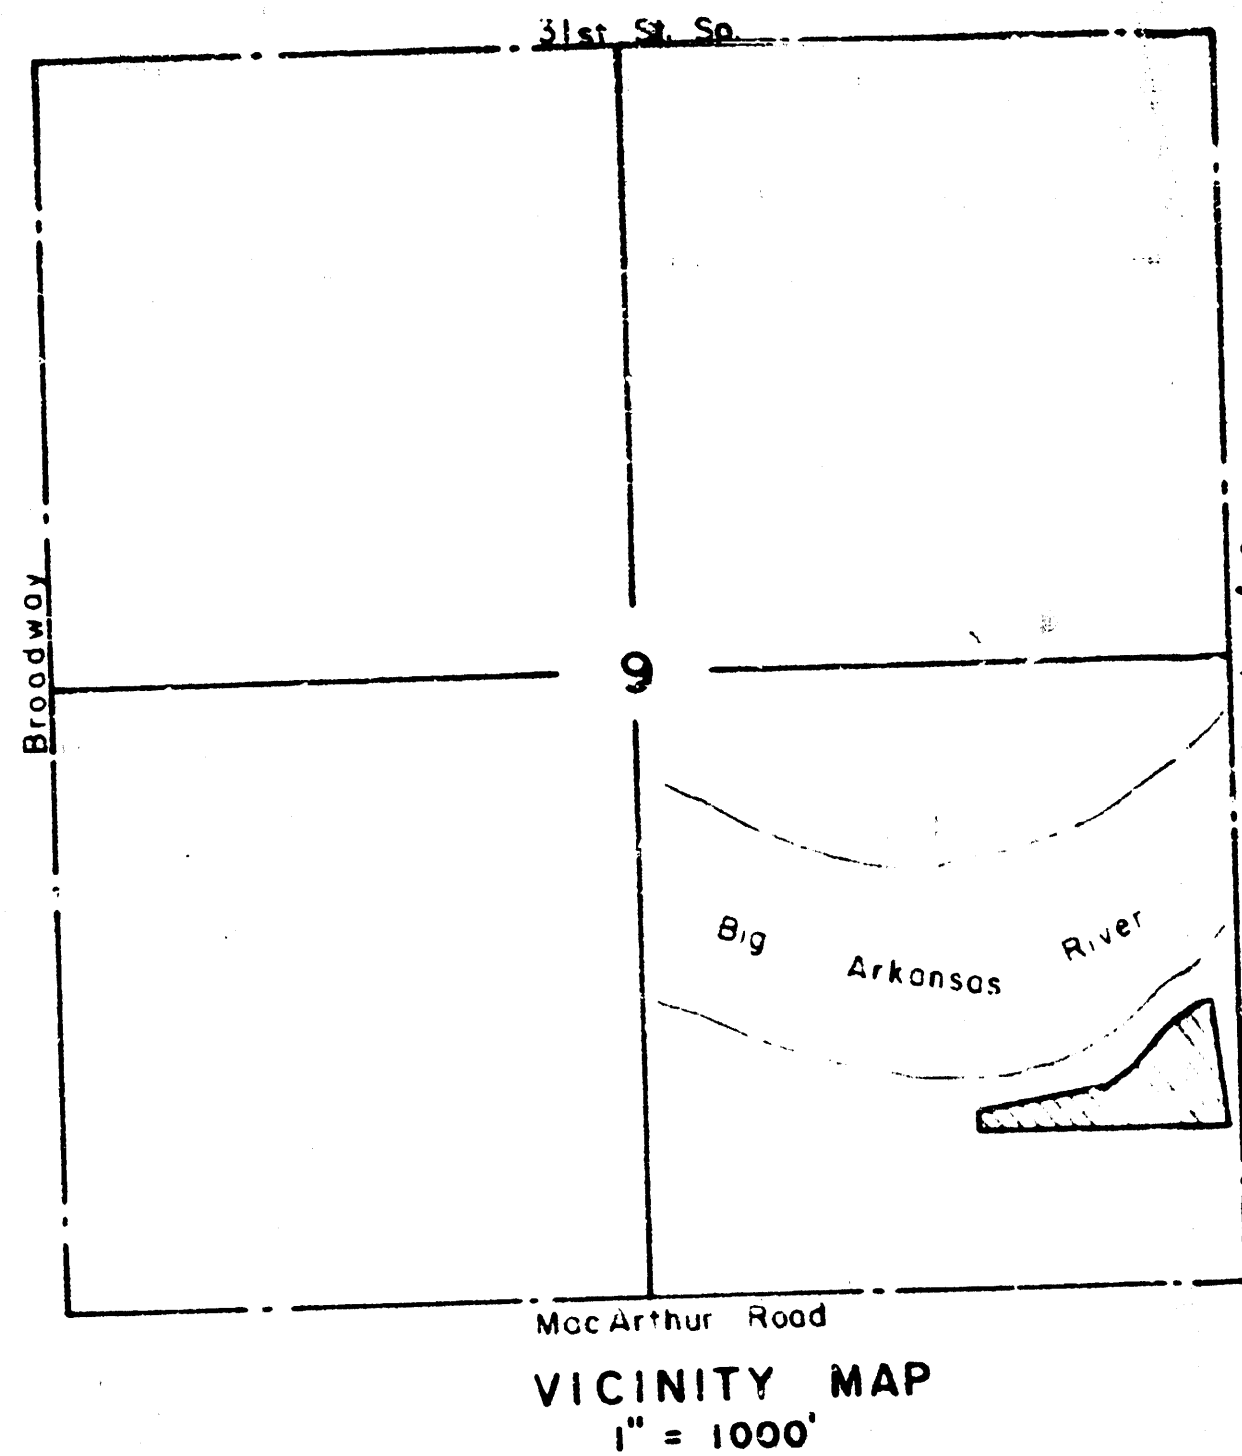



DRAINAGE PLAN

GRADE LOT TO DRAIN TO EXISTING
"BEE-HIVE" INLET 82' NORTH OF SE
CORNER LOT 1.



Min Pad. 1277
City Data 89.6

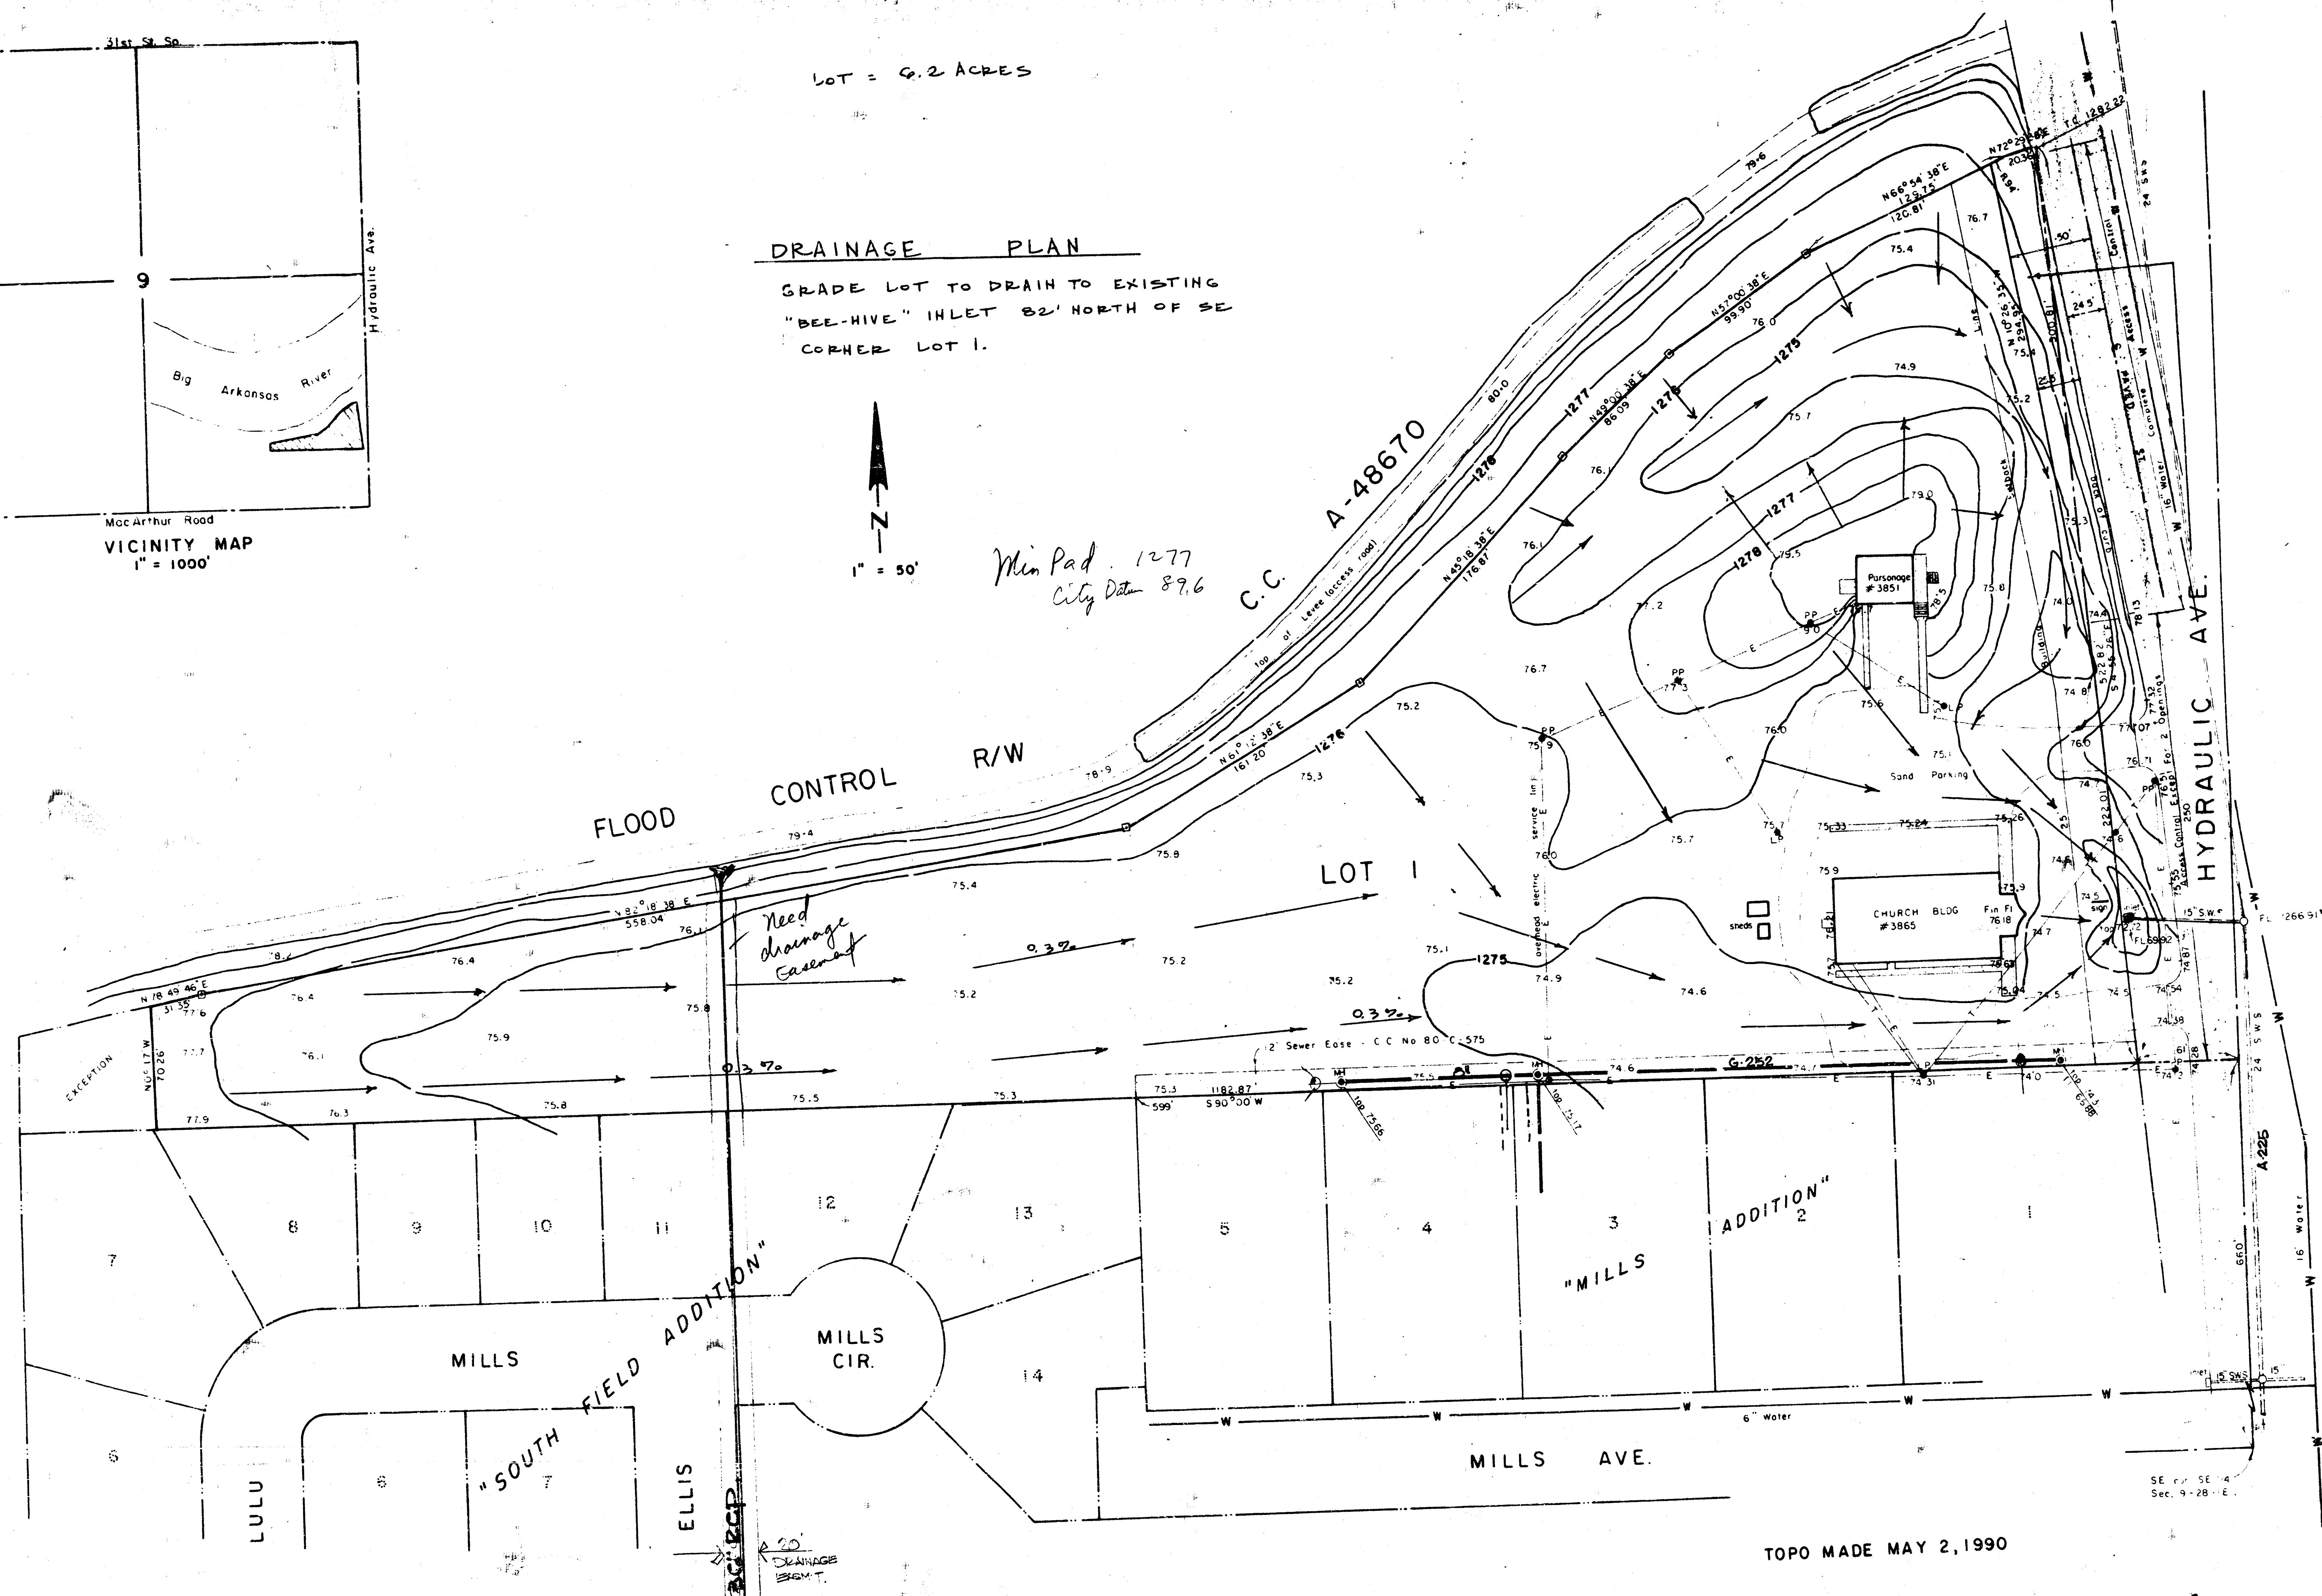

FOR:
ARK VALLEY CHRISTIAN CHURCH
3865 S. HYDRAULIC
WICHITA, KANSAS

TOPO MADE MAY 2, 1990

HI-TECH SURVEYORS, INC.
334 S. LAURA
WICHITA, KANSAS

B.M. - ELEV. 1274.28 - "□" on top of curb at SE
cor. of property.