
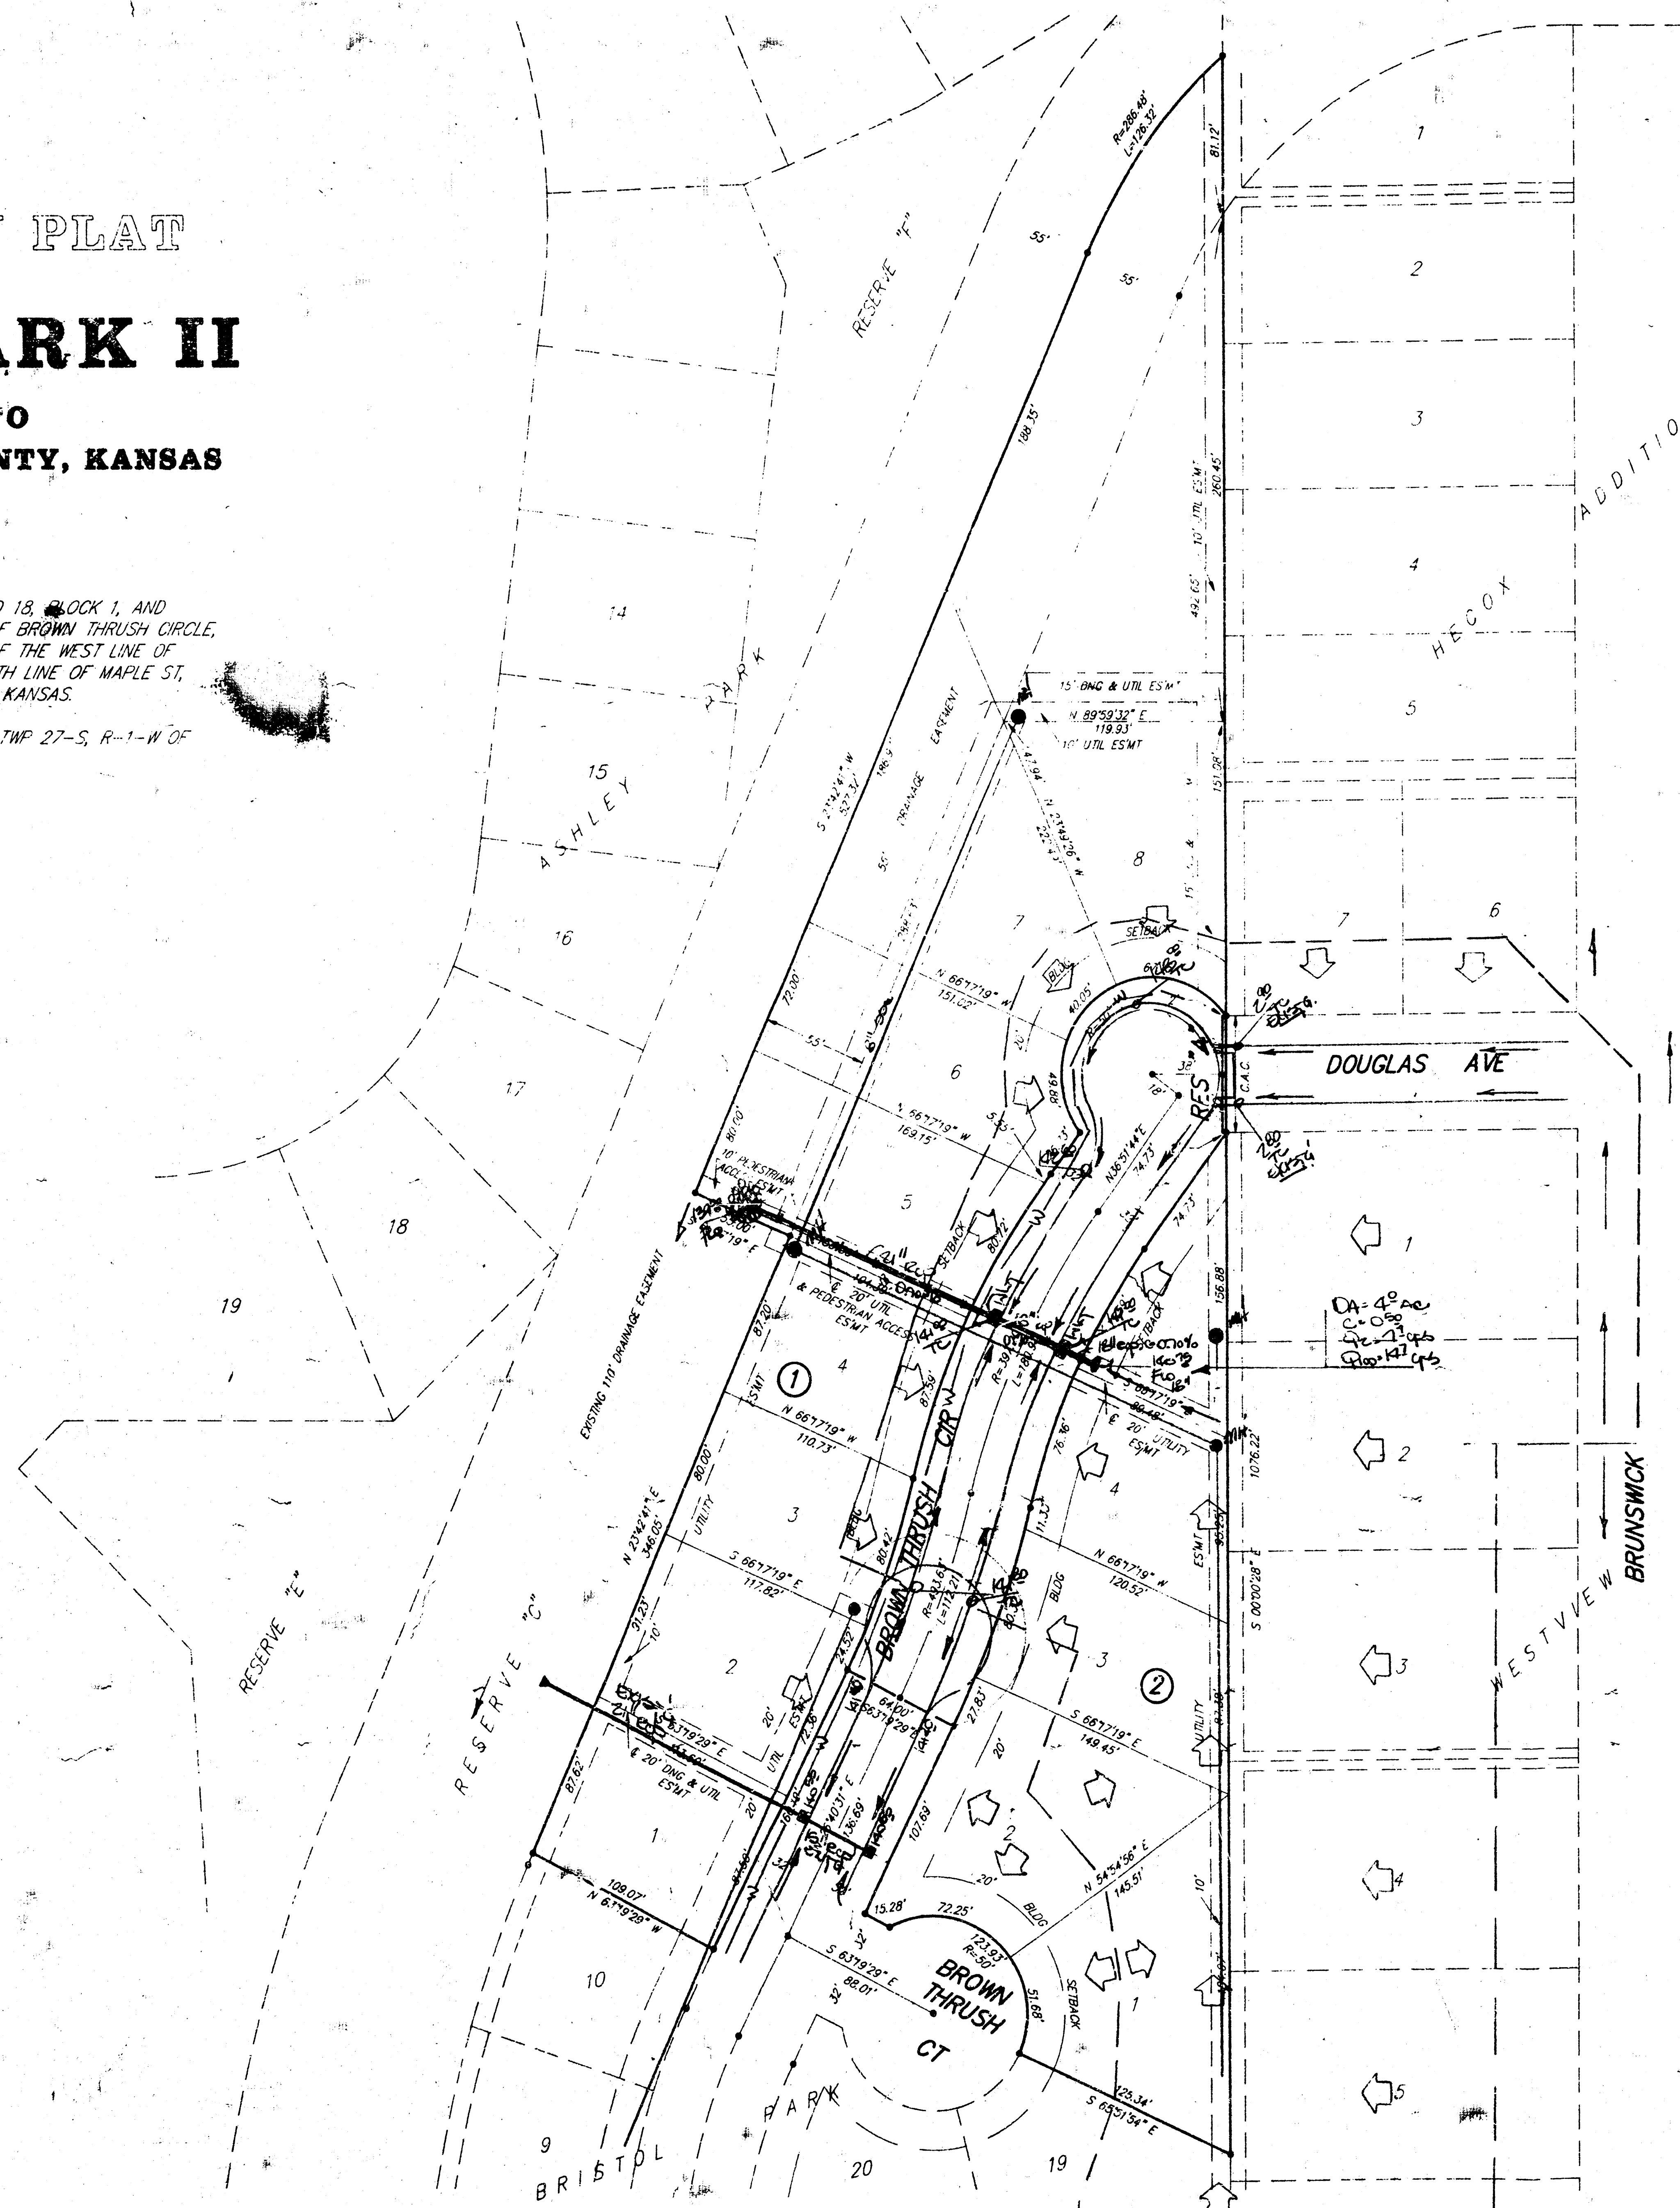


REPEAT OF LOTS 11, 12, 14, 15, 16, 17, AND 18, BLOCK 1, AND LOTS 1, 2, 3, 4, AND 5, BLOCK 2, AND PART OF BROWN THRUSH CIRCLE, AND ~~THAT~~ PART OF RESERVE "C" LYING EAST OF THE WEST LINE OF LOT 1, BLOCK 1, EXTENDED SOUTH TO THE NORTH LINE OF MAPLE ST, ALL IN BRISTOL PARK AN ADDITION TO WICHITA, KANSAS.

ALL BEING SITUATED IN THE SE1/4 OF SEC 21, TWP 27-S, R-1-W OF THE 6TH P.M., SEDGWICK COUNTY, KANSAS.

BRISTOL PARK, INC.
J. W. RUSSEL, PRESIDENT

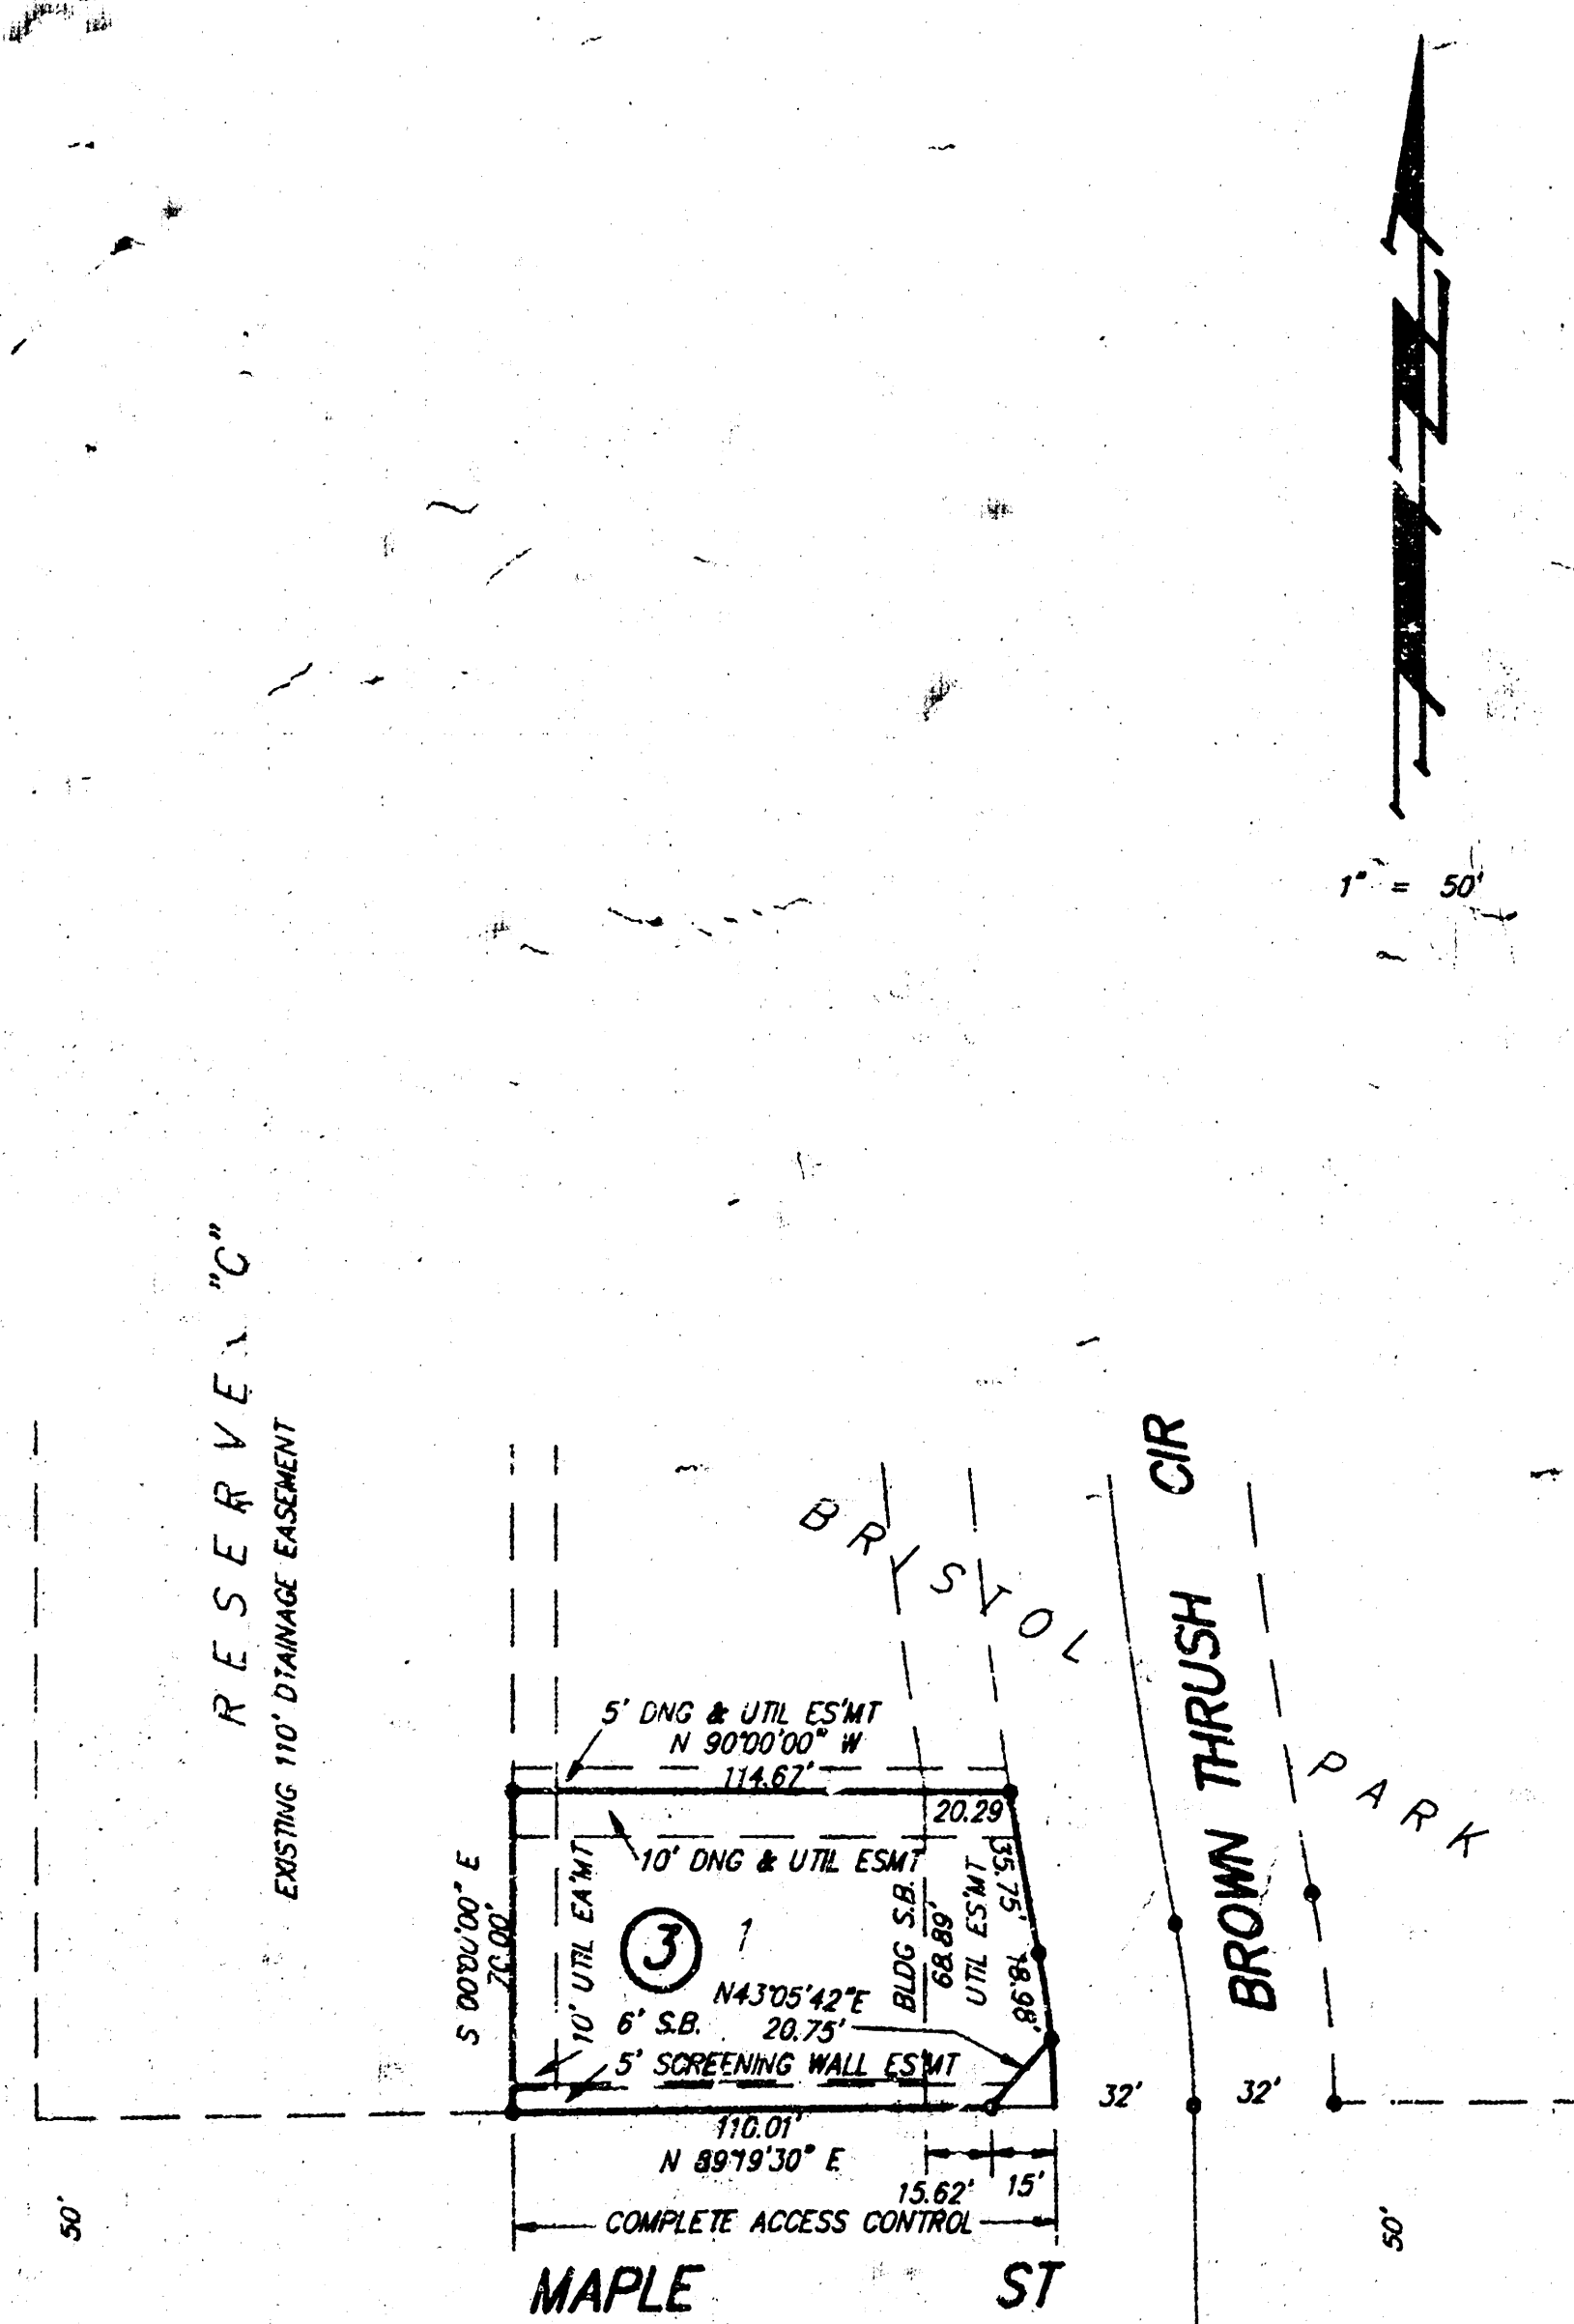

APPROVED DRAINAGE PLAN

1. REMOVE EXISTING CUL DE SAC
2. REMOVE EXISTING WARE LINTS IN CUL DE SAC
3. EXTEND WARE LINT TO WARE PT
4. EXTEND SPRING TO 1 INCH CUL DE SAC.
5. CONSTRUCT SPRING SOWER W. CUL DE SAC
6. CONSTRUCT TRENCH GRADUALLY & FILL ACCESS TO OVERTURN FROM CUL DE SAC

DRAINAGE & UTILITY PLAN

BAUGHMAN COMPANY P. A.
ENGINEERING & SURVEYING
316/262-7271 • 315 ELLIS • WICHITA, KANSAS 67211

FILMED FROM THE BEST
AVAILABLE COPY.....