



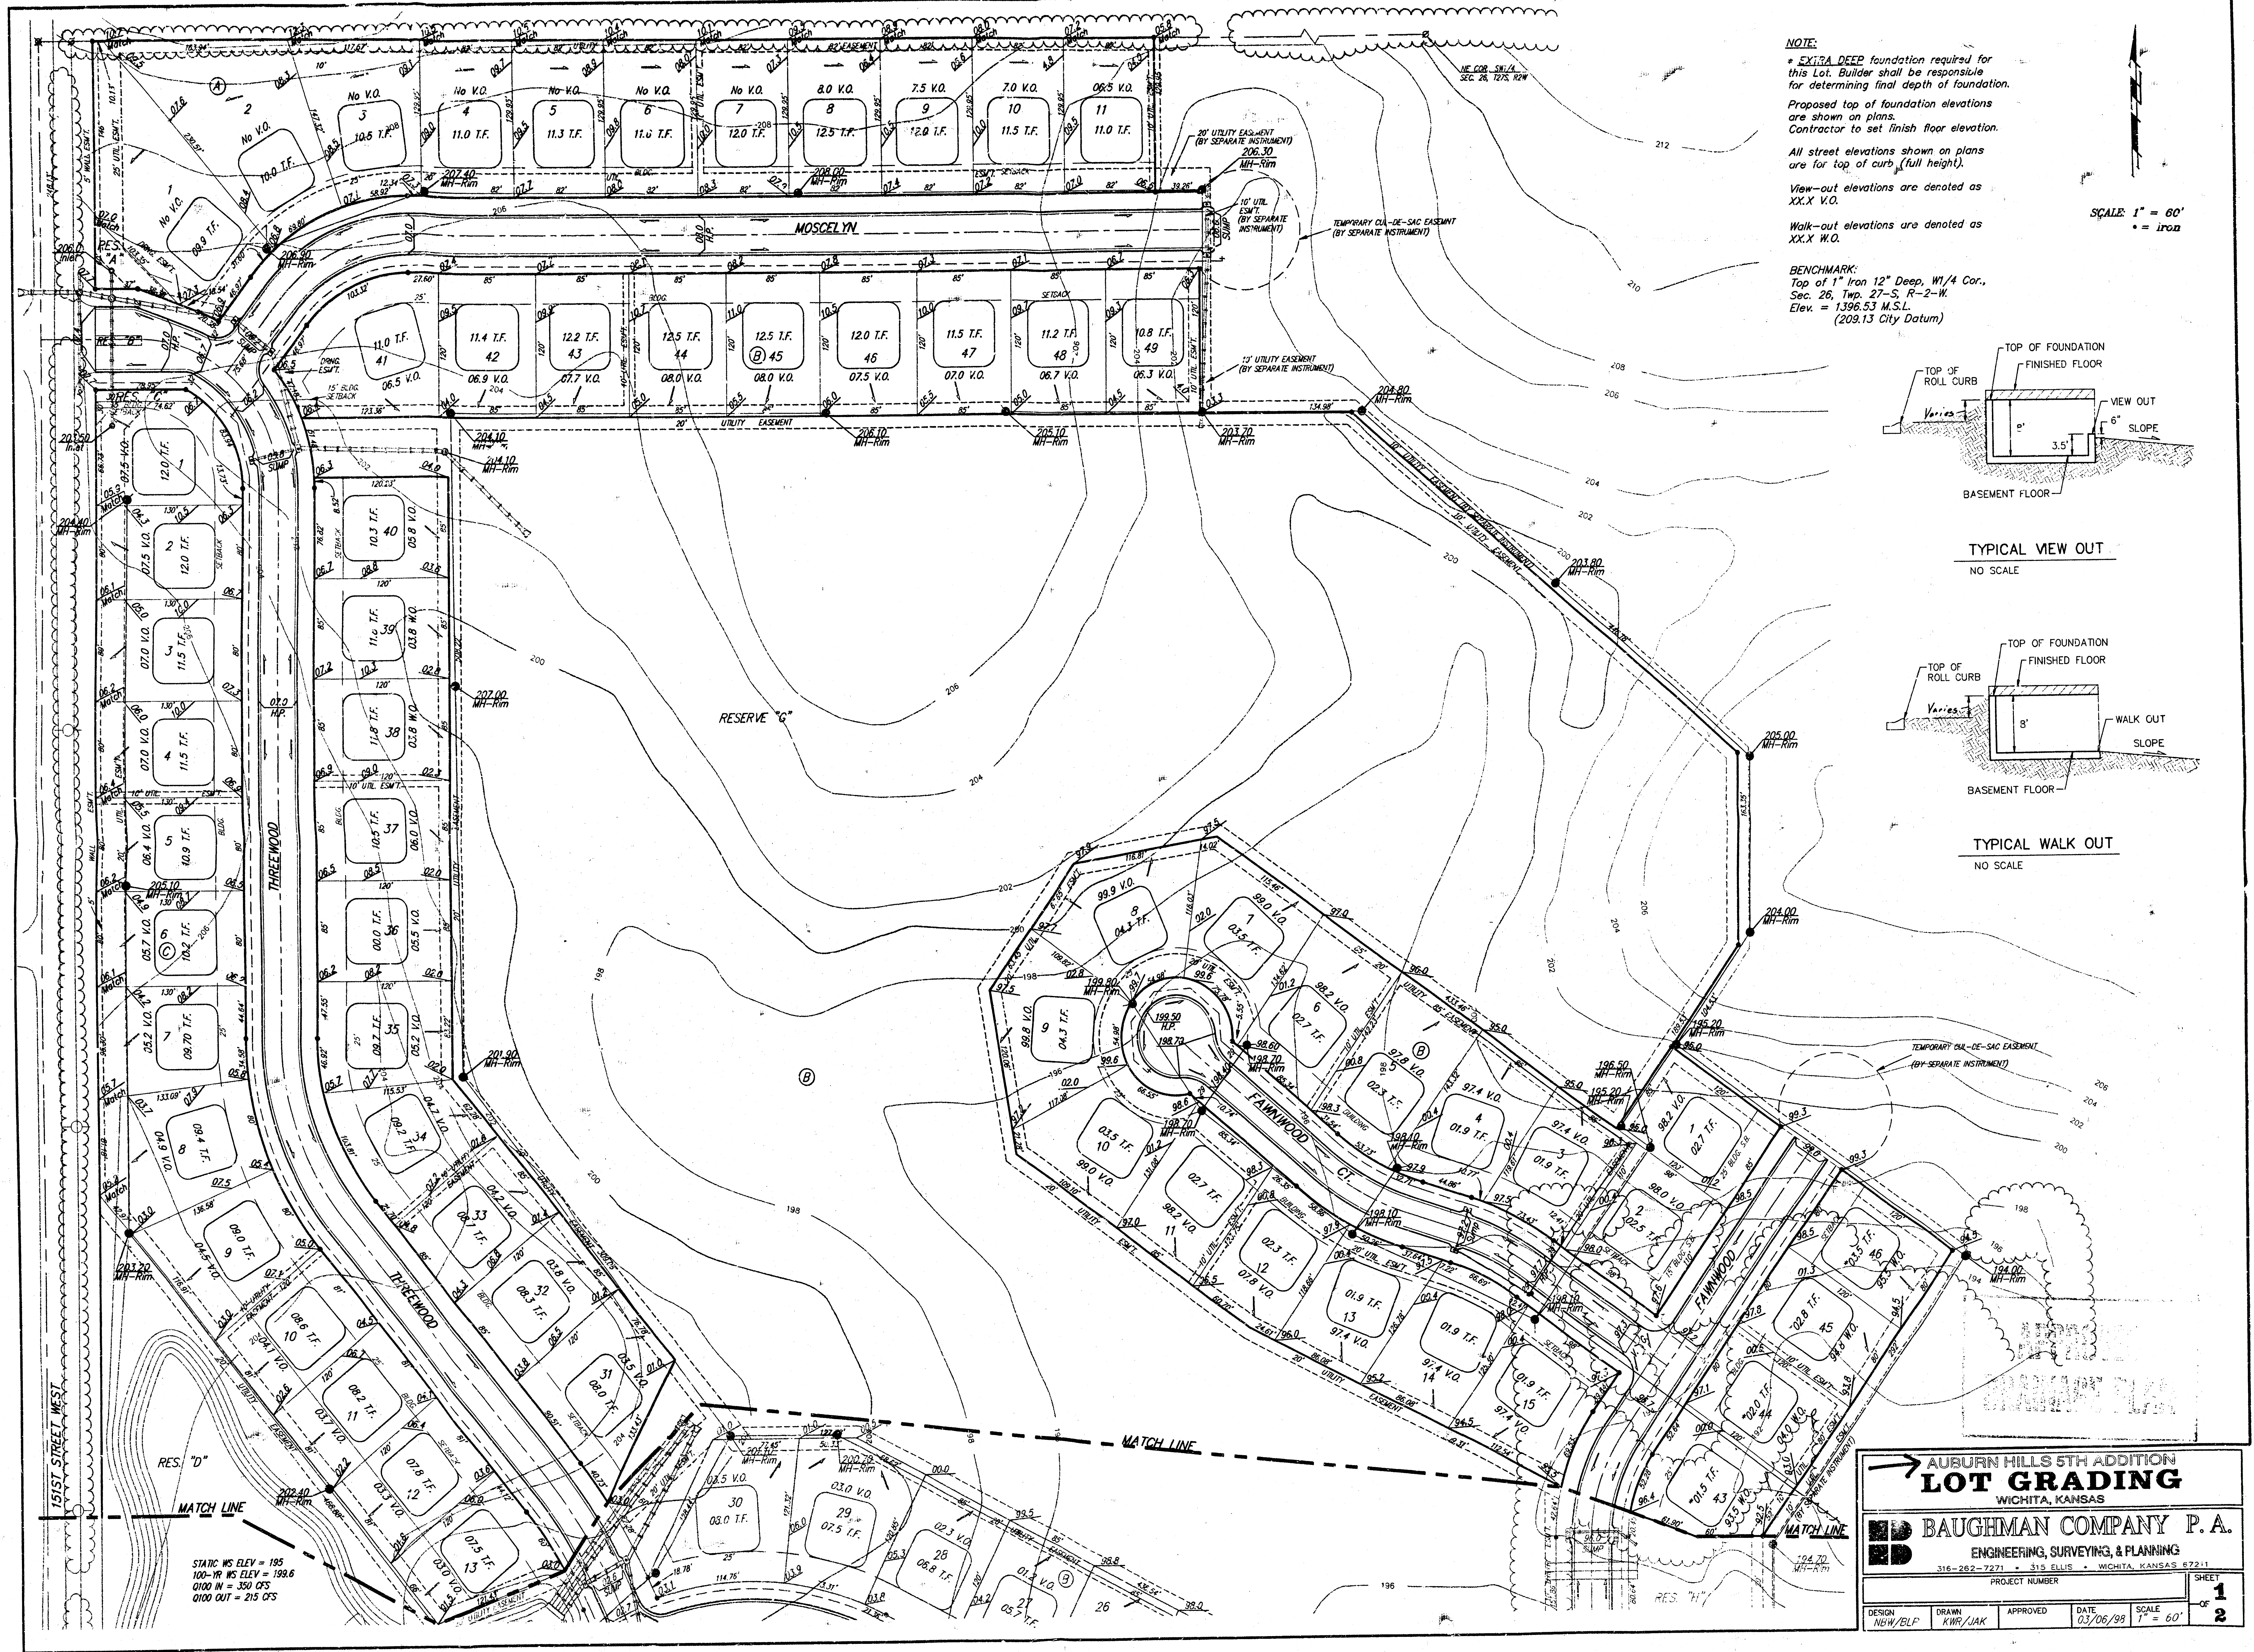

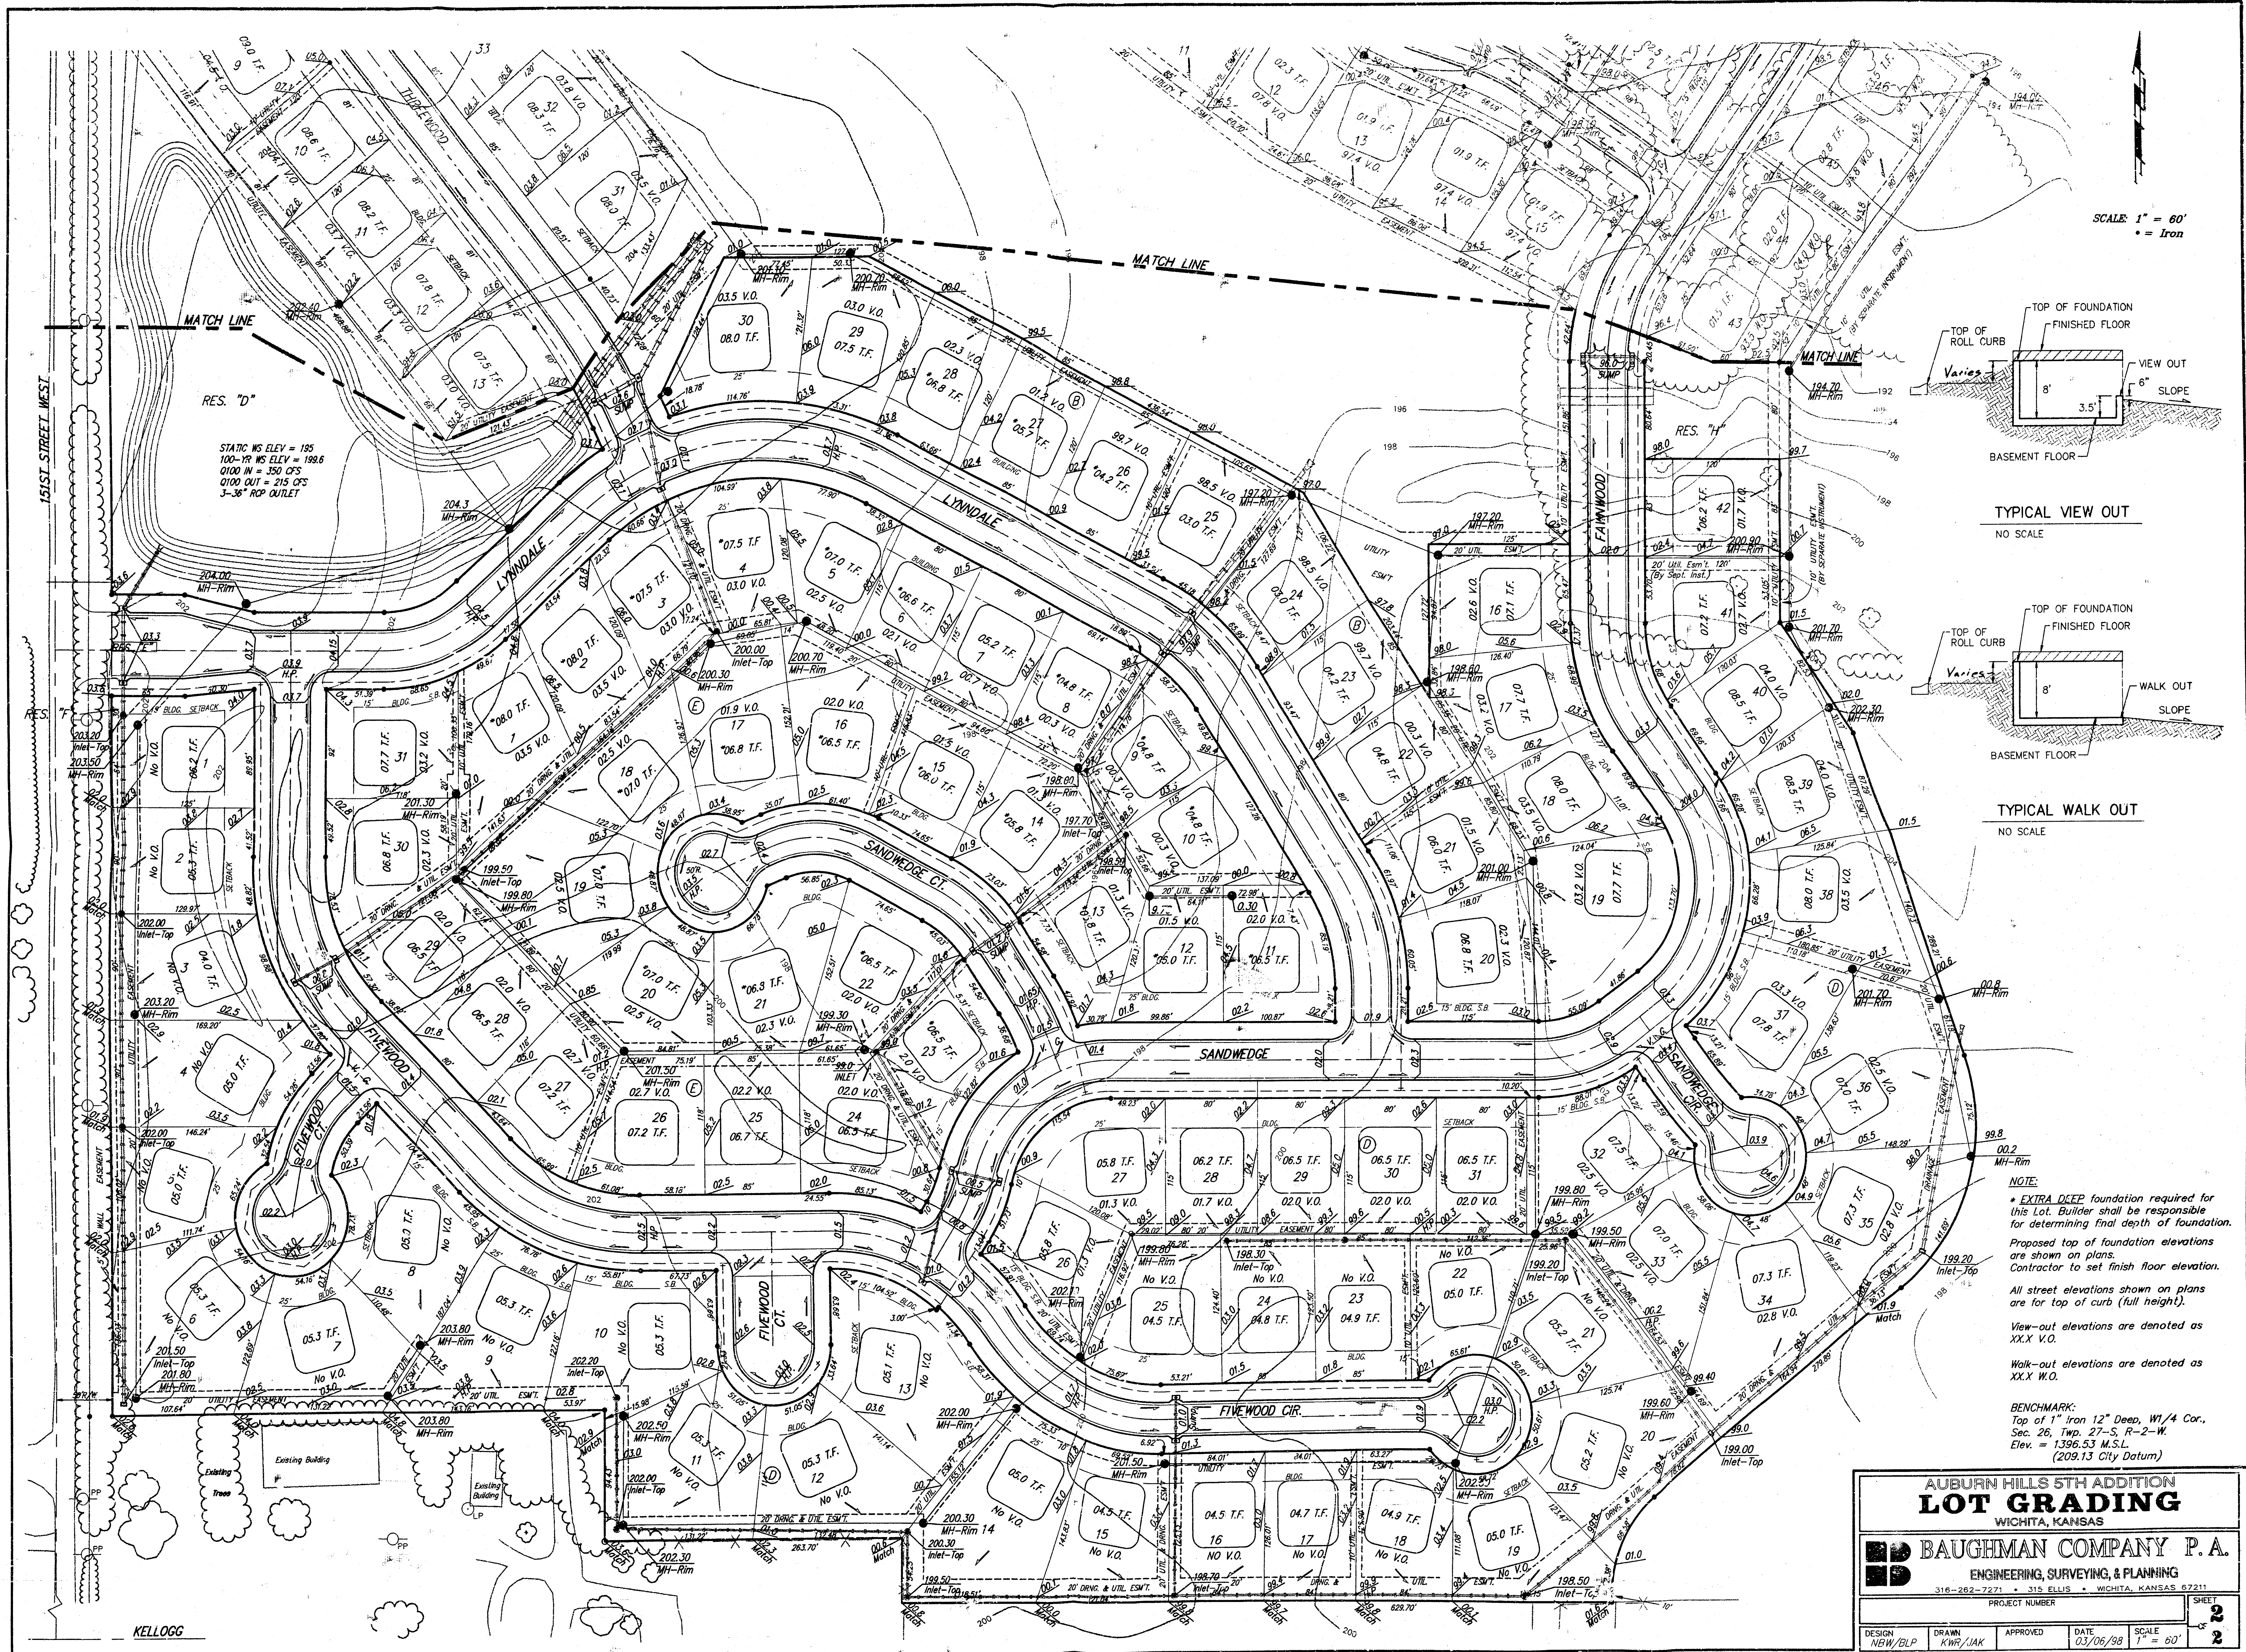

AUBURN HILLS 5TH ADDITION
LOT GRADING
WICHITA, KANSAS

BAUGHMAN COMPANY P.A.
ENGINEERING, SURVEYING, & PLANNING
316-262-7271 • 318 ELLIS • WICHITA, KANSAS 67211

PROJECT NUMBER _____

DATE 03/06/98 SCALE 1" = 60'

SHEET 2 OF 2