


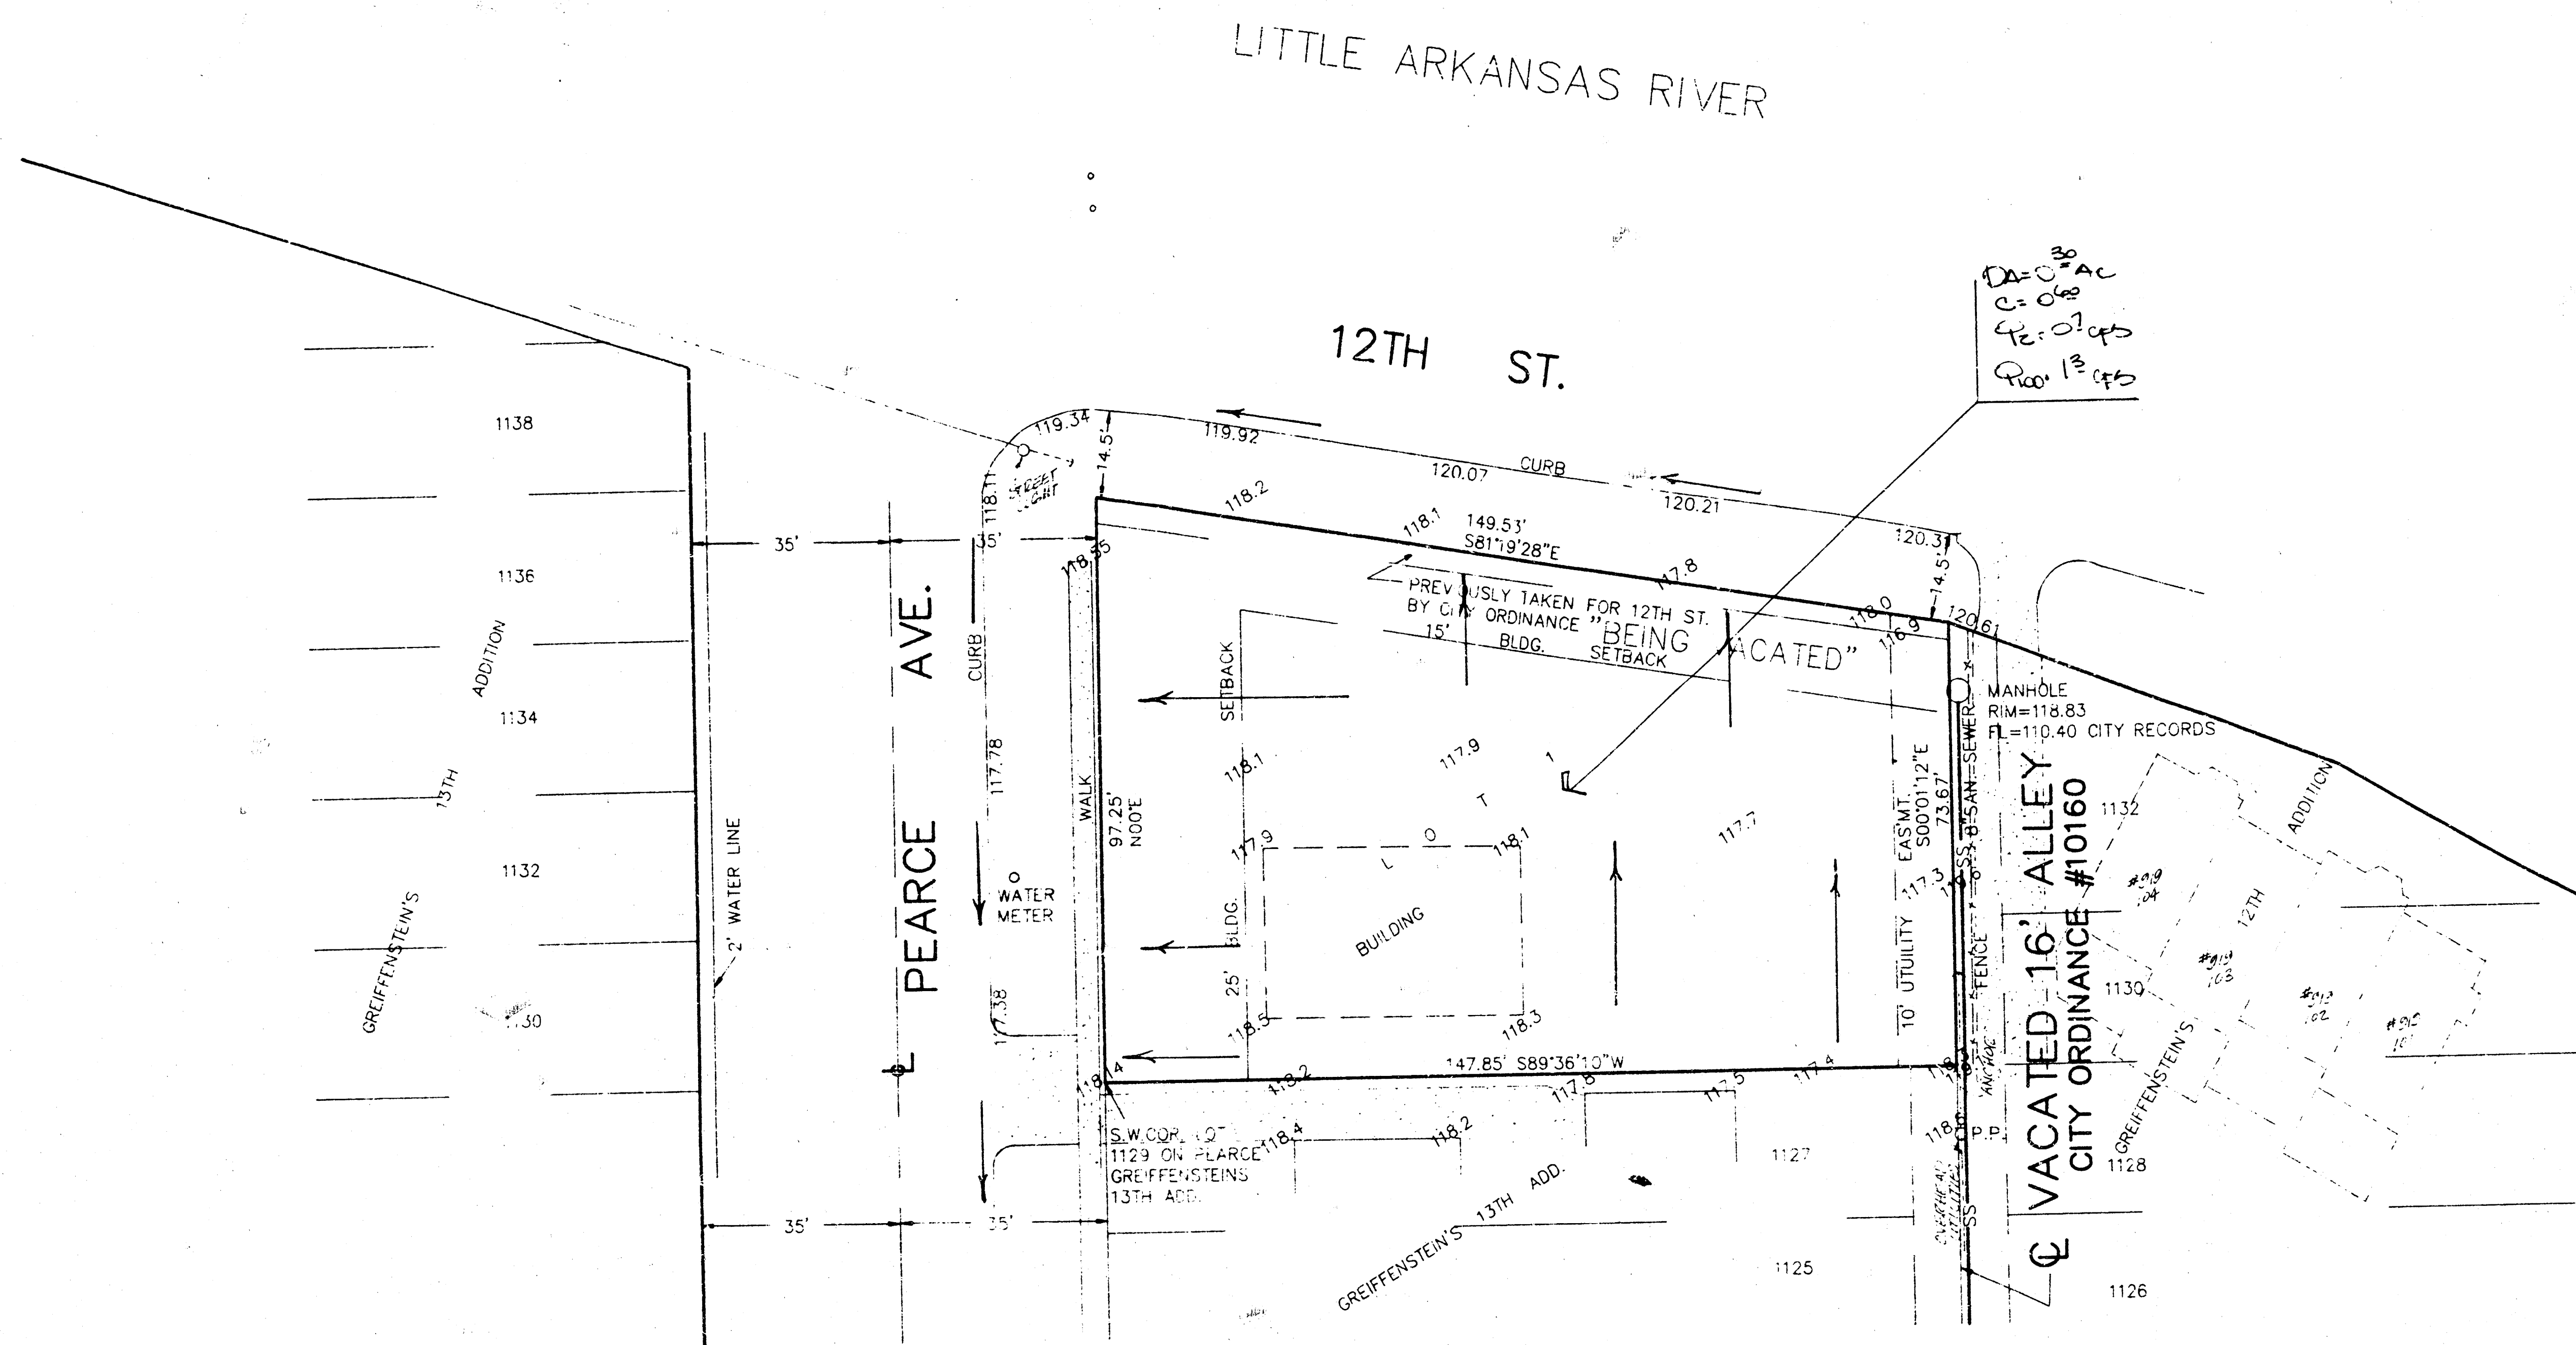

All of Lots 1128, 1131, 1133, and Lot 1135
 Ave. together with the W 1/2 of vacated Alley adjacent on the east
 wick County, Kansas, and together with a portion of 12 St. as pre-
 viously taken by City Ordinance, being originally a portion of, said Lot
 1133, all being more particularly described as beginning at the S.W.
 Cor. of said Lot 1128, thence 400'±, along the ead line of
 Ave. 73.67'±, thence 170'±, 149.5'±, thence S00°01'10"
 73.67'±, thence S89°36'10" 147.85'± to the place of be-
 ginning
 The above described portion of street and alley are hereby vacated
 by virtue of K.S.A 12-512 (b).

DRAINAGE plan

**APPROVED
DRAINAGE PLAN**



BAUGHMAN COMPANY P.
SURVEYING & ENGINEERING
316/262-7271 • 315 ELLIS • WICHITA, KANSAS 67211

MAY 17 1961

FILMED FROM THE BEST