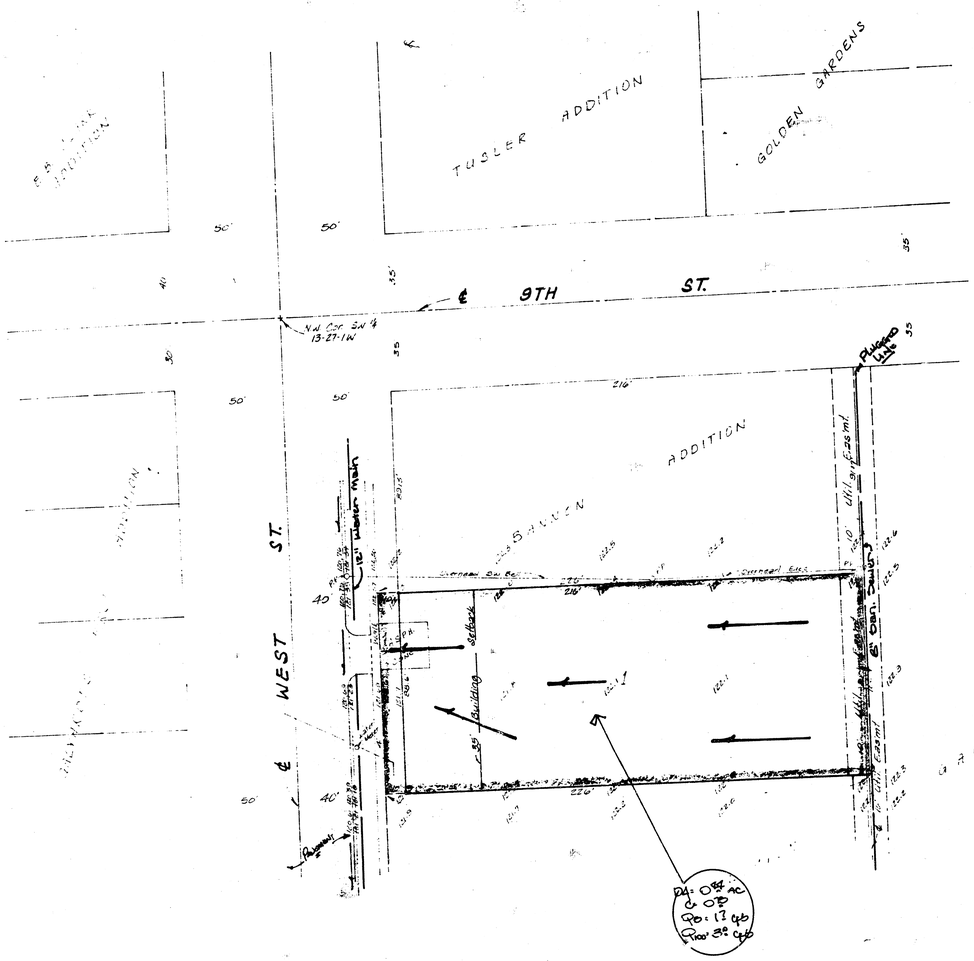
TUSLER ADDITION
GOLDEN GARDENS
9TH ST.
NW Cor SW 4 13-27-1W
Platted Line
ADDITION
BANNON
WEST ST.
Setback
Building
