


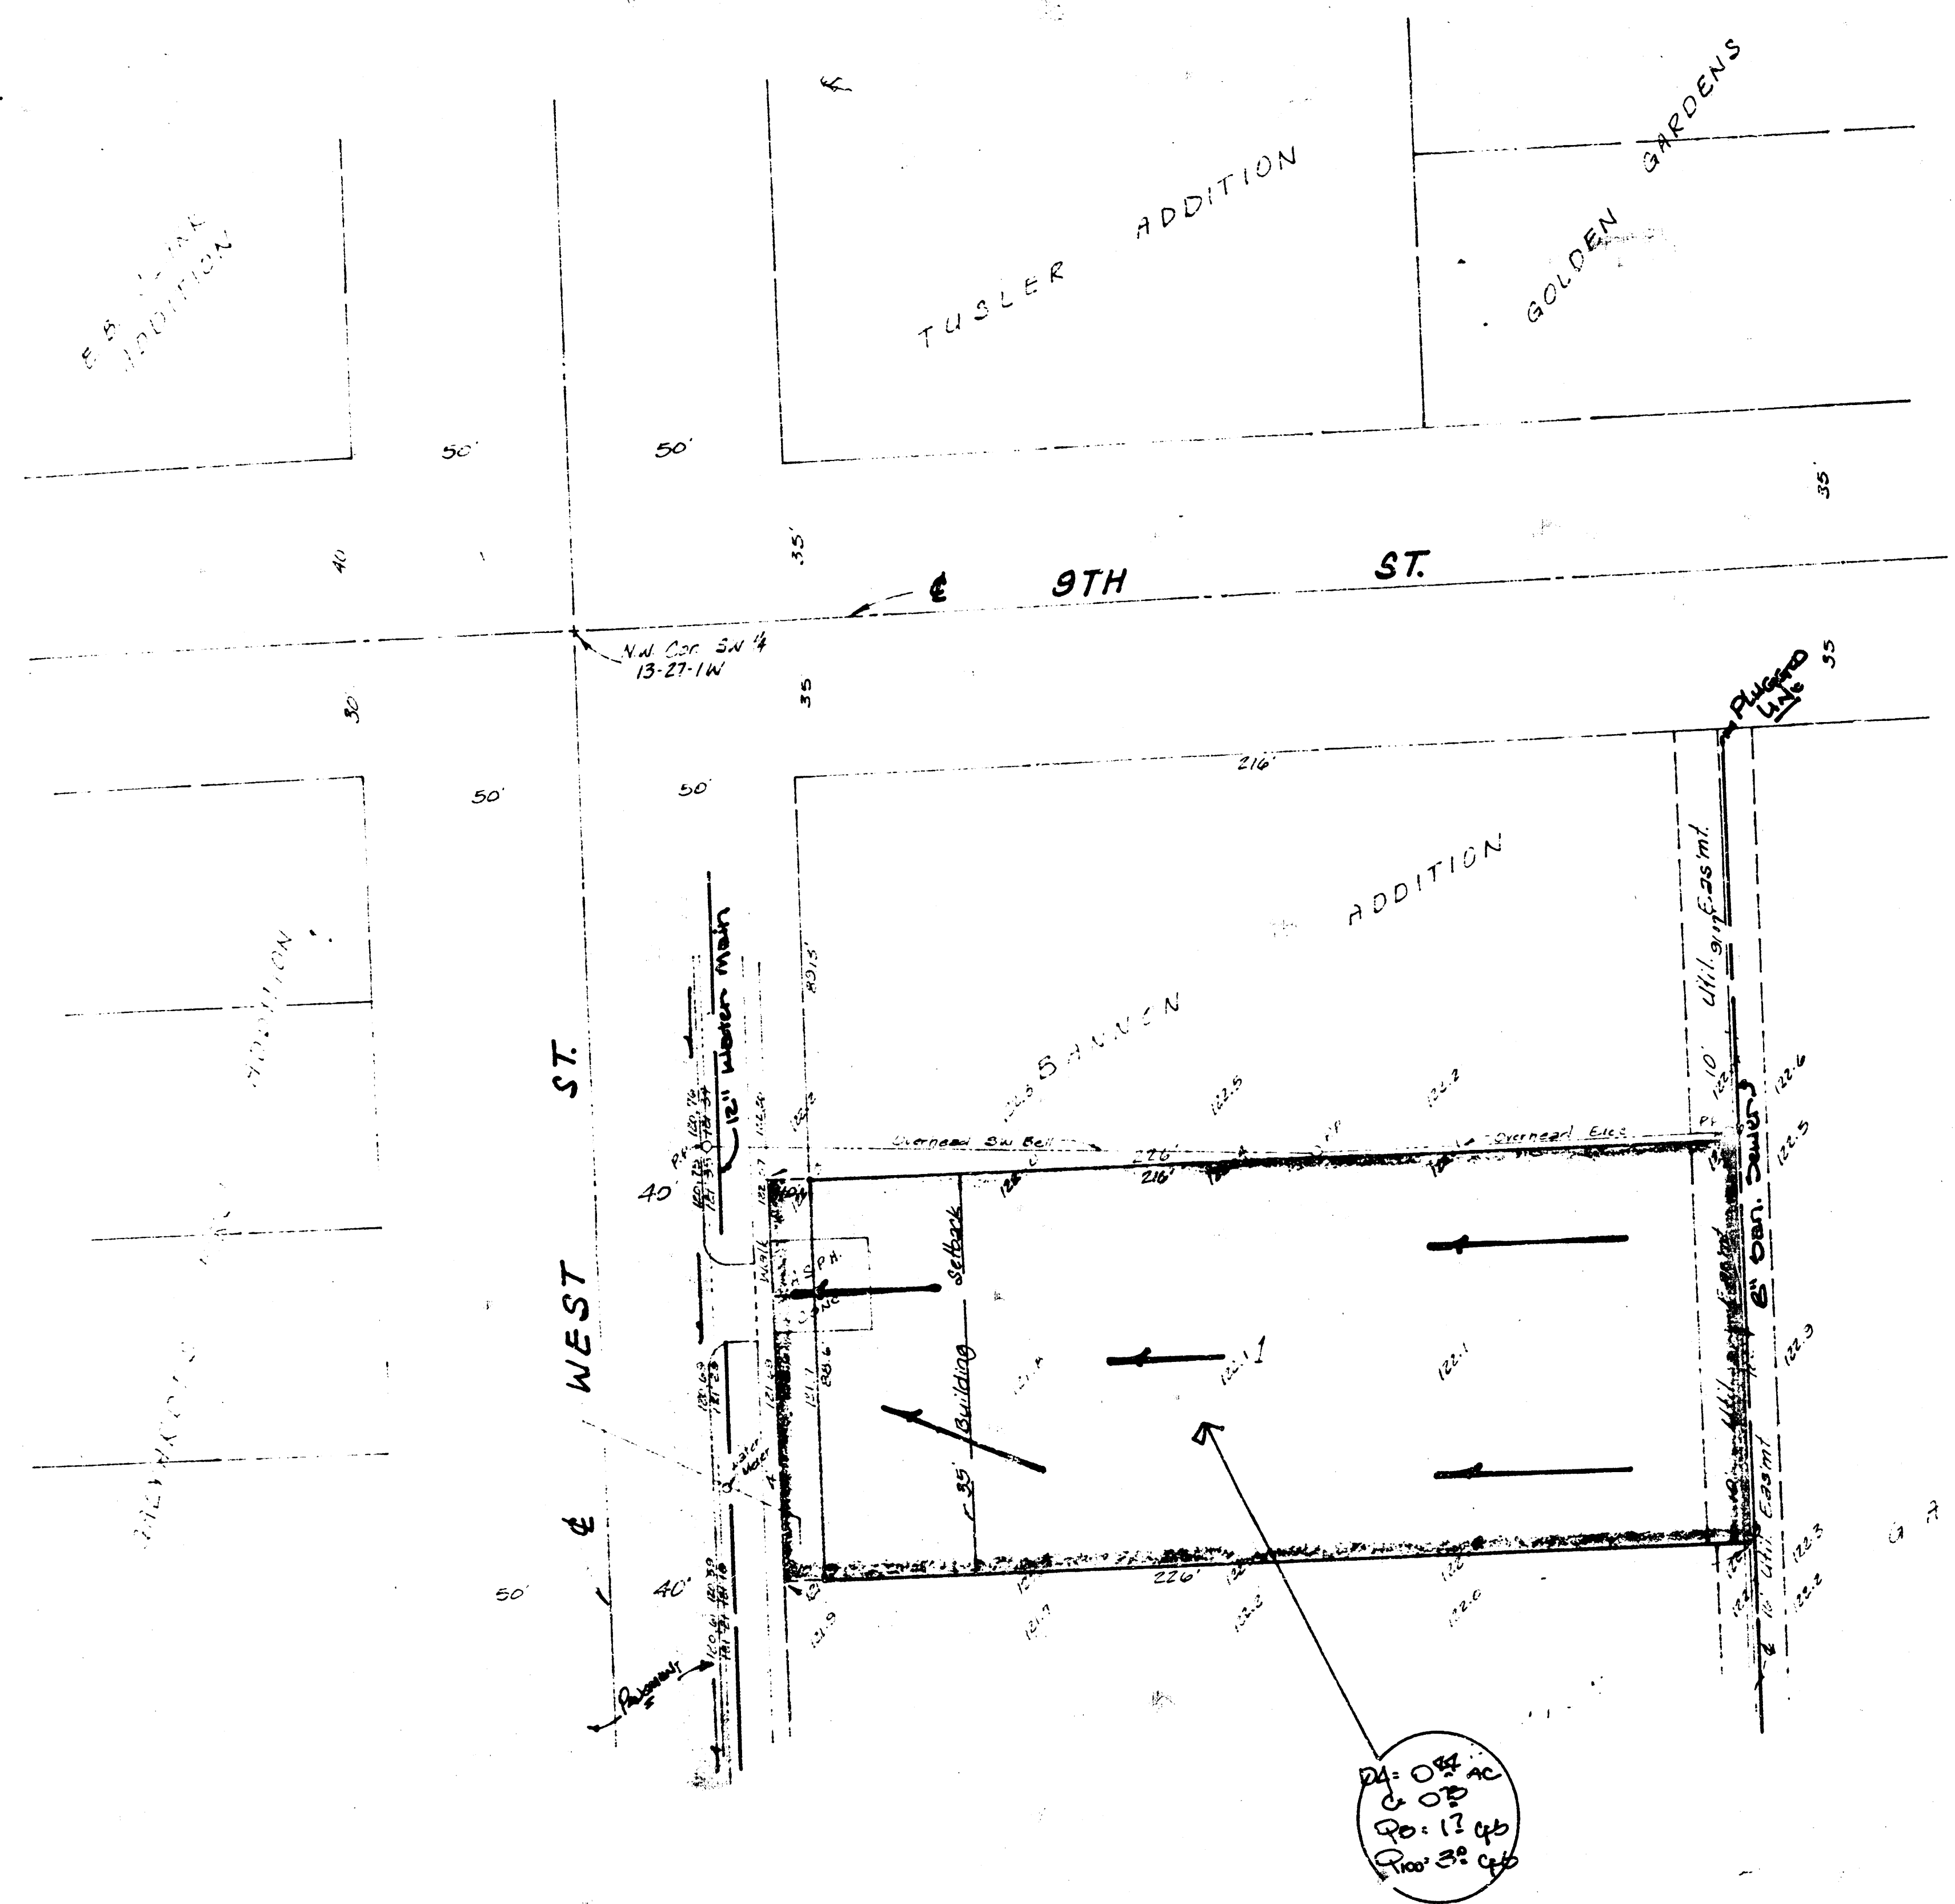

SKETCH PLAT

BANNON 2ND ADDITION

REPLAT OF LOT 2 NEWTON GARDENS SEDGWICK COUNTY, KANSAS

GENERAL NOTES:
THE COMMERCIAL LOT WHEN DEVELOPED SHALL DRAIN WEST TO WEST ST. AND DISCHARGE TO THE STREET THRU THE DRIVEWAY. WEST ST. DRAINS SOUTH AND INTO AN INLET & DRAIN SWORE APPROX. 100' S. OF THIS PROPERTY.

OWNER: JEFF BANNON

DRAINAGE PLAN

BAUGHMAN COMPANY, P.A.
SURVEYING & ENGINEERING
316/263-7271 • 330 LAURA • WICHITA, KANSAS 67211

14 NOVEMBER 1985

FILMED FROM THE BEST
AVAILABLE COPY.....