


1" = 40'
ELEV. = CITY DATUM

BENCH MARK:
SQUARE COT ON TOP OF CURB
AT S. END OF CURB RETURN AT
S.W. CORNER OF DOUGLAS AND
TYLER
ELEV. = 142.75 CITY DATUM

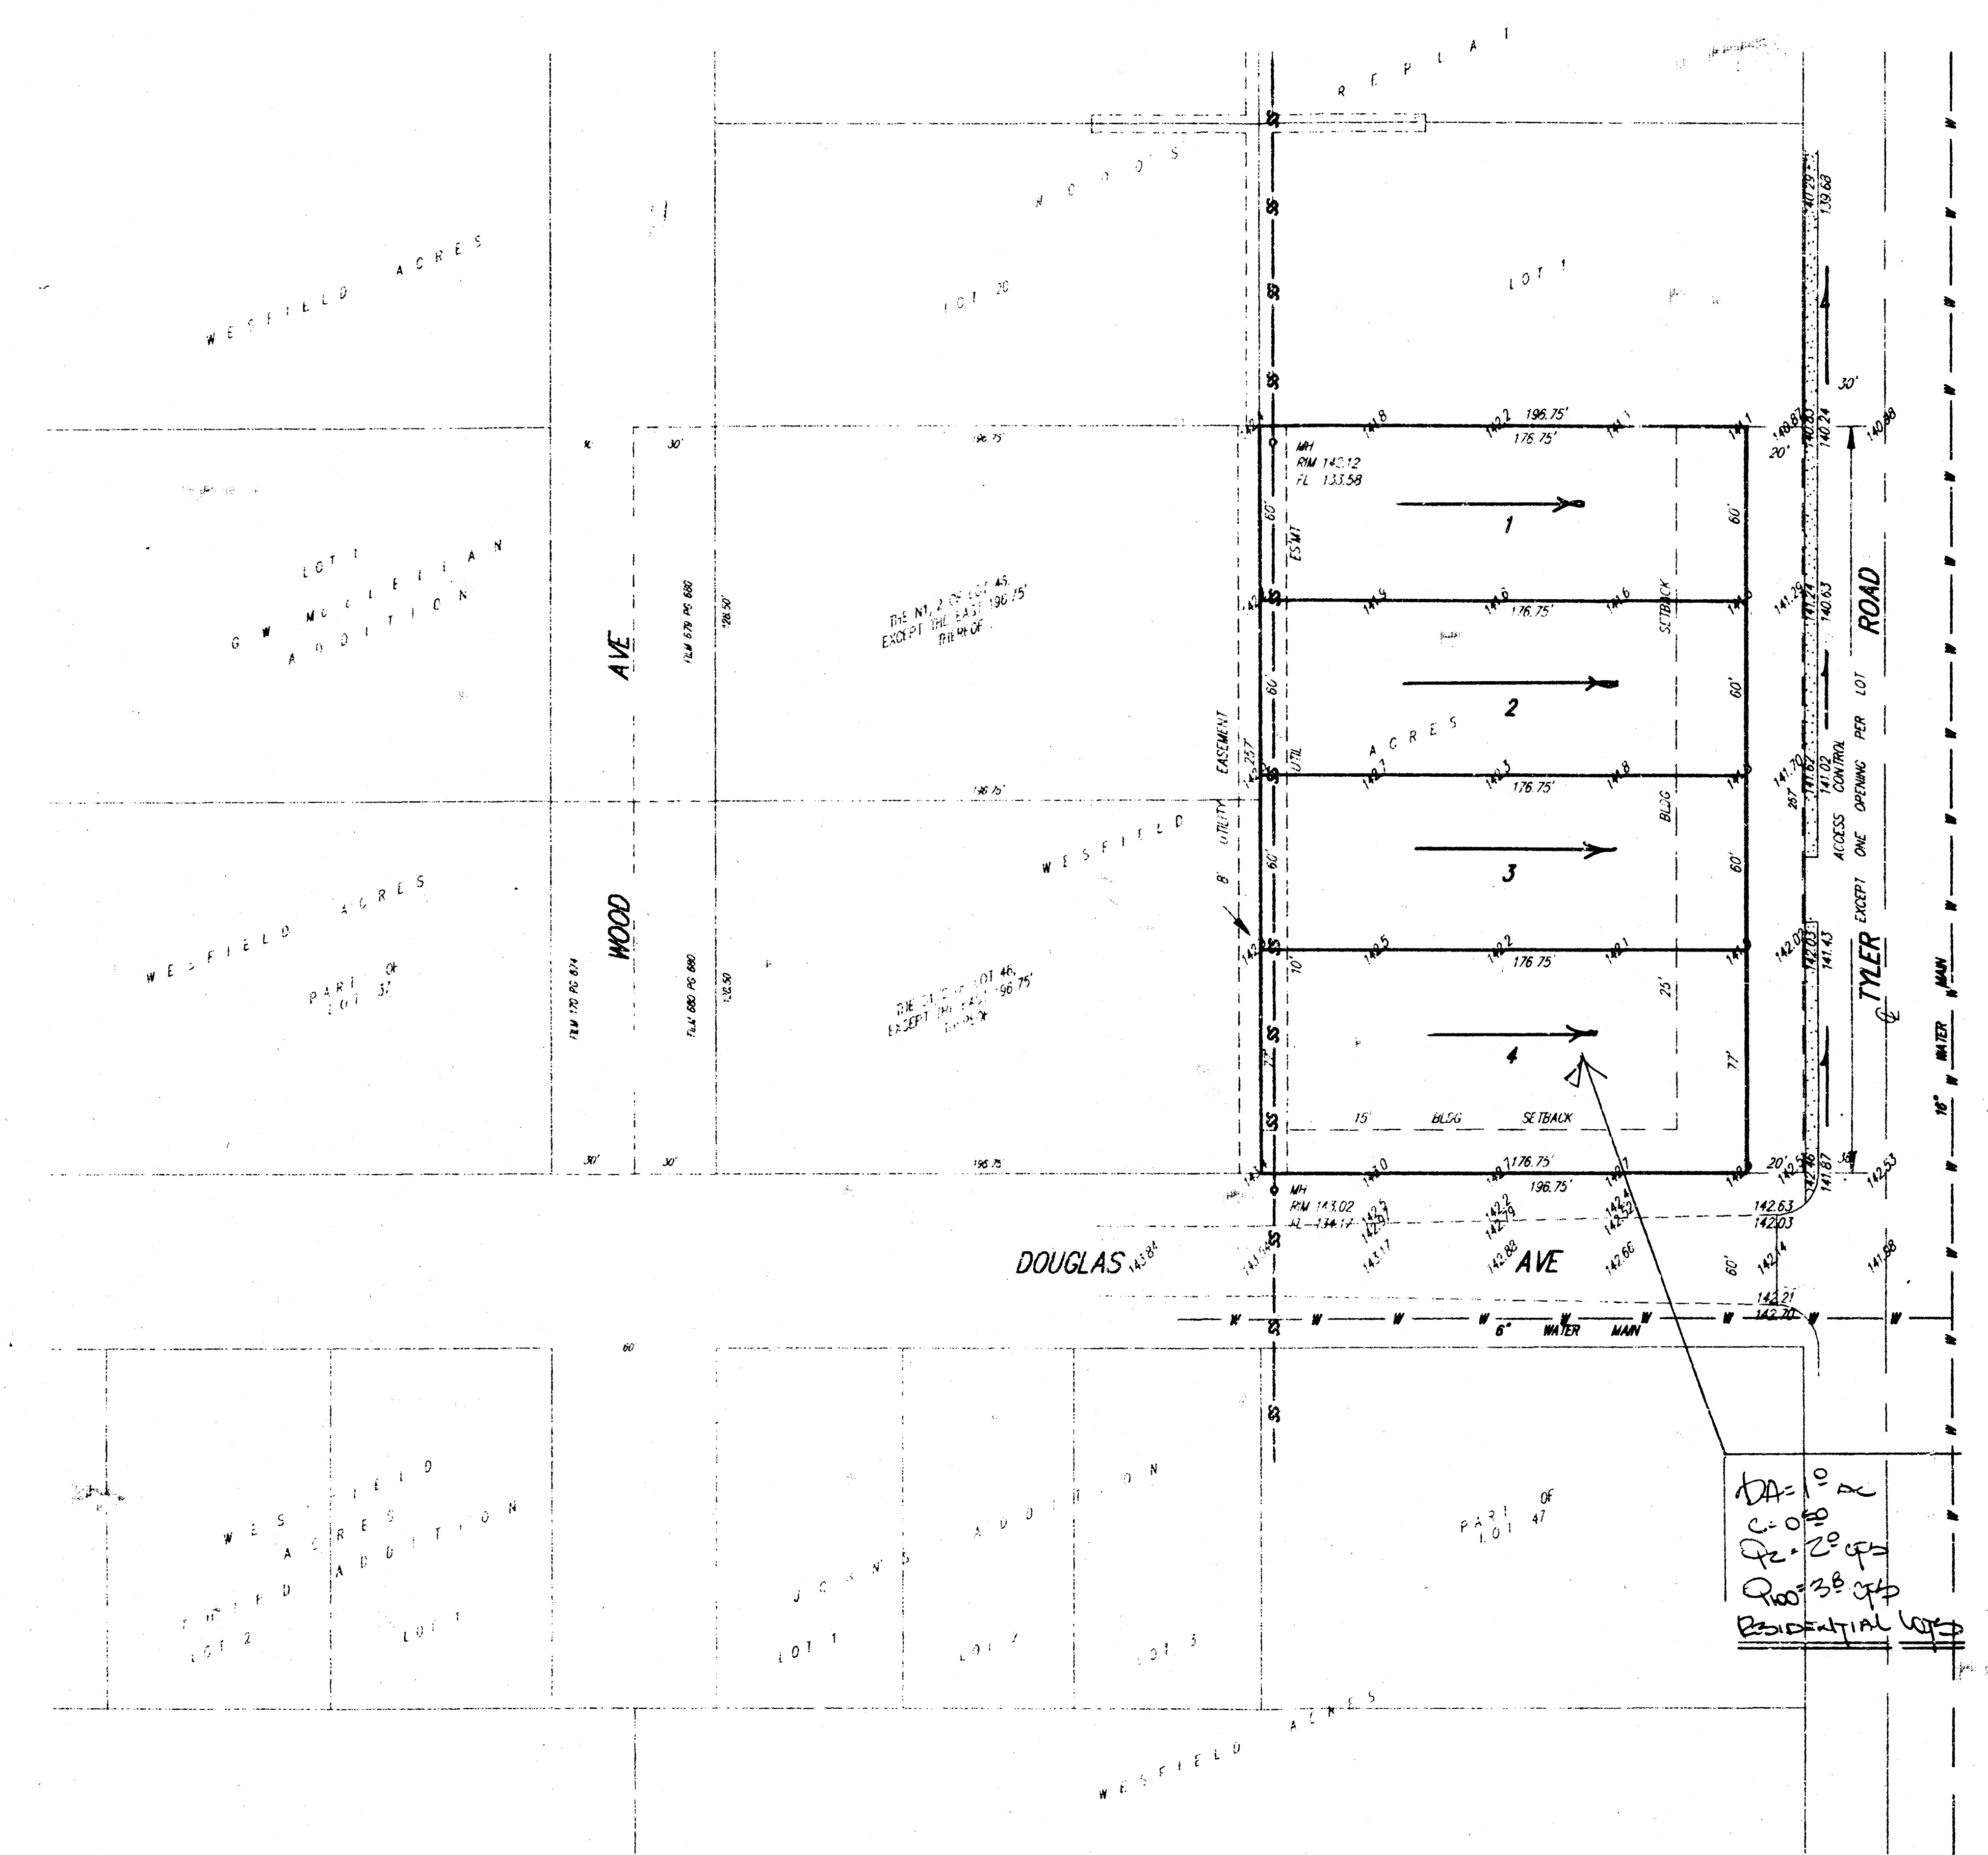

SKETCH PLAT **R. BEARD ADDITION**

WICHITA, SEDGWICK COUNTY, KANSAS

HONNIE BEARD
7817 W. NANTUCKET
WICHITA, KS 67212
PH. 722-4894

THE EAST 136.75 FEET OF LOT 46,
WESFIELD ACRES, SEDGWICK COUNTY,
KANSAS.

DRAINAGE PLAN

BAUGHMAN COMPANY P. A.
SURVEYING & ENGINEERING
316/282-7271 • 315 ELLIS • WICHITA, KANSAS 67211

1 SEP 92