

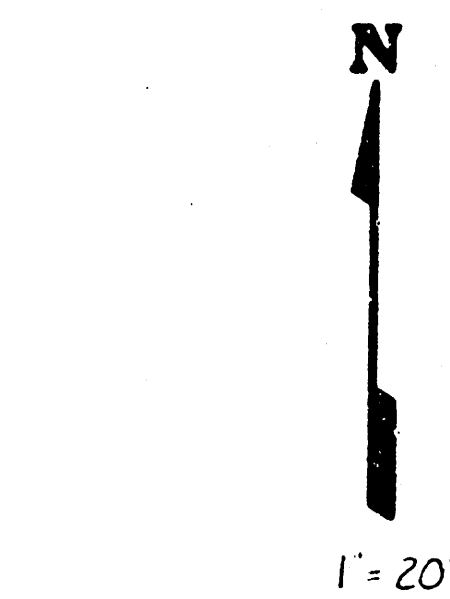


Blasi Add'n

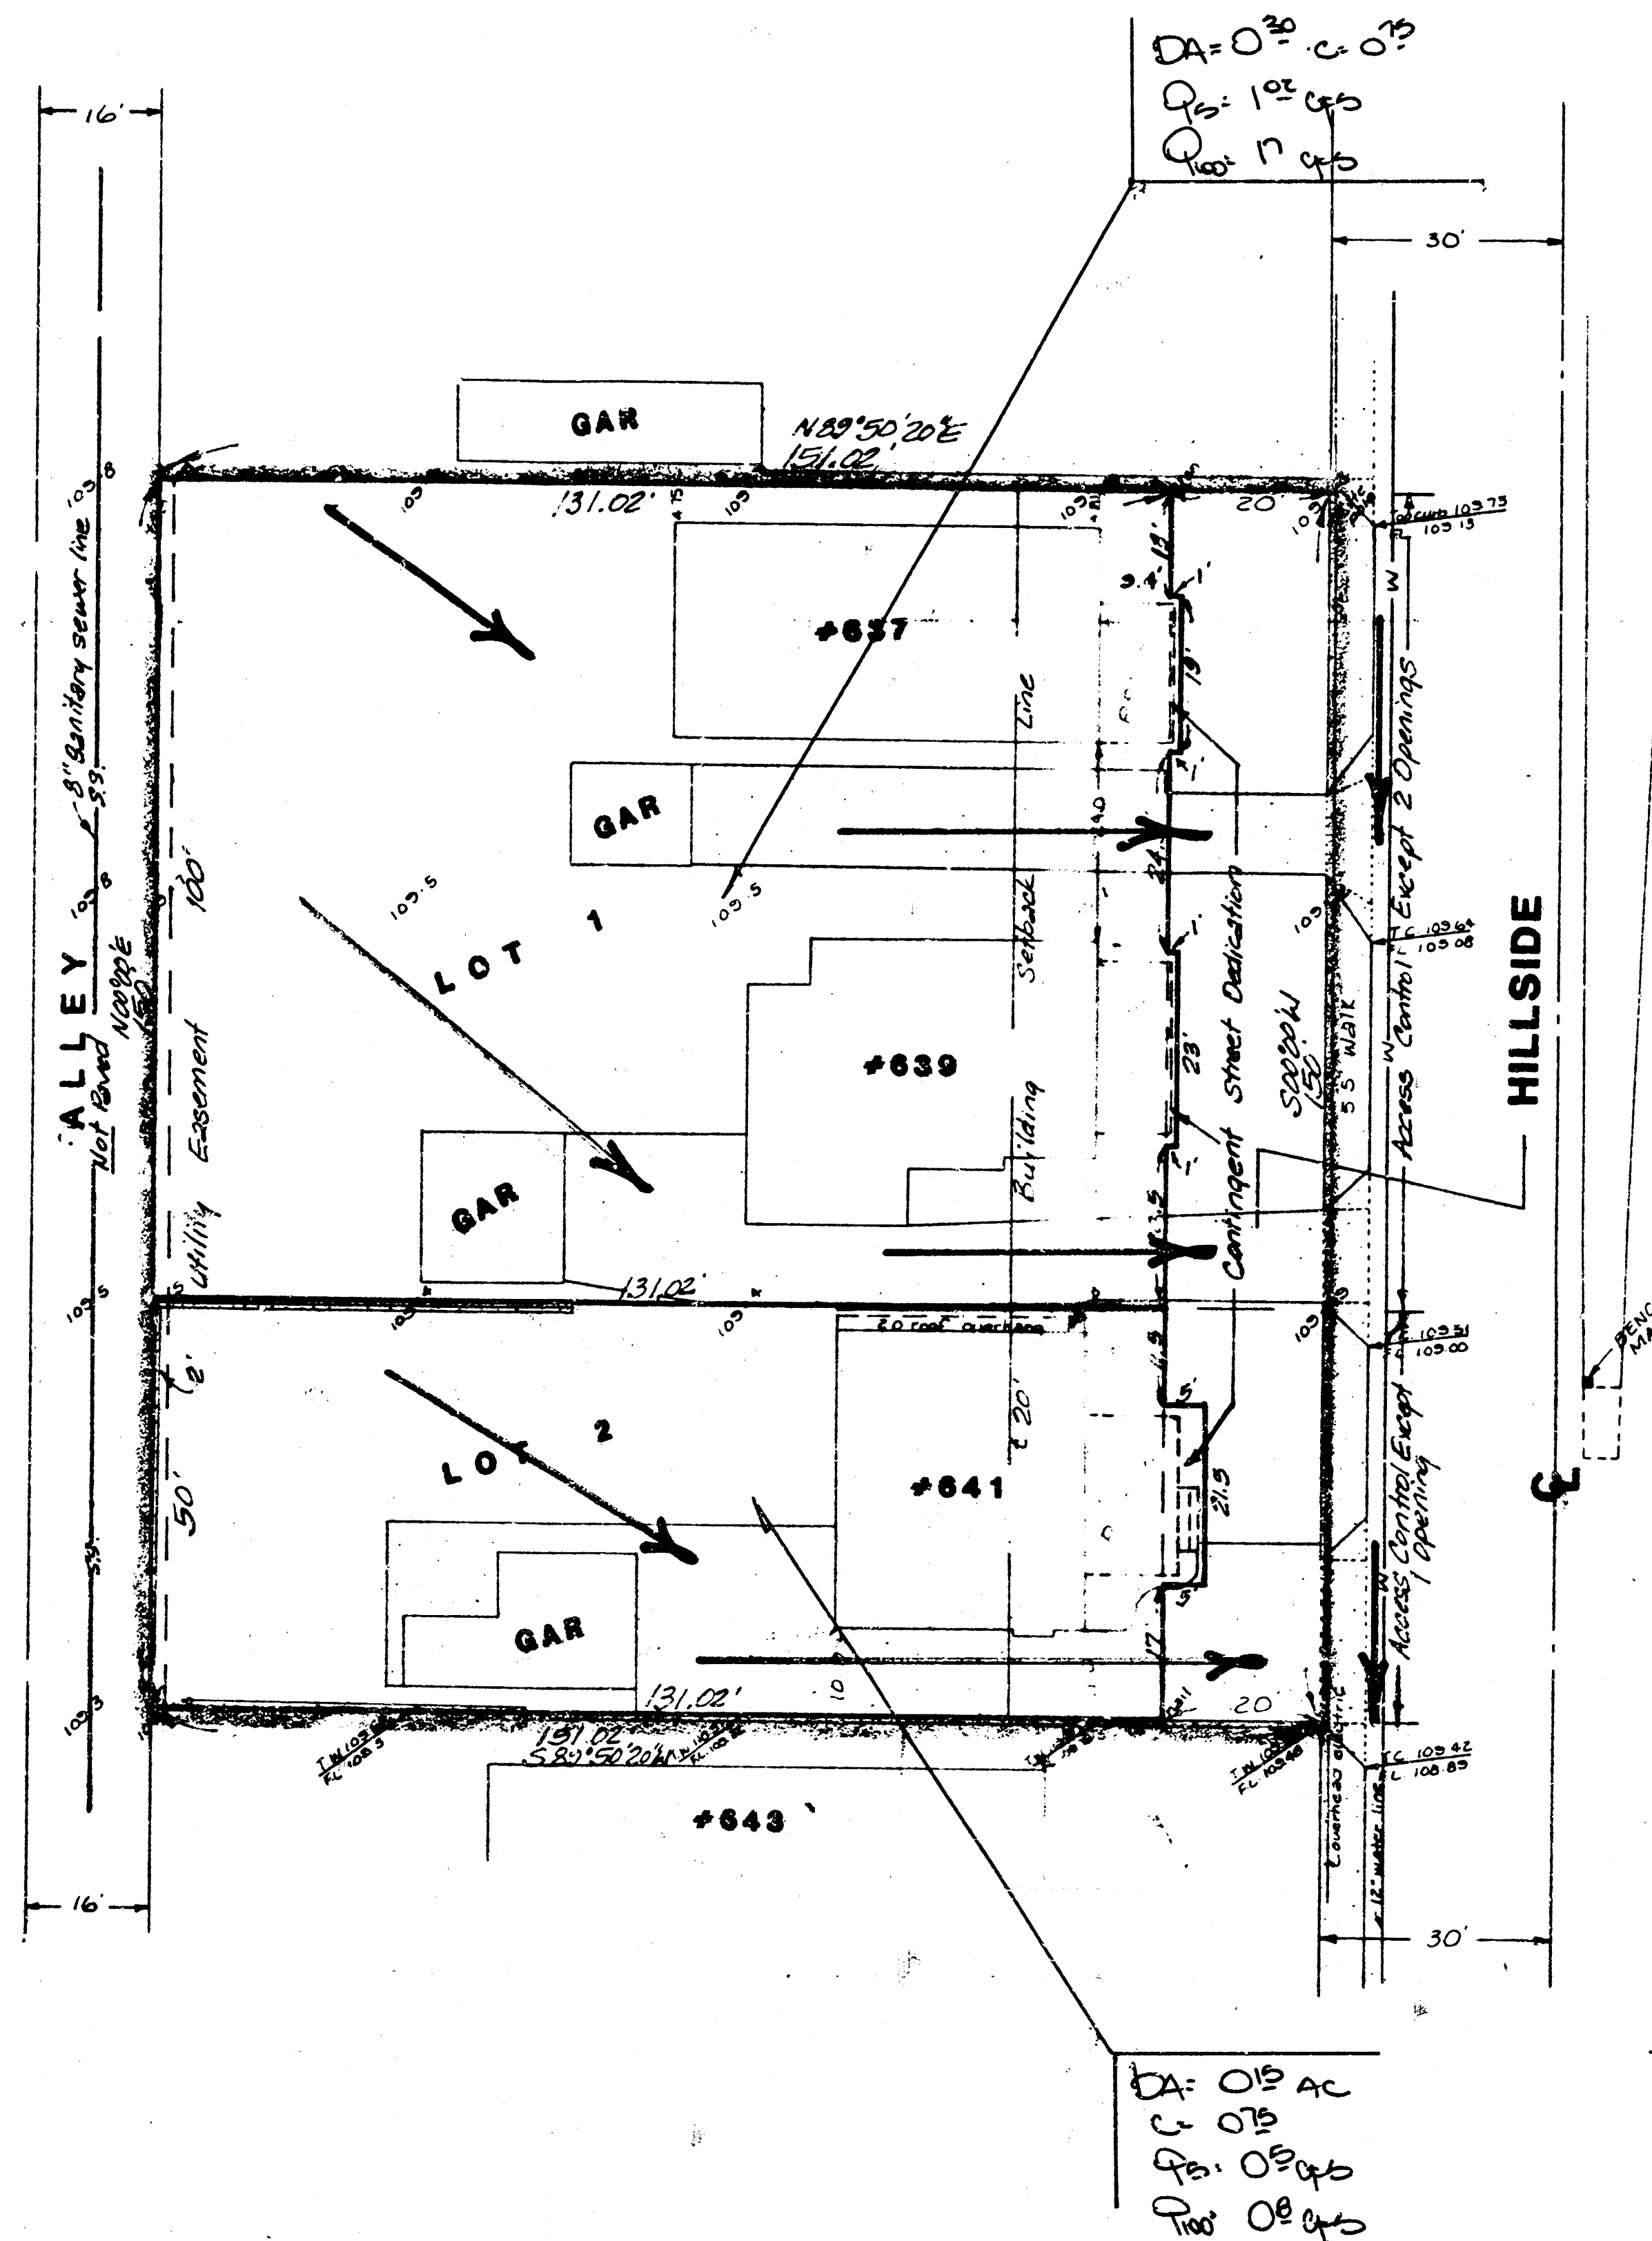

Bench Mark:
 0' cut on top of West curb on
 south end of island on Hillside
 431.12ft south of E of Orme.
 Elev. = 110.02 City Datum

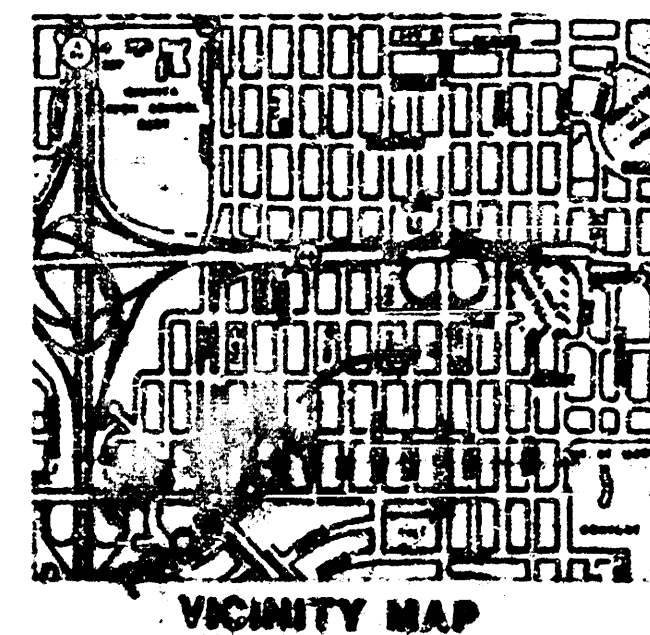

SKETCH PLAT **BLASI ADDITION**

LOTS 73, 75, 77, 79, 81, AND 83, BLOCK 8,
 SUNNY-SIDE ADDITION TO THE CITY OF
 WICHITA, KANSAS.

OWNERS:
 B. LINUS AND ADAURE C. OHAEBOSIM
 ORIE, JIM, AND BILL OWENS
 DONALD T. AND EILEEN M. BLASI

Drainage plan —

FILMED FROM THE BEST
 AVAILABLE COPY