



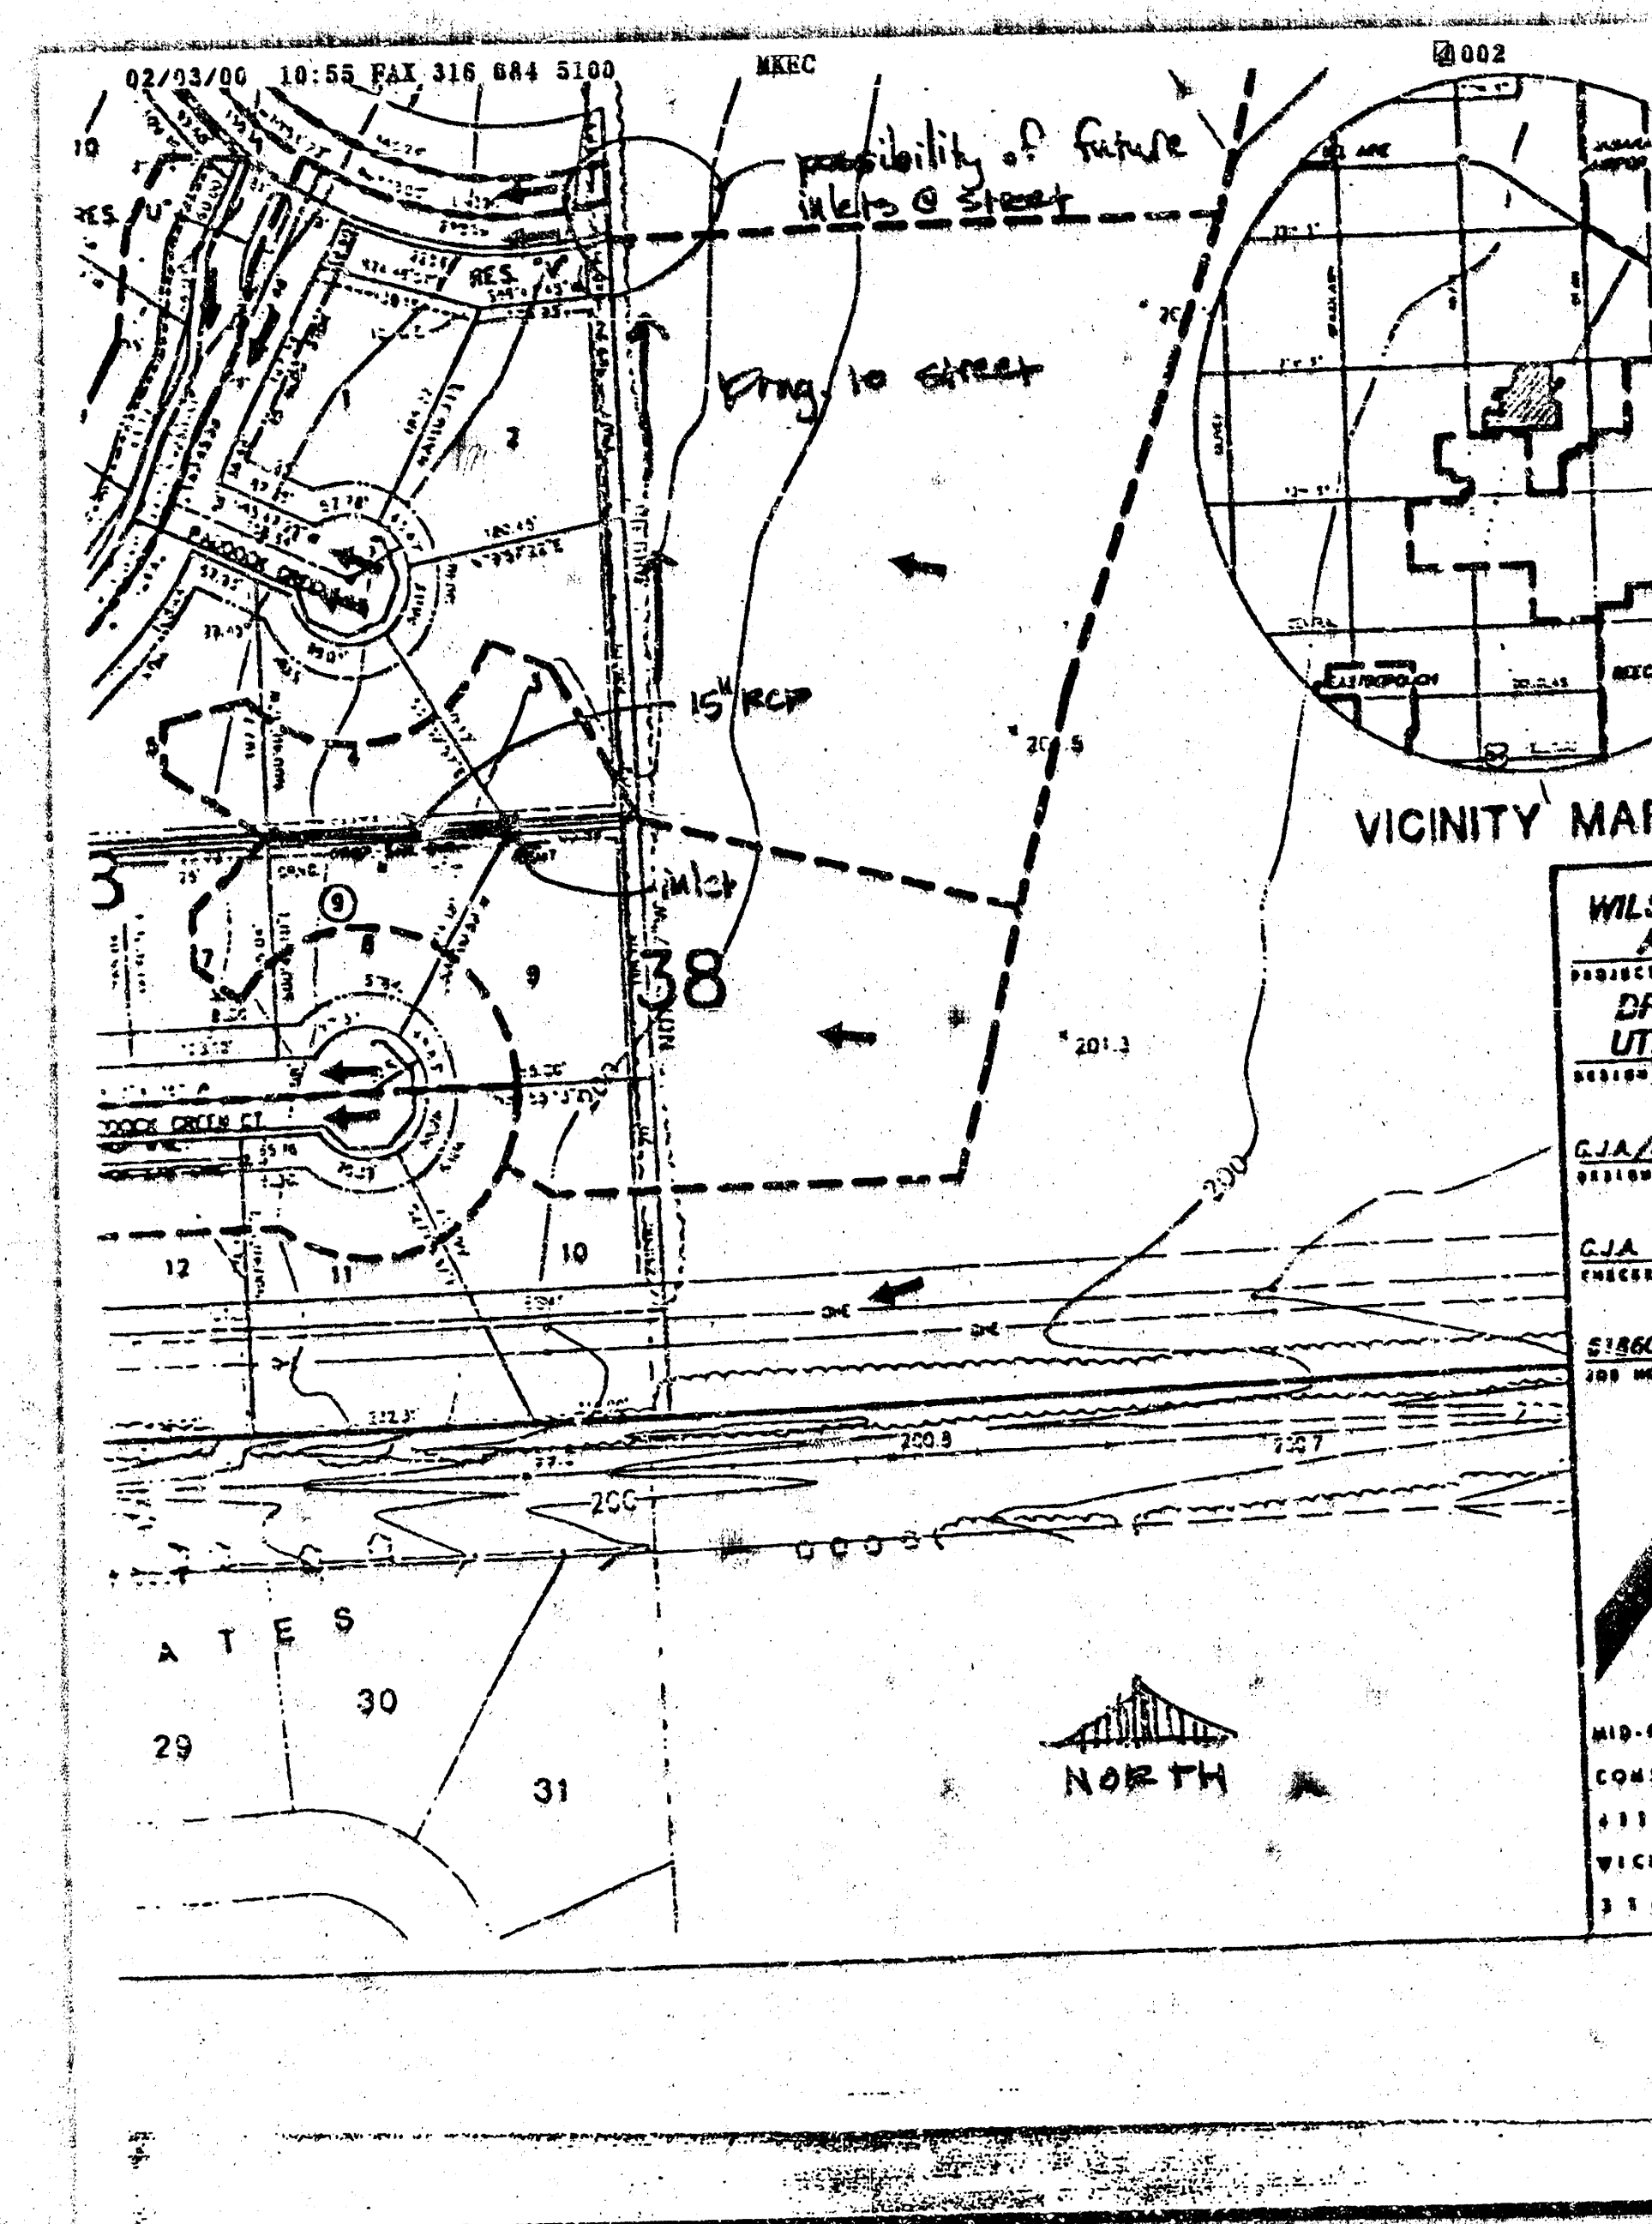

BRADLEY FAIR 2ND ADD. WILSON ESTATES RESIDENTIAL


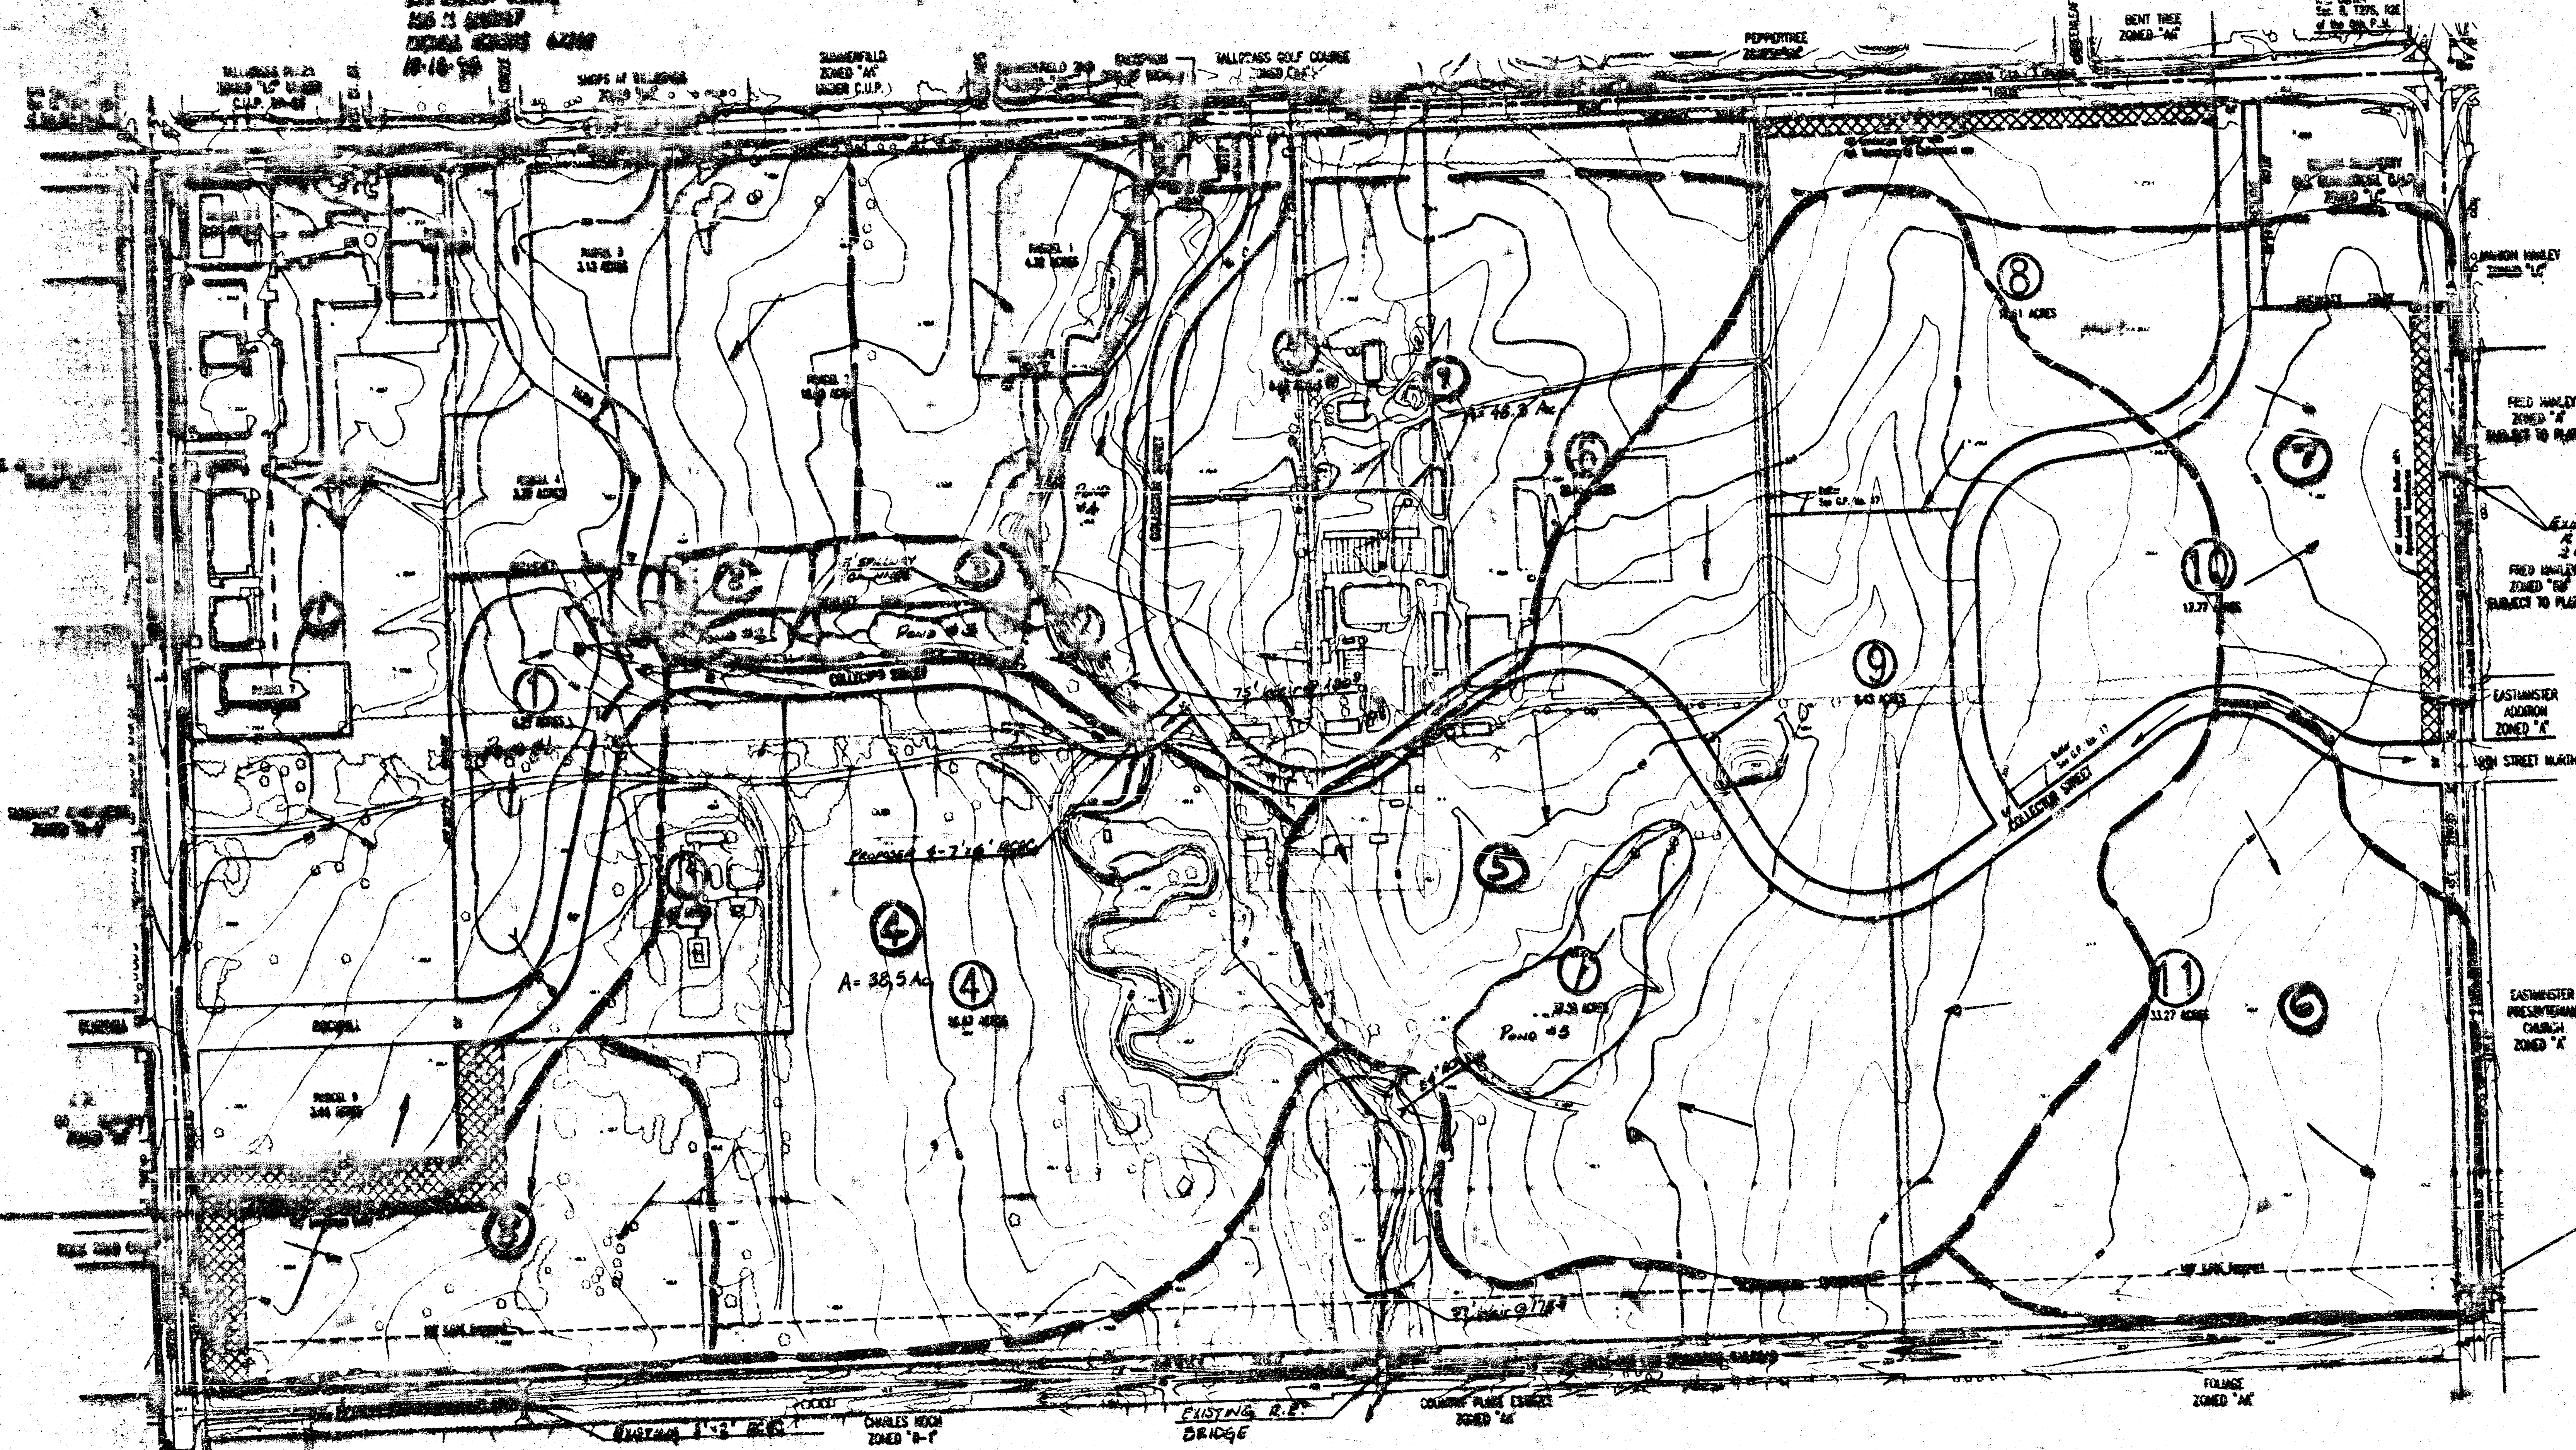

