Bratcher 2nd add'n

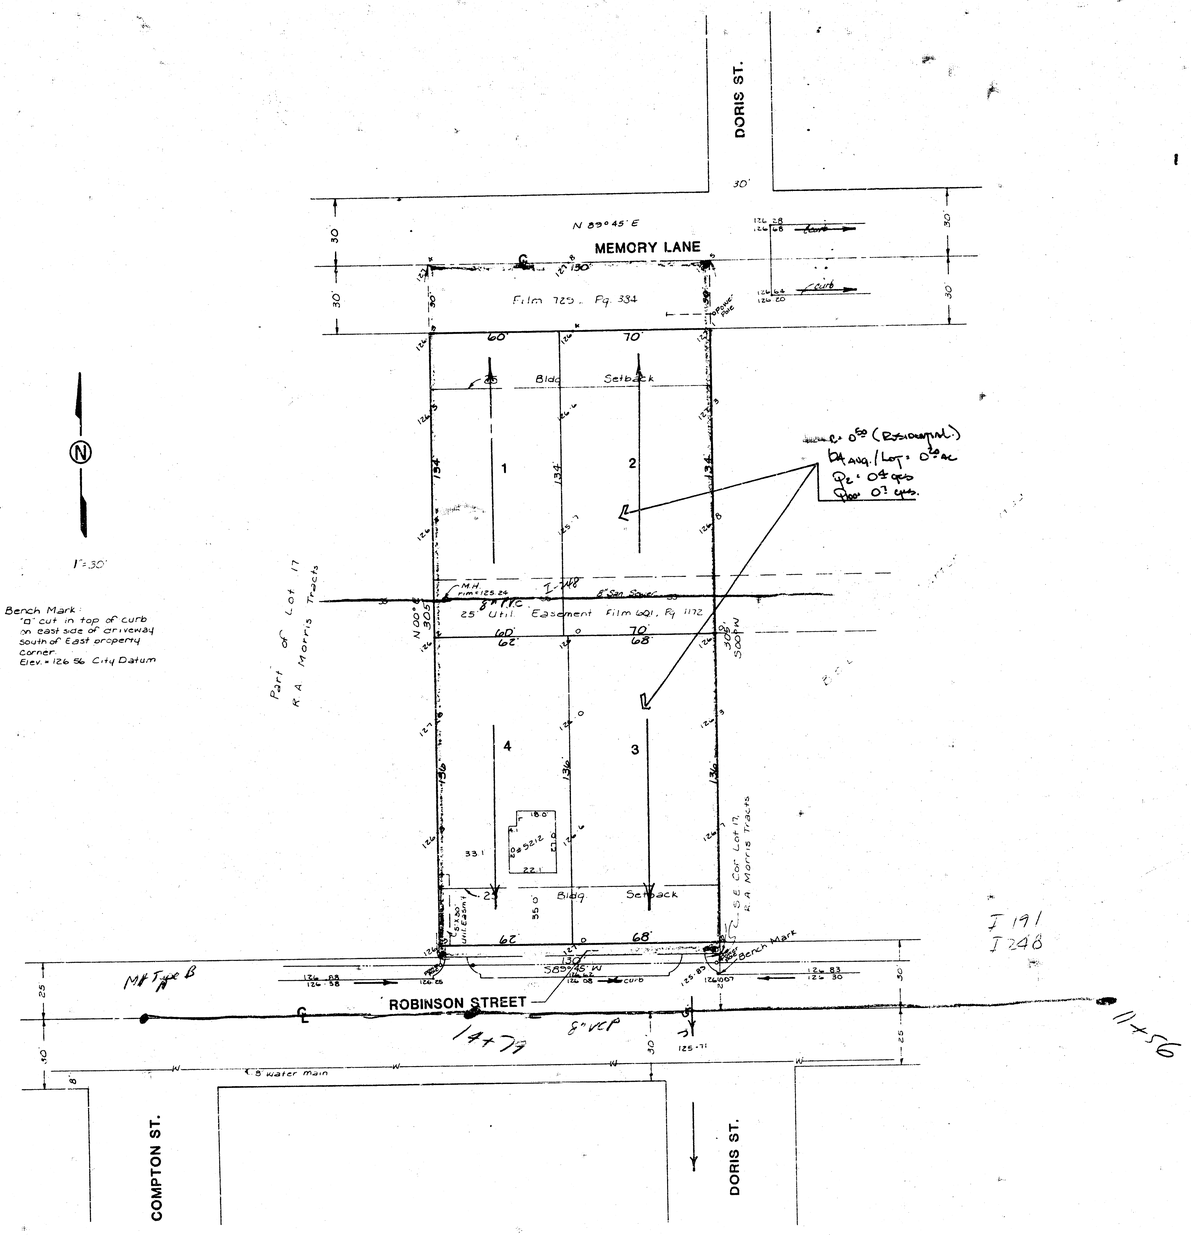

SKETCH PLAT

BRATCHER 2ND ADDITION

LOT 17, EXCEPT THE WEST 510 FEET THEREOF, R. A. MORRIS TRACTS,
SEDGWICK COUNTY, KANSAS

DRAINAGE PLAN

OWNER: MICHAEL D. BRATCHER

BAUGHMAN COMPANY, P.A.
SURVEYING & ENGINEERING
316/262-7271 • 315 ELLIS • WICHITA, KANSAS 67211