


~~CEDAR RIDGE (FOURTH ADDITION) TO~~
(OR: INAGE)
Hastal Park Cdd'n

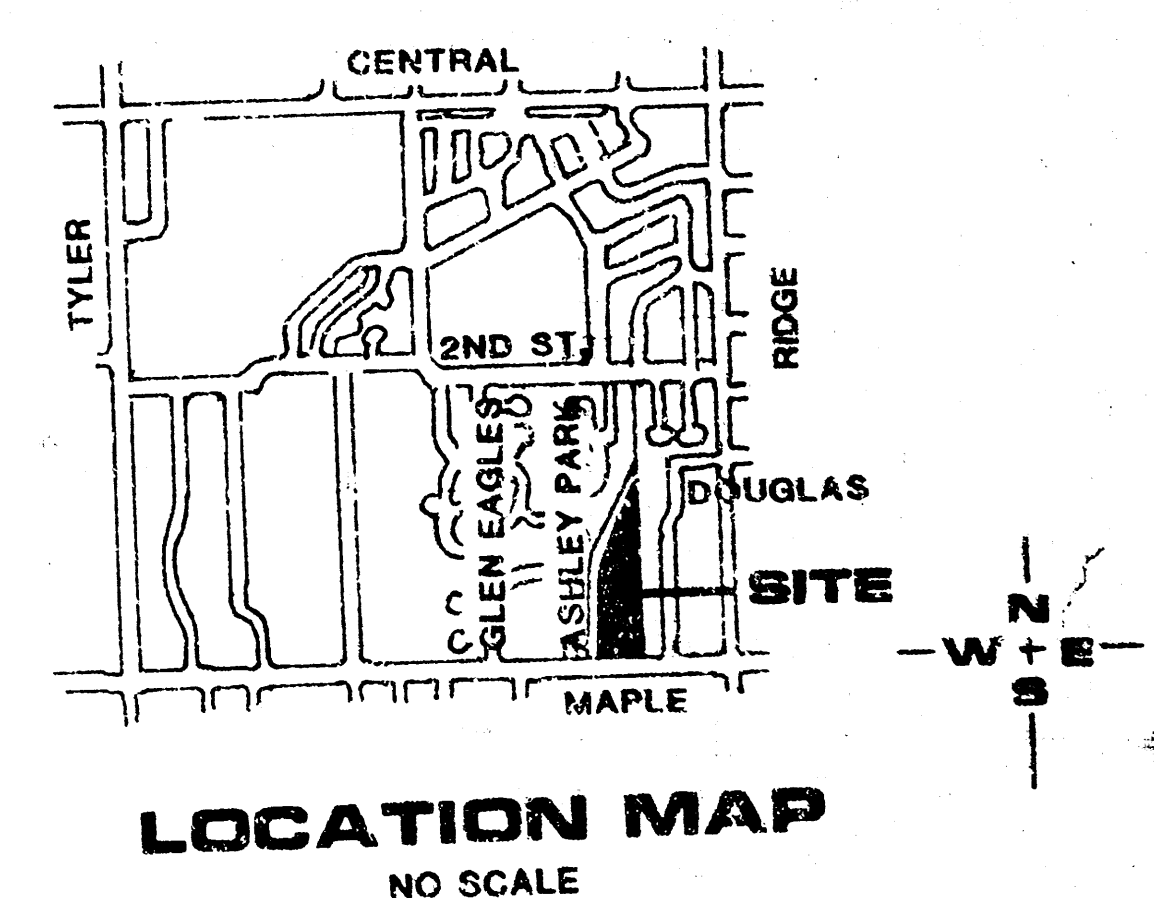

OWNER: STITT ESTATE IN C/O LEON STITT 2531 GREENWOOD WICHITA, KS. 67216 316-266-1455

BILL G. YUNG DESIGN
4012 E. 29TH STREET NORTH, WICHITA, KS 67220 316-683-0000
FAX NO.- 316-683-9298

