



PRELIMINARY PLAT **BRITTAIN INDUSTRIAL PARK** WICHITA, SEDGWICK COUNTY, KANSAS

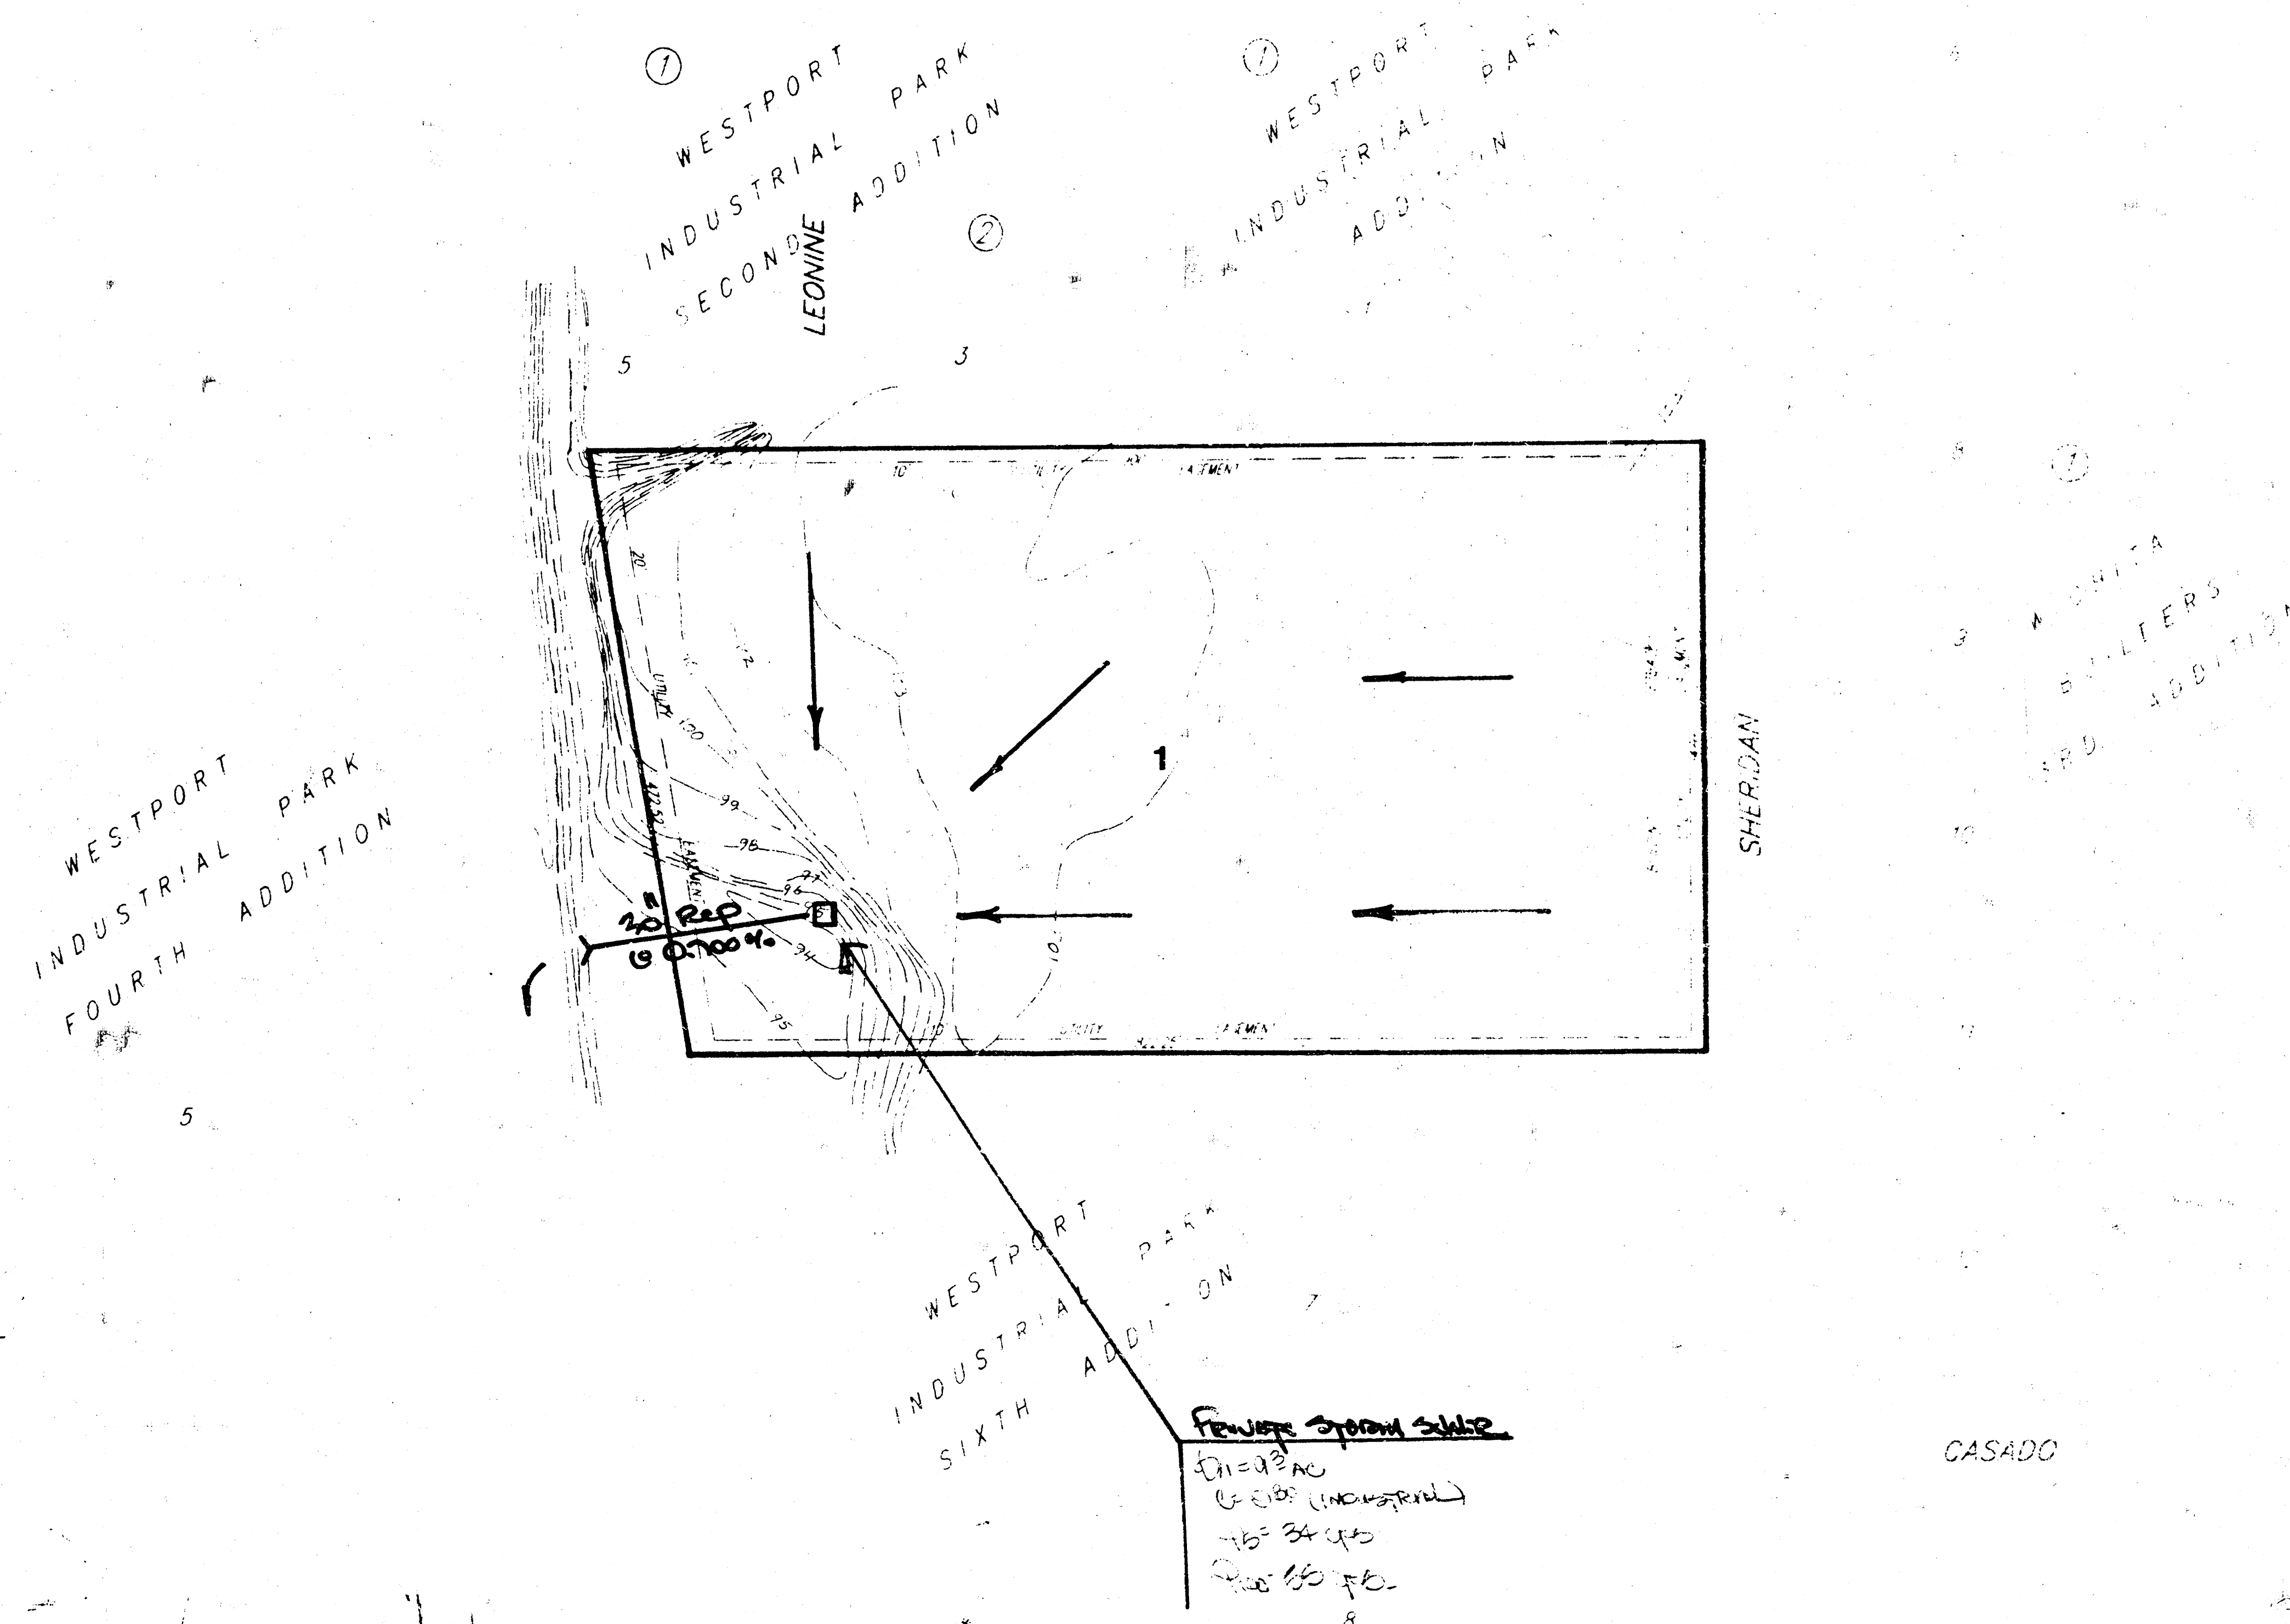

Scale: 1" = 100'
 Contours at 1' interval

Owner: Dewey Britton
 2820 S. Sheridan
 P.O. Box 12227
 Wichita, Kansas 67217
 913, 442-8123

Legend:
 A replat of lots 1, 2, 3, 4, 5, and 6,
 Westport Industrial Park Sixth Addition,
 Wichita, Sedgewick County, Kansas.

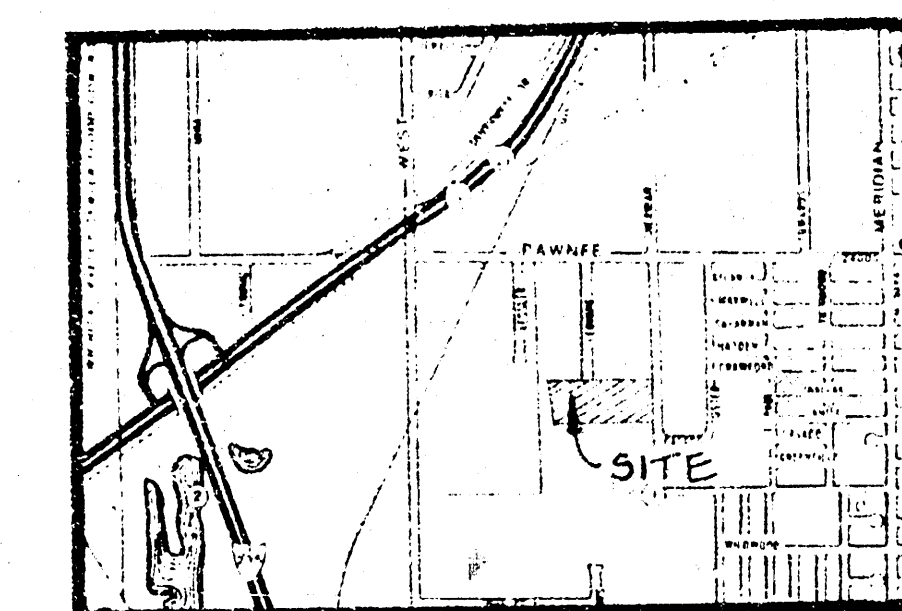

Vicinity Map

DRAINAGE PLAN