


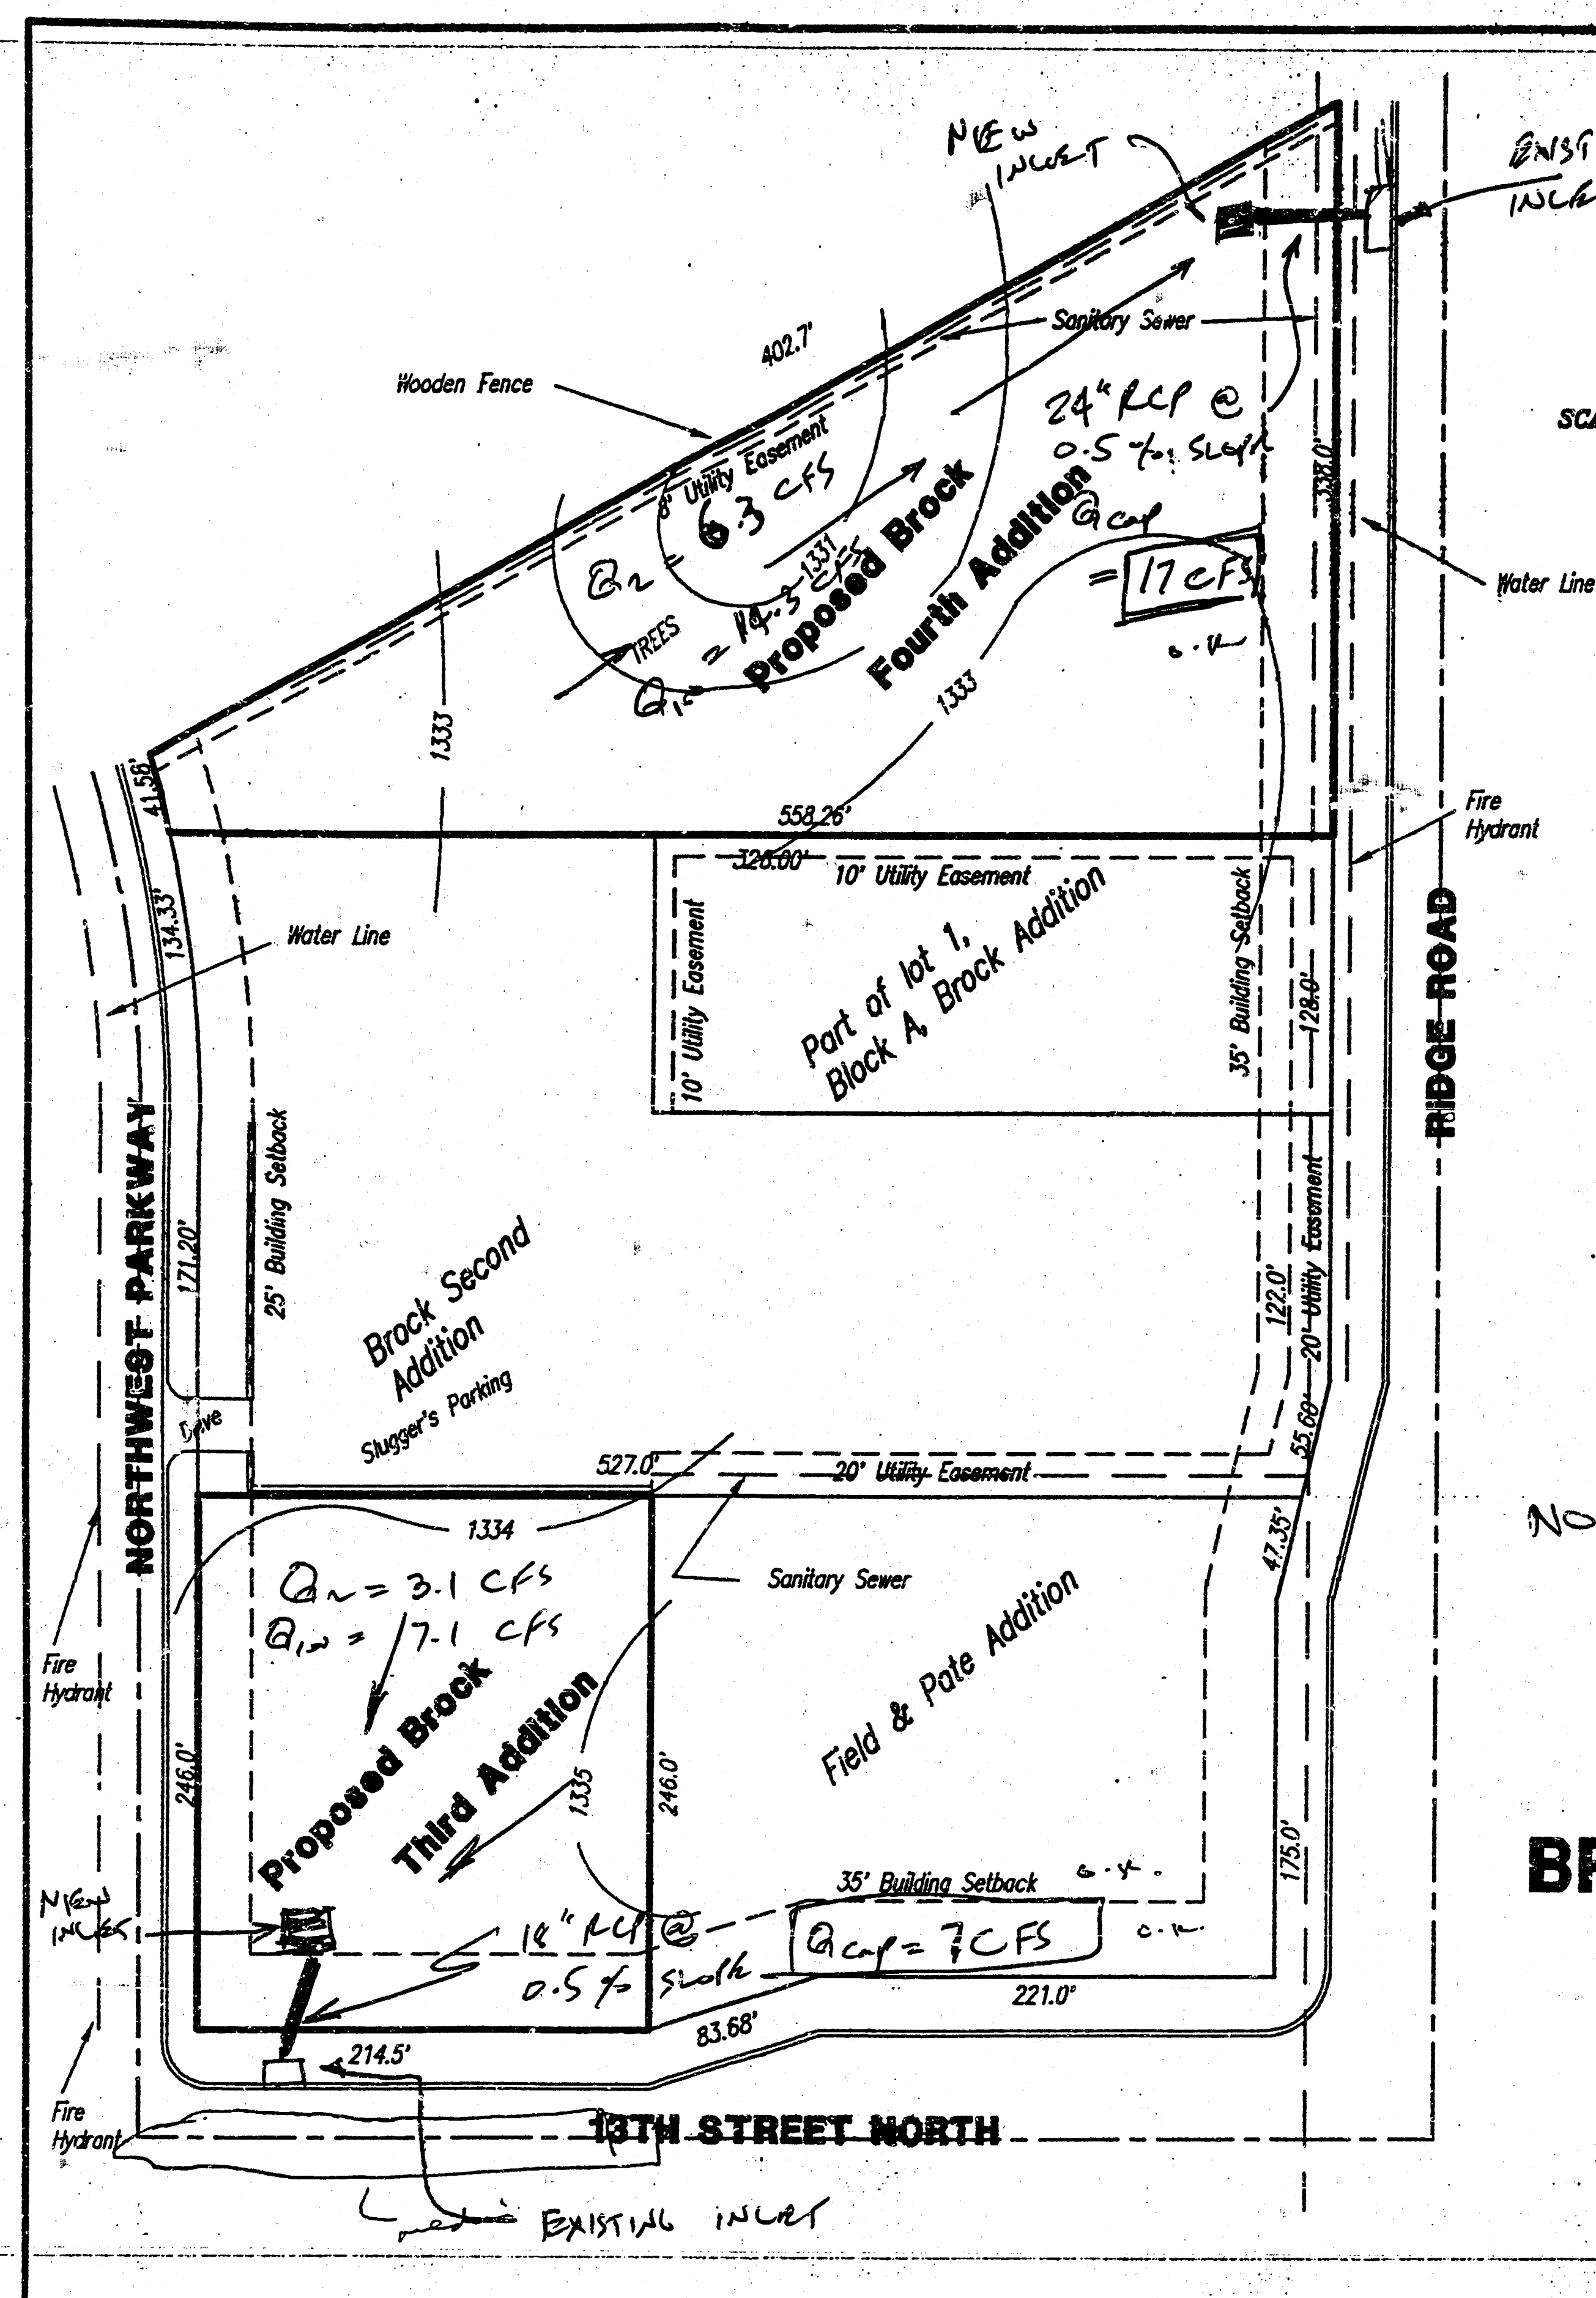

LAND USE = BUSINESS (MERCANTILE ROAD)

$C_2 = 0.68$

$C_{100} = 0.80$

USE $T_c = 15$ MIN.

$L_2 = 3.83$

$L_{100} = 7.37$

BROCK THIRD ADDITION:

Area = 1.21 Acres
Zoning = LC

BROCK FOURTH ADDITION:

Area = 2.43 Acres
Zoning = LC

OWNER:

Police Properties, LLC
243 Portlock Road
Honolulu, HI 96825

SURVEYOR/ENGINEER:


Babar M. Khan
Municipal Engineers, P.A.
254-Laura, Suite 201
Wichita, Kansas 67211

NOTE: STORM RETAINAGE MAY BE PROVIDED IN PARKING LOTS UPON DETAILED DRAINAGE ANALYSIS.

DRAINAGE CALCULATIONS

~~VICINITY MAP~~

**BROCK THIRD & FOURTH ADDITION
TO
WICHITA
SEDGWICK COUNTY, KANSAS**

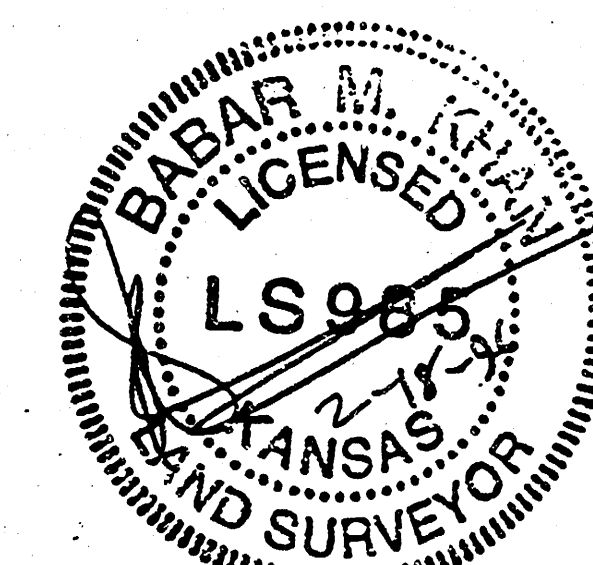

MUNICIPAL ENGINEERS, P.A.
254-Laura, Suite 201
Wichita, Kansas 67211
316-262-3642